


ESTIMATES		
Material	Quantity	Unit
Conc. Paving	2295	Sq. Yd.
Sand Bedding	127	Cu. Yd.

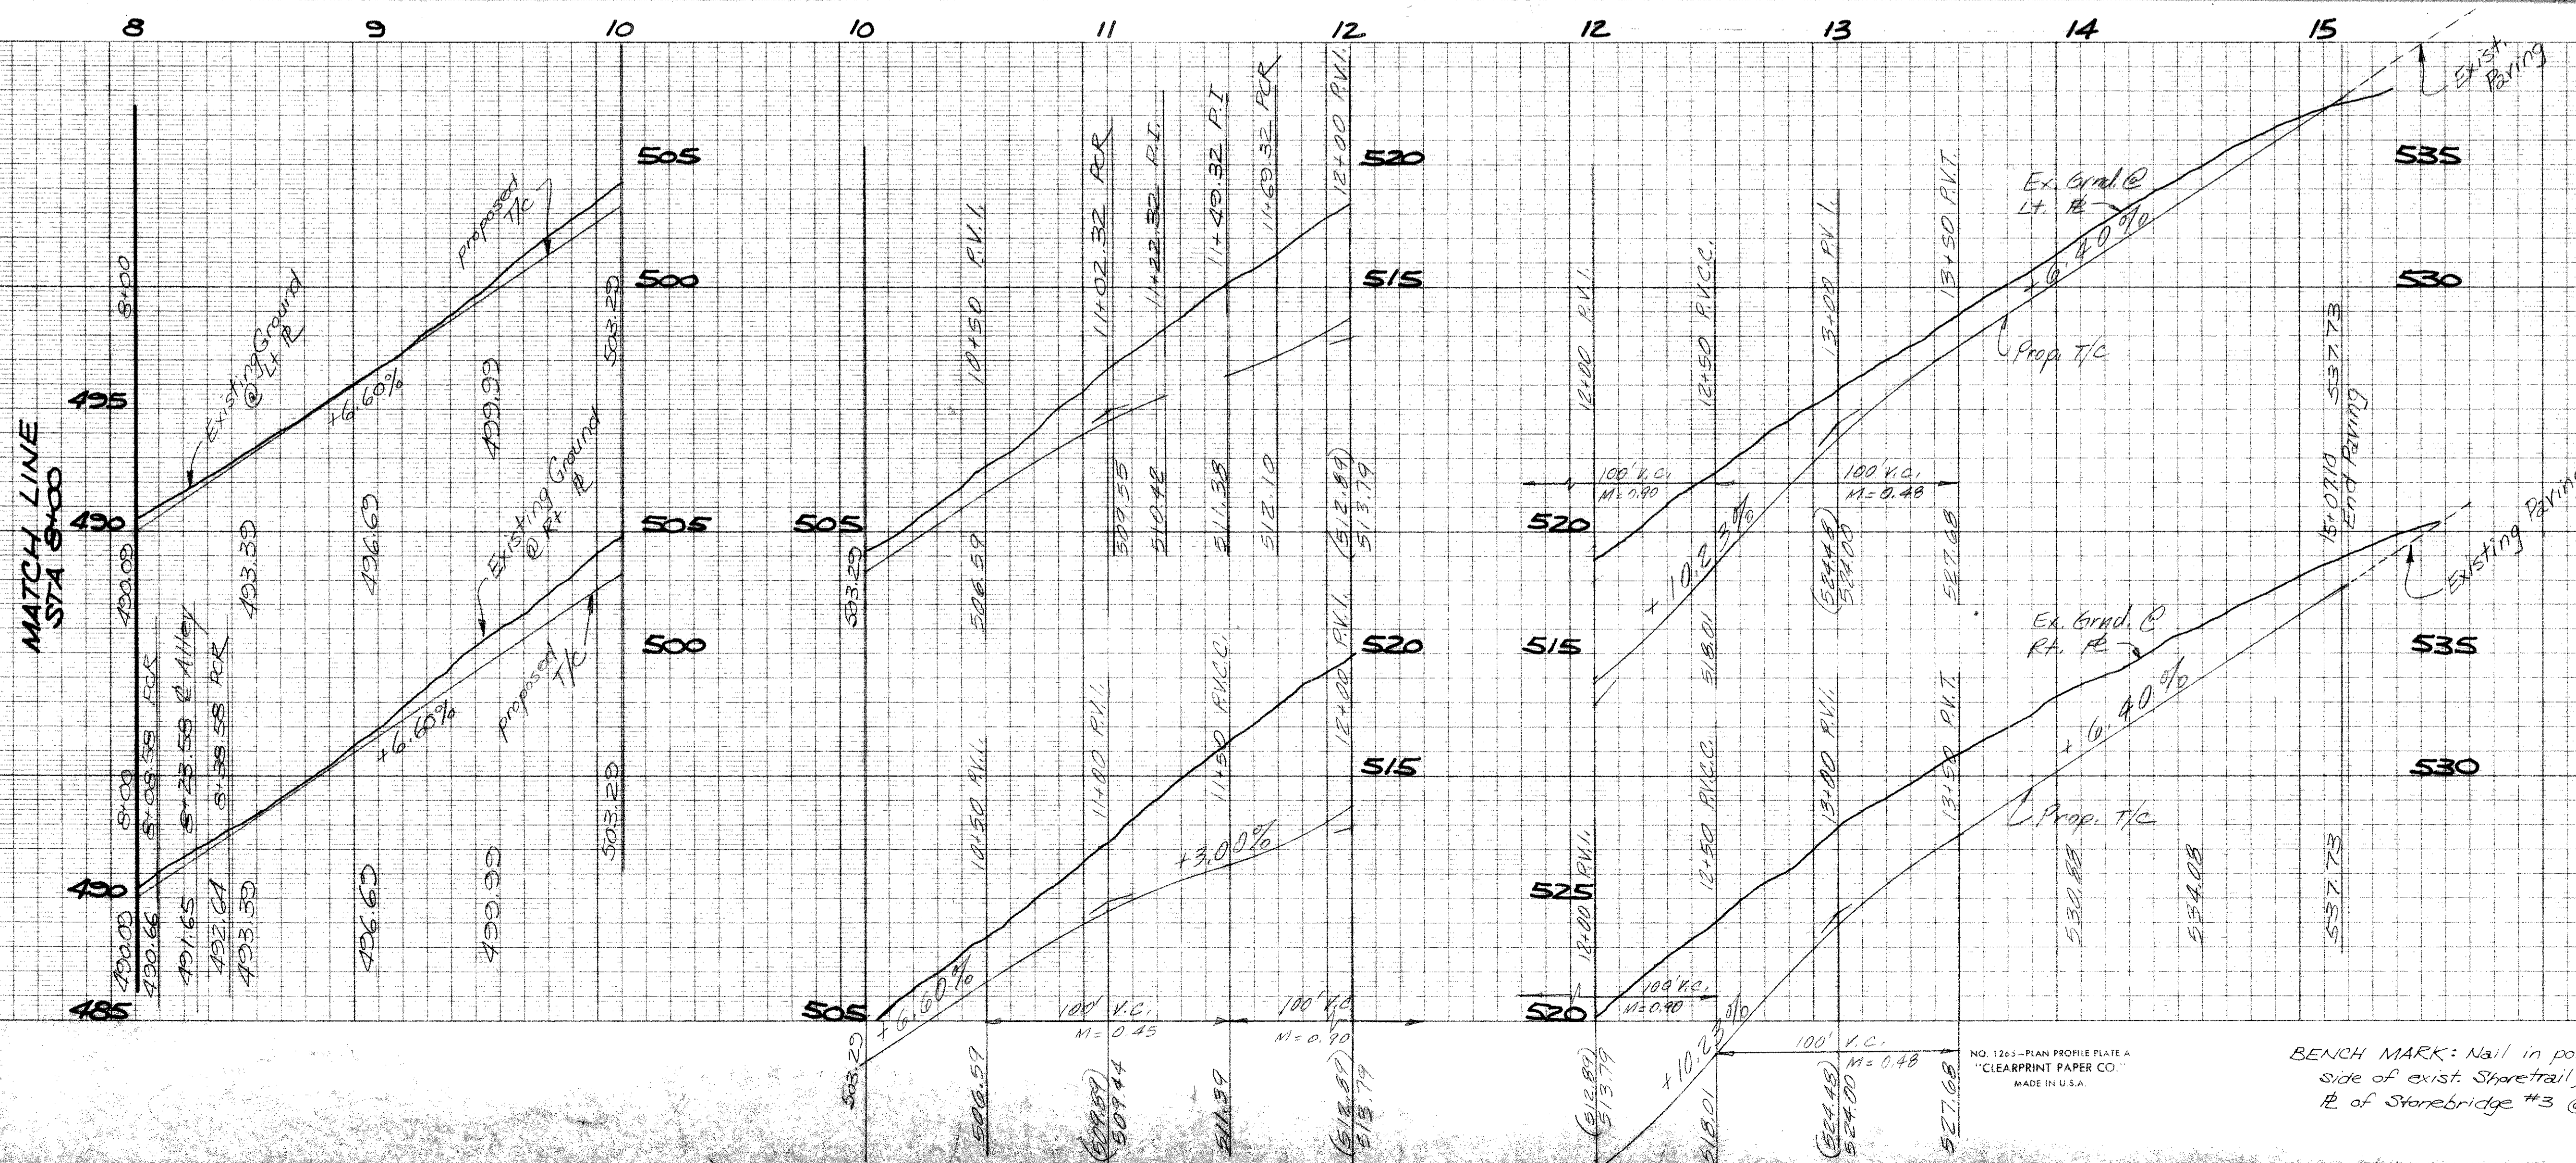

PAVING PLANS
STONEBRIDGE MEADOWS
 PHASE THREE
 ROCKWALL COUNTY, TEXAS
 THREADGILL - DOWDEY and ASSOCIATES
 CONSULTING ENGINEERS DALLAS, TEXAS

DESIGN	DRAWN	CHECKED	DATE	SCALE	JOB	SHEET
ARW	HTM	JCH	6-77	1"=40'	472-E	2/3

BENCH MARK: Nail in power pole, N. side of exist. Shoretrail, 40' East of E of Stonebridge #3 @ Alley.

NO. 1263 - PLAN PROFILE PLATE A
 "CLEARPRINT PAPER CO."
 MADE IN U.S.A.