


**OFF-SITE DRAINAGE AREAS**  
SCALE: 1" = 400'

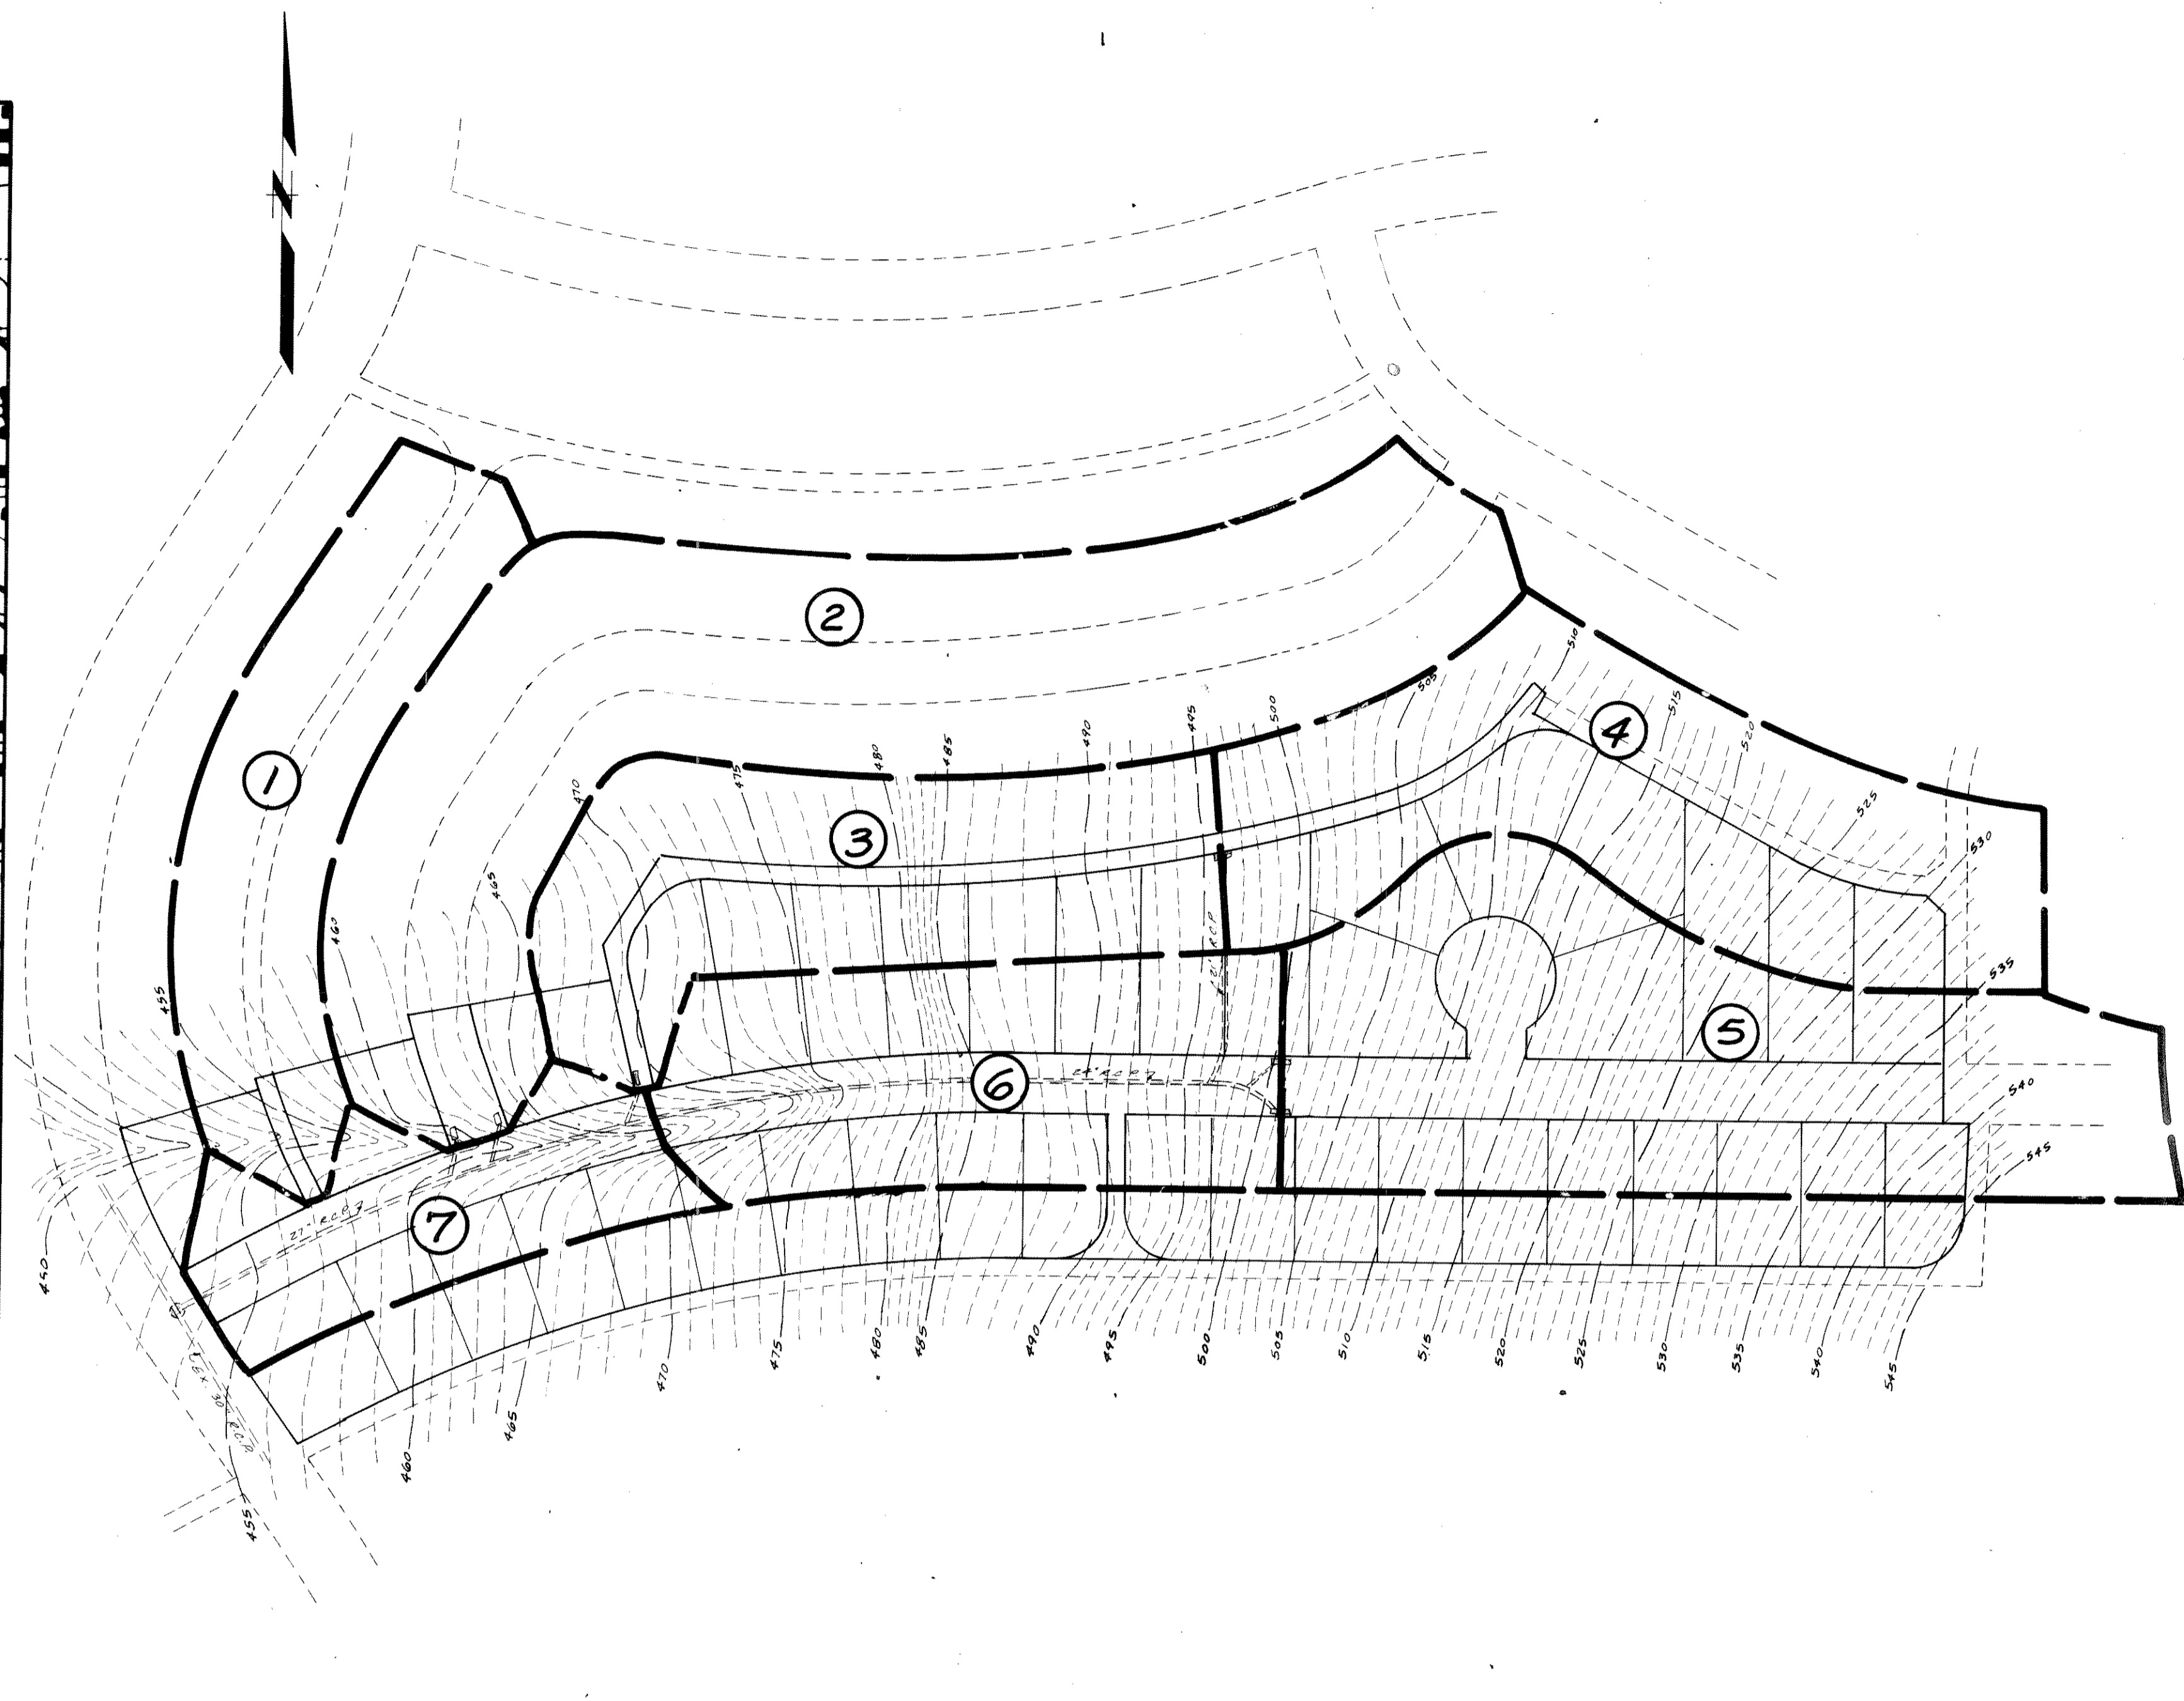

**ON-SITE DRAINAGE AREAS**  
SCALE: 1" = 100'

**DRAINAGE AREAS**

No.	Acres	C	150	450
1	1.5	0.4	9.0	0.5
2	3.9			1.4
3	1.9			0.7
4	2.3			0.8
5	2.8			101.0
6	1.8			60.6
7	1.0			0.4
8	4.3	0.4	9.0	15.5

**DRAINAGE AREA MAP**  
**STONEBRIDGE MEADOWS**  
PHASE THREE  
ROCKWALL, TEXAS

THREADGILL - DOWDEY and ASSOCIATES  
CONSULTING ENGINEERS DALLAS, TEXAS

DESIGN	DRAWN	CHECKED	DATE	SCALE	JOB	SHEET
ARW.	RE.	J.C.H.	6-77	AS SHOWN	472E	1

Plate No. 6