


ESTIMATES		
Material	Quantity	Unit
4" Dia. M.H.	1	Ea.
27" R.C.P.	287	L.F.
24" R.C.P.	642	L.F.
21" R.C.P.	327	L.F.
10' Conc. Inlets	6	Ea.

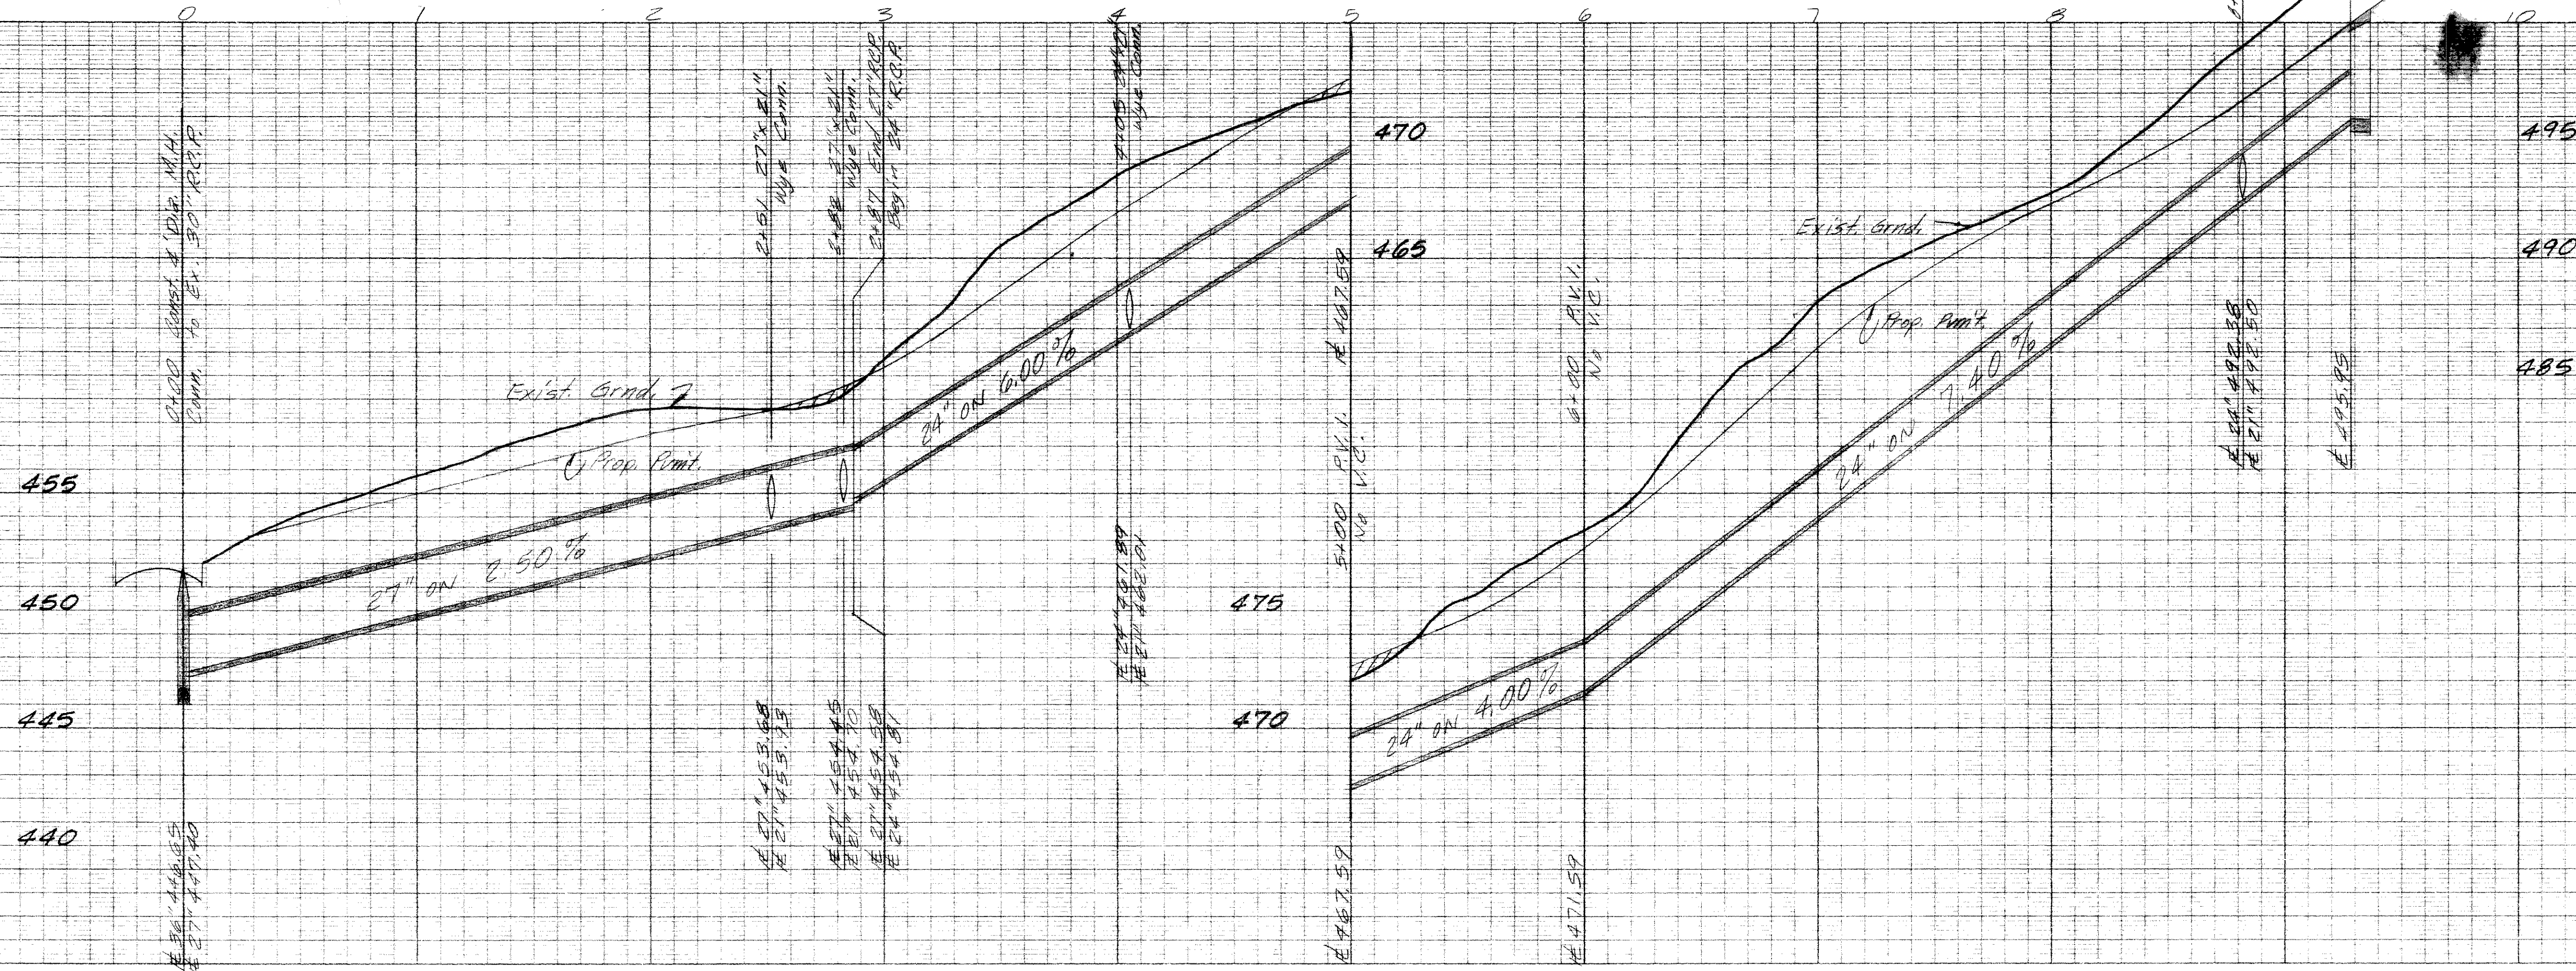

STORM SEWER PLANS
STONEBRIDGE MEADOWS
 PHASE THREE
 ROCKWALL COUNTY, TEXAS

THREADGILL - DOWDEY and ASSOCIATES
 CONSULTING ENGINEERS DALLAS, TEXAS

DESIGN	DRAWN	CHECKED	DATE	SCALE	JOB	SHEET
ARW	HTM	JCH	6-77	1"=40'	ATZE	2/2

BENCH MARK: Nail in power pole, north side of exist. Shoretrail, 40' east of Shoretrail No. 3 property at asphalt alley. Elev. 540.93

"CLEARPRINT" PROFILE PAPER PLATE A
 "CLEARPRINT" PAPER CO.
 MADE IN U.S.A.

"CLEARPRINT" PROFILE PAPER PLATE A
 "CLEARPRINT" PAPER CO.
 MADE IN U.S.A.