


- NOTES:
1. All construction performed shall be in accordance with City of Rockwall ordinances and specifications.
  2. Locations of all existing facilities, i.e. pipelines, cables, electricity, telephone, etc., shall be verified in the field by the contractor. It shall be the responsibility of the contractor to notify the proper agencies prior to construction.

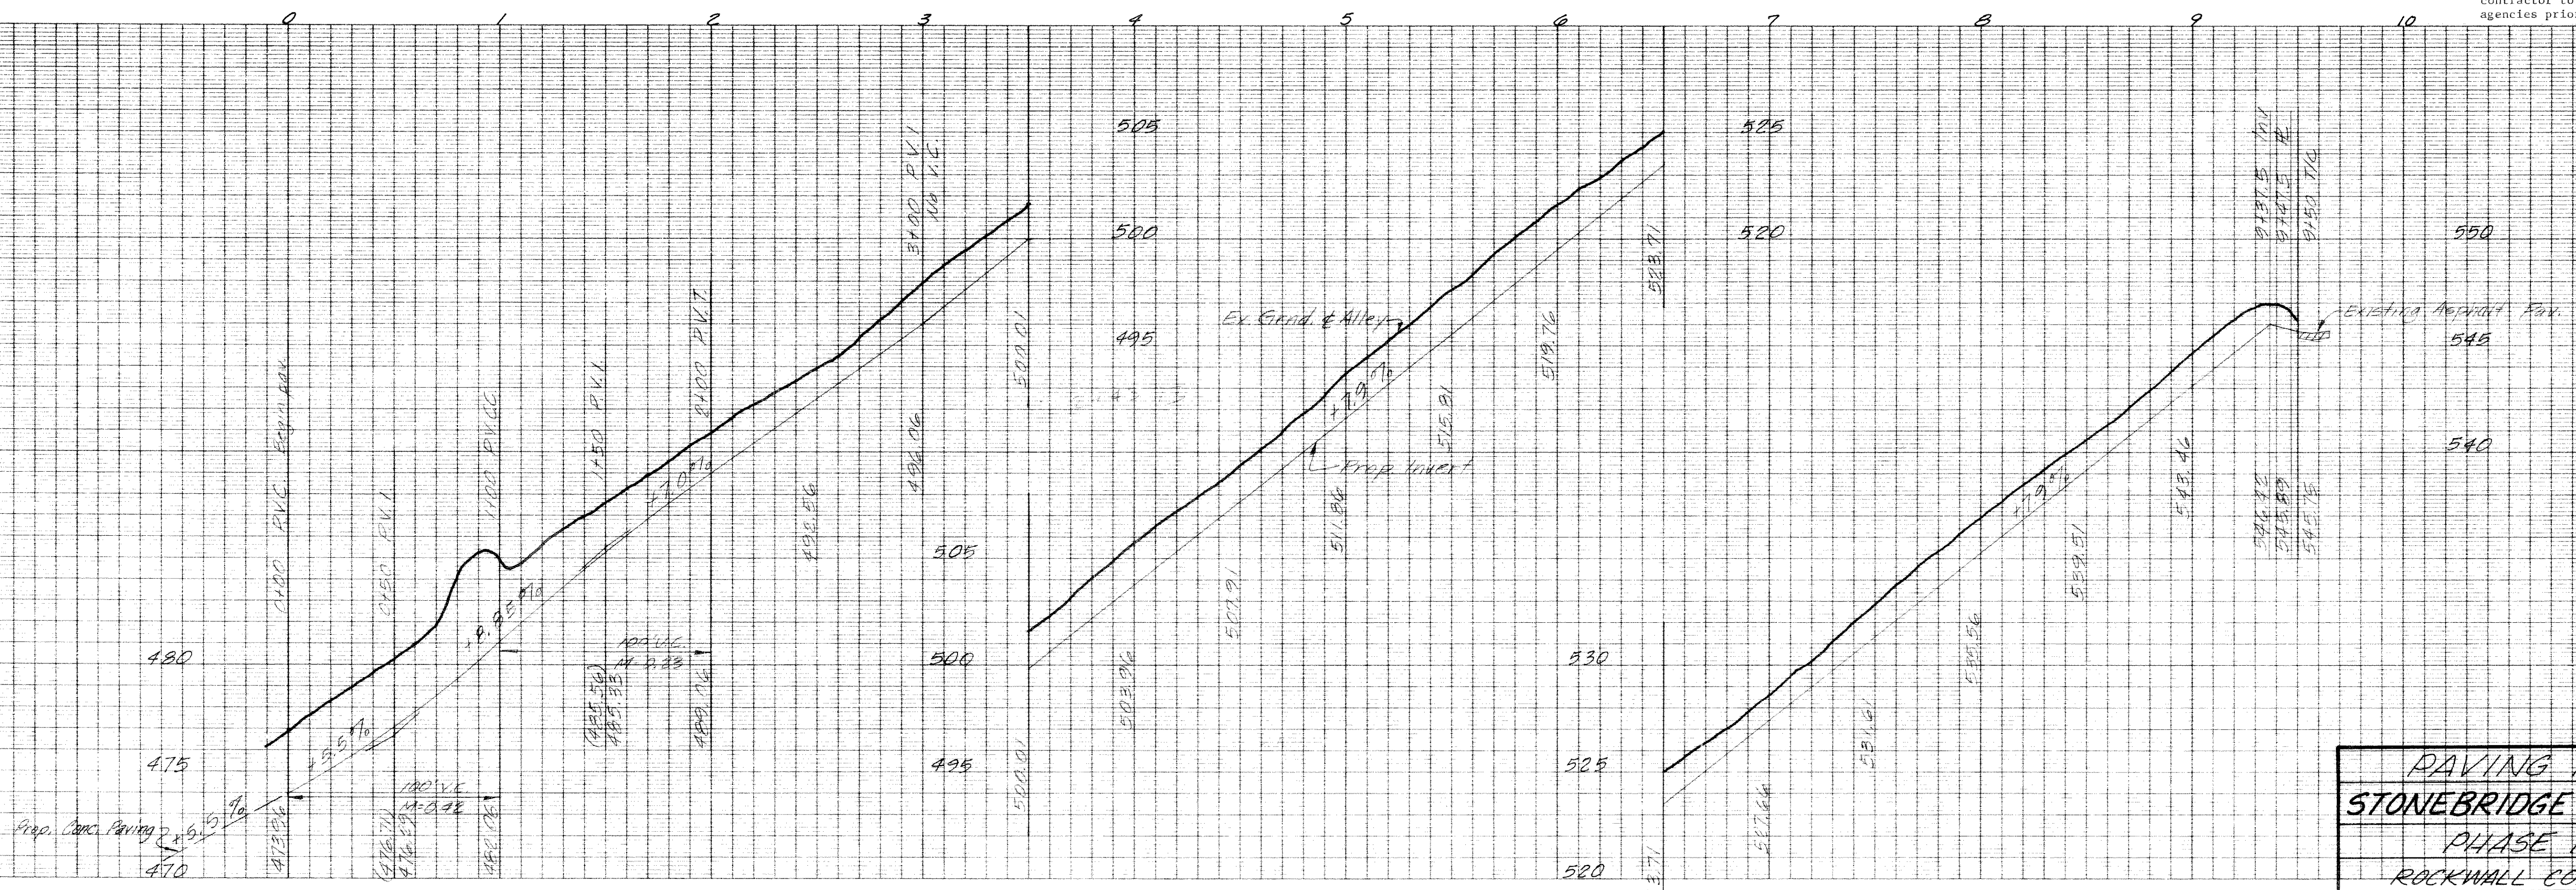

NO. 1265-PLAN PROFILE PLATE A  
"CLEARPRINT PAPER CO."  
MADE IN U.S.A.

BENCH MARK: "O" Cut on conc. curb,  
11.5' South of the southeast  
corner of Lot #17  
Elev. 551.51'

PAVING PLANS					
STONEBRIDGE MEADOWS					
PHASE TWO					
ROCKWALL CO., TEXAS					
THREADGILL - DOWDEY and ASSOCIATES					
CONSULTING ENGINEERS DALLAS, TEXAS					
DESIGN	DRAWN	CHECKED	DATE	SCALE	JOB SHEET
A.R.M.	R.E.	J.C.H.	1-77	1"=40' 1/2"=1'	459-E/1