


- NOTES:
- All construction performed shall be in accordance with City of Rockwall ordinances and specifications.
  - Locations of all existing facilities, i.e. pipelines, cables, electricity, telephone, etc., shall be verified in the field by the contractor. It shall be the responsibility of the contractor to notify the proper agencies prior to construction.

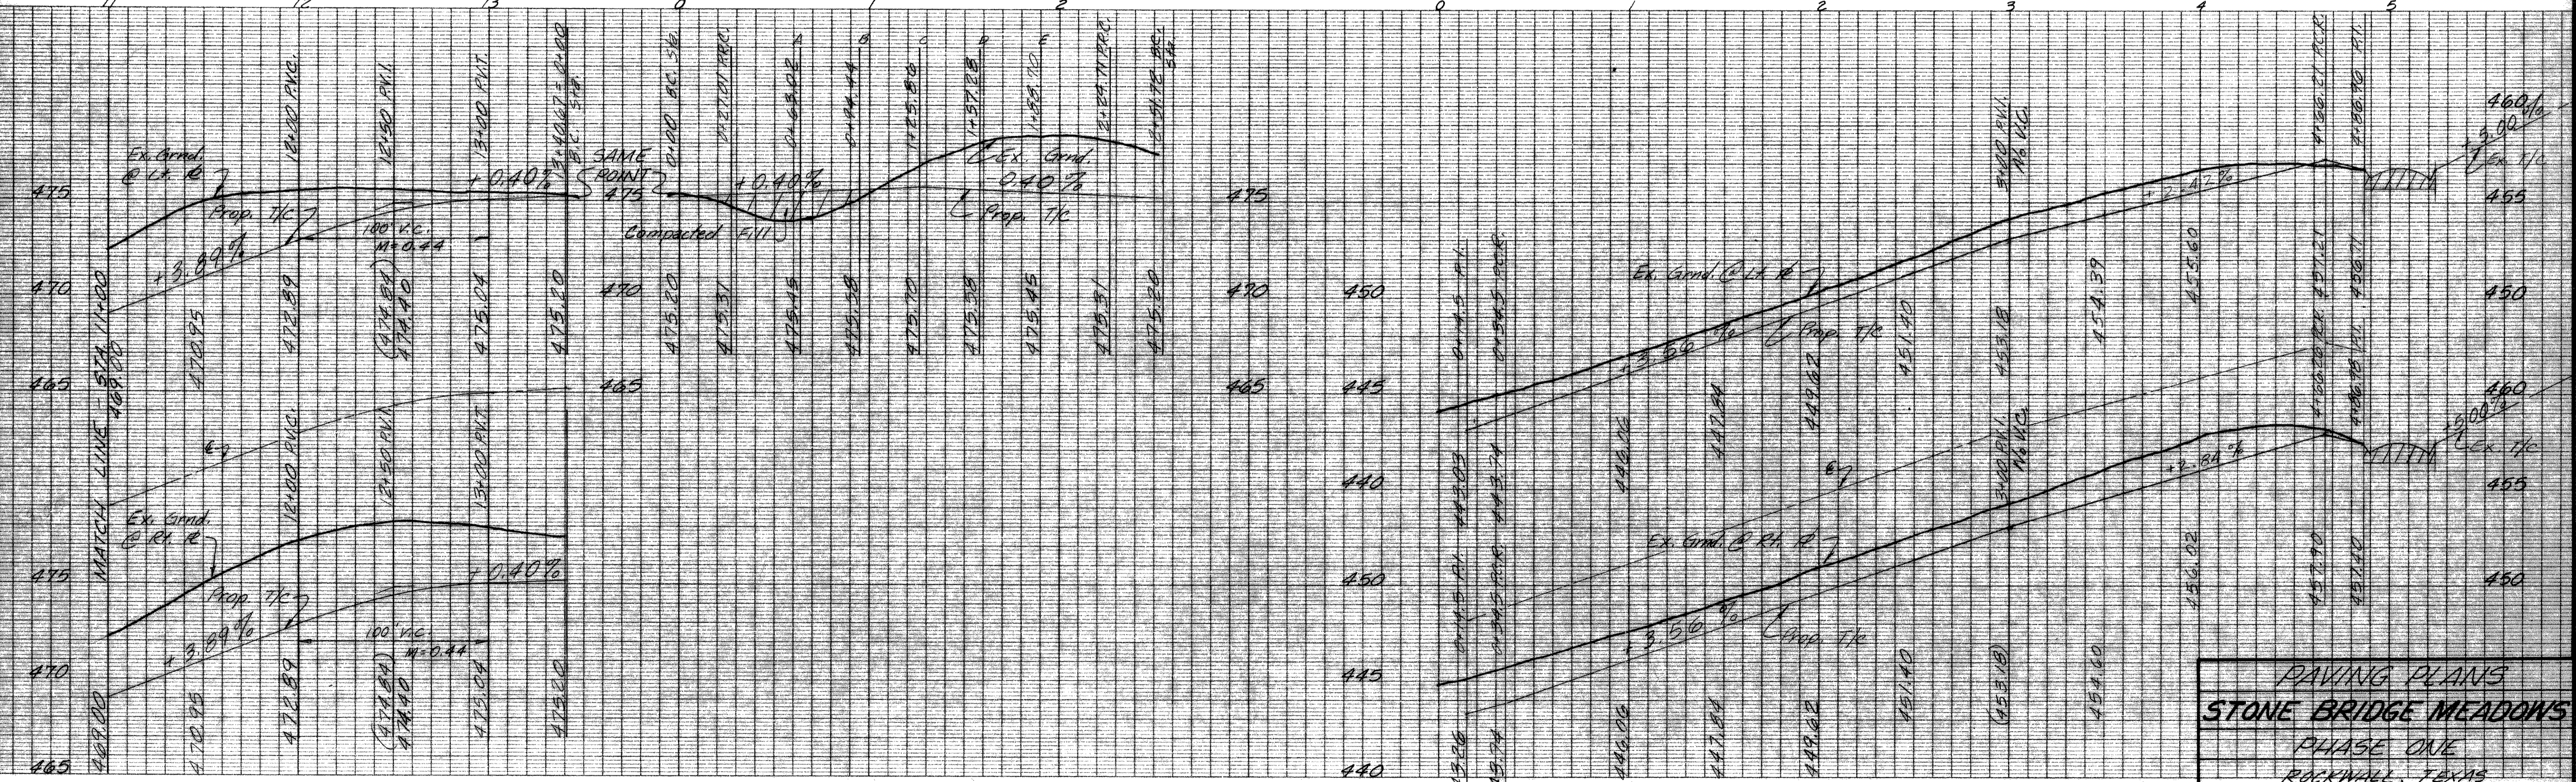

NO. 1245-PLAN PROFILE PLATE A  
"CLEARPRINT PAPER CO."  
MADE IN U.S.A.

BENCH MARK: Top Fire Hydrant Operating nut, at South Property Line, West Side Lake Shore Drive. Elev. 468.86

PAVING PLANS  
STONE BRIDGE MEADOWS  
PHASE ONE  
ROCKWALL, TEXAS

THREADGILL - DOWDEY and ASSOCIATES  
CONSULTING ENGINEERS DALLAS, TEXAS

DESIGN	DRAWN	CHECKED	DATE	SCALE	JOB	SHEET
AR.W	RE.	J.C.H.	10-76	1"=40' 12"=1'	456-E	2/2