


- NOTES:
1. All construction performed shall be in accordance with City of Rockwall ordinances and specifications.
 2. Locations of all existing facilities, i.e. pipelines, cables, electricity, telephone, etc., shall be verified in the field by the contractor. It shall be the responsibility of the contractor to notify the proper agencies prior to construction.

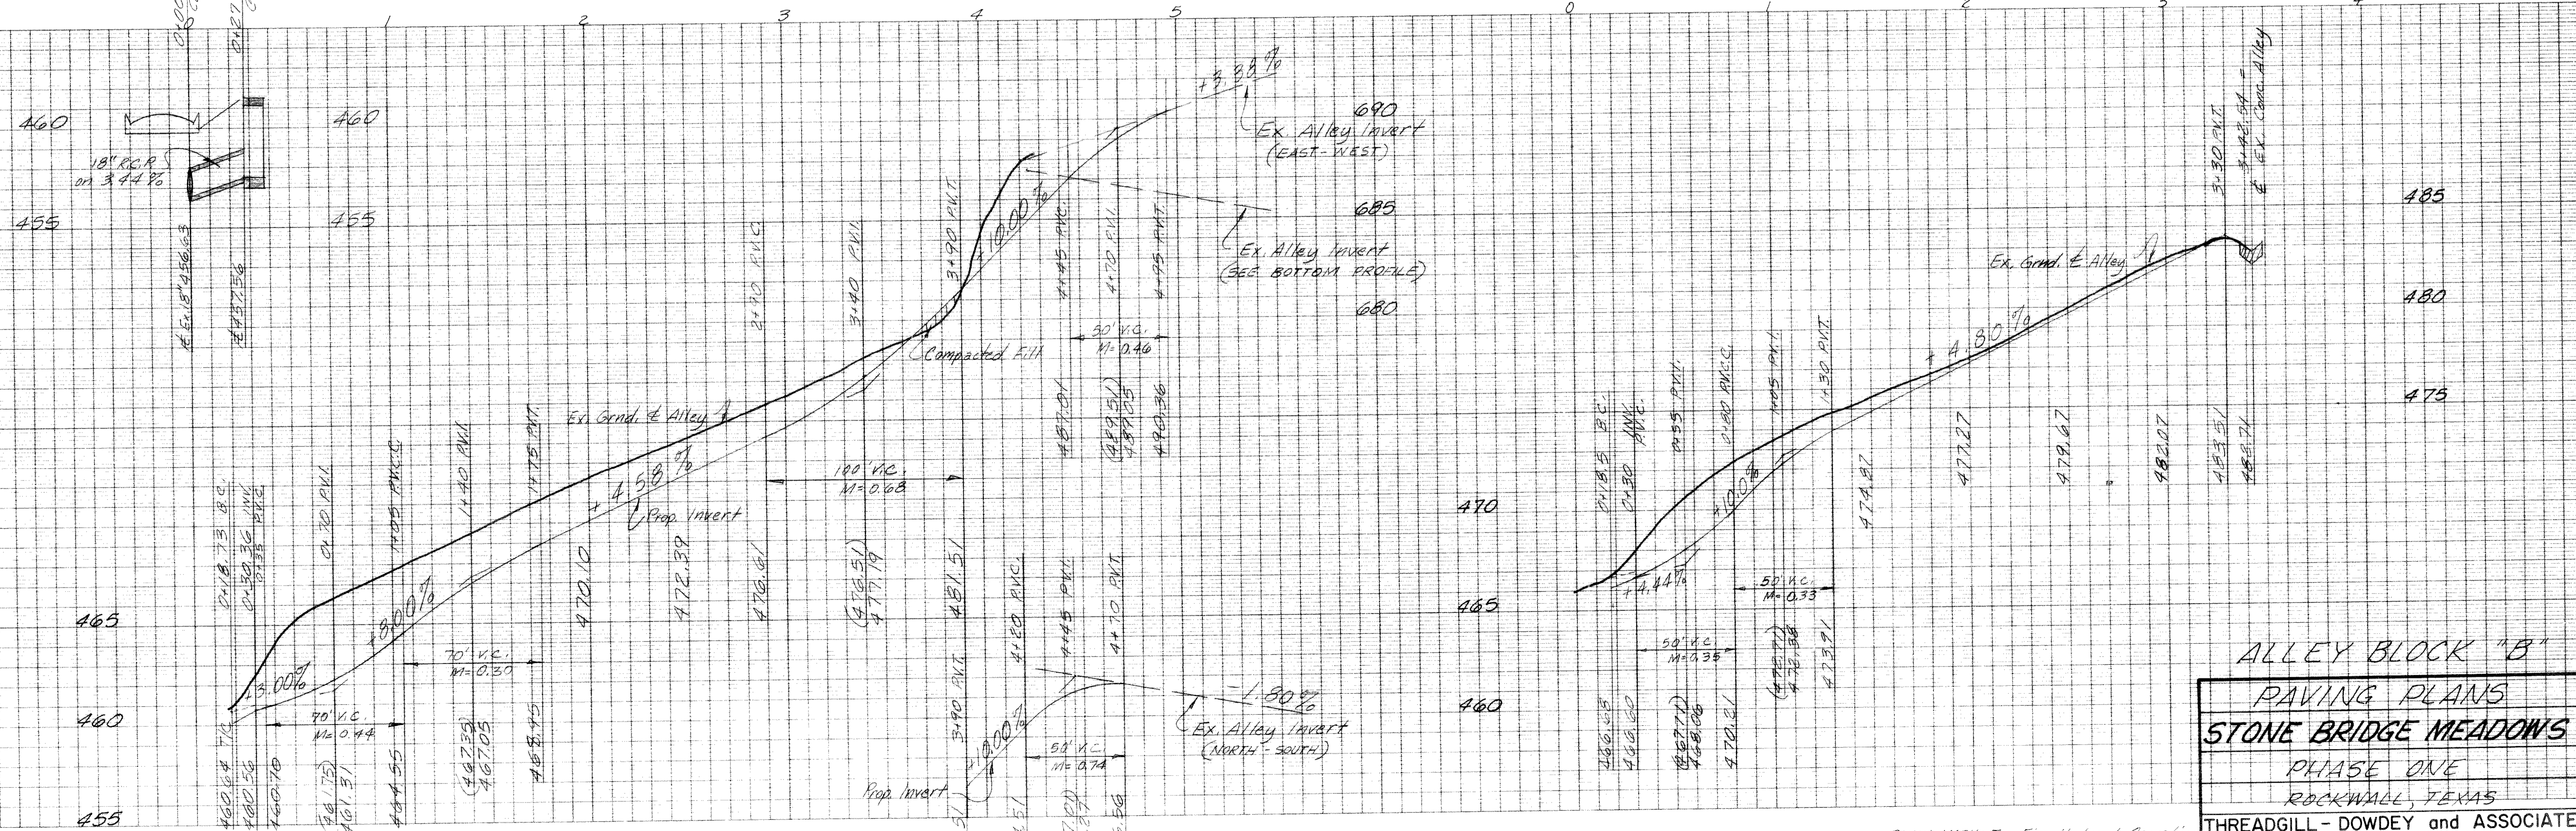

ALLEY BLOCK "B"
 PAVING PLANS
 STONE BRIDGE MEADOWS
 PHASE ONE
 ROCKWALL, TEXAS

THREADGILL - DOWDEY and ASSOCIATES		CONSULTING ENGINEERS		DALLAS, TEXAS	
DESIGN	DRAWN	CHECKED	DATE	SCALE	JOB SHEET
ARW	RE	JCH	10-76	1/4" = 1'-0"	24

BENCH MARK: Top Fire Hydrant Operating
 pit at south Property Line,
 west side Lake Shore Drive,
 Elev. 468.86