


- NOTES:
1. All construction performed shall be in accordance with City of Rockwall ordinances and specifications.
 2. Locations of all existing facilities, i.e. pipelines, cables, electricity, telephone, etc., shall be verified in the field by the contractor. It shall be the responsibility of the contractor to notify the proper agencies prior to construction.

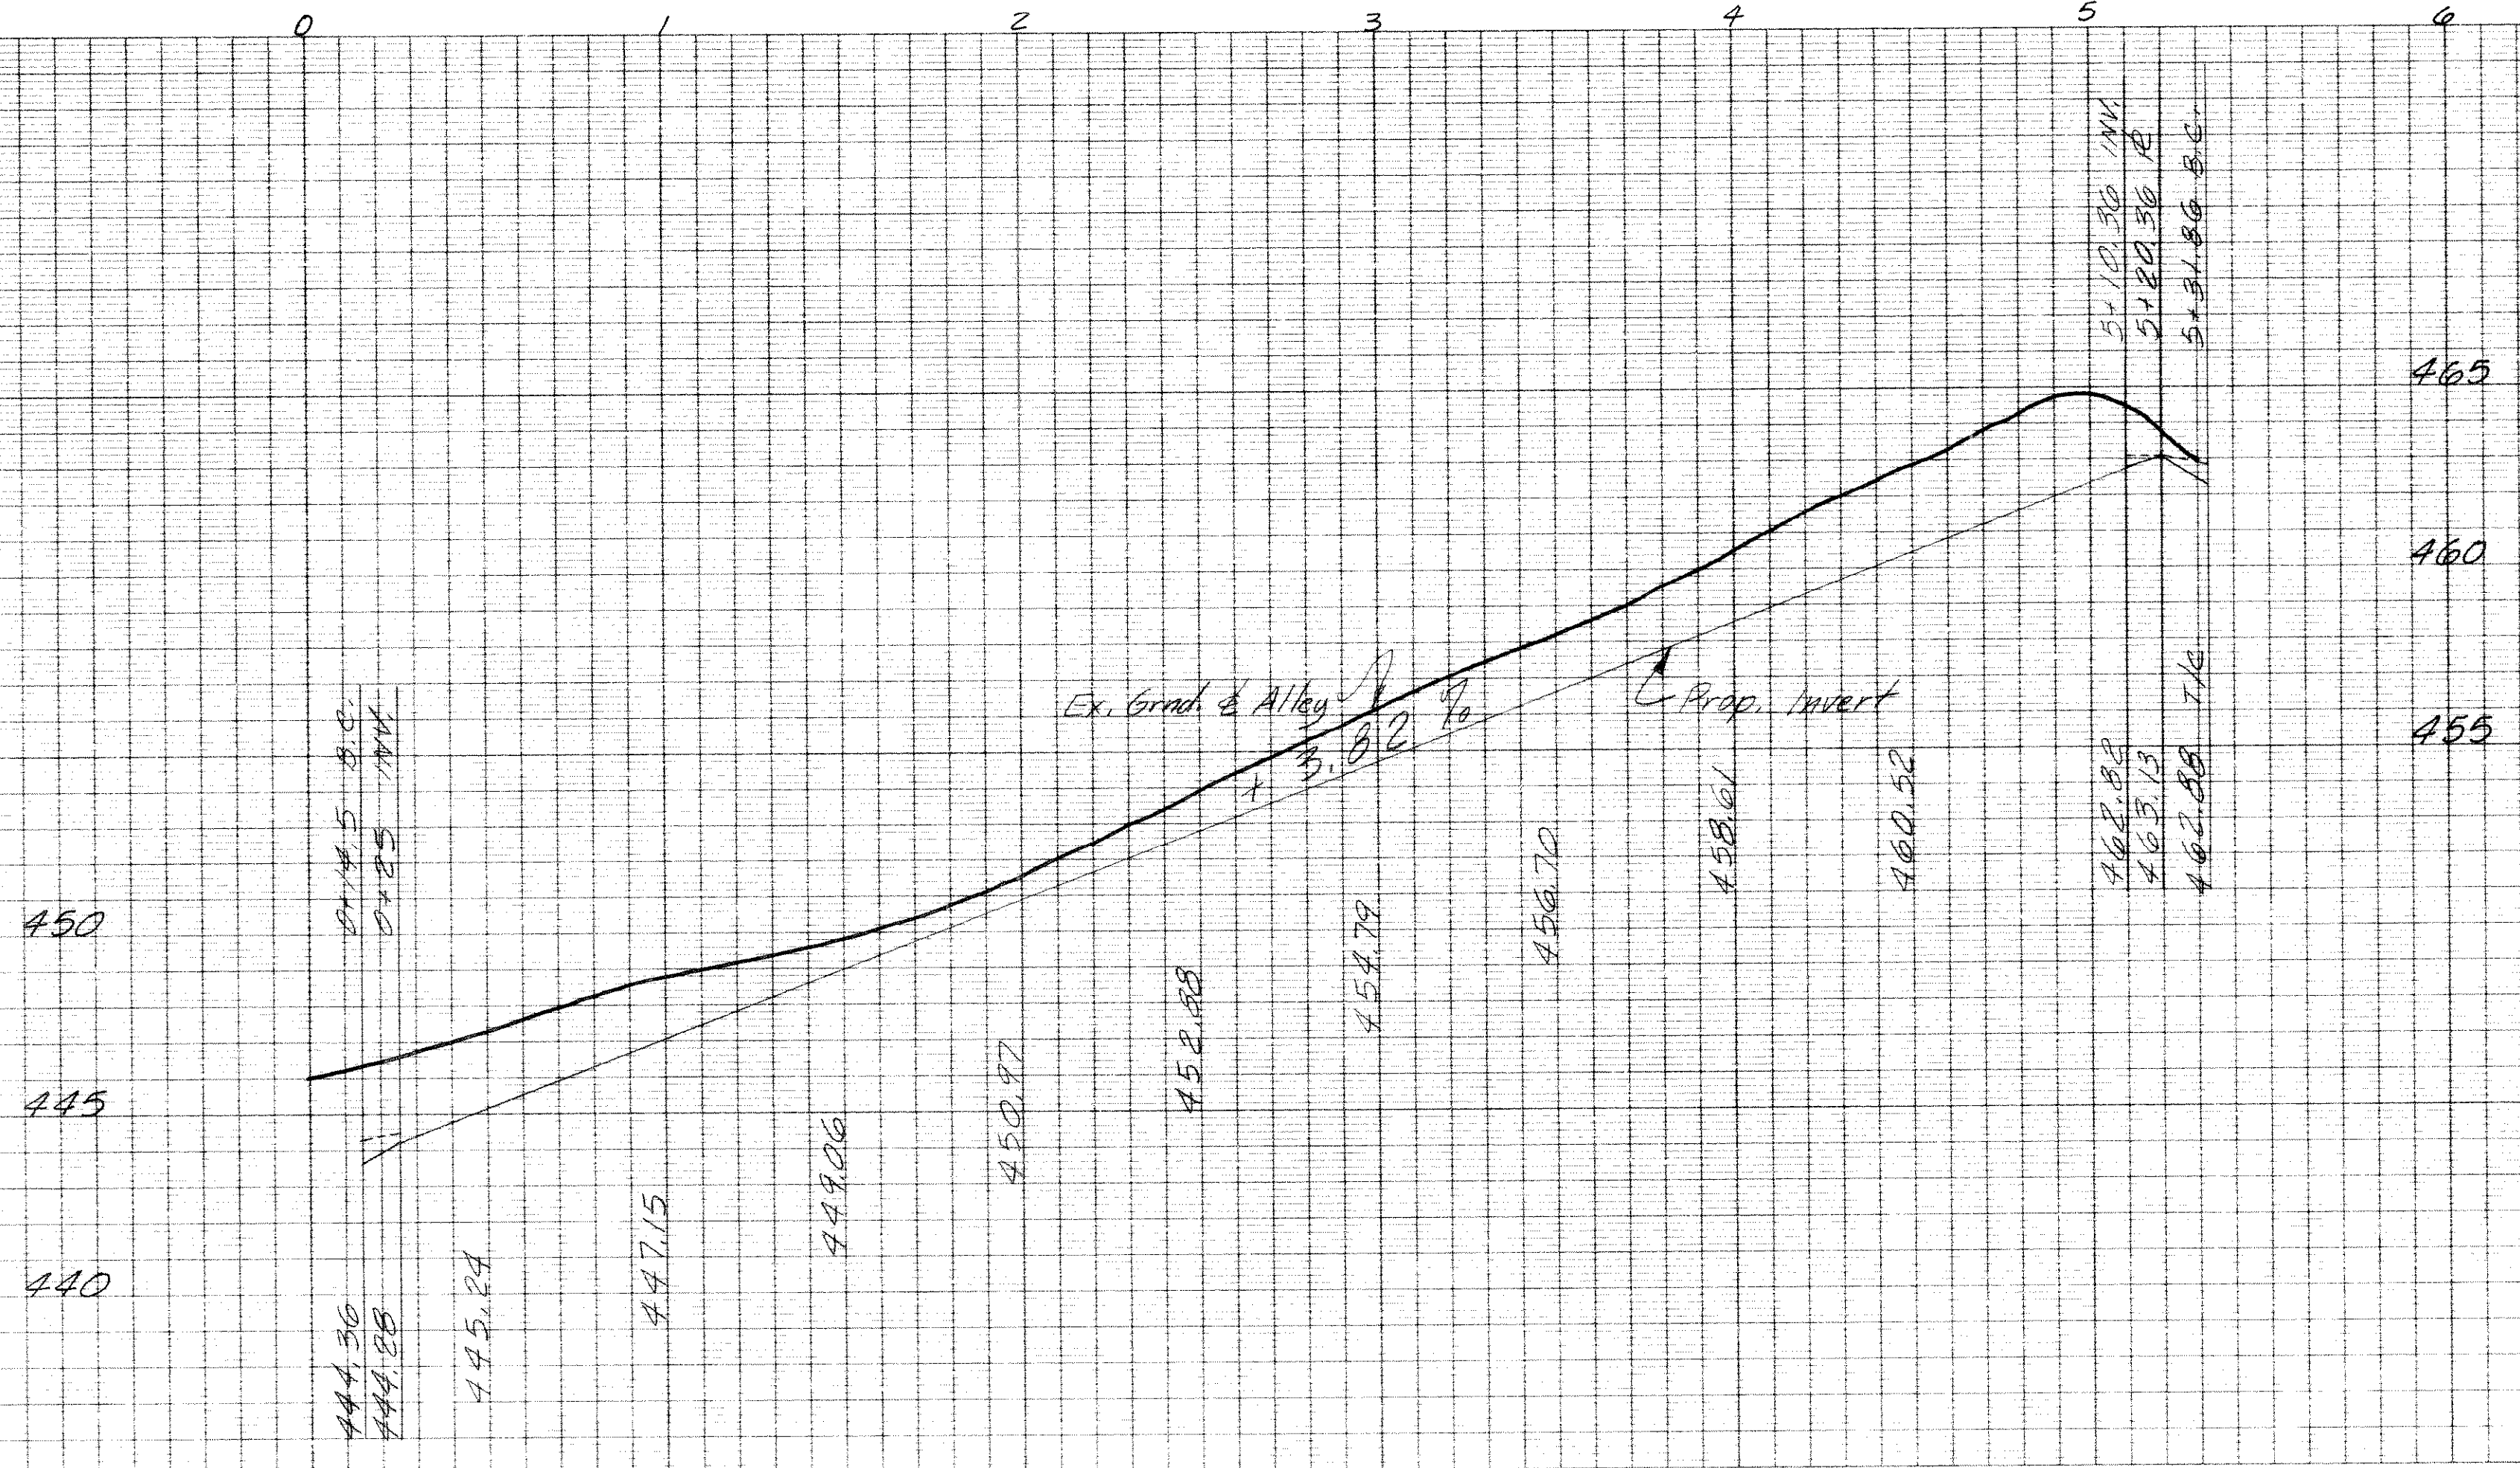

NO. 1305 - PLAN PROFILE PLATE A
 CLEARPRINT PAPER CO.
 MADE IN U.S.A.

BENCH MARK: 700 Fire Hydrant Operating
 pit, at South property line,
 West side Lake Shore Drive
 Elev. 468.86

ALLEY BLOCK "C"
 RAVING PLANS
 STONE BRIDGE MEADOWS
 PHASE ONE
 ROCKWALL, TEXAS

THREADGILL - DOWDEY and ASSOCIATES
 CONSULTING ENGINEERS DALLAS, TEXAS

DESIGN	DRAWN	CHECKED	DATE	SCALE	JOB	SHEET
ARW	RE	JCH	10-76	1/4" = 1'-0"	456-E	3/4