


- NOTES:
1. All construction performed shall be in accordance with City of Rockwall ordinances and specifications.
 2. Locations of all existing facilities, i.e. pipelines, cables, electricity, telephone, etc., shall be verified in the field by the contractor. It shall be the responsibility of the contractor to notify the proper agencies prior to construction.

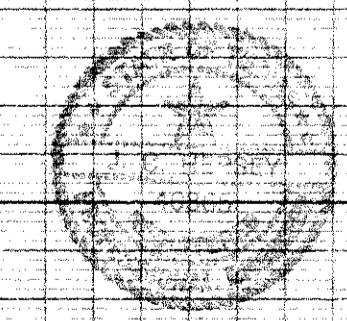

AS BUILT
SANITARY SEWER PROFILES
STONE BRIDGE MEADOWS
PHASE ONE
ROCKWALL, TEXAS

THREADGILL, DOWDEY and ASSOCIATES CONSULTING ENGINEERS DALLAS, TEXAS						
DESIGN	DRAWN	CHECKED	DATE	SCALE	JOB	SHEET
MH	MH	JCH	10-76	1"=100' 1/2"=4'	456-E	2/2

BENCH MARK: Top Fire Hydrant Operating
 not at South Property Line,
 West Side Lake Shore Drive.
 Elev. 468.86