


REINFORCED CONCRETE PAVEMENT JOINTS	North Central Texas Council of Governments	STANDARD SPECIFICATION REFERENCE	5.8.
		DATE	NOV. '96
		STANDARD DRAWING NO.	2050

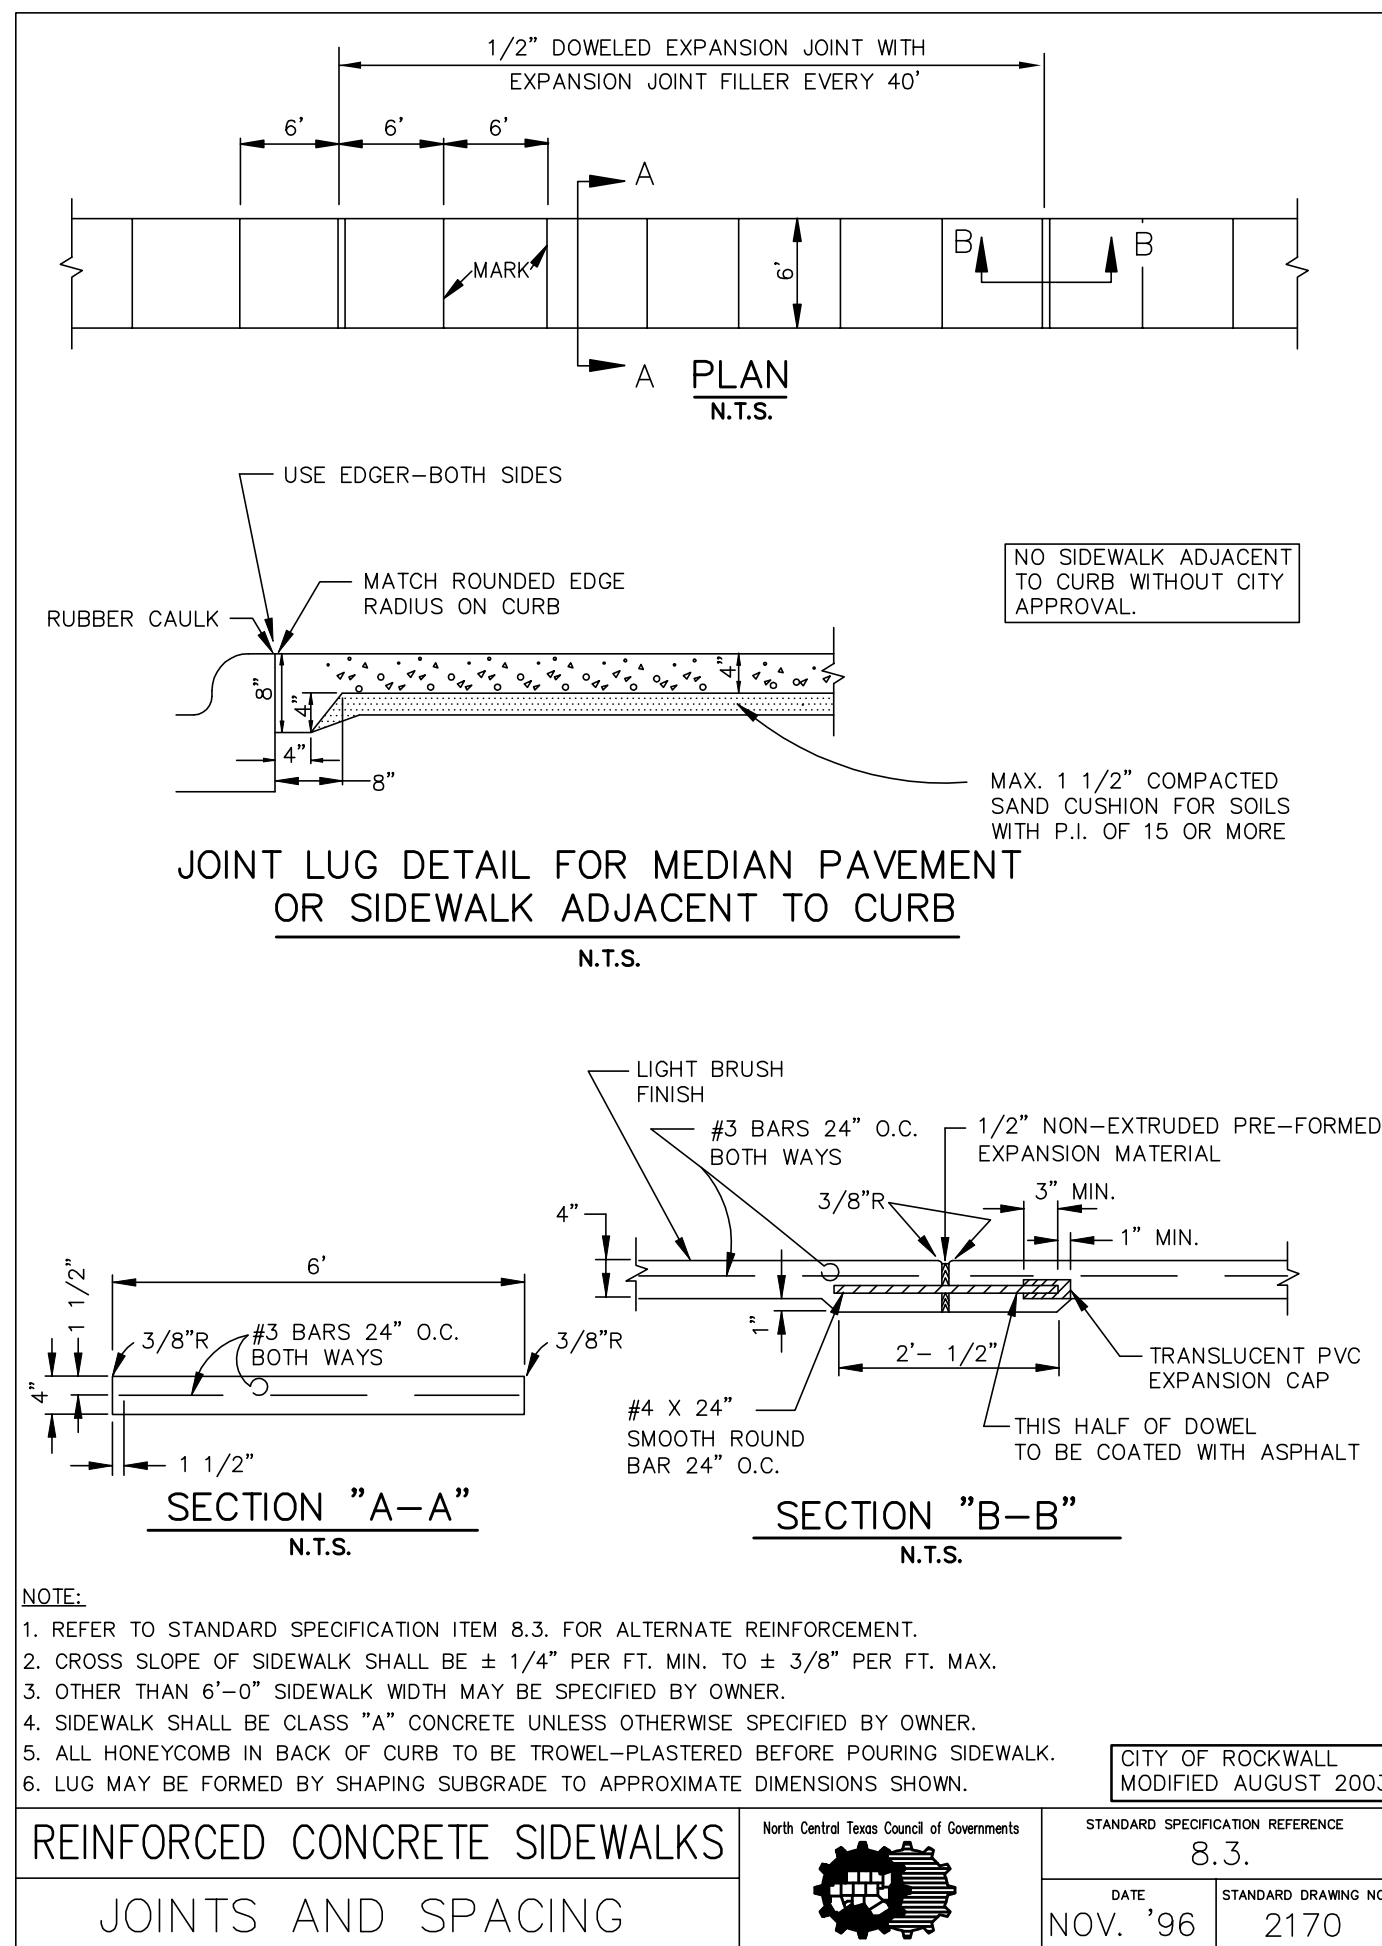


REINFORCED CONCRETE SIDEWALKS JOINTS AND SPACING	North Central Texas Council of Governments	STANDARD SPECIFICATION REFERENCE	8.3.
		DATE	NOV. '96
		STANDARD DRAWING NO.	2170


GENERAL NOTES:

- REINFORCED CONCRETE PAVEMENT:
 - ALL CURBS SHALL BE PLACED INTEGRAL WITH PAVEMENT UNLESS OTHERWISE APPROVED BY THE OWNER.
 - CURBS SHALL MEET THE SAME COMPRESSIVE STRENGTH AS SPECIFIED FOR THE PAVEMENT.
 - BAR LAPS SHALL BE 30 DIAMETERS.
 - REINFORCING BARS SHALL BE SUPPORTED BY CHAIRS OR OTHER DEVICES APPROVED BY THE OWNER.
- SUBGRADE: (UNLESS OTHERWISE SPECIFIED BY OWNER)
 - SUBGRADE UNDER ALL PAVEMENTS SHALL BE STABILIZED TO A MINIMUM DEPTH OF SIX INCHES (6") WITH HYDRATED LIME OR CEMENT. THE P.I. OF THE INPLACE MATERIAL IS GREATER THAN 15. LABORATORY TESTS MUST BE PERFORMED TO DETERMINE THE AMOUNT OF LIME OR CEMENT TO BE USED.


PAVEMENT SYSTEMS	North Central Texas Council of Governments	STANDARD SPECIFICATION REFERENCE	8.3.
		DATE	NOV. '96
		STANDARD DRAWING NO.	2190

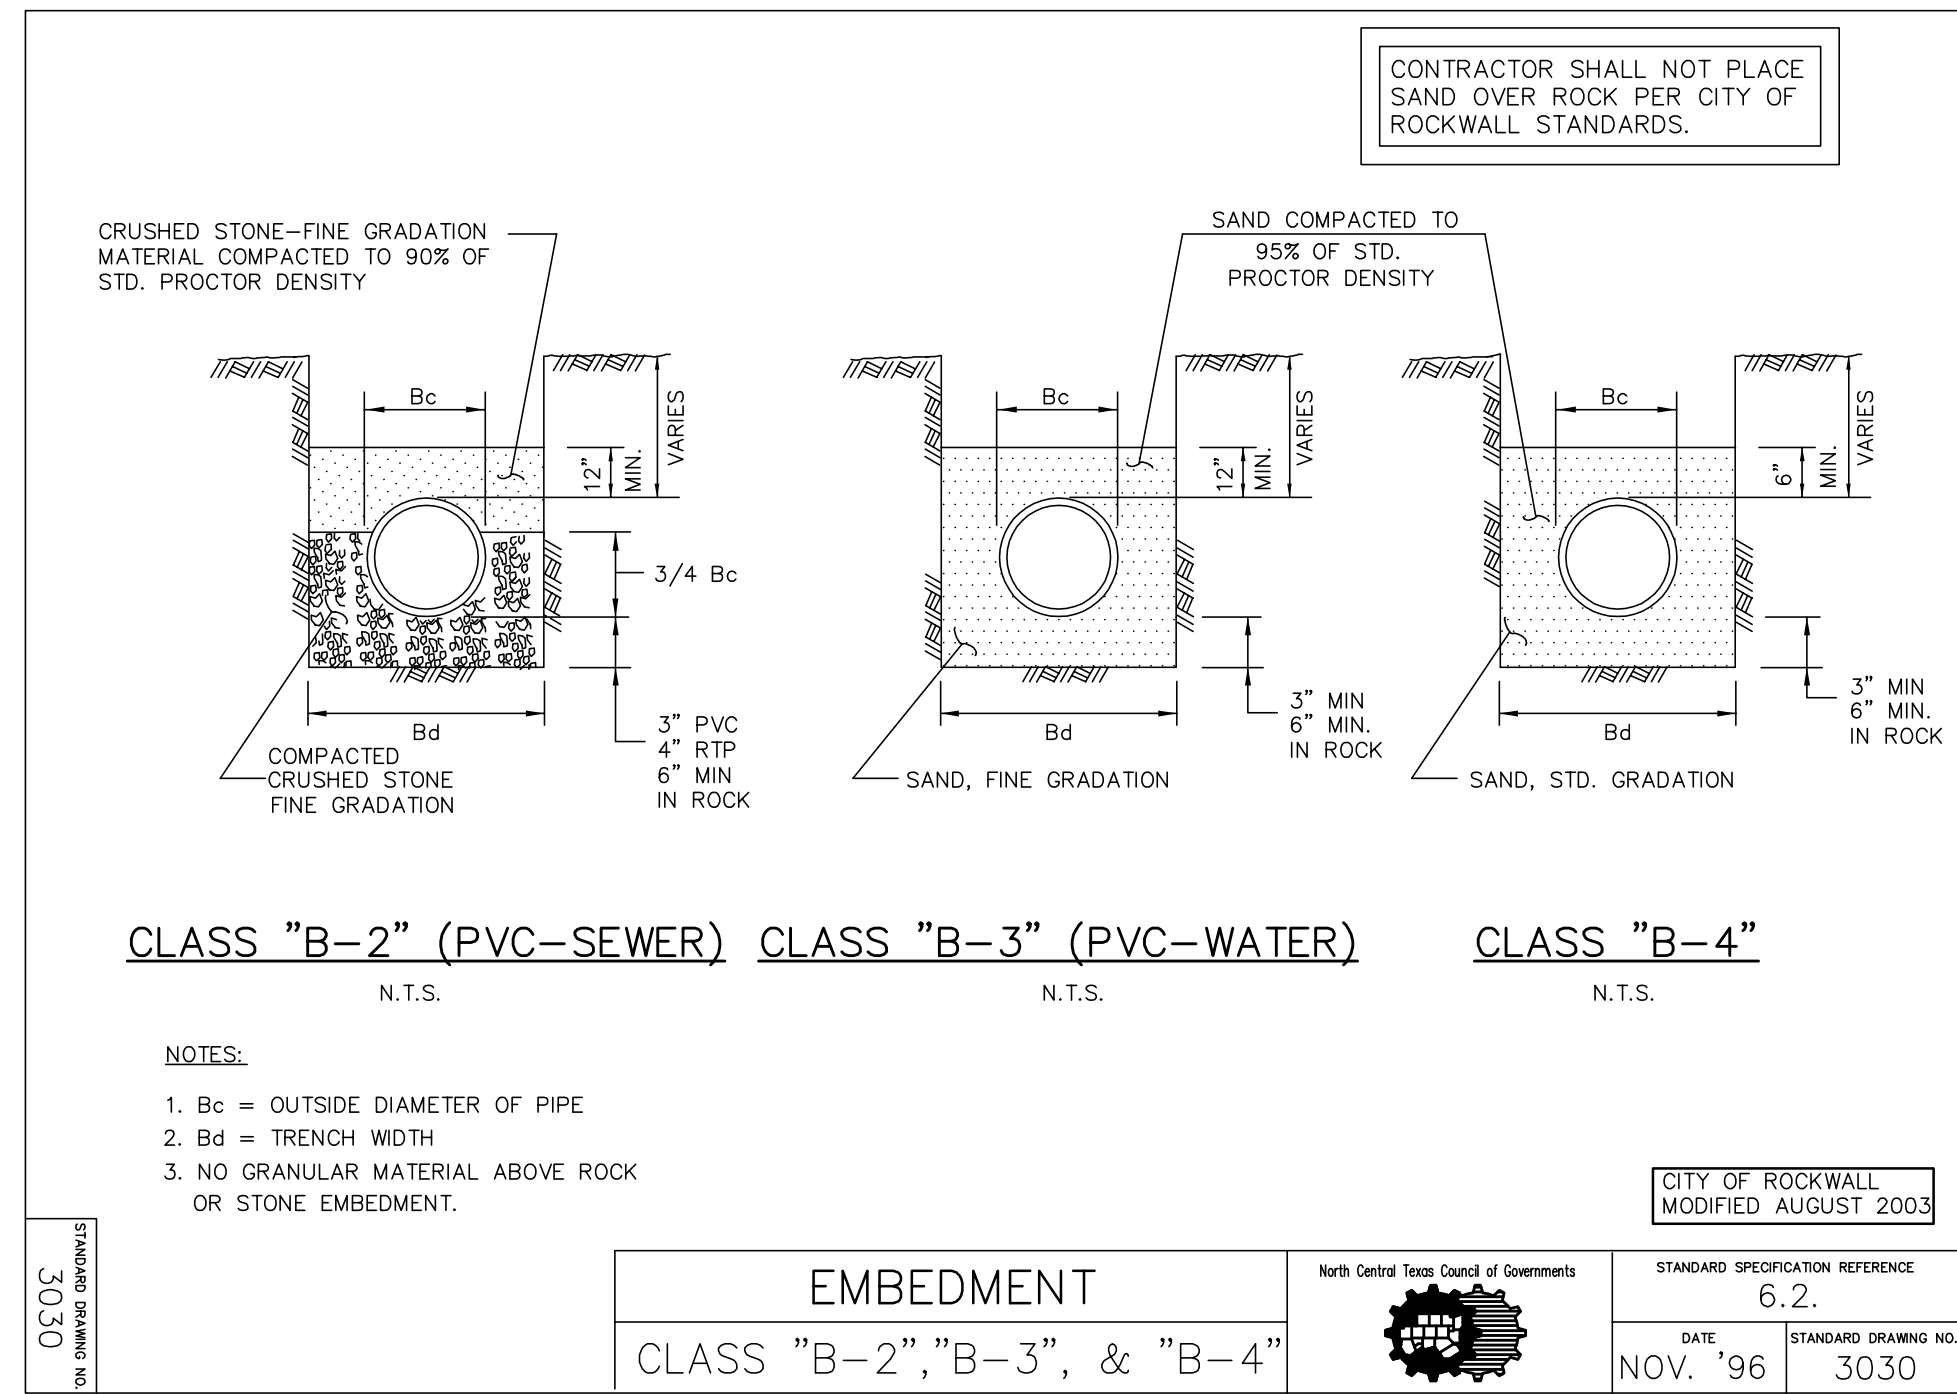

EMBEDMENT	North Central Texas Council of Governments	STANDARD SPECIFICATION REFERENCE	6.2.
		DATE	NOV. '96
		STANDARD DRAWING NO.	3030

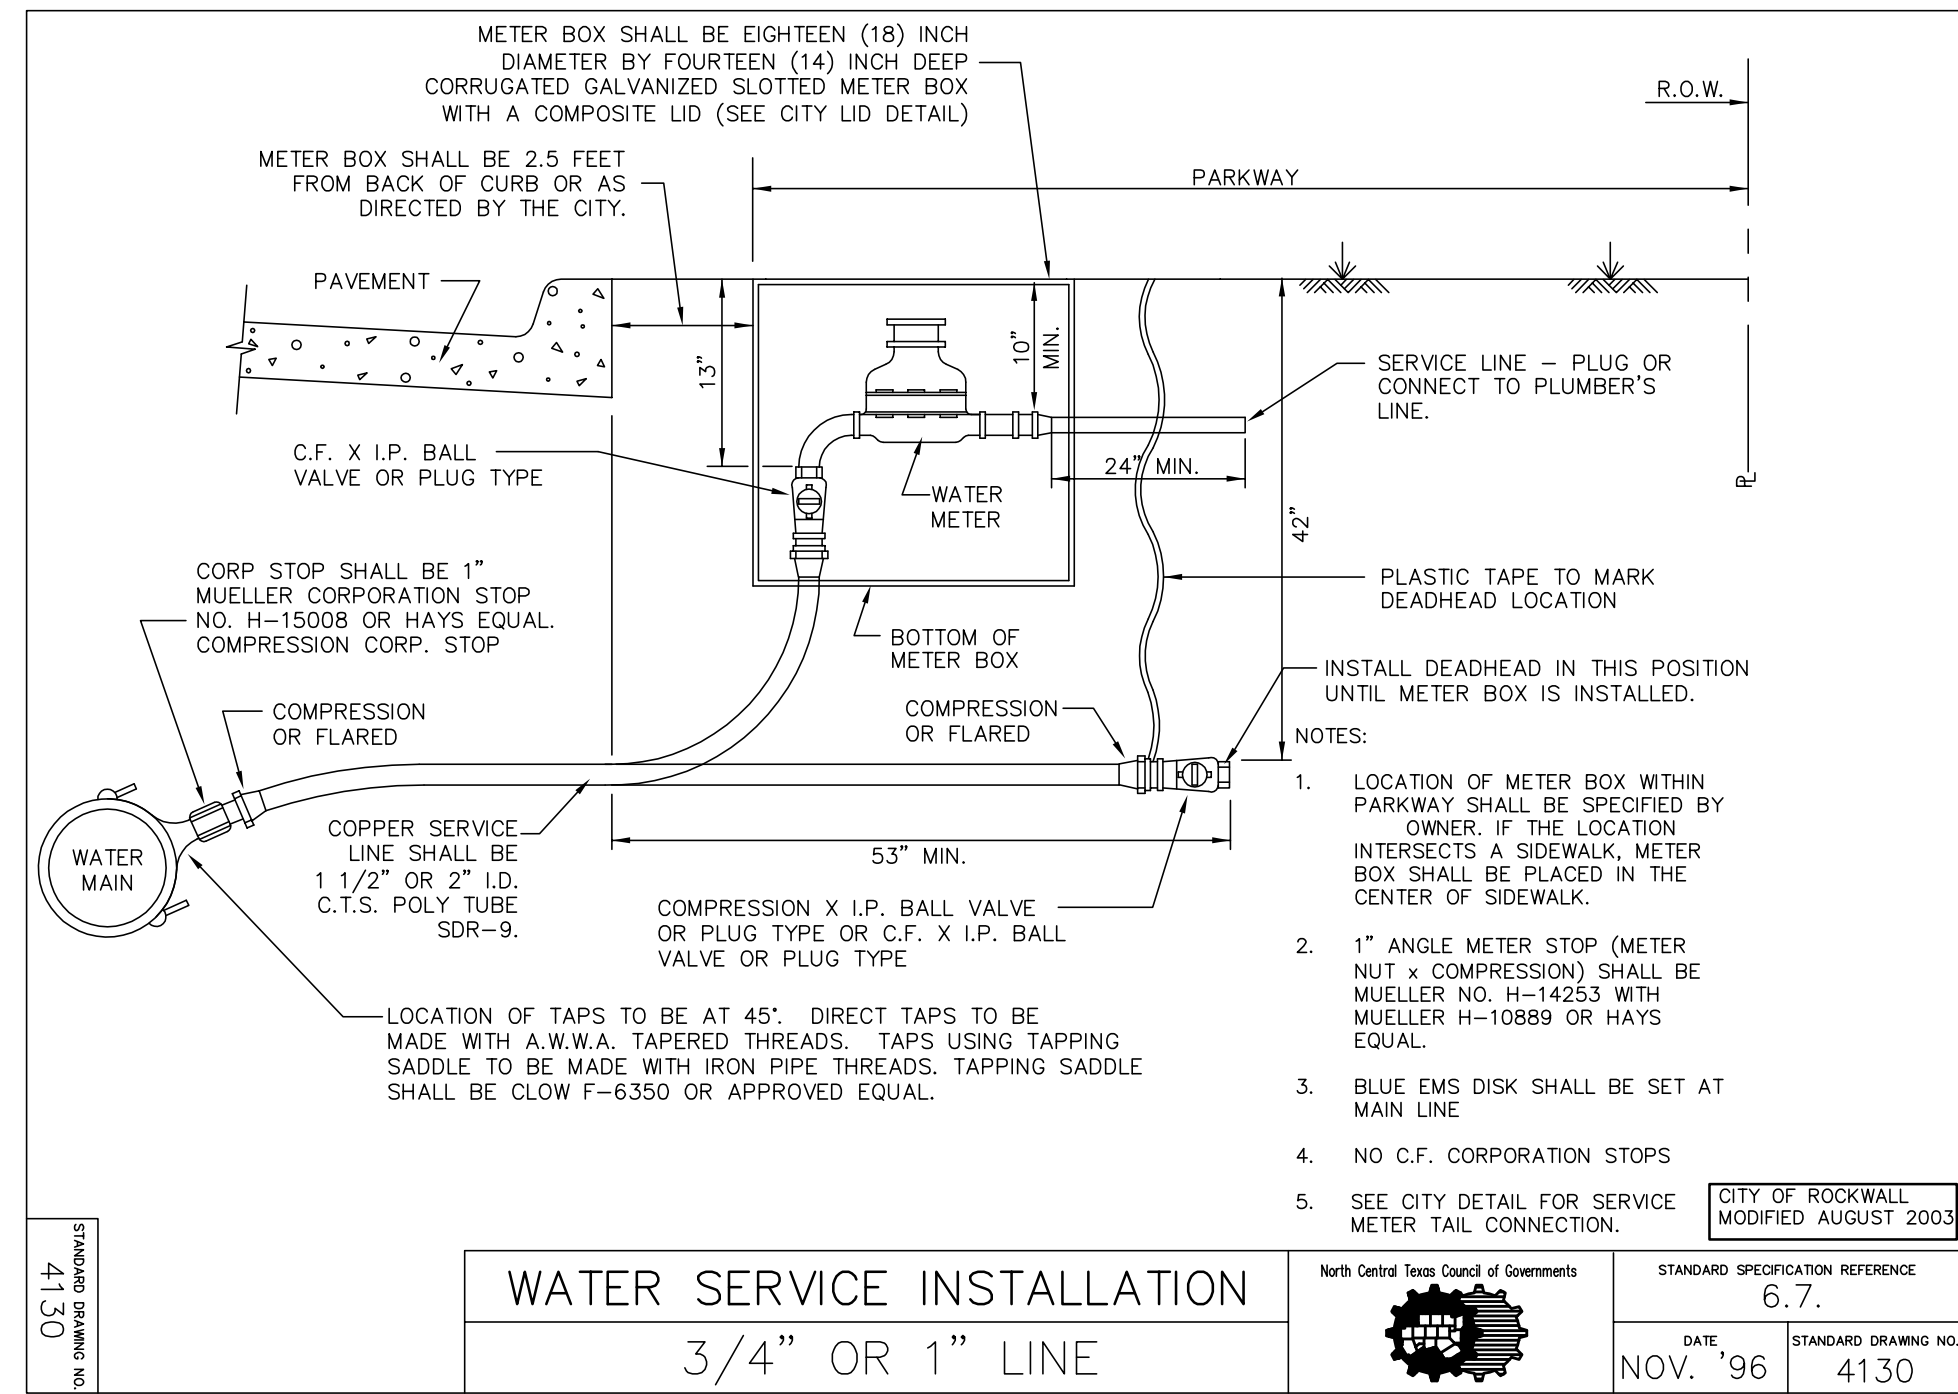

WATER SERVICE INSTALLATION	North Central Texas Council of Governments	STANDARD SPECIFICATION REFERENCE	6.7.
		DATE	NOV. '96
		STANDARD DRAWING NO.	4130

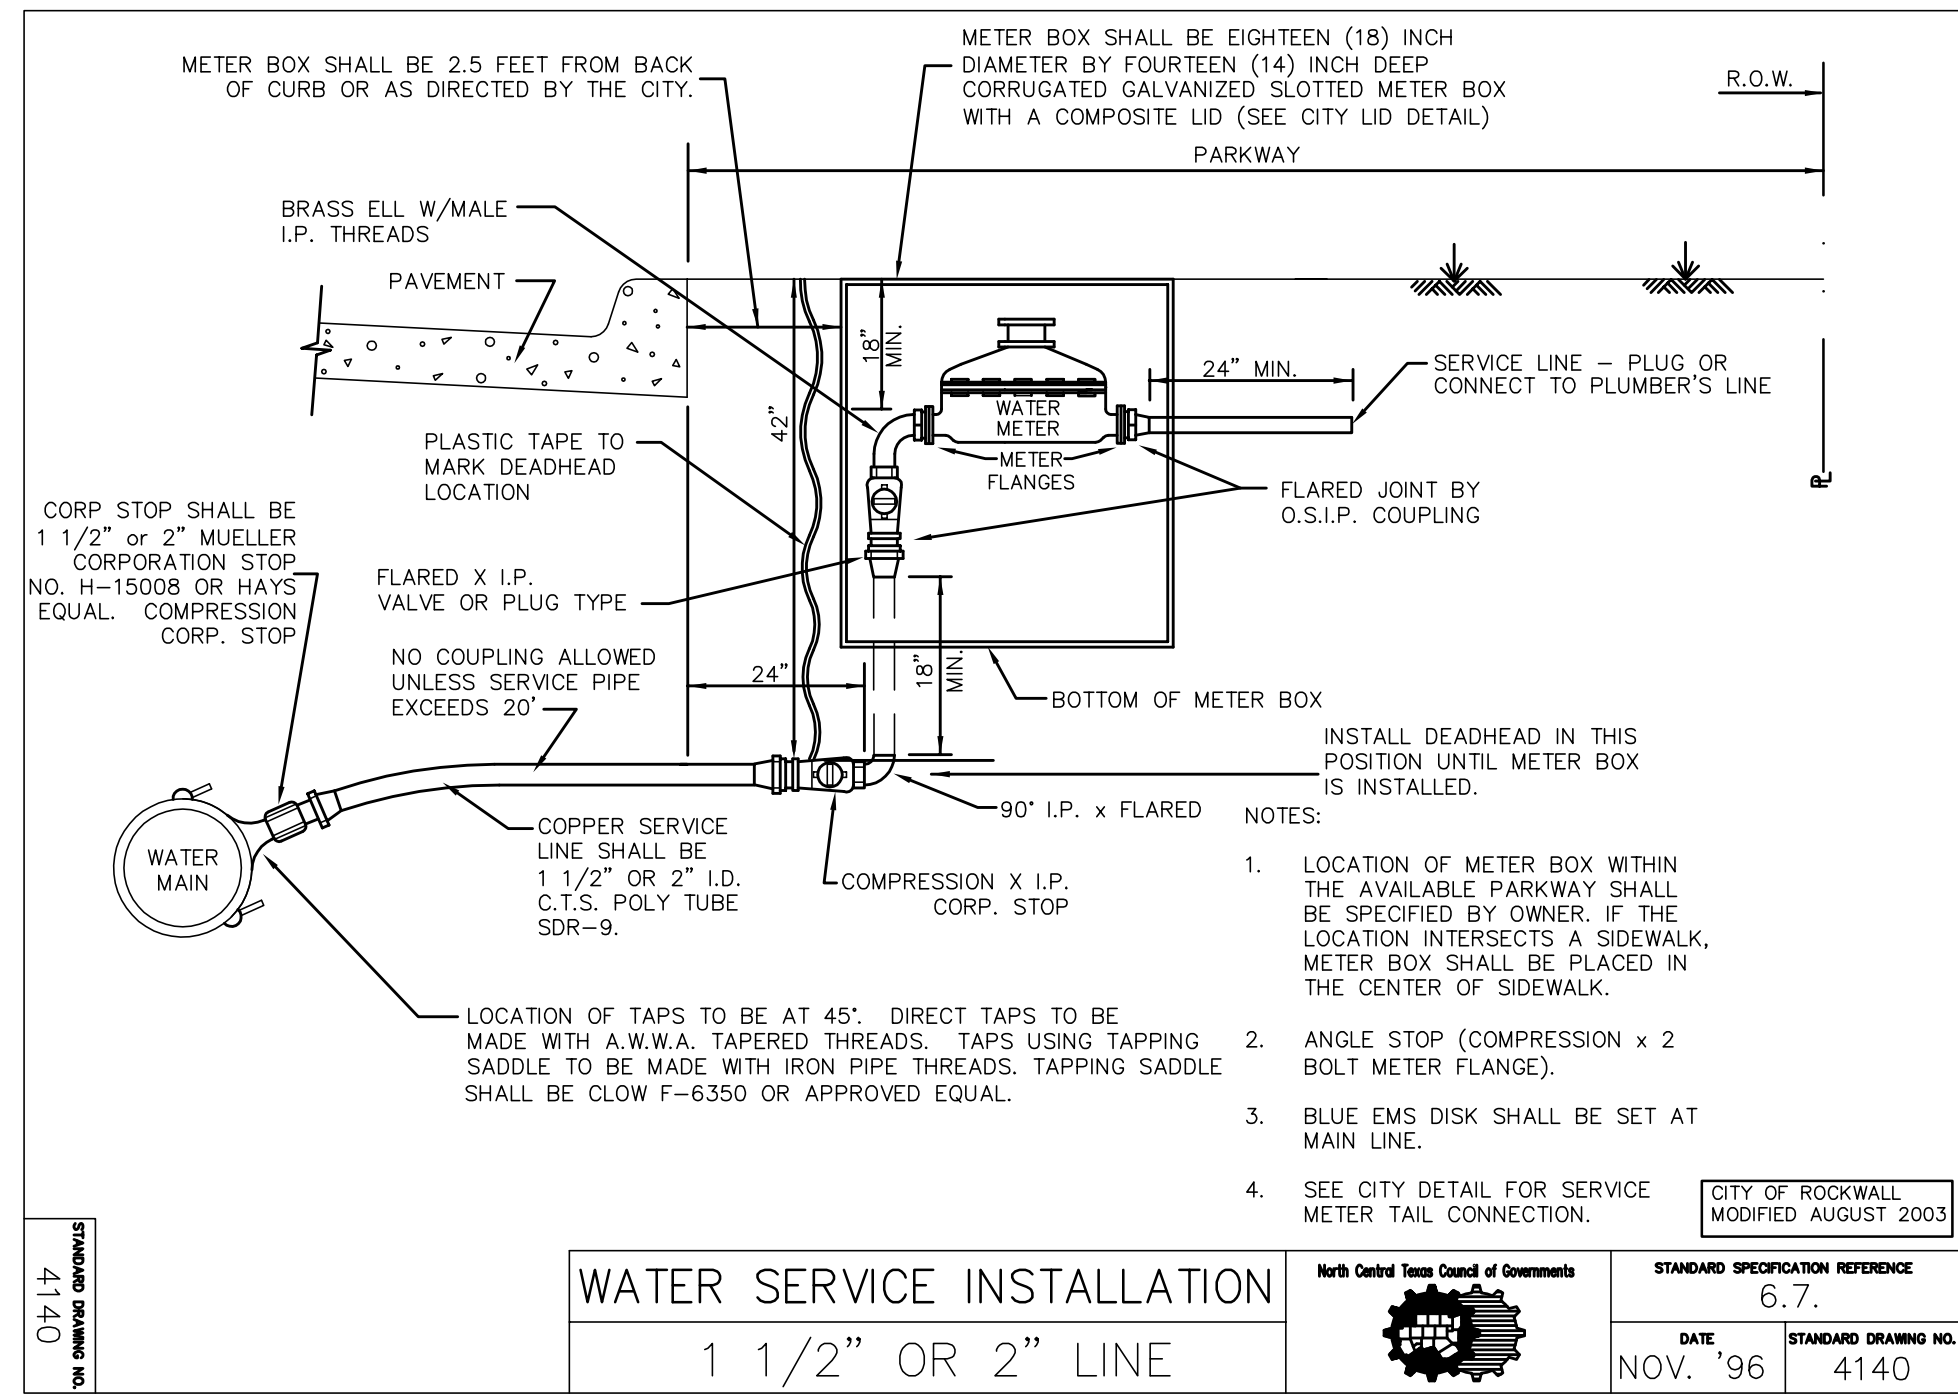

WATER SERVICE INSTALLATION	North Central Texas Council of Governments	STANDARD SPECIFICATION REFERENCE	6.7.
		DATE	NOV. '96
		STANDARD DRAWING NO.	4140

RECORD DRAWING

To the best of our knowledge, Homeyer Engineering, Inc., hereby states that this plan is a Record Drawing. The information provided is based on surveying conducted at the site and information provided by the contractor.

Steven R. Homeyer
Steven R. Homeyer, P.E. #86942
Date: 07-01-2008



THE SEAL APPEARING ON THIS DOCUMENT WAS AUTHORIZED BY STEVEN R. HOMEYER, P.E. 86942 ON JULY 1, 2008.

HOMEYER ENGINEERING, INC.
CIVIL ENGINEERING, PLANNING, SITE & LAND PLANNING
P.O. BOX 294527 • LEWISVILLE, TEXAS • 75039
972-909-0100 • WWW.HOMEYERENGINEERING.COM

STONEBRIDGE VETERINARY
1.085 ACRES
ZONED - GR/SH 66 OVERLAY
CITY OF ROCKWALL
ROCKWALL COUNTY, TEXAS

CITY OF ROCKWALL
STANDARD DETAILS

DRAWN BY: BSZ
DATE: 10/15/07
HEI #: 07-168
SHEET NO: C13