


THE SEAL APPEARING ON THIS DOCUMENT WAS AUTHORIZED BY STEVEN R. HOMEYER, P.E. 86942 ON JULY 1, 2008.

**HOMEYER**  
ENGINEERING, INC.  
CIVIL ENGINEERING • PLANNING  
SITE & LAND PLANNING  
P. O. BOX 294527 • LEWISVILLE, TEXAS • 75039  
972-906-8877 FAX  
WWW.HOMEYERENGINEERING.COM

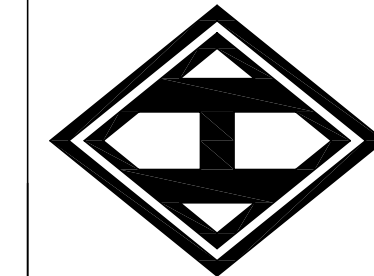

STONEBRIDGE VETERINARY  
1.085 ACRES  
ZONED - GR/SH 66 OVERLAY  
CITY OF ROCKWALL  
ROCKWALL COUNTY, TEXAS

CITY OF ROCKWALL  
STANDARD DETAILS

DRAWN BY: BSZ  
DATE: 10/15/07  
HEI #: 07-168

SHEET NO:  
C14