
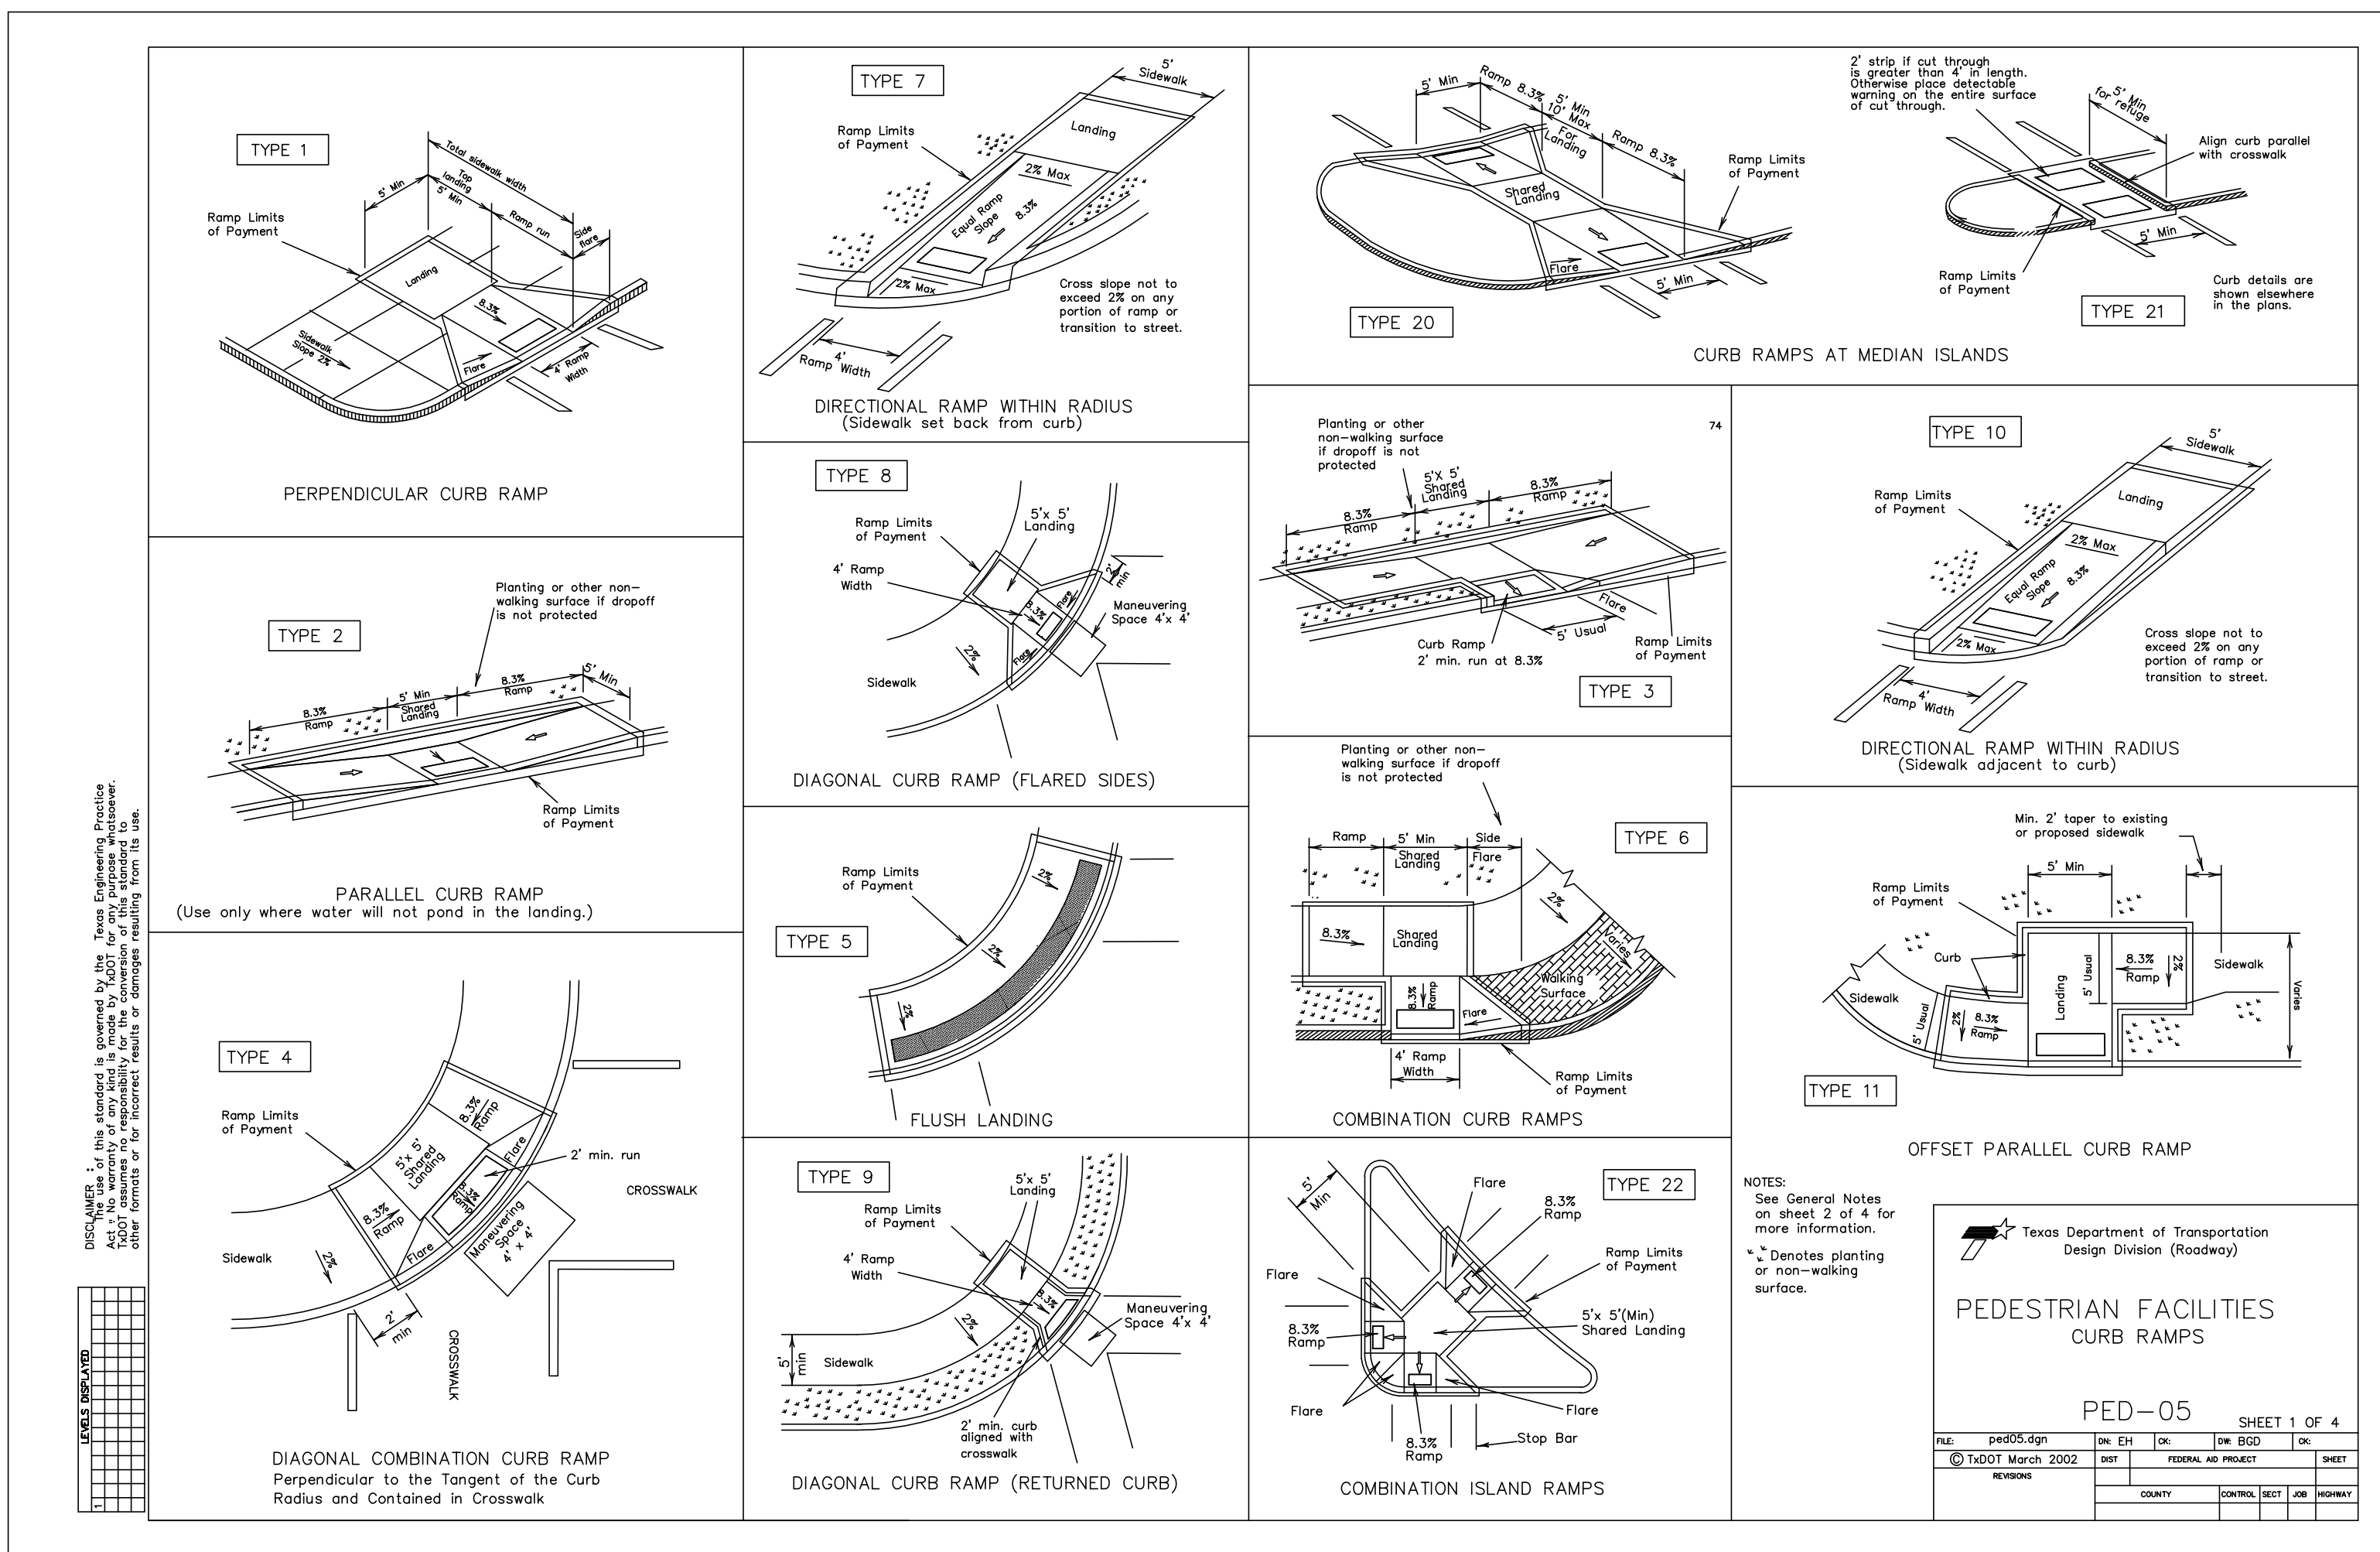


DATE: 10/15/07; TIME: 10:56:46 AM; USER: STONEBRIDGE\_VETERINARY; PROJECT: STONEBRIDGE\_VETERINARY; SHEET: ADA RAMP DETAILS; SHEET NO: 07-168; DATE: 10/15/07; TIME: 10:56:46 AM; USER: STONEBRIDGE\_VETERINARY; PROJECT: STONEBRIDGE\_VETERINARY; SHEET: ADA RAMP DETAILS; SHEET NO: 07-168

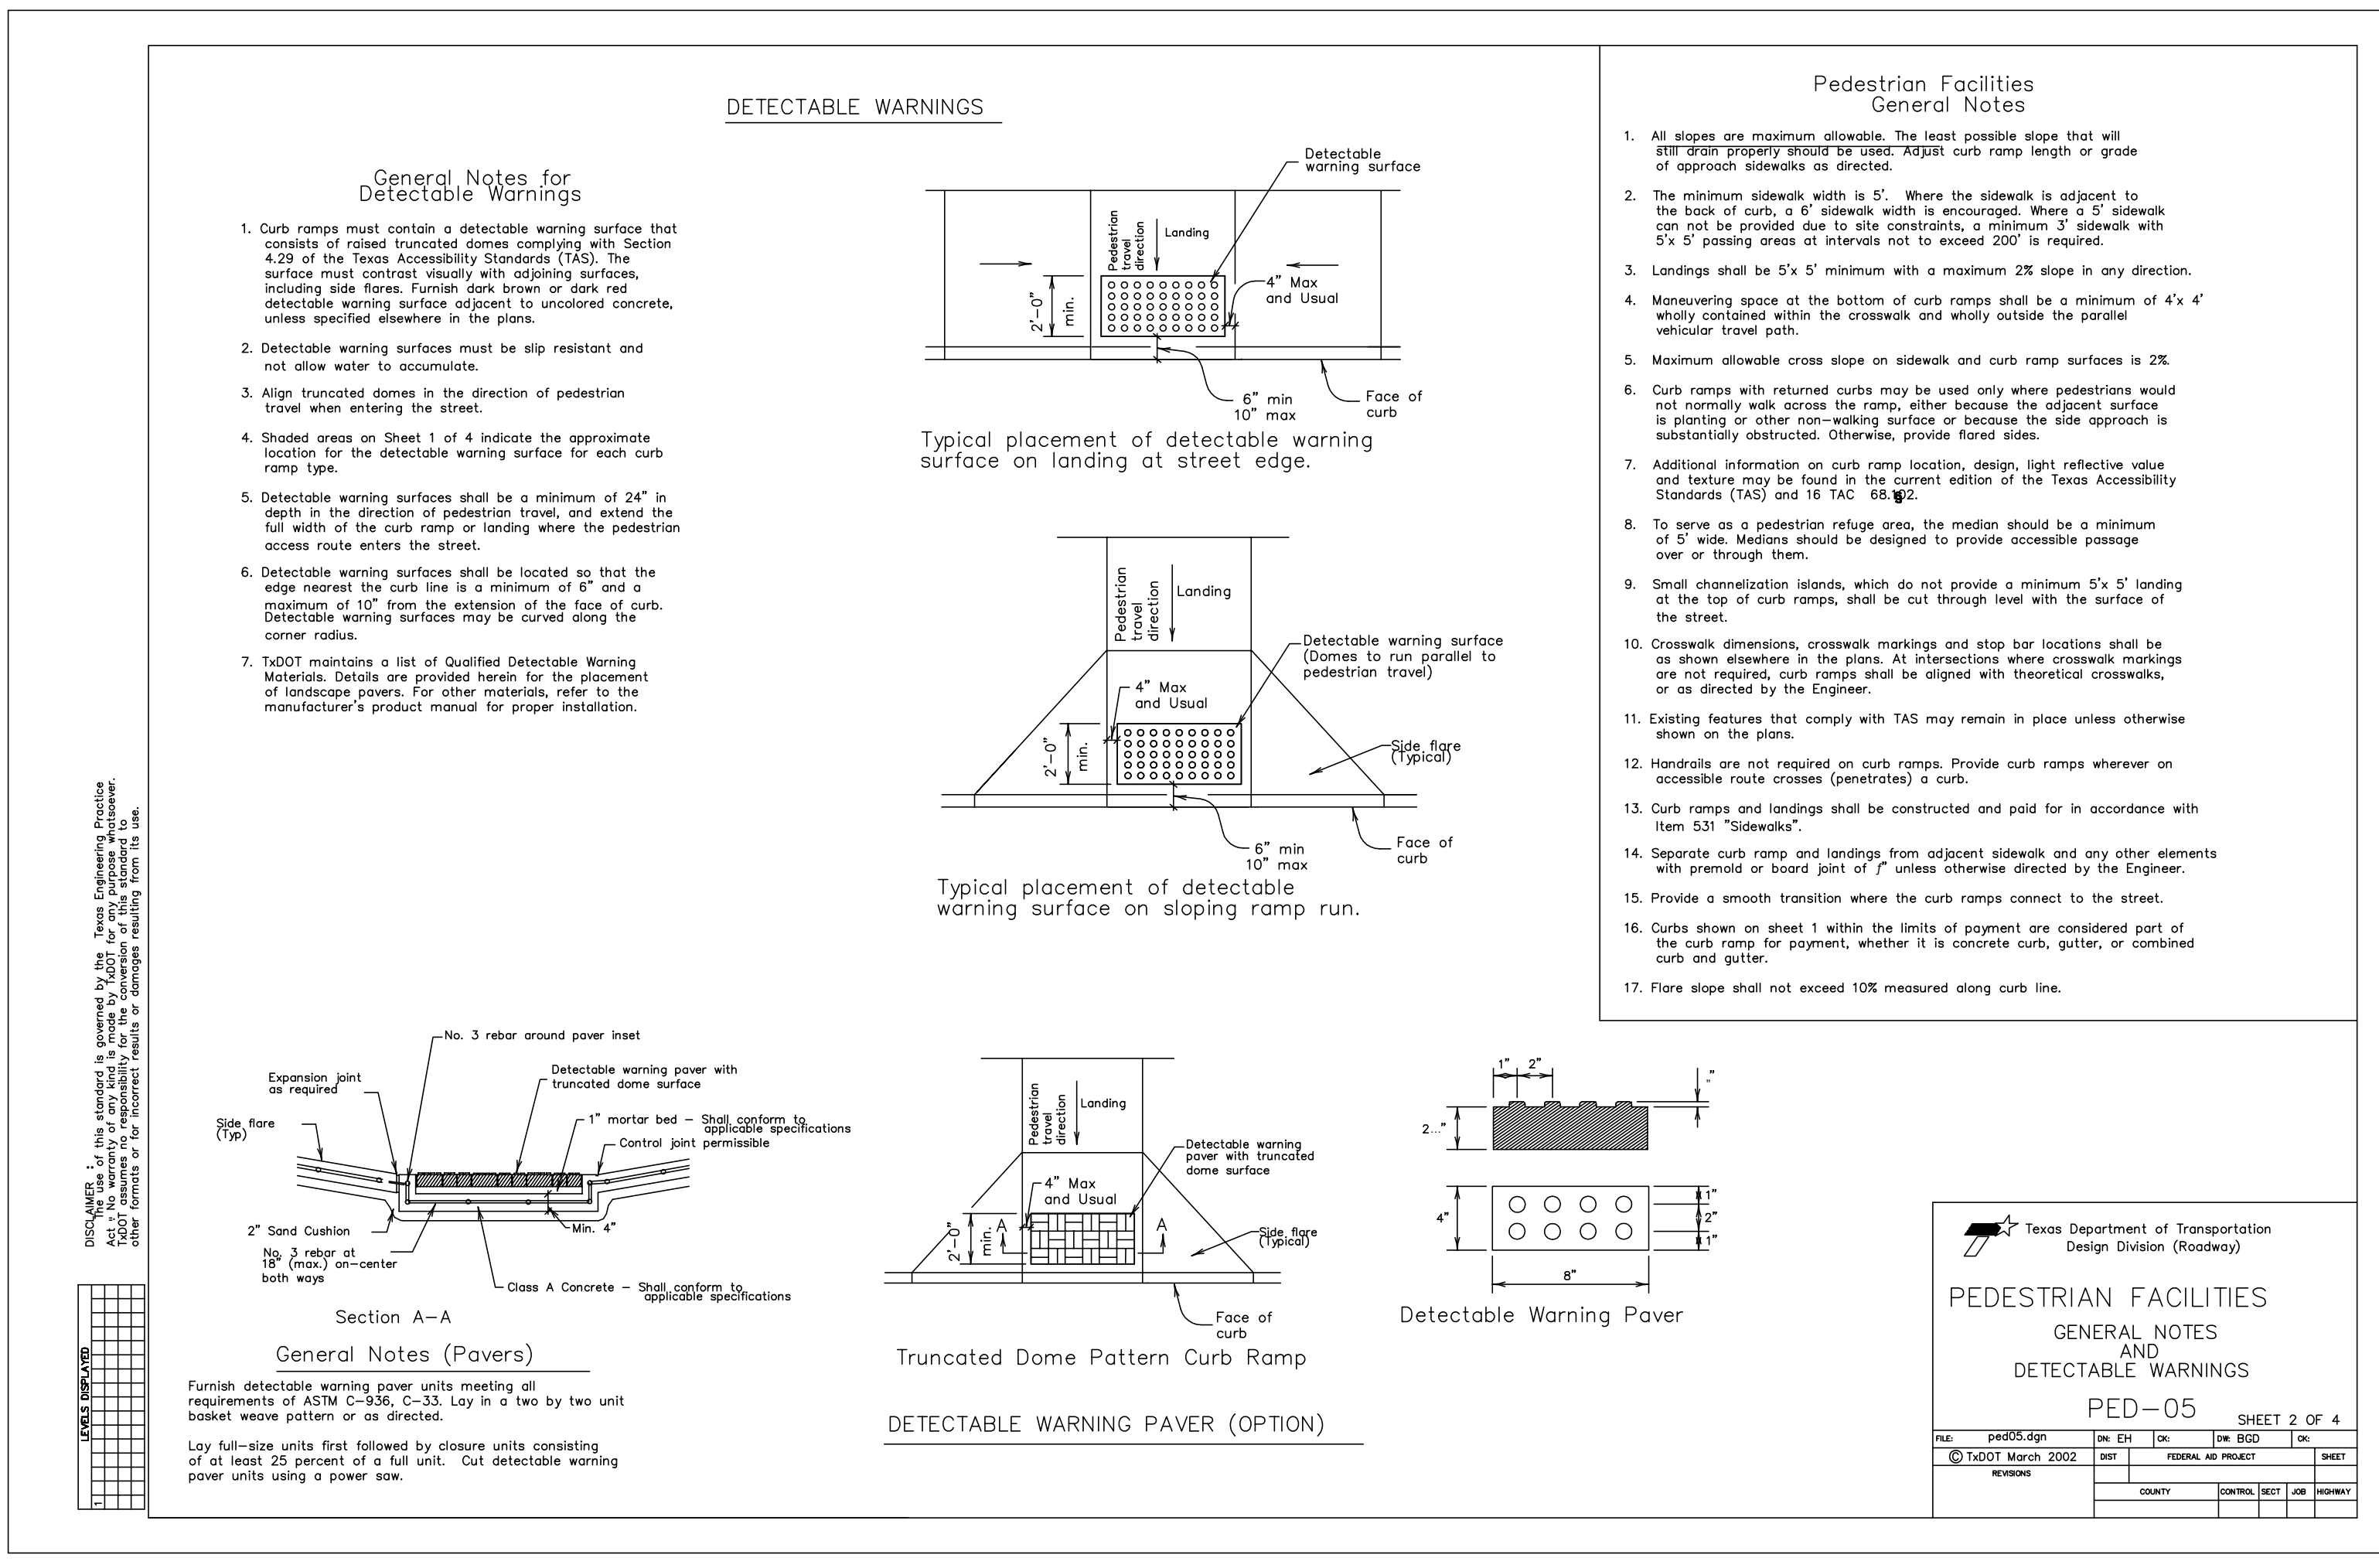

**RECORD DRAWING**

*To the best of our knowledge, Homeyer Engineering, Inc., hereby states that this plan is a Record Drawing. The information provided is based on surveying conducted at the site and information provided by the contractor.*

Steven R. Homeyer  
Steven R. Homeyer, P.E. #86942  
Date: 07-01-2008



THE SEAL APPEARING ON THIS DOCUMENT WAS AUTHORIZED BY STEVEN R. HOMEYER, P.E. #86942 ON JULY 1, 2008.

**DRAWN BY:** BSZ  
**DATE:** 10/15/07  
**HEI #:** 07-168

**SHEET NO:** C-15

**STONEBRIDGE VETERINARY**  
1.085 ACRES  
ZONED - GR/SH 66 OVERLAY  
CITY OF ROCKWALL  
ROCKWALL COUNTY, TEXAS

**HOMEYER**  
ENGINEERING, INC.  
CIVIL ENGINEERING • PLANNING  
SITE & LAND PLANNING  
P. O. BOX 294527 • LEWISVILLE, TEXAS 75029  
972-906-5750 • WWW.HOMEYERENGINEERING.COM