
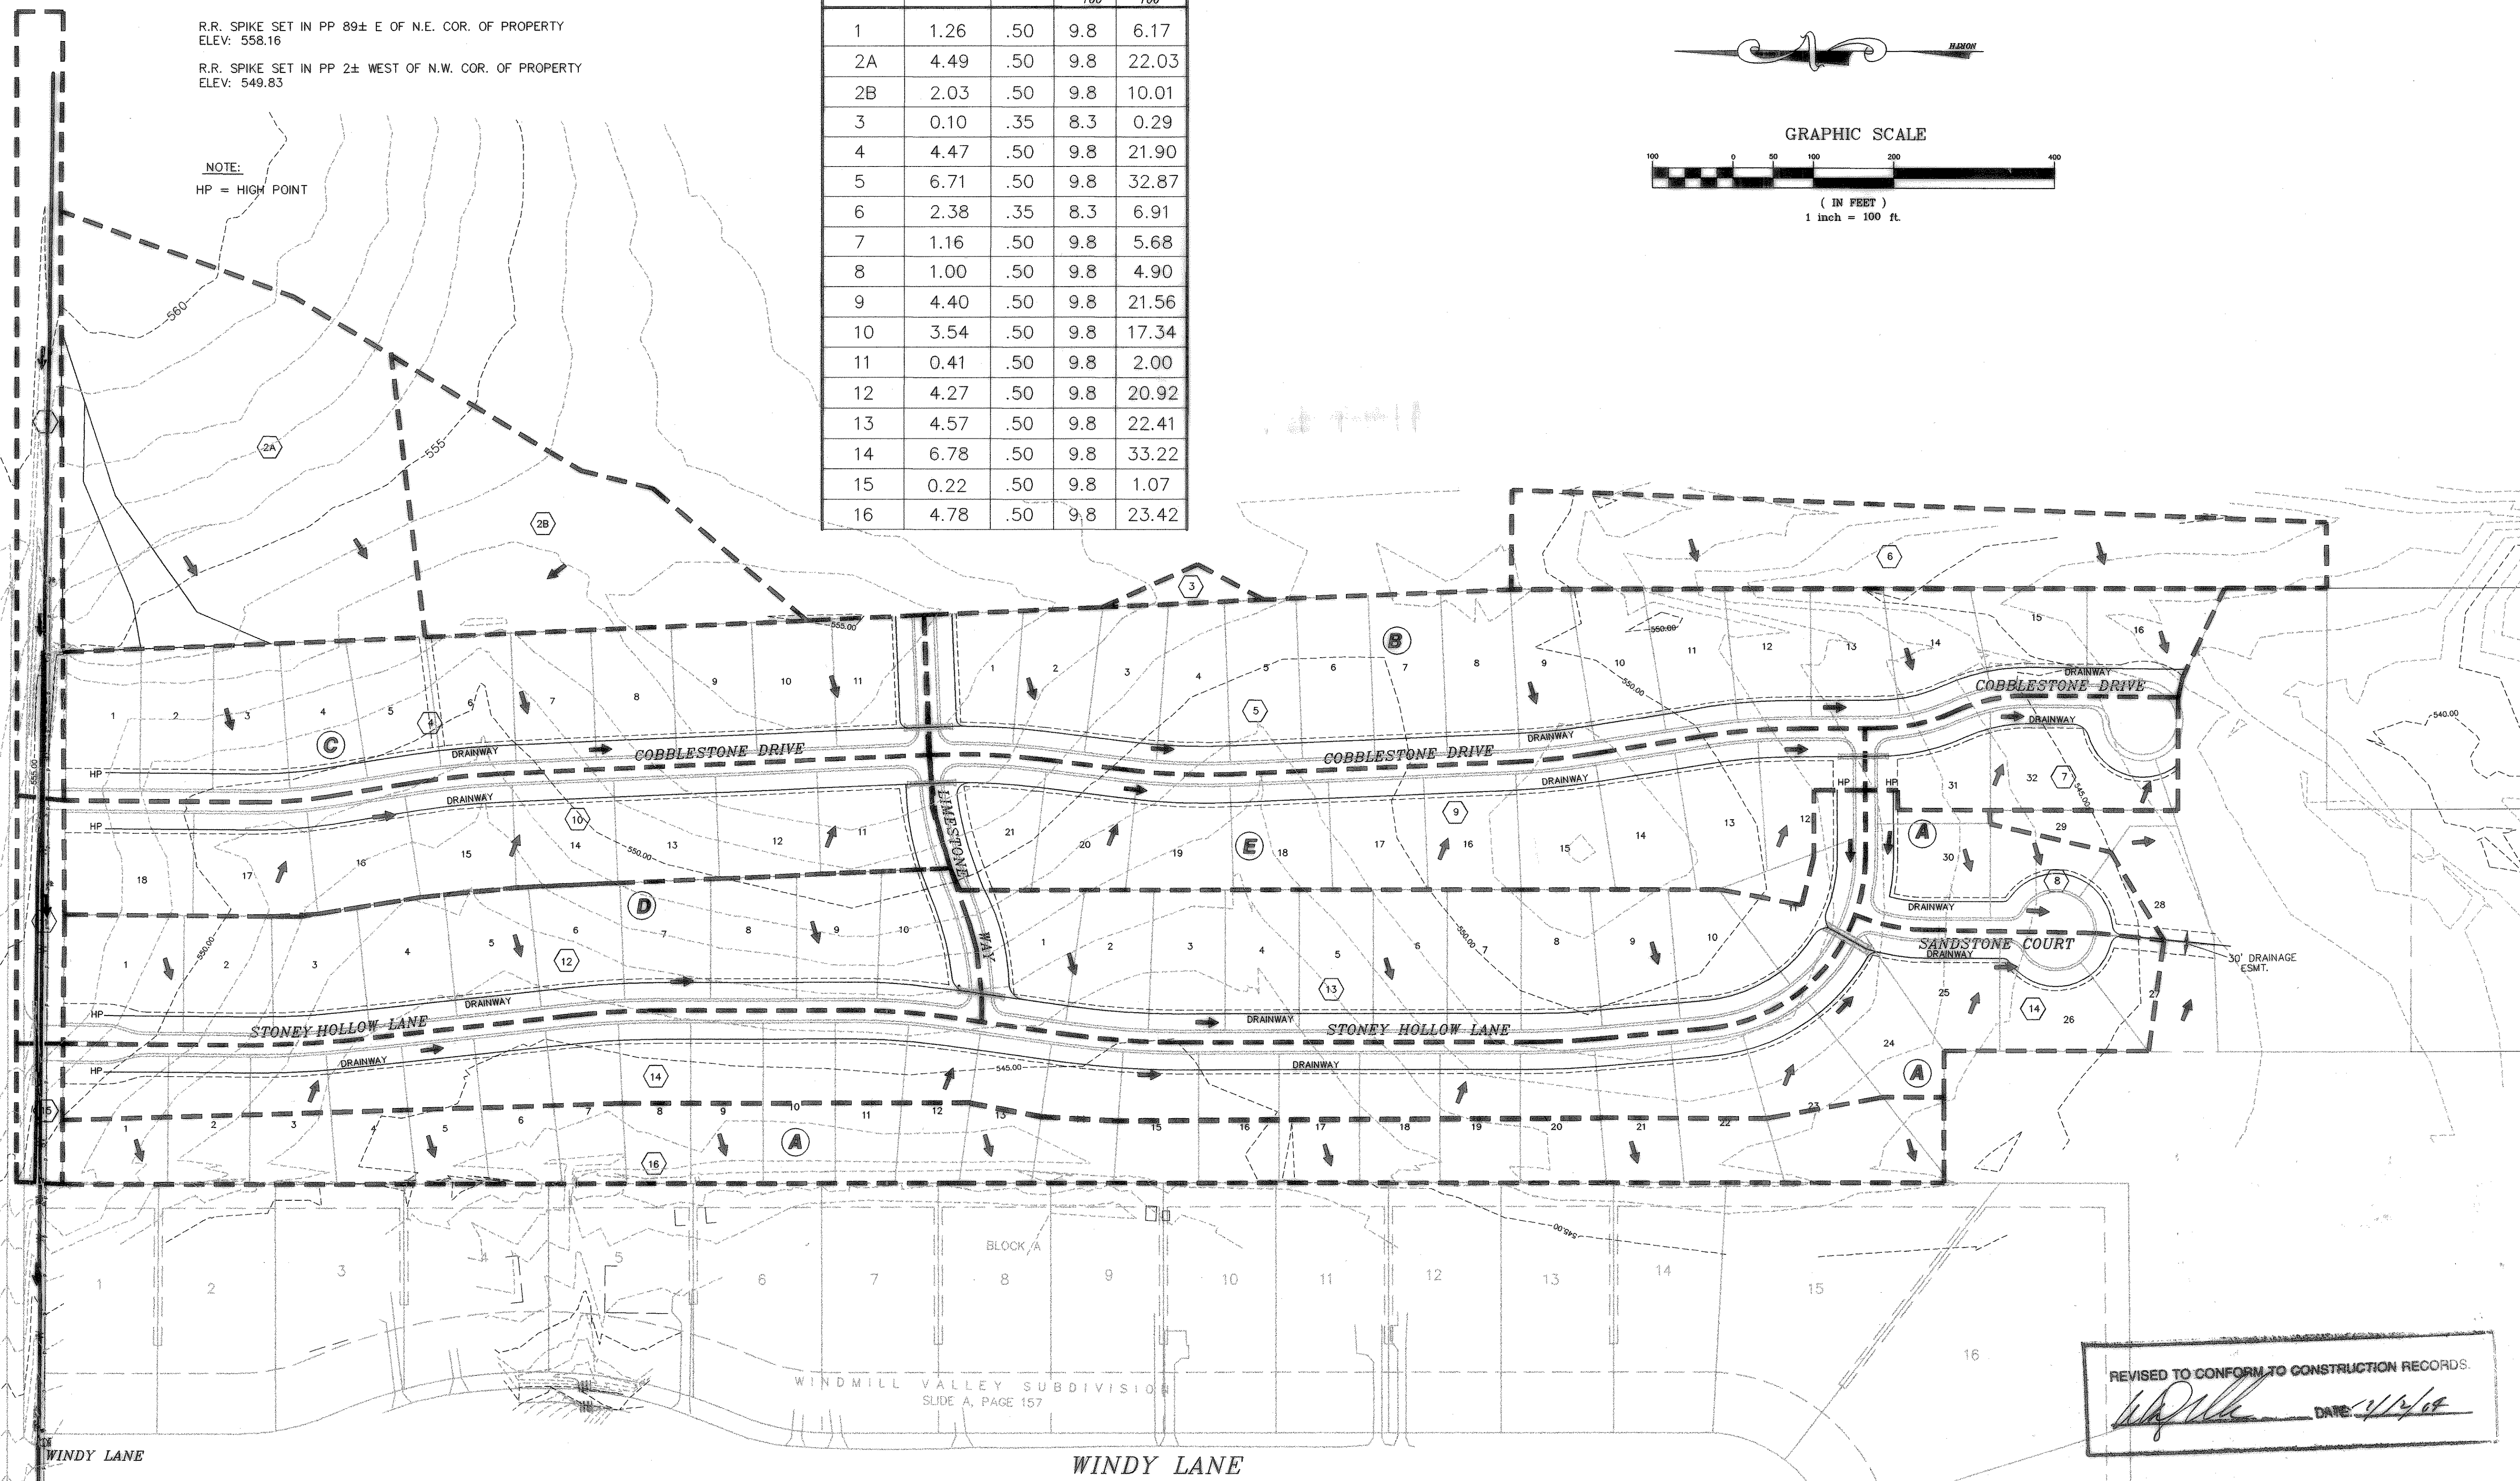


**BENCHMARK NOTES:**


R.R. SPIKE SET IN PP 89± E OF N.E. COR. OF PROPERTY  
ELEV: 558.16  
R.R. SPIKE SET IN PP 2± WEST OF N.W. COR. OF PROPERTY  
ELEV: 549.83

**NOTE:**  
HP = HIGH POINT

| DRAINAGE TABLE |       |     |                  |                  |
|----------------|-------|-----|------------------|------------------|
| AREA           | ACRES | C   | I <sub>100</sub> | Q <sub>100</sub> |
| 1              | 1.26  | .50 | 9.8              | 6.17             |
| 2A             | 4.49  | .50 | 9.8              | 22.03            |
| 2B             | 2.03  | .50 | 9.8              | 10.01            |
| 3              | 0.10  | .35 | 8.3              | 0.29             |
| 4              | 4.47  | .50 | 9.8              | 21.90            |
| 5              | 6.71  | .50 | 9.8              | 32.87            |
| 6              | 2.38  | .35 | 8.3              | 6.91             |
| 7              | 1.16  | .50 | 9.8              | 5.68             |
| 8              | 1.00  | .50 | 9.8              | 4.90             |
| 9              | 4.40  | .50 | 9.8              | 21.56            |
| 10             | 3.54  | .50 | 9.8              | 17.34            |
| 11             | 0.41  | .50 | 9.8              | 2.00             |
| 12             | 4.27  | .50 | 9.8              | 20.92            |
| 13             | 4.57  | .50 | 9.8              | 22.41            |
| 14             | 6.78  | .50 | 9.8              | 33.22            |
| 15             | 0.22  | .50 | 9.8              | 1.07             |
| 16             | 4.78  | .50 | 9.8              | 23.42            |

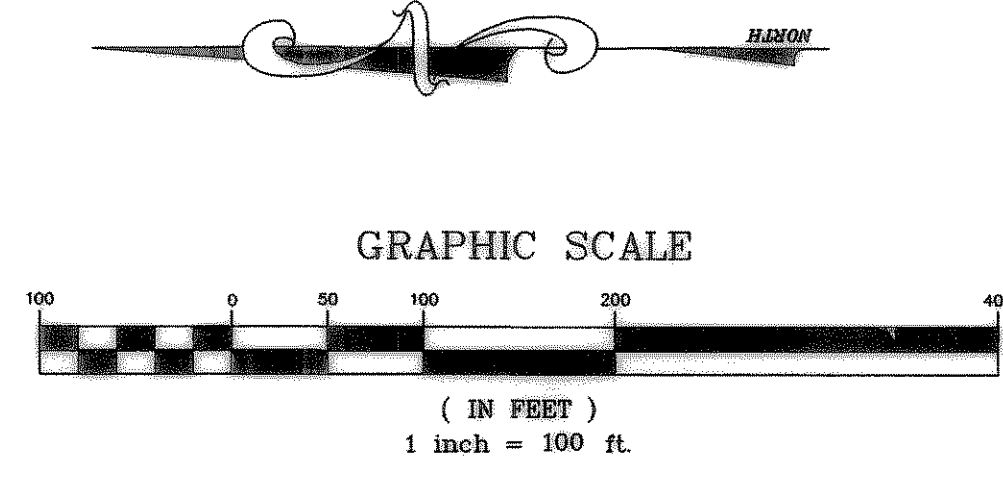

REVISED TO CONFORM TO CONSTRUCTION RECORDS.  
*[Signature]* DATE: 11/2/08

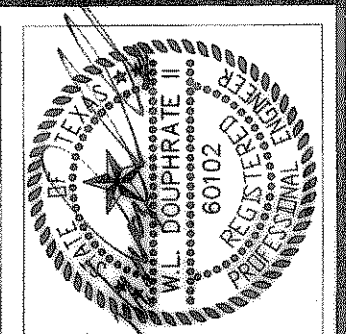

THE SEAL APPEARING ON THIS DOCUMENT IS AUTHORIZED BY THE BOARD OF ENGINEERING EXAMINERS, STATE OF TEXAS, NO. 60102 ON 8/2/02

**DOUPHRADE & ASSOCIATES, INC.**  
ENGINEERING - PROJECT MANAGEMENT - SURVEYING  
2235 RIDGE RD., # 200 ROCKWALL, TEXAS 75087  
PHONE: (972)771-9004 FAX: (972)771-9005

**DRAINAGE AREA MAP**  
**STONEY HOLLOW ADDITION**  
**CITY OF ROCKWALL**  
**ROCKWALL COUNTY, TEXAS**

|          |
|----------|
| REVISION |
| W.L.D.   |
| CHECKED  |
| K.E.B.   |
| DRAWN    |
| 12/01    |
| DATE     |
| 9907DAM  |
| PROJECT  |
| 4A       |
| OF       |
| 48       |