
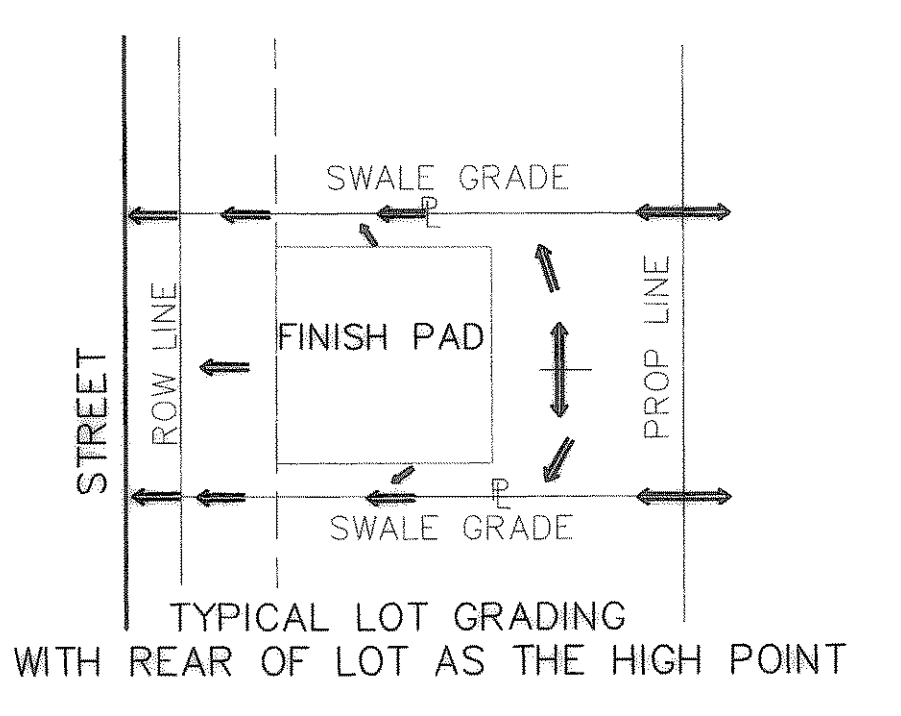
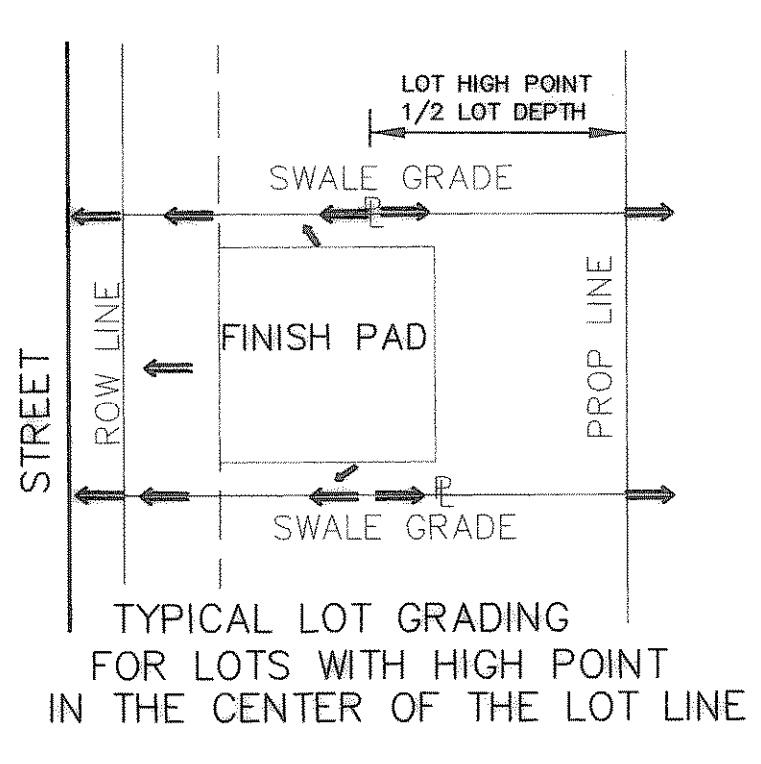



**DOUPHRATE & ASSOCIATES, INC.**  
 ENGINEERING - PROJECT MANAGEMENT - SURVEYING  
 2235 RIDGE RD., # 200 ROCKWALL, TEXAS 76087  
 PHONE: (972)771-9004 FAX: (972)771-9005

**LOT GRADING PLAN**  
**STONE HOLLOW ADDITION**  
 CITY OF ROCKWALL  
 ROCKWALL COUNTY, TEXAS

REV. 4-29-02 PER CITY COMMENTS  
 REV. 6-04-02 PER CITY COMMENTS  
 REV. 2-05-03 PER AM BELT  
 REV. 4-07-03 DIT. ALONG FM 552  
 REVISION  
 W.L.D. CHECKED  
 K.E.B. DRAWN  
 1/02 DATE  
 9907GRD-1 PROJECT  
 5 OF 48

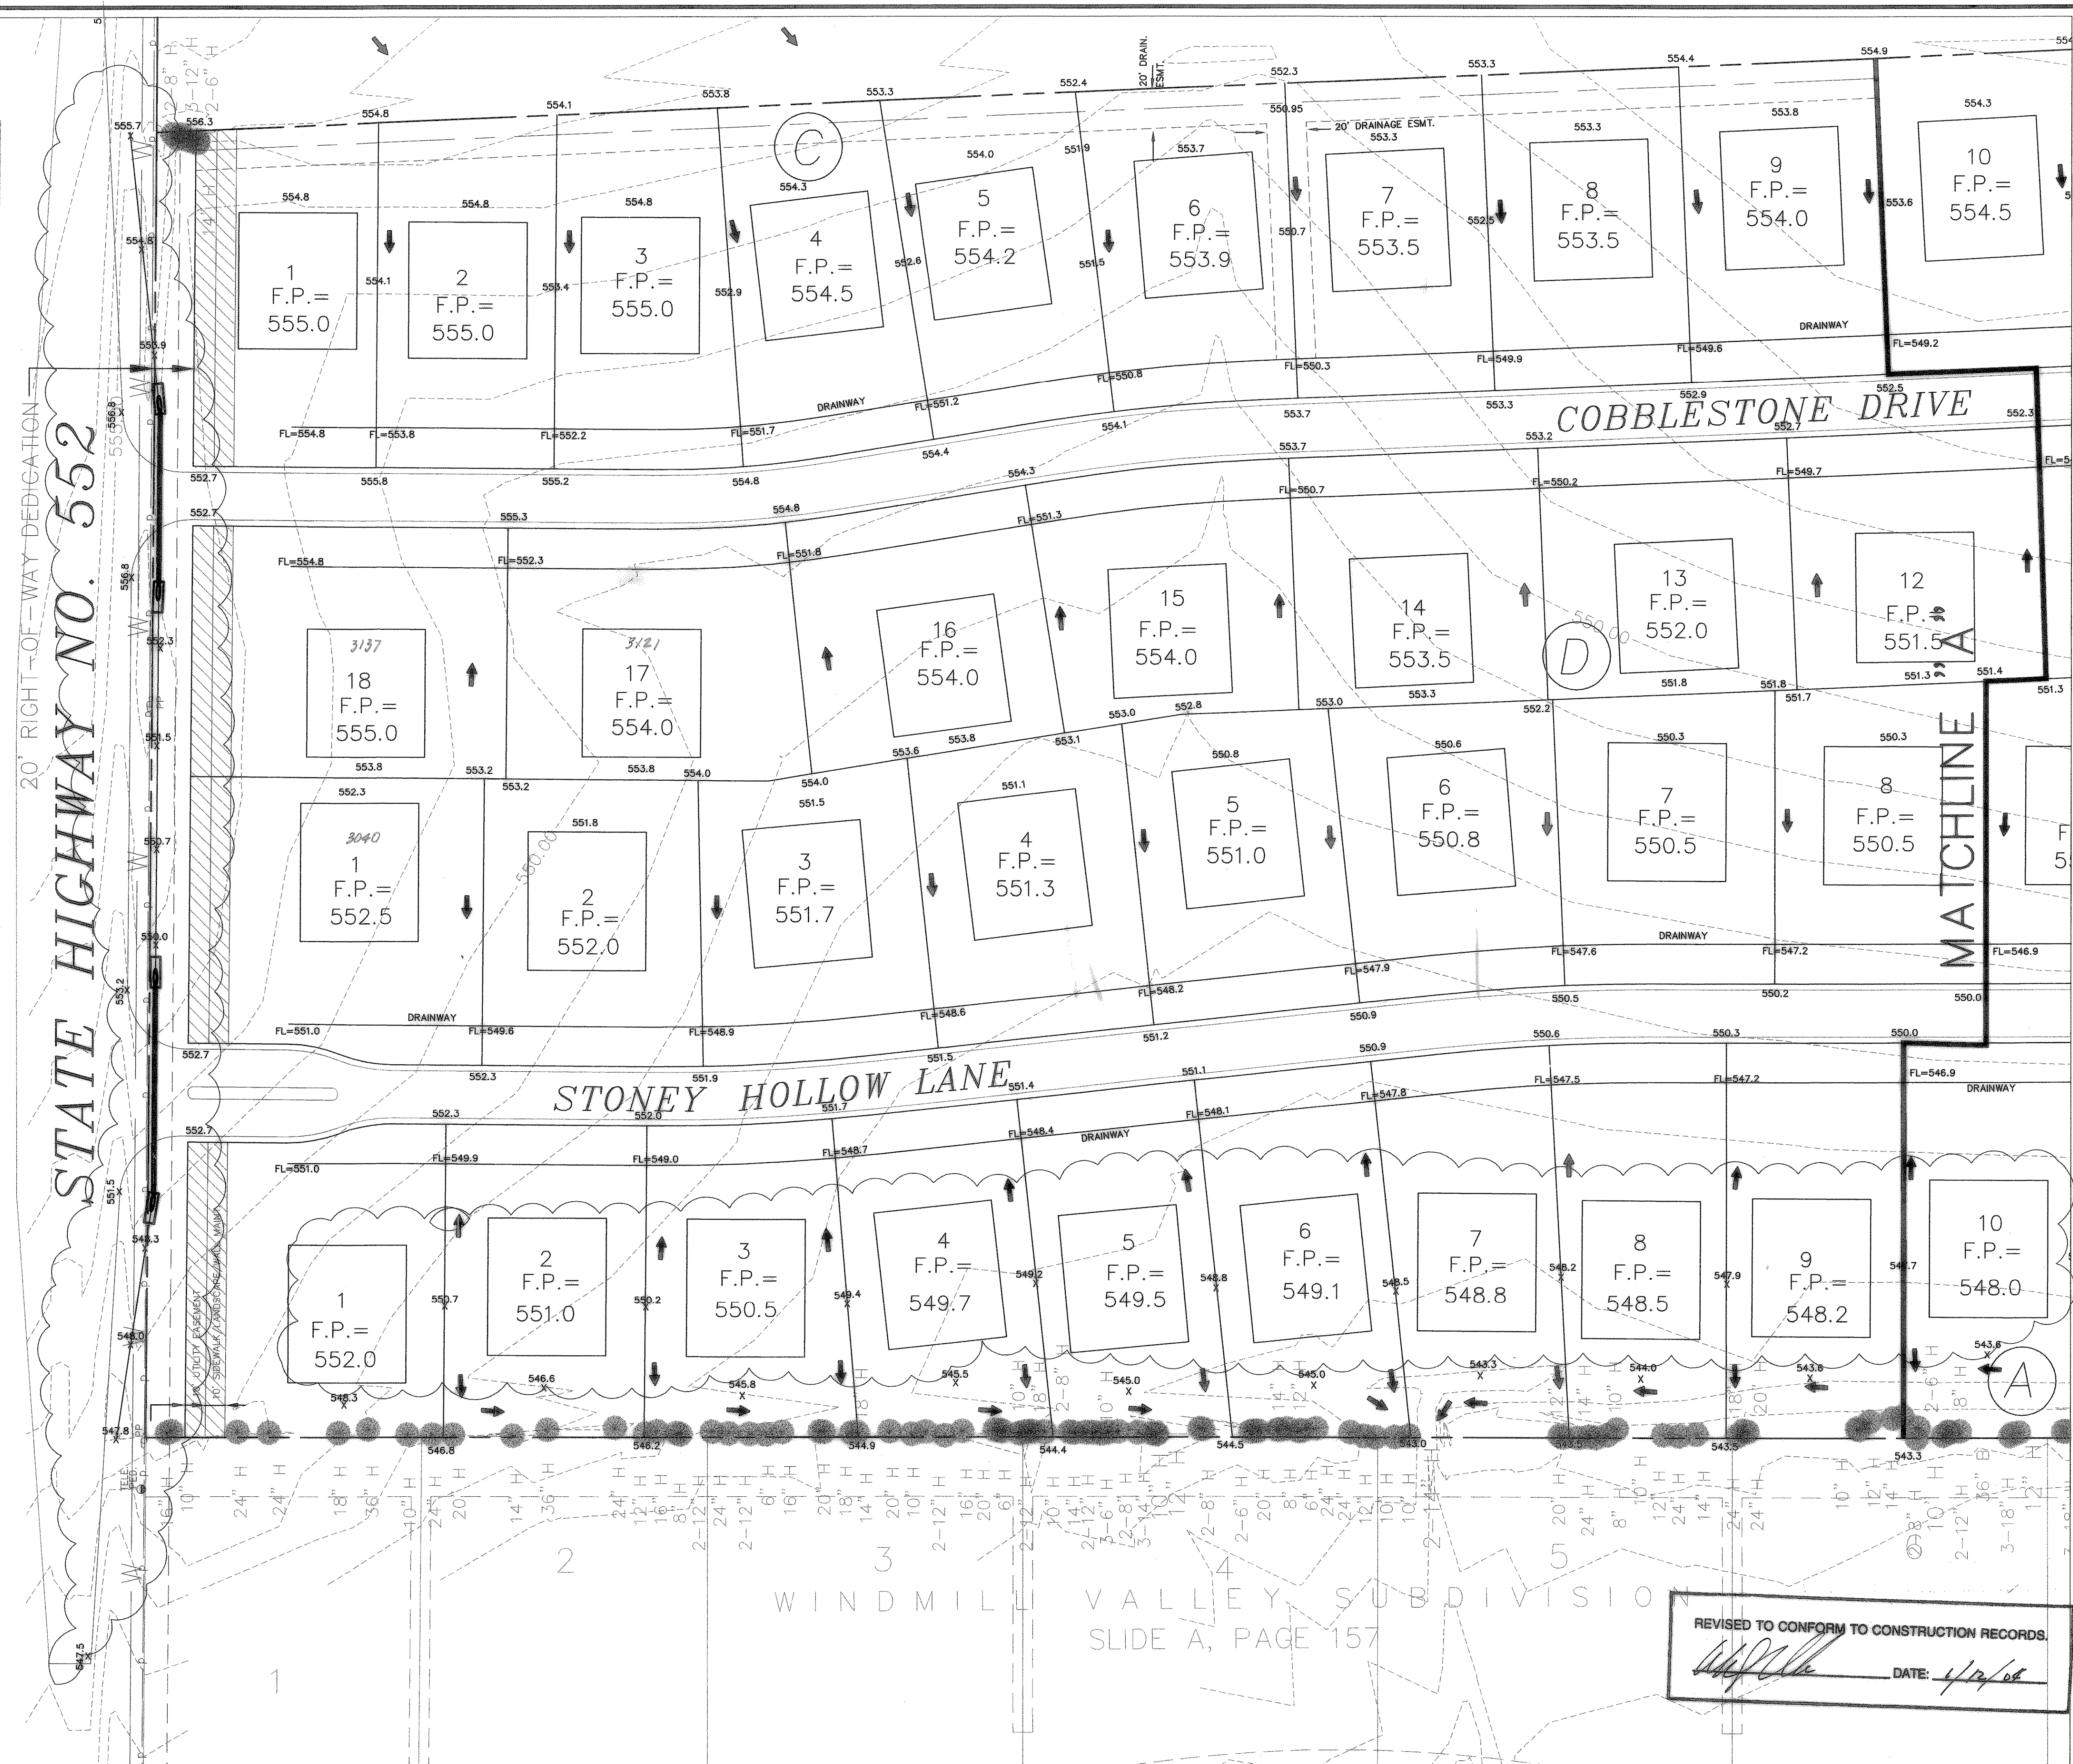

**BENCHMARK NOTES:**  
 R.R. SPIKE SET IN PP 89± E OF N.E. COR. OF PROPERTY  
 ELEV: 558.16  
 R.R. SPIKE SET IN PP 2± WEST OF N.W. COR. OF PROPERTY  
 ELEV: 549.83

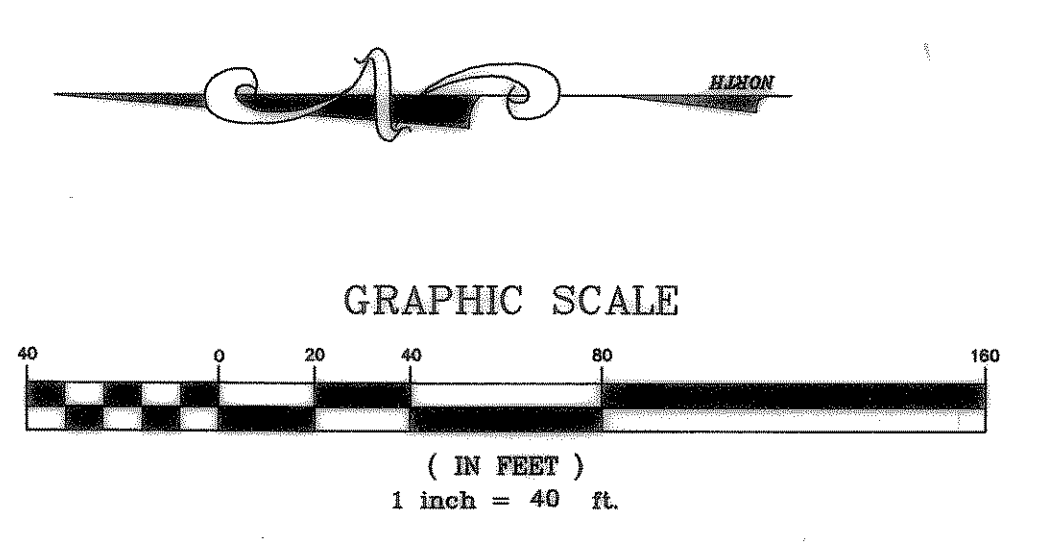

REVISED TO CONFORM TO CONSTRUCTION RECORDS.  
 DATE: 4/12/08

WINDMILL VALLEY SUBDIVISION  
 SLIDE A, PAGE 157