


BENCHMARK NOTES:
 R.R. SPIKE SET IN PP 89± E OF N.E. COR. OF PROPERTY
 ELEV: 558.16
 R.R. SPIKE SET IN PP 2± WEST OF N.W. COR. OF PROPERTY
 ELEV: 549.83



REVISED TO CONFORM TO CONSTRUCTION RECORDS.
[Signature] DATE: 1/12/12

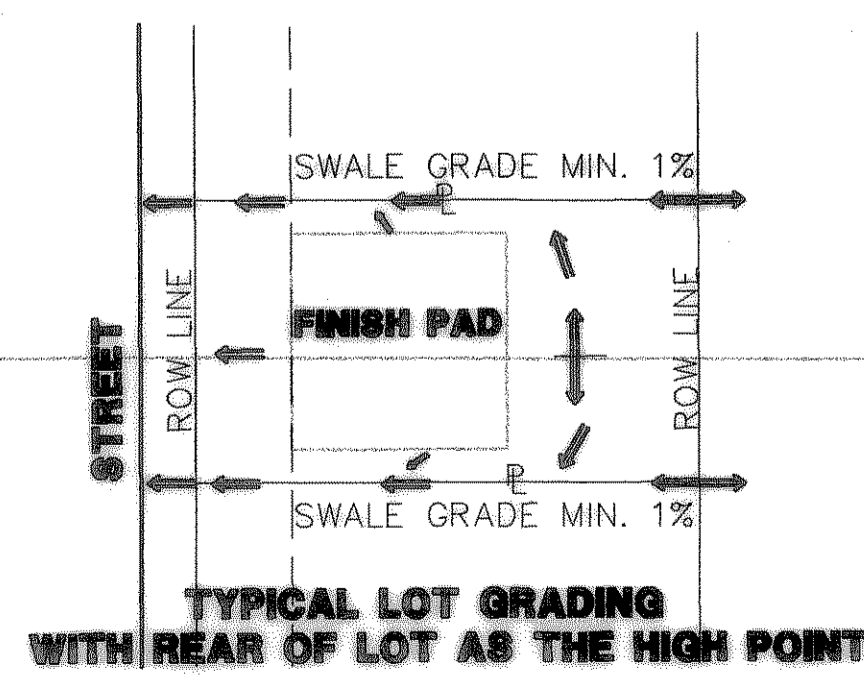

THE SEAL APPEARING ON THIS DOCUMENT WAS AUTHORIZED BY W.L. DOUPHRATE II TEXAS P.E. NO. 60102 ON 8/1/02

DOUPHRATE & ASSOCIATES, INC.
 ENGINEERING - PROJECT MANAGEMENT - SURVEYING
 2226 RIDGE RD., # 200 ROCKWALL, TEXAS 75087
 PHONE: (972)771-9004 FAX: (972)771-9005

LOT GRADING PLAN
STONEY HOLLOW ADDITION
 CITY OF ROCKWALL
 ROCKWALL COUNTY, TEXAS

REV. 4-29-02
 PER CITY COMMENTS
 REV. 6-04-02
 PER CITY COMMENTS

REVISION
 W.L.D.
 CHECKED
 K.E.B.
 DRAWN

1/02
 DATE
 9907GRD-3
 PROJECT

7
 OF
 48

VALLEY SUBDIVISION