

OFFSITE WATER STA: 35+92.80  
PAV. STA: 0+19.78 COBBLESTONE DR.  
INSTALL:  
1-16" x 8" TEE  
1-8" GATE VALVE  
1-16" GATE VALVES

PAV. STA: 1+42.97 COBBLESTONE DR.  
INSTALL:  
1-8" FIRE HYDRANT W/ASSEMBLY  
1-8" GATE VALVE

PAV. STA: 10+96.16 COBBLESTONE DR.  
INSTALL:  
1-8" FIRE HYDRANT W/ASSEMBLY  
1-8" GATE VALVE

PAV. STA: 15+04.22 COBBLESTONE DR.  
INSTALL:  
1-8" FIRE HYDRANT W/ASSEMBLY  
1-8" GATE VALVE

PAV. STA: 18+84.19 COBBLESTONE DR.  
INSTALL:  
1-8" FIRE HYDRANT W/ASSEMBLY  
1-8" GATE VALVE

PAV. STA: 22+28.58 COBBLESTONE DR.  
INSTALL:  
1-8" FIRE HYDRANT W/ASSEMBLY  
1-8" GATE VALVE

PAV. STA: 28+43.22 COBBLESTONE DR.  
INSTALL:  
1-11.5" BEND

PAV. STA: 28+77.04 COBBLESTONE DR.  
INSTALL:  
1-8" FIRE HYDRANT W/ASSEMBLY  
1-8" GATE VALVE

PAV. STA: 0+49.05 STONEY HOLLOW LANE  
INSTALL:  
1-8" FIRE HYDRANT W/ASSEMBLY  
1-8" GATE VALVE

PAV. STA: 6+12.01 COBBLESTONE DR.  
INSTALL:  
1-8" FIRE HYDRANT W/ASSEMBLY  
1-8" GATE VALVE

PAV. STA: 11+10.04 COBBLESTONE DR.  
PAV. STA: 3+57.69 LIMESTONE WAY  
INSTALL:  
1-8" x 8" TEE  
2-8" GATE VALVES

PAV. STA: 23+27.82 STONEY HOLLOW LANE  
PAV. STA: 0+16.87 SANDSTONE CT.  
INSTALL:  
1-8" x 8" TEE  
2-8" GATE VALVES

PAV. STA: 1+96.89 SANDSTONE CT.  
INSTALL:  
1-11.5" BEND

PAV. STA: 4+66.64 STONEY HOLLOW LANE  
INSTALL:  
1-8" FIRE HYDRANT W/ASSEMBLY  
1-8" GATE VALVE

PAV. STA: 9+21.88 STONEY HOLLOW LANE  
INSTALL:  
1-8" FIRE HYDRANT W/ASSEMBLY  
1-8" GATE VALVE

PAV. STA: 13+73.15 STONEY HOLLOW LANE  
INSTALL:  
1-8" FIRE HYDRANT W/ASSEMBLY  
1-8" GATE VALVE

PAV. STA: 18+66.31 STONEY HOLLOW LANE  
INSTALL:  
1-8" FIRE HYDRANT W/ASSEMBLY  
1-8" GATE VALVE

PAV. STA: 23+07.31 STONEY HOLLOW LANE  
INSTALL:  
1-8" FIRE HYDRANT W/ASSEMBLY  
1-8" GATE VALVE

PAV. STA: 2+66.50 SANDSTONE CT.  
INSTALL:  
1-8" FIRE HYDRANT W/ASSEMBLY  
1-8" GATE VALVE


OFFSITE WATER STA: 32+42.14  
PAV. STA: 0+19.01 STONEY HOLLOW LANE  
INSTALL:  
1-16" x 8" TEE  
1-8" GATE VALVE  
1-16" GATE VALVES

PROPOSED 16" WATER LINE TO FOLLOW 60' INSIDE R.O.W. AND CONNECT TO AN EXISTING 16" WATER LINE (SEE SHEET 17)


WATER LINE TO BE CONSTRUCTED 7.5' FROM EDGE OF PAVEMENT

**BENCHMARK NOTES:**  
R.R. SPIKE SET IN PP 89± E OF N.E. COR. OF PROPERTY  
ELEV: 558.16  
R.R. SPIKE SET IN PP 2± WEST OF N.W. COR. OF PROPERTY  
ELEV: 549.83

**LEGEND**  
----- = WATER SERVICE

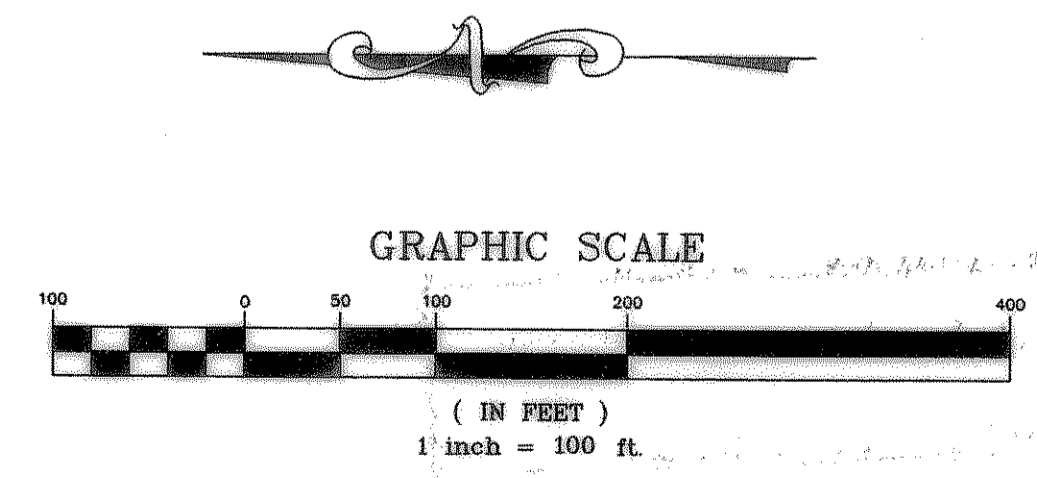

REVISED TO CONFORM TO CONSTRUCTION RECORDS.  
*[Signature]* DATE: 1/2/04

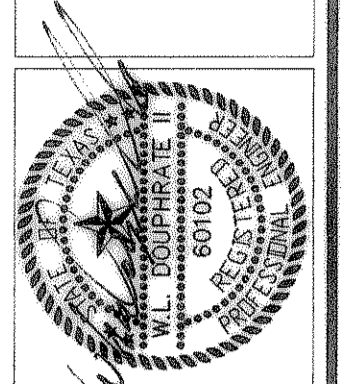

THE SEAL APPEARING ON THIS DOCUMENT WAS AUTHORIZED BY W.L. DOUPHRATE II TEXAS P.E. NO. 60102 ON 8/17/02

**DOUPHRATE & ASSOCIATES, INC.**  
ENGINEERING - PROJECT MANAGEMENT - SURVEYING  
2236 RIDGE RD., # 200 ROCKWALL, TEXAS 75087  
PHONE: (972)771-9004 FAX: (972)771-9005

**WATER PLAN  
STONEY HOLLOW ADDITION  
CITY OF ROCKWALL  
ROCKWALL COUNTY, TEXAS**

REV. 4-29-02 PER CITY COMMENTS  
REV. 6-04-02 PER CITY COMMENTS

REVISION	W.L.D.	CHECKED	K.E.B.	DATE
				12/01
				9907WTR
				PROJECT