

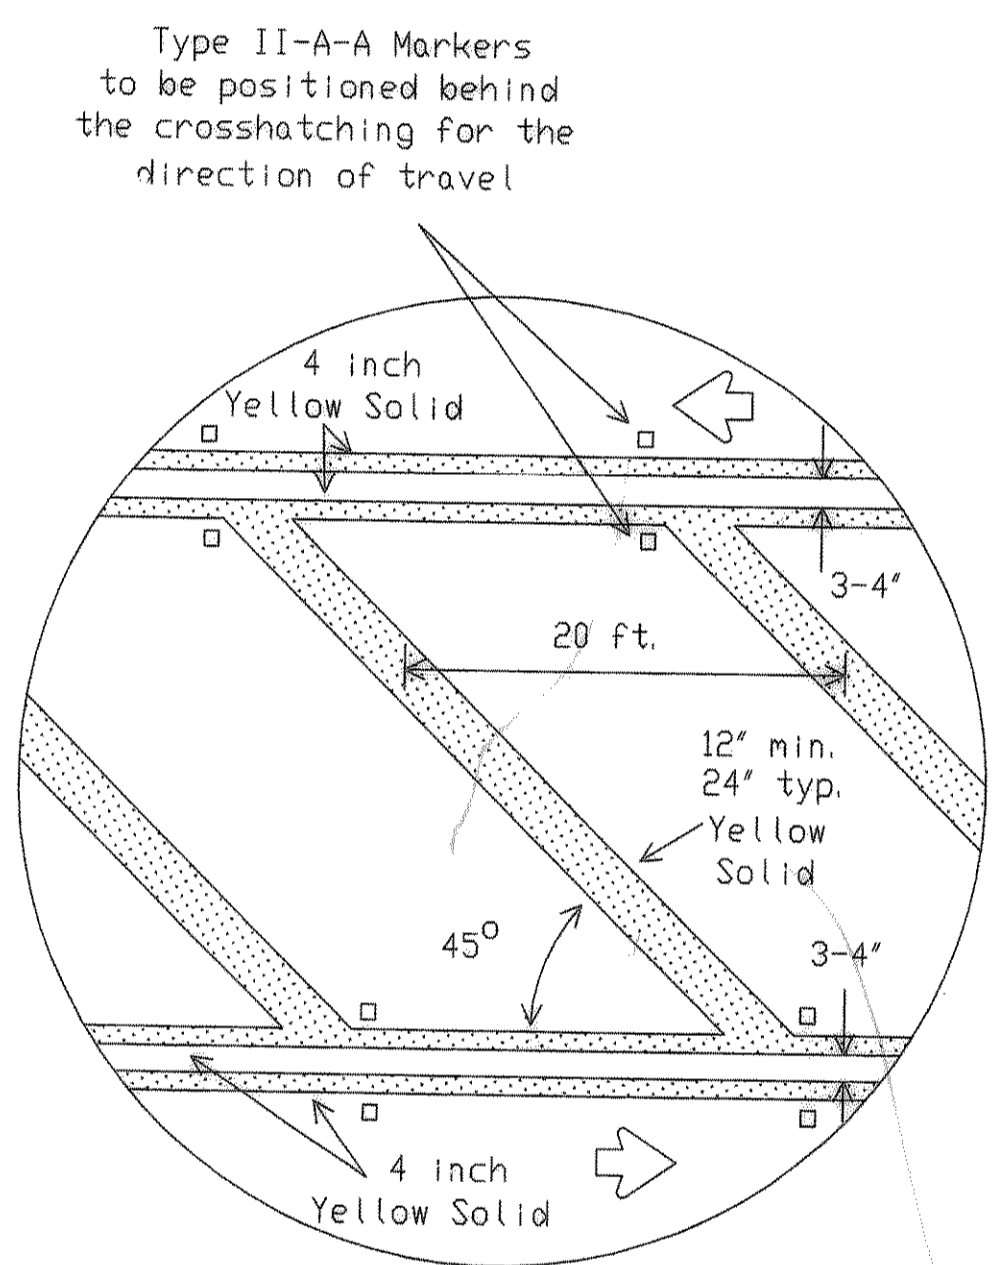



DISCLAIMER  
 The use of this standard is governed by the "Texas Engineering Practice Act". No warranty of any kind is made by TxDOT for any purpose whatsoever. TxDOT assumes no responsibility for the conversion of this standard to other formats or for incorrect results or damages resulting from its use.

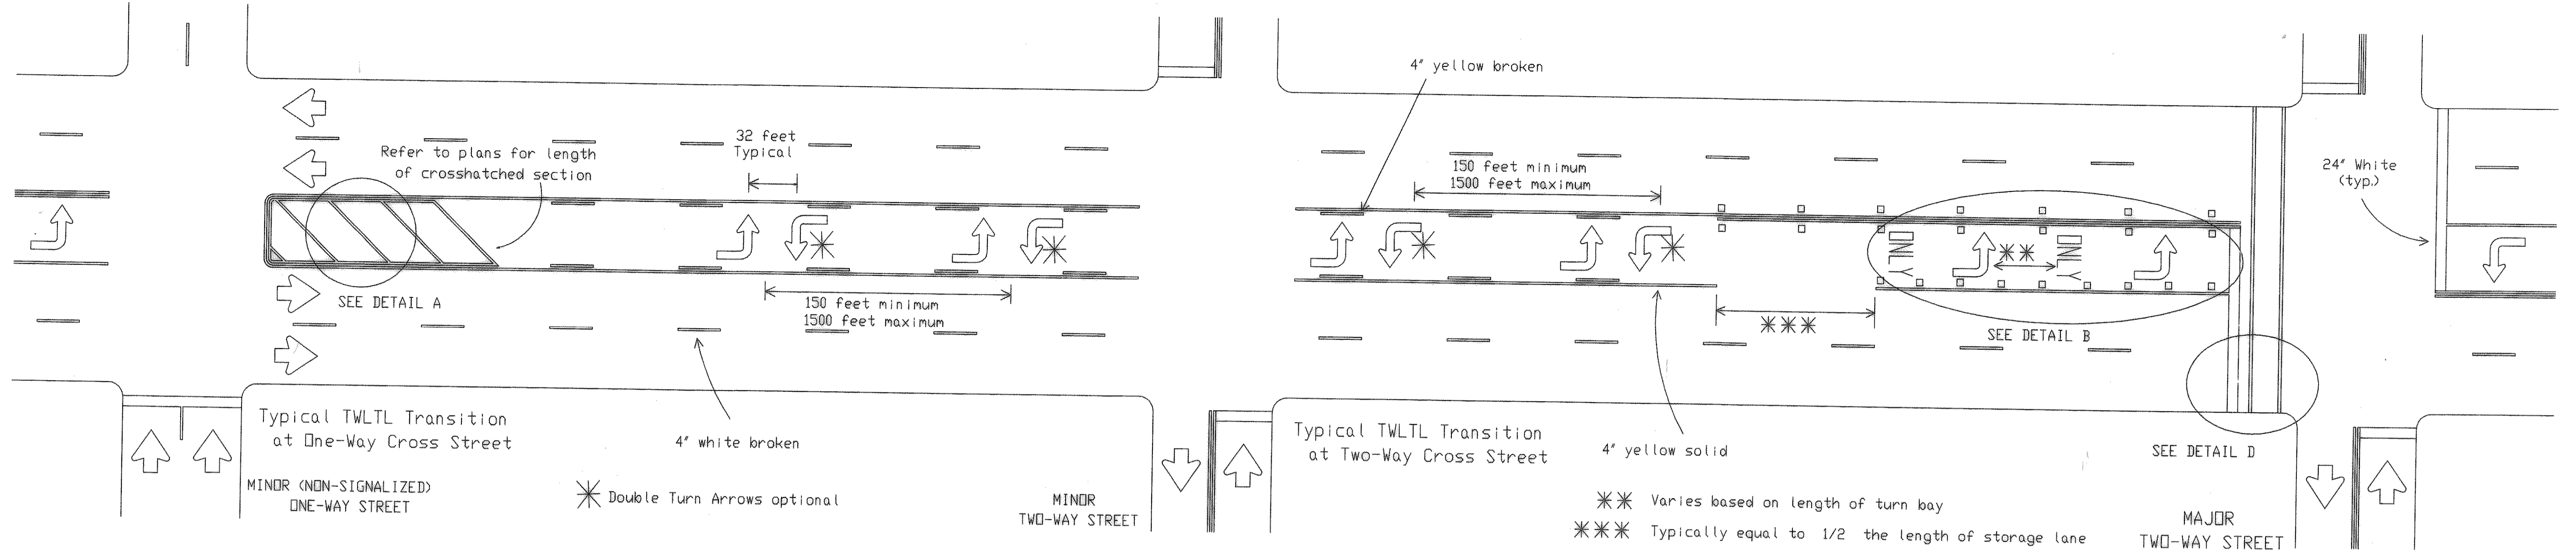

DETAIL A

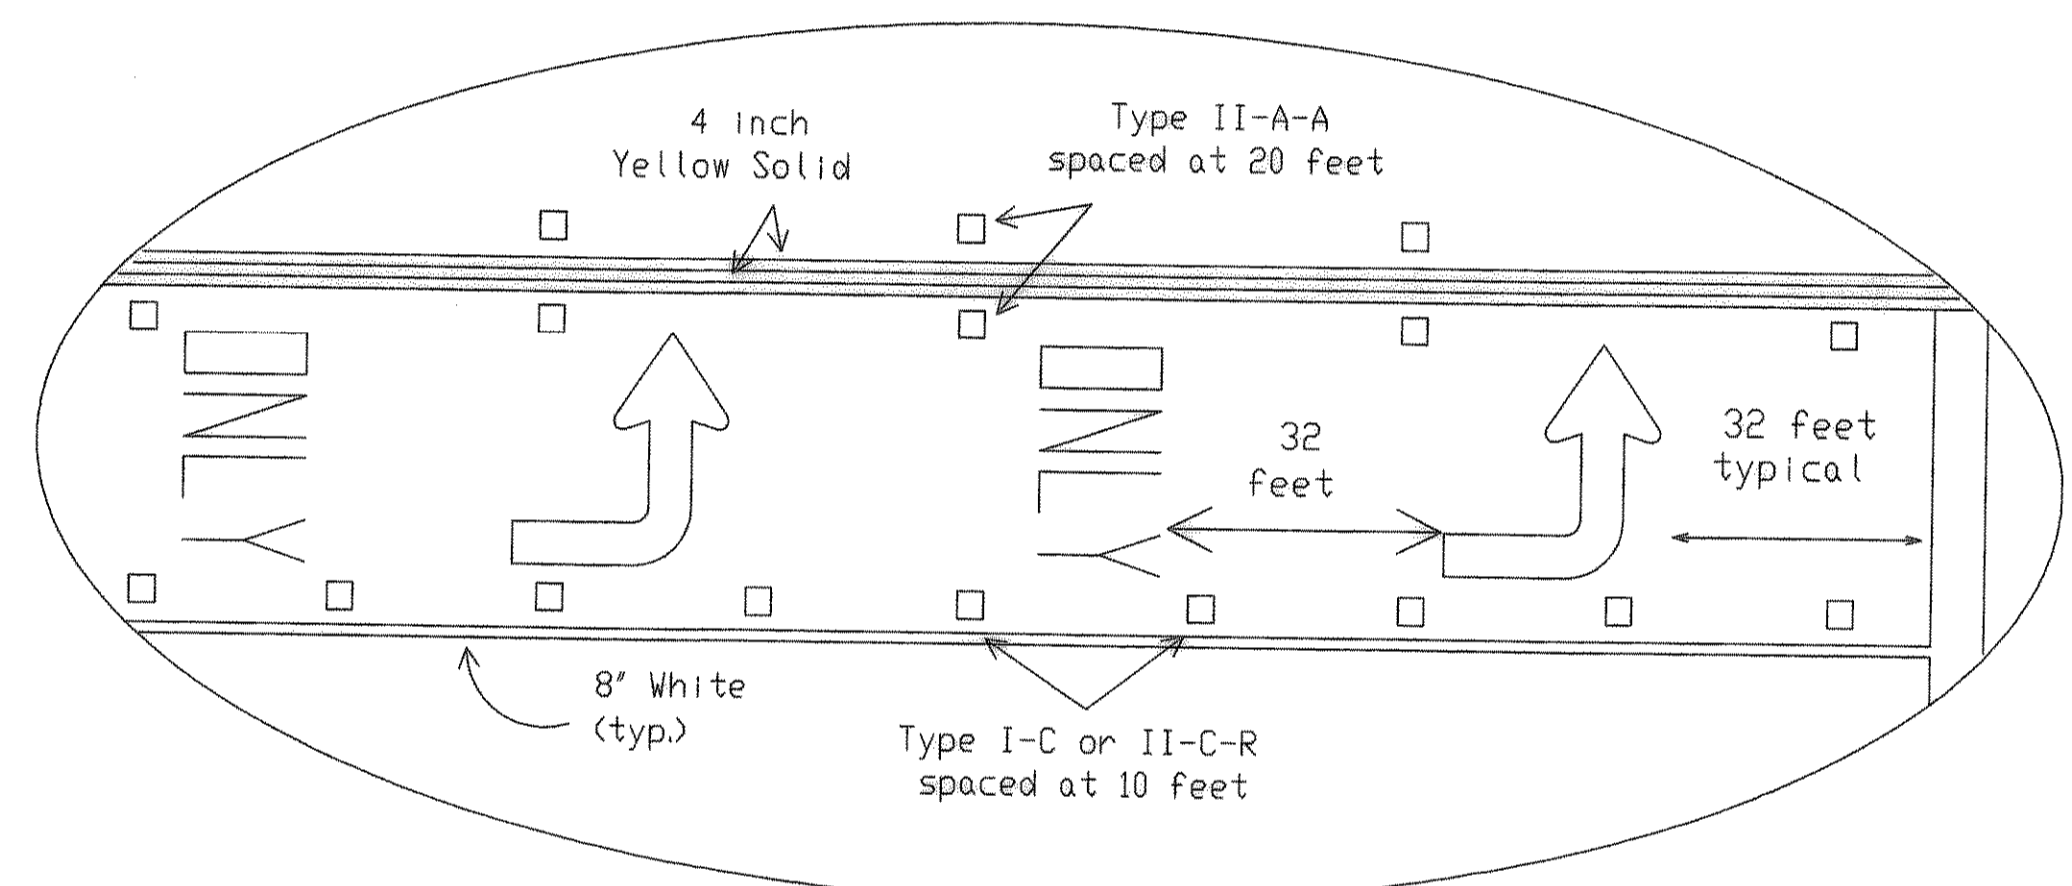


DETAIL B

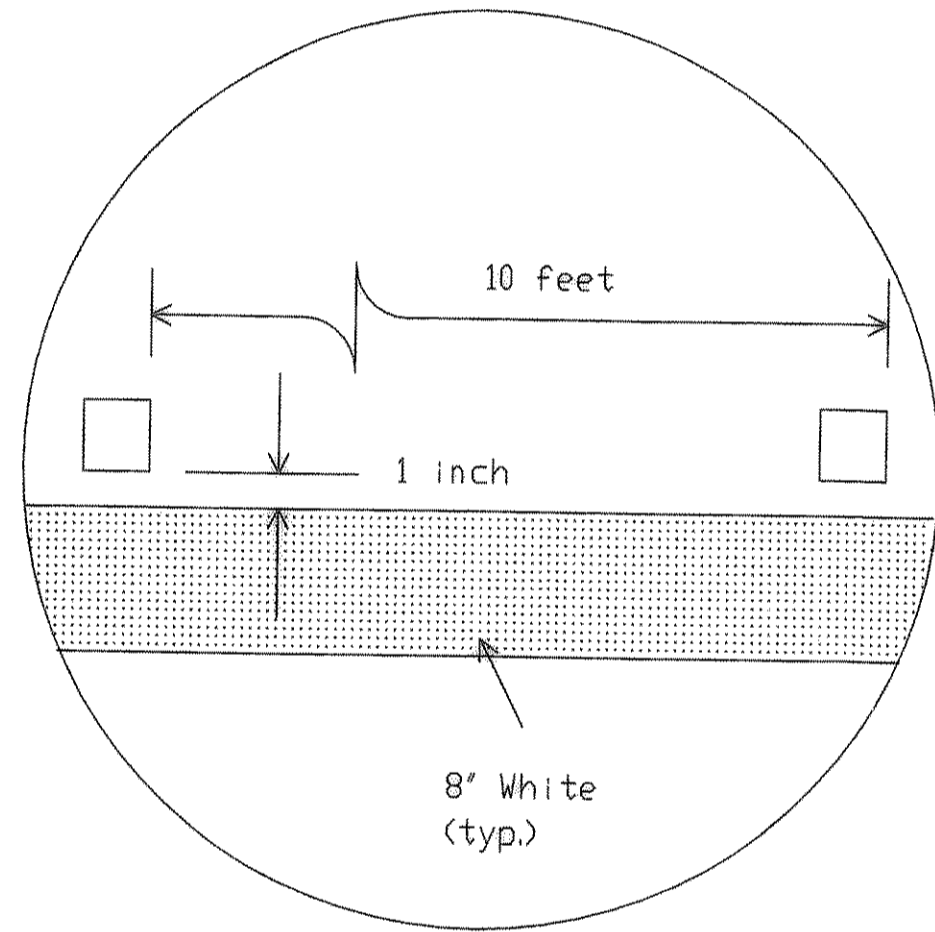

DETAIL C

Raised pavement marker Type I-C with undivided highways, flush medians and two way left turn lanes. Raised pavement marker Type II-C-R with divided highways and raised medians.

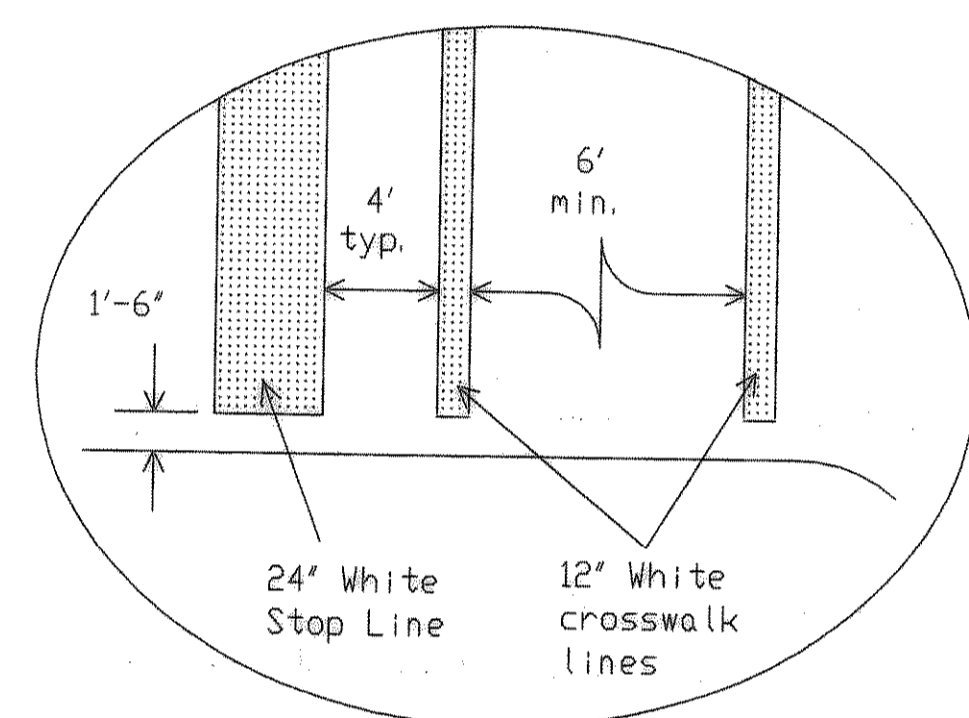


DETAIL D


Final placement of Stop Bar and Crosswalk shall be approved by the Engineer in the field.

REVISED TO CONFORM TO CONSTRUCTION RECORDS.  
 DATE: 4/12/08

Type II-A-A Markers to be positioned behind the crosshatching for the direction of travel

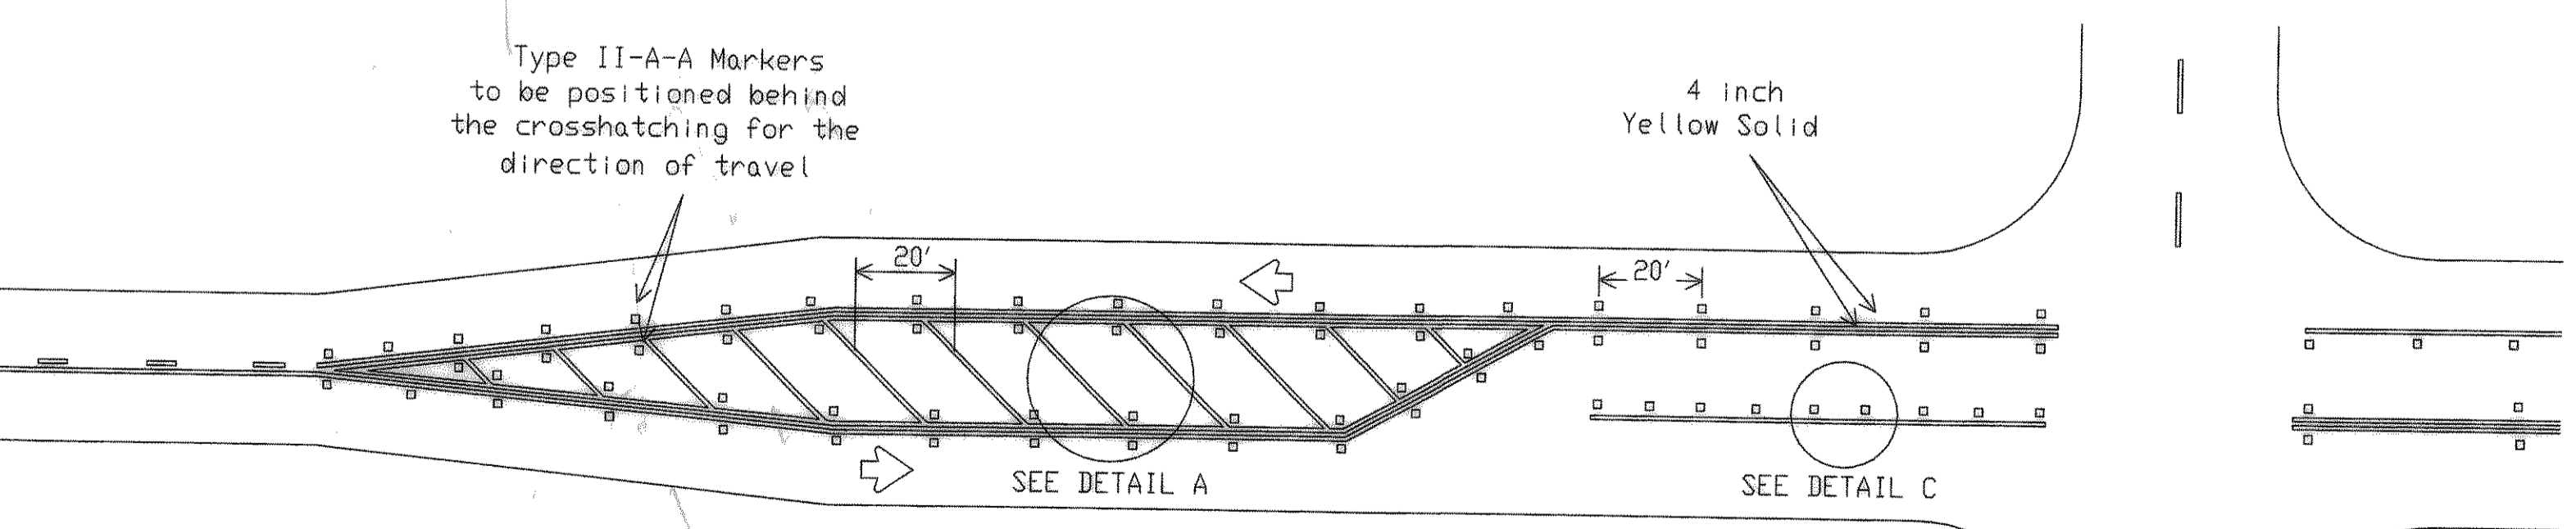

TYPICAL TWO-LANE HIGHWAY INTERSECTION WITH LEFT TURN BAYS

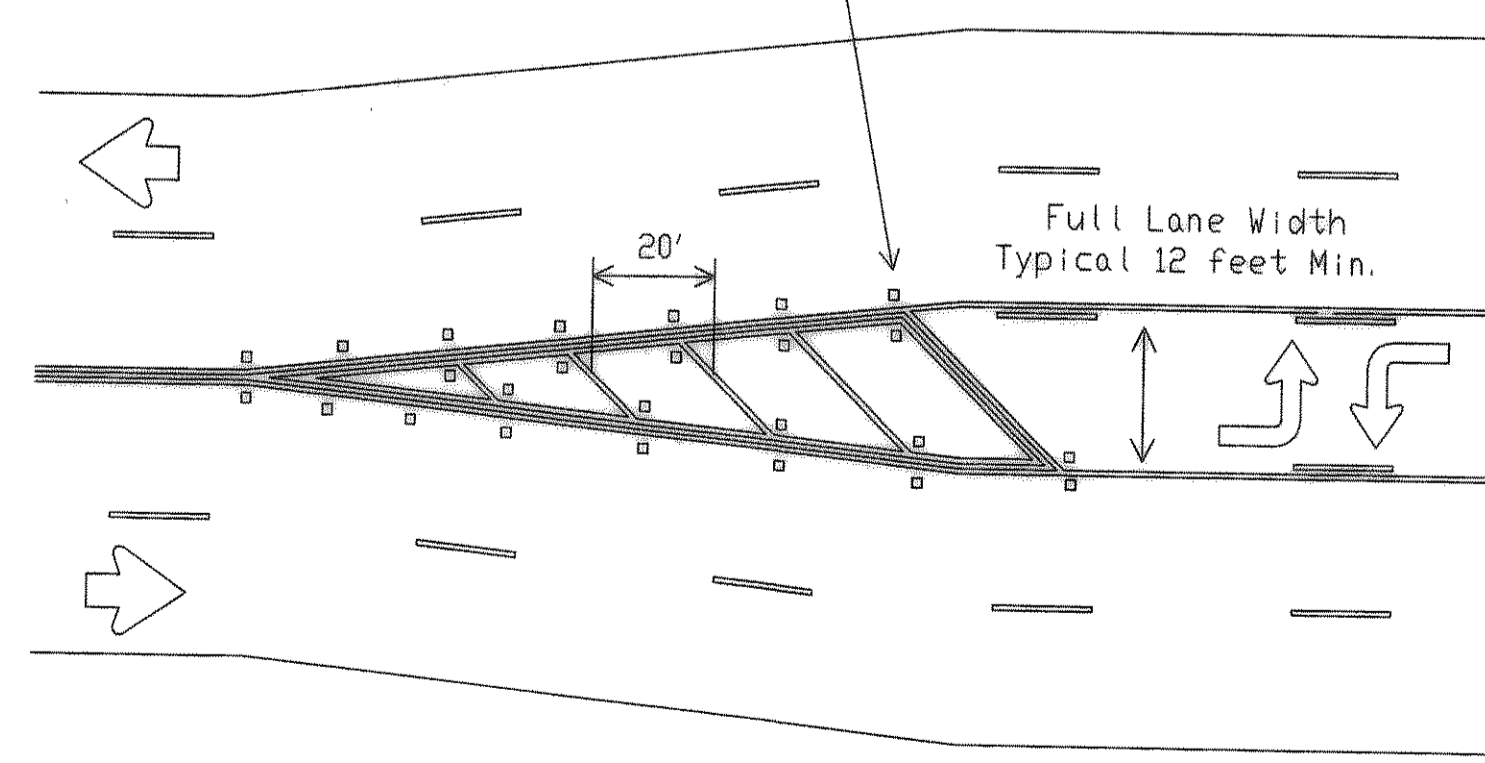

TYPICAL TRANSITION FOR TWLTL AND DIVIDED HIGHWAY

GENERAL NOTES

- Refer elsewhere in plans for additional RPM placement and details.
- Details for words and arrows as shown on other sheets.
- All pavement marking materials shall meet the required Departmental Material Specifications as specified by the plans.
- For a left turn bay, two sets of words and arrows shall be used if the length of the bay is equal to or greater than 180 feet. The bottom of the first ONLY shall be placed at the beginning of the turn bay lane line as shown above.
- Other crosswalk patterns as shown in the "Texas Manual on Uniform Traffic Control Devices" may be used.

SPECIFICATION REFERENCE TABLE

MATERIAL SPECIFICATIONS	
PAVEMENT MARKERS (REFLECT.)	DMS-4200
EPOXY	DMS-6100
BITUMINOUS ADHESIVE FOR PAVE. MKS.	DMS-6130

STANDARD PLANS  
 Texas Department of Transportation  
 Traffic Operations Division

PAVEMENT MARKINGS FOR TWO-WAY LEFT TURN LANES DIVIDED HIGHWAYS AND RURAL LEFT TURN BAYS  
 PM(4)-00A

LEVELS DISPLAYED

1	2	3	4	5	6	7	8	9	10	11	12	13	14	15
16	17	18	19	20	21	22	23	24	25	26	27	28	29	30
31	32	33	34	35	36	37	38	39	40	41	42	43	44	45
46	47	48	49	50	51	52	53	54	55	56	57	58	59	60

© TxDOT April 1998

REVISING	STATE	FEDERAL	IN- BAS	OK- GRB	IN- FDN	OK- CAL	REG. NO.
5-00	DISTRICT	REGION					
8-00	6						
	COUNTY	CONTROL	SECTION	JOB	HIGHWAY		