


**BENCHMARK NOTES:**

R.R. SPIKE SET IN PP 89 ± E OF N.E. COR. OF PROPERTY  
ELEV: 558.16

R.R. SPIKE SET IN PP 2 ± WEST OF N.W. COR. OF PROPERTY  
ELEV: 549.83

REVISED TO CONFORM TO CONSTRUCTION RECORDS

DATE: 4/17/02

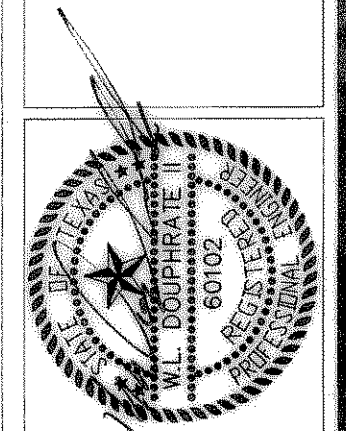

THE SEAL APPEARING ON THIS DOCUMENT WAS AUTHORIZED BY THE BOARD OF ENGINEERING EXAMINERS IN TEXAS ON 8/15/02

**DOUPHRATE & ASSOCIATES, INC.**  
ENGINEERS - PROJECT MANAGEMENT - SURVEYING  
2535 RIDGE RD., # 200 ROCKWALL, TEXAS 75087  
PHONE: (972)771-9004 FAX: (972)771-9005

**STORM SEWER PLAN & PROFILES**  
**LINE A, B, C**  
**STONEY HOLLOW ADDITION**  
**CITY OF ROCKWALL, ROCKWALL COUNTY, TEXAS**

REV. 6-04-02  
PER CITY COMMENTS

REVISION
W.L.D.
CHECKED
K.E.B.
DRAWN
12/01
DATE
9907STM1
PROJECT