

F.M. HIGHWAY NO. 552

BLACK VINYL COATED CHAIN LINK FENCE W/ LANDSCAPED SCREENING  
 PROPOSED CONTROL PANEL AND GENERATOR ELEV. 501.50

PROPOSED LIFT STATION ELEV. 500.50

PROPOSED 12" SANITARY SEWER



WATER METER

PROPOSED DRIVEWAY TO MIDDLE SCHOOL

10' R GATE  
 PROPOSED 12' DRIVEWAY CONC. 3600 PSI (NCTCOG CLASS 2)

COVER GROUND IN FENCED AREA WITH PEA GRAVEL

NOTE:  
 LIFT STATION MOVED 10.00' TO THE SOUTH FROM ITS ORIGINAL LOCATION;

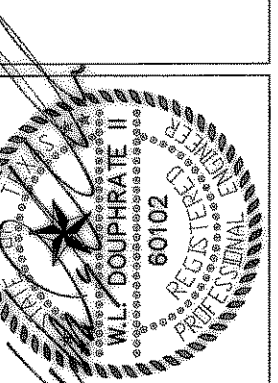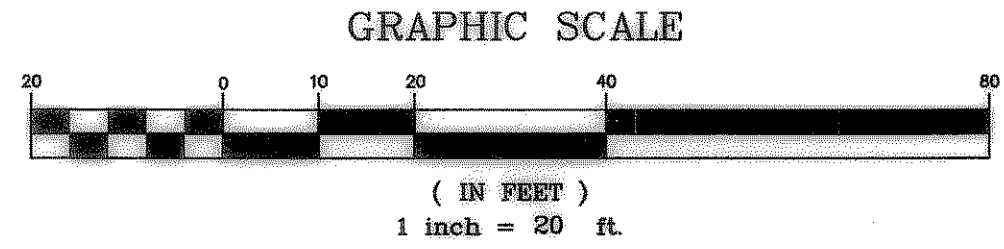

THE SEAL APPEARING ON THIS DOCUMENT WAS AUTHORIZED BY THE STATE OF TEXAS ON 11/21/14 NO. 80102 ON 11/21/14

**DOUPHRADE & ASSOCIATES, INC.**  
 ENGINEERING - PROJECT MANAGEMENT - SURVEYING  
 2235 RIDGE RD., # 200 ROCKWALL, TEXAS 75087  
 PHONE: (972)771-9004 FAX: (972)771-9005

LAYOUT AND GRADING PLAN  
 THOMPSON BRANCH LIFT STATION  
 STONEY HOLLOW ADDITION  
 CITY OF ROCKWALL, ROCKWALL COUNTY, TEXAS

MOVED LIFT STA:  
 10' SOUTH  
 5/12/03

REVISION  
 W.L.D.  
 CHECKED  
 K.E.B.  
 DRAWN  
 1/28/98  
 DATE

REVISED TO CONFORM TO CONSTRUCTION RECORDS.  
 DATE: 4/2/99

9907LS4  
 PROJECT  
 38  
 OF  
 48