

PROPOSED 12" FORCE MAIN  
 PROPOSED LIFT STATION  
 PROPOSED 12" SANITARY SEWER

FM 552

FM 552

HAYS ROAD

PARK CENTRAL

WINDY LANE

WINDY LANE

STONEY HOLLOW LANE

COBBLESTONE DRIVE

FM 1141

ROCKWALL MIDDLE SCHOOL #4


WINDMILL VALLEY SUBDIVISION

STONEY HOLLOW  
 98 RESIDENCE

CATHOLIC DIOCESE  
 77 ACRES

NELSON LAKE  
 93 ACRES

1" = 300'

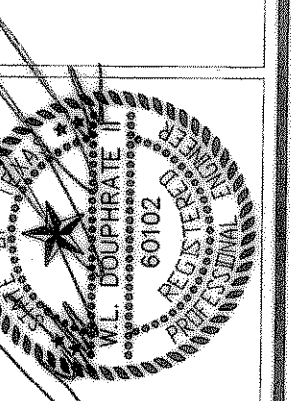

THE SEAL APPEARING ON THIS DOCUMENT WAS AUTHORIZED BY THE BOARD OF PROFESSIONAL ENGINEERS OF THE STATE OF TEXAS, P.E. NO. 60102 ON 5/1/02

DOUPHRATE & ASSOCIATES, INC.  
 ENGINEERING • PROJECT MANAGEMENT • SURVEYING  
 2235 RIDGE RD., # 200 ROCKWALL, TEXAS 75087  
 PHONE: (972)771-9004 FAX: (972)771-9006

**DRAINAGE AREA FOR PHASE I OF  
 THOMPSON BRANCH LIFT STATION  
 STONEY HOLLOW ADDITION**  
 CITY OF ROCKWALL, COUNTY OF ROCKWALL, TEXAS

REVISED TO CONFORM TO CONSTRUCTION RECORDS.  
 DATE: 1/12/04

REVISION

W.L.D.  
 CHECKED

A.J.W.  
 DRAWN

3/20/02  
 DATE

9907LS6  
 PROJECT

39A  
 OF  
 48