



AERIAL CROSSING DETAIL
NTS

- GENERAL NOTES:
1. DUCTILE IRON PIPE SHALL BE OF THE TYPE SHOWN IN THE SPECIFICATIONS AND SHALL HAVE THE WALL THICKNESS REQUIRED FOR THE SIZE AND SPAN AS DESIGNED.
 2. PIER PLACEMENT AND SPACING ALONG WITH A SOILS REPORT SHALL BE SUBMITTED TO THE CITY OF ROCKWALL'S CITY ENGINEER FOR APPROVAL.
 3. PIERS SHALL PENETRATE A MINIMUM OF 6'-0" FEET INTO ROCK OR BLUE SHALE.

REVISED TO CONFORM TO CONSTRUCTION RECORDS.
[Signature] DATE: 4/26/04

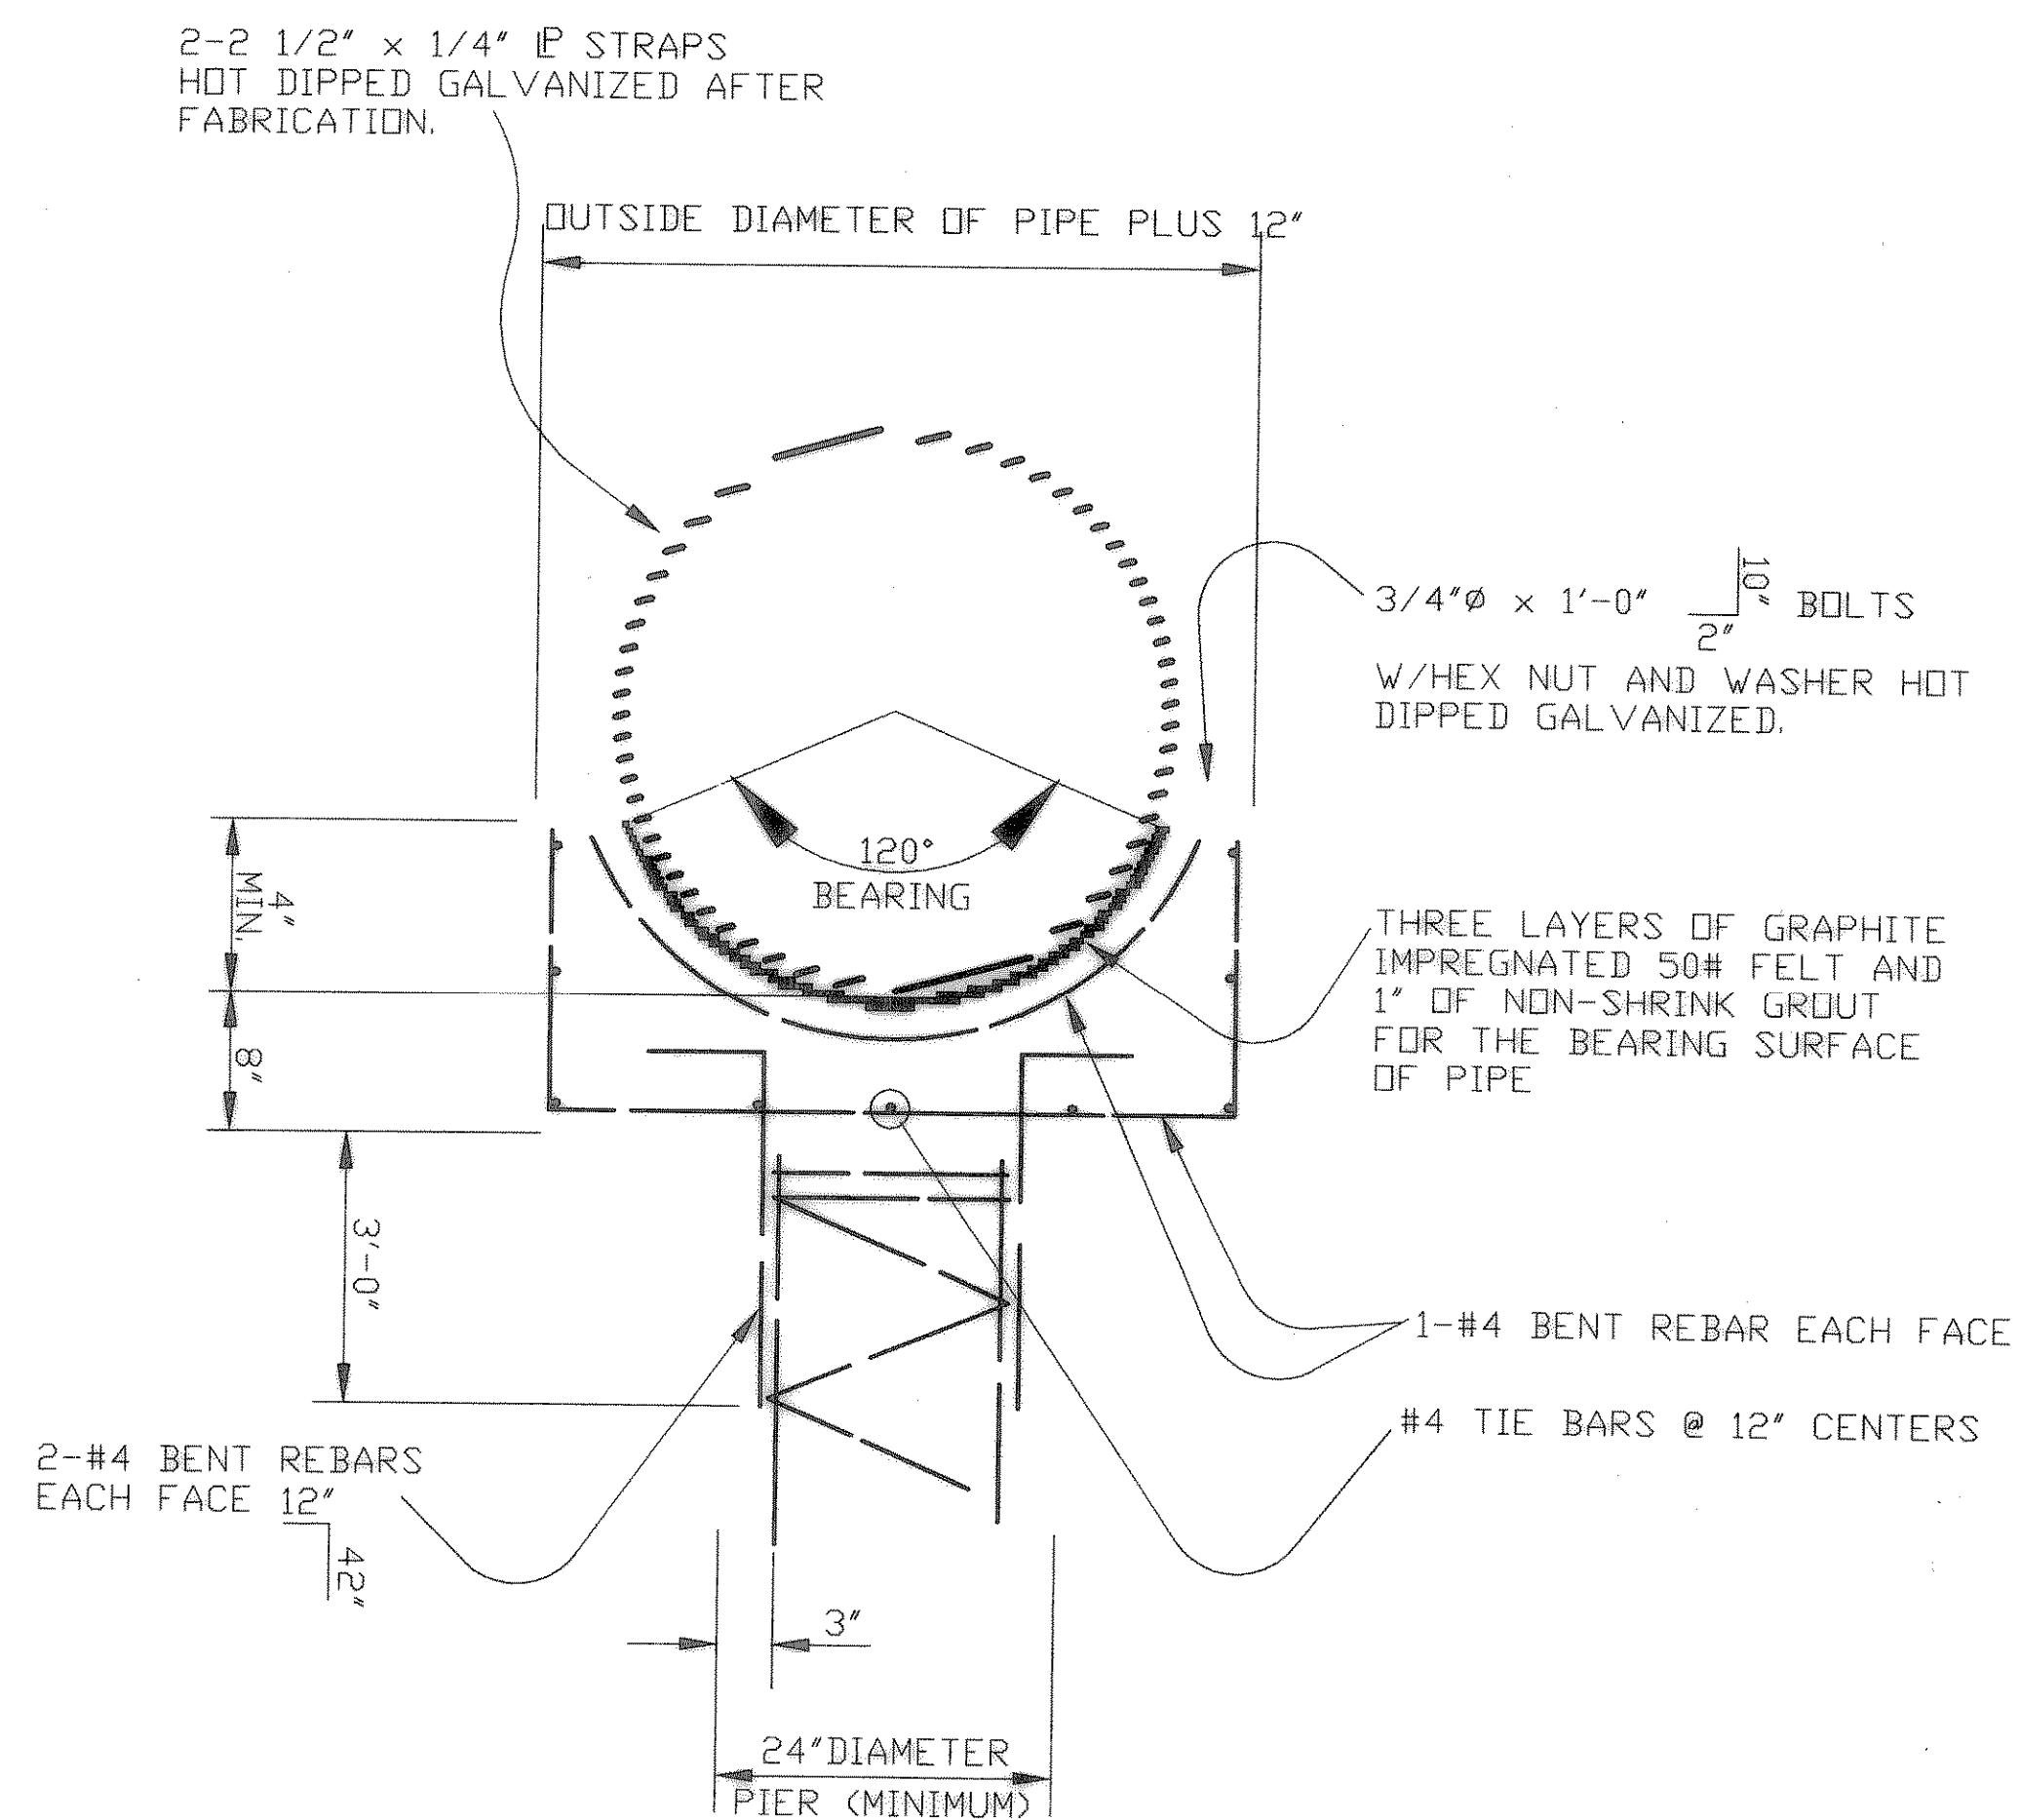


AERIAL CROSSING PIER CAP DETAIL "B"
NTS

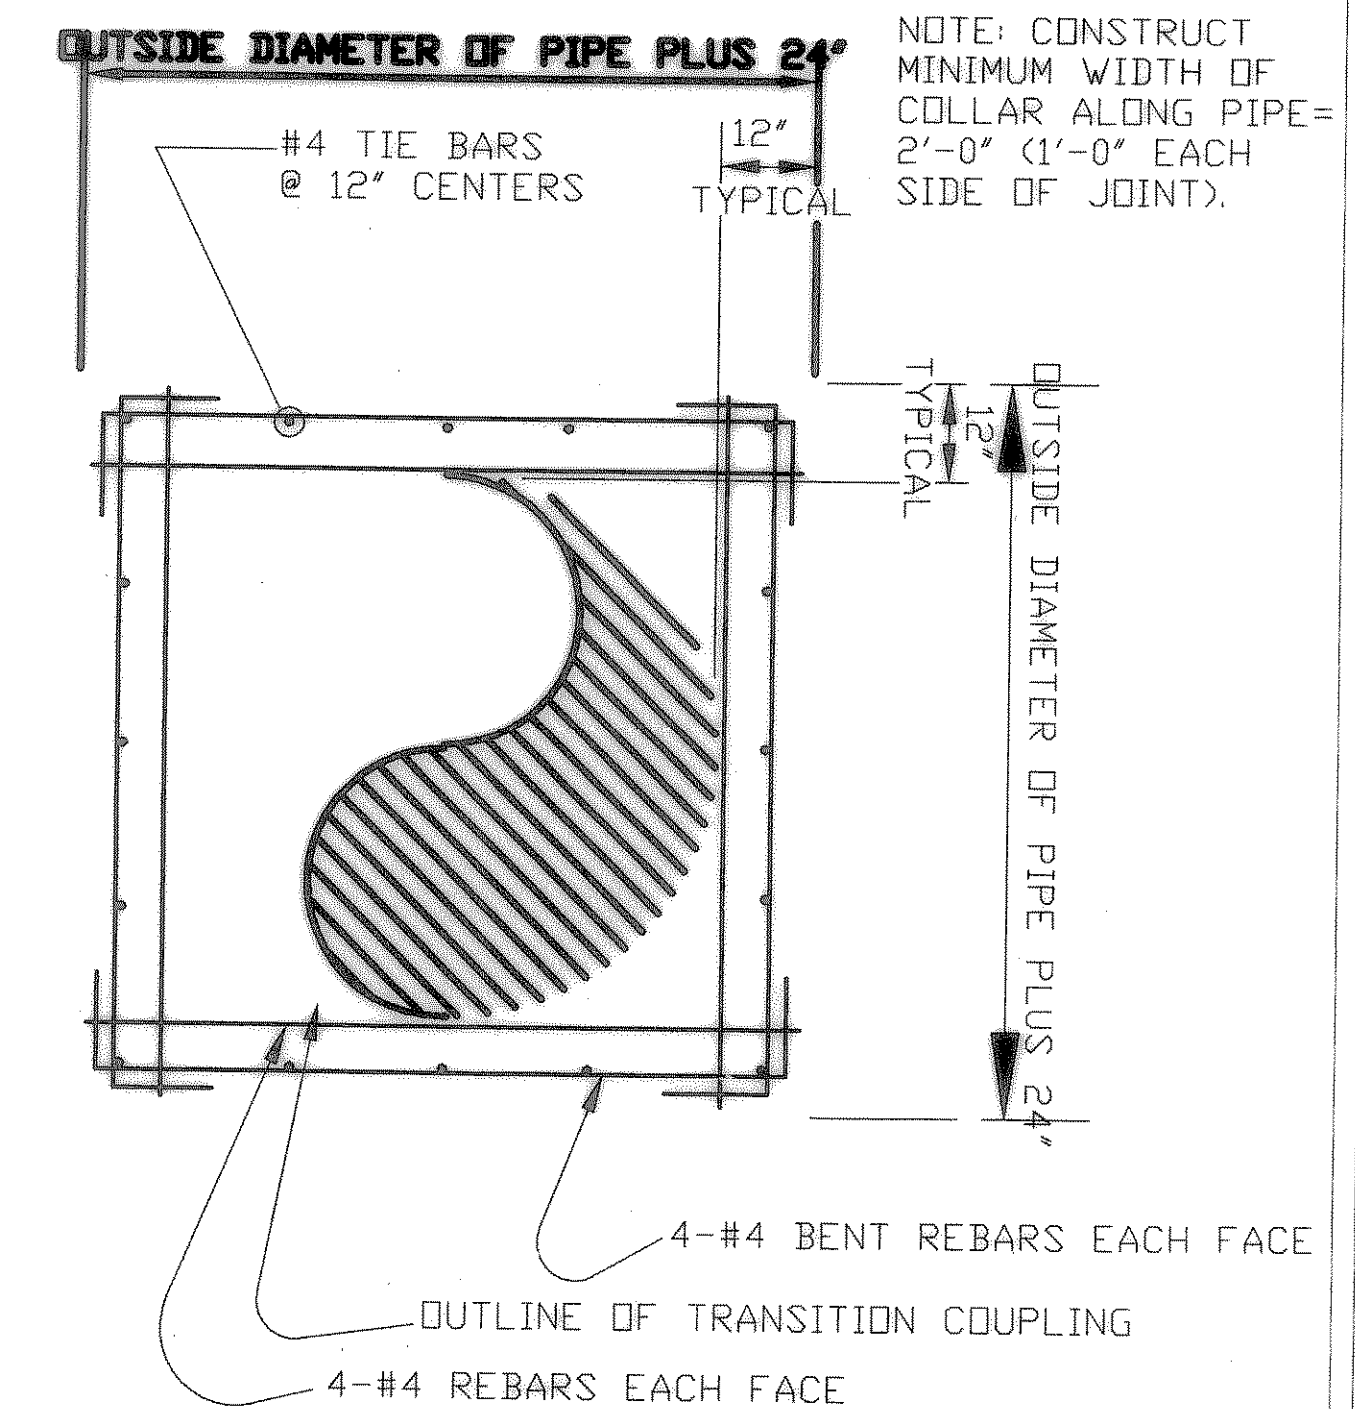

AERIAL CROSSING CONCRETE COLLAR DETAIL "A"
NTS

NOTE:
ALL EXPOSED EDGES SHALL HAVE A 1" X 45° CHAMFER.

MATERIALS SHALL CONFORM TO THE SPECIAL PROVISIONS AND/OR THE STANDARD SPECIFICATIONS.

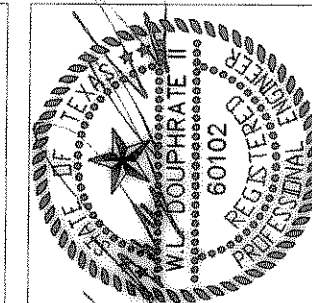

THE SEAL APPEARING ON THIS DOCUMENT WAS AUTHORIZED BY THE STATE OF TEXAS, PUBLIC WORKS P.E. NO. 80102 ON 8/2/04

DOUPHRETE & ASSOCIATES, INC.
CONSULTING - PROJECT MANAGEMENT - SURVEYING
2235 RIDGE RD., # 200 ROCKWALL, TEXAS 75087
PHONE: (972)771-9004 FAX: (972)771-9005

AERIAL CROSSING DETAILS
DETAILS
STONEY HOLLOW OFFSITE
CITY OF ROCKWALL, COUNTY OF ROCKWALL, TEXAS

REVISION	W.L.D.	A.J.W.	2/02	9907DET2	48
CHECKED					OF
					48