


DOUPHRA
& ASSOCIATES, INC.
ENGINEERING - PROJECT MANAGEMENT - SURVEYING
2236 RIDGE RD., # 200 ROCKWALL, TEXAS 75087
PHONE: (972)771-9004 FAX: (972)771-9005

TREE PRESERVATION PLAN
STONEY HOLLOW ADDITION
CITY OF ROCKWALL
ROCKWALL COUNTY, TEXAS

REVISION
CHECKED
W.L.D.
DRAWN
K.E.B.
DATE
1/02
PROJECT
9907TREE-2
8A
OF
48

TREE LEGEND

- BOIS D'ARC
- CEDAR
- HACKBERRY
- OAK
- PECAN
- SWEETGUM
- WILLOW
- TREE TO BE REMOVED

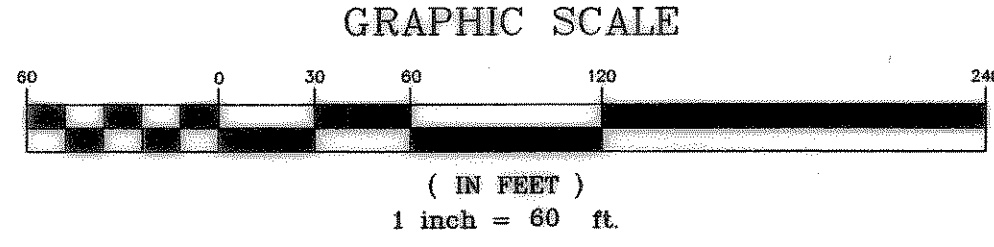

ROMAN CATHOLIC DIOCESE OF DALLAS
VOL. 115, PG. 438
CALLED 77.018 AC.



TREES TO BE REMOVED

TREE #	TYPE OF TREE	SIZE OF TREE
1481	HACK	14"
1482	HACK	12"
1472	HACK	16"
1511	HACK	12"
1512	HACK	14"
1513	HACK	12"
2031	HACK	10"
2037	HACK	6"
2039	HACK	12"

BENCHMARK NOTES:
R.R. SPIKE SET IN PP 89± E OF N.E. COR. OF PROPERTY
ELEV: 558.16
R.R. SPIKE SET IN PP 2± WEST OF N.W. COR. OF PROPERTY
ELEV: 549.83

TREE NOTE:
180" TO BE REMOVED
3266" TO REMAIN

REVISED TO CONFORM TO CONSTRUCTION RECORDS.
DATE: 4/2/16

WINDMILL VALLEY SUBDIVISION
SLIDE A, PAGE 157