


RECORD DRAWINGS
 THESE RECORD DRAWINGS HAVE BEEN PREPARED BASED ON INFORMATION PROVIDED BY THE CLIENT. THE ENGINEER HAS CONDUCTED VISUAL GENERAL VERIFICATION OF THE INFORMATION PROVIDED AND HAS FOUND IT TO BE REASONABLY ACCURATE AND COMPLETE. THE ENGINEER HAS NOT CONDUCTED ANY FIELD SURVEYING OR TESTING TO VERIFY THE INFORMATION PROVIDED. THE ENGINEER'S LIABILITY IS LIMITED TO THE INFORMATION PROVIDED BY THE CLIENT. THE ENGINEER'S LIABILITY IS LIMITED TO THE INFORMATION PROVIDED BY THE CLIENT. THE ENGINEER'S LIABILITY IS LIMITED TO THE INFORMATION PROVIDED BY THE CLIENT.

- LEGEND**
- CHANNEL FLOW DIRECTION
 - CHANNEL FLOWLINE
 - PROPOSED STORM SEWER
 - PROPOSED INLET
 - PROPOSED STORM MANHOLE
 - ELECTRICAL BOX (EB) / TRANSFORMER (TRN)
 - LIGHT POLE
 - WATER METER
 - RAISE PAD ELEVATIONS TO ELEVATIONS SHOWN

SEE SHEET 14 FOR X-SECTION DETAILS

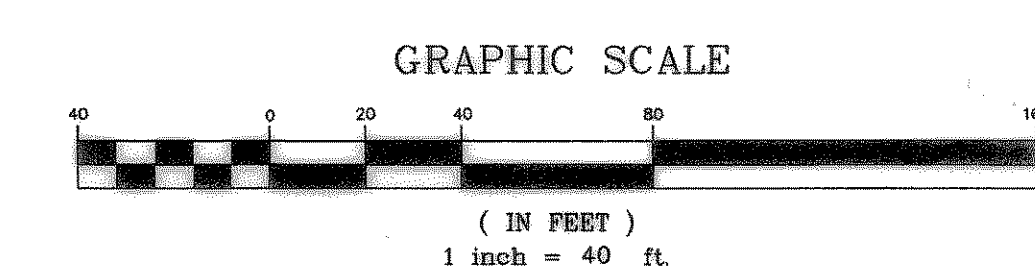

Benchmark #1- R.R. SPIKE SET IN PP 89± E OF N.E. COR. OF PROPERTY
 ELEV: 558.16
 Benchmark #2- R.R. SPIKE SET IN PP 2± WEST OF N.W. COR. OF PROPERTY
 ELEV: 549.83

REVISIONS DURING CONSTRUCTION		REVISIONS DURING PLAN REVIEW	
NO.	BY	NO.	BY

The seal appearing on this document was authorized by Brian L. Umberger, P.E. 82474. Alteration of a sealed document without proper notification to the responsible engineer is an offense under the Texas Engineering Practice Act.

J&B Jones & Boyd, Inc.
 17090 Dallas Parkway, Suite 200
 Dallas, Texas 75248
 Tel: 972-248-7676
 Fax: 972-248-1414

CHANNEL PLAN (2)
Stoney Hollow Addition
 City Rockwall, Rockwall County, Texas

PROJECT NO. HOE013
 SHEET NO. 13