


$Q_w = 26.36$ cfs
 $v = 0.98$ ft/ec
 $s = 12^\circ$
 $s = 0.0031$

CHANNEL X-SECTION (TYP.)
N.T.S.

RECORD DRAWINGS
 THESE RECORD DOCUMENTS HAVE BEEN PREPARED BASED ON INFORMATION PROVIDED BY OTHERS. JONES & BOYD, INC. HAS NOT VERIFIED THE ACCURACY AND/OR COMPLETENESS OF THIS INFORMATION. JONES & BOYD, INC. MAKES NO WARRANTY, EXPRESS OR IMPLIED, THAT THE INFORMATION PROVIDED IS CORRECT OR COMPLETE. A RESULT OF ENGINEERING INFORMATION PROVIDED BY OTHERS.
 JONES & BOYD, INC.
 BY: *[Signature]*
 DATE: 4/20/04

- LEGEND**
- CHANNEL FLOW DIRECTION
 - CHANNEL FLOWLINE
 - PROPOSED STORM SEWER
 - PROPOSED INLET
 - PROPOSED STORM MANHOLE
 - ELECTRICAL BOX (EB) / TRANSFORMER (TRN)
 - LIGHT POLE
 - WATER METER
 - RAISE PAD ELEVATIONS TO ELEVATIONS SHOWN

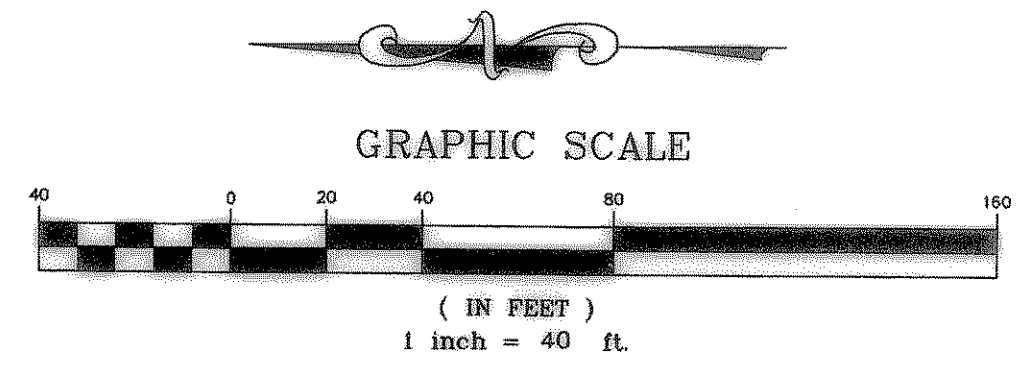

Benchmark #1- R.R. SPIKE SET IN PP 89± E OF N.E. COR. OF PROPERTY
 ELEV: 558.16
 Benchmark #2- R.R. SPIKE SET IN PP 2± WEST OF N.W. COR. OF PROPERTY
 ELEV: 549.83

NO.	REVISIONS DURING CONSTRUCTION	BY	DATE	NO.	REVISIONS DURING PLAN REVIEW	BY	DATE

The seal appearing on this document was authorized by Brian L. Umberger, P.E. 82474. Alteration of a sealed document without proper notification to the responsible engineer is an offense under the Texas Engineering Practice Act.

J&B Jones & Boyd, Inc.
 17090 Dallas Parkway, Suite 200
 Dallas, Texas 75248
 Tel: 972-248-7676
 Fax: 972-248-1414

CHANNEL PLAN (3)
Stoney Hollow Addition
 City Rockwall, Rockwall County, Texas

PROJECT NO. H0E013
 SHEET NO. 14