

Development Plans


RANDALL NOE

SUBARU

City of Rockwall ~ Rockwall County, Texas

Index of Sheets


<u>Sheet No.</u>	<u>Title</u>
1	Cover Sheet
--	Final Plat
2	Demolition Plan
3	Erosion Control Plan
4	Site Plan
5	Paving Plan
6	Grading Plan
7	Pre Developed Drainage Area Map
8	Post Developed Drainage Area Map
9-9A	Storm Sewer Plan and Profiles
10A-F	Detention Pond Plan and Calculations
11	Utility Plan
--	Retaining Wall Plans

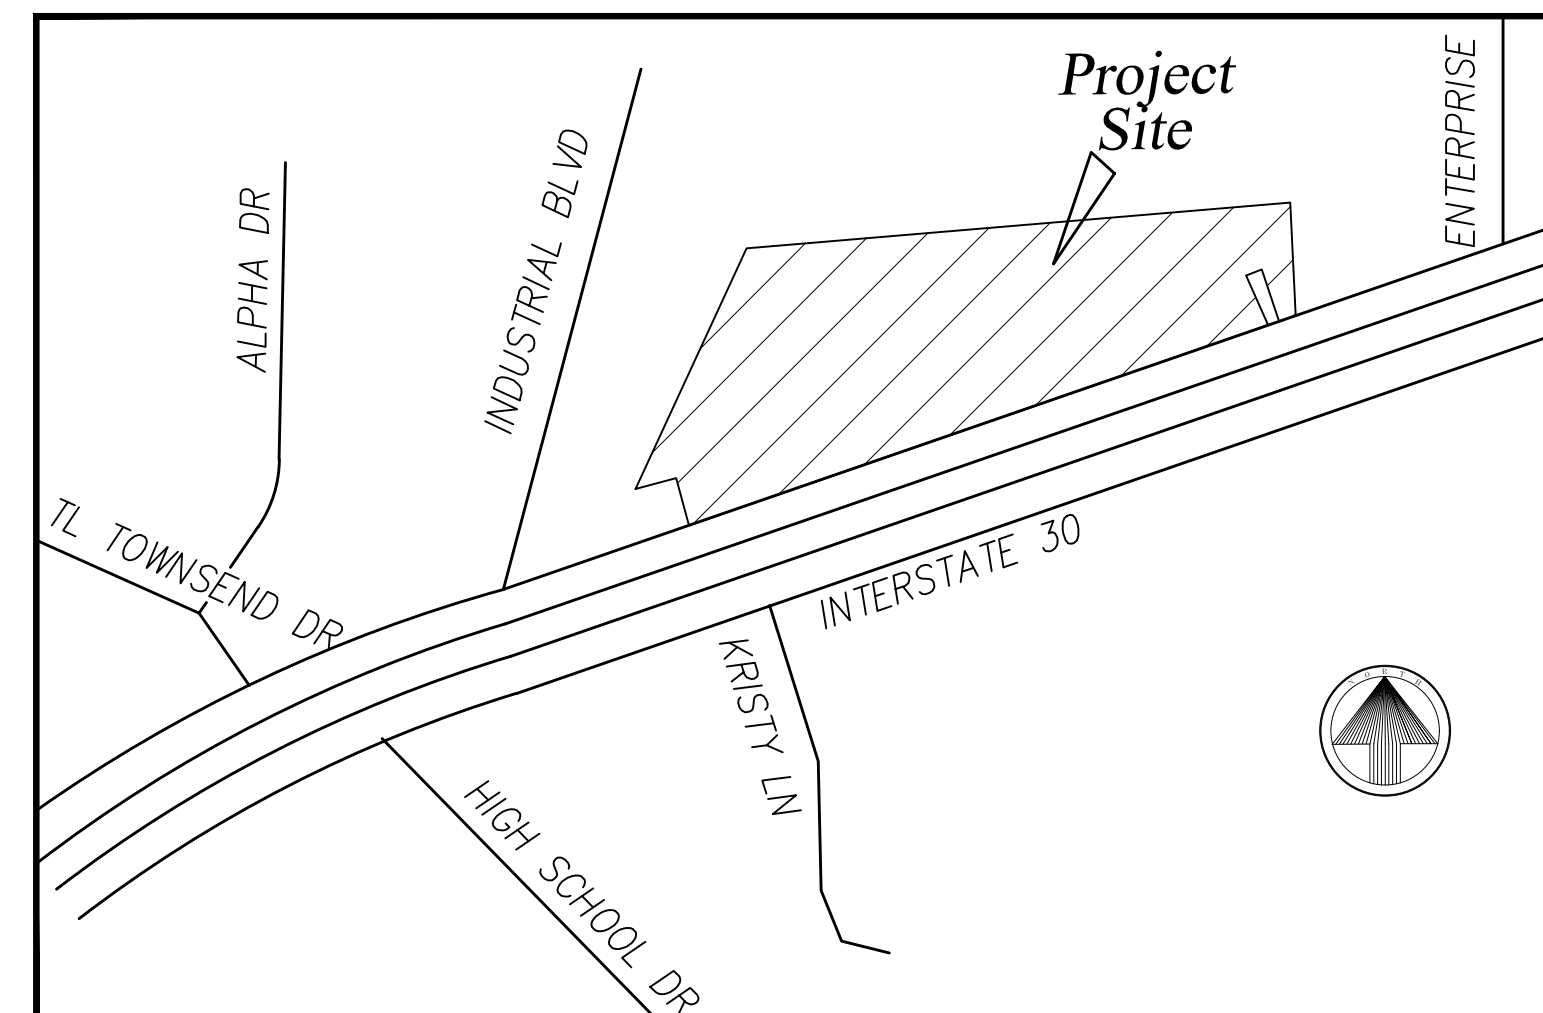

LOCATION MAP

Owner:
 Rockwall Rental Properties
 P.O. 818
 Terrell, Texas 75060

Engineer:
 F.C. Cuny Corp. 
 #2 Horizon Court
 Suite 500
 Heath, Texas 75032
 469.402.7700
 Texas Registered Engineering Firm F-7449

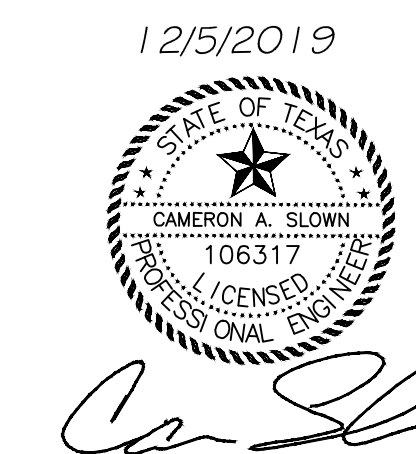

Record Drawings
December 2019