



Revision	Date	Description

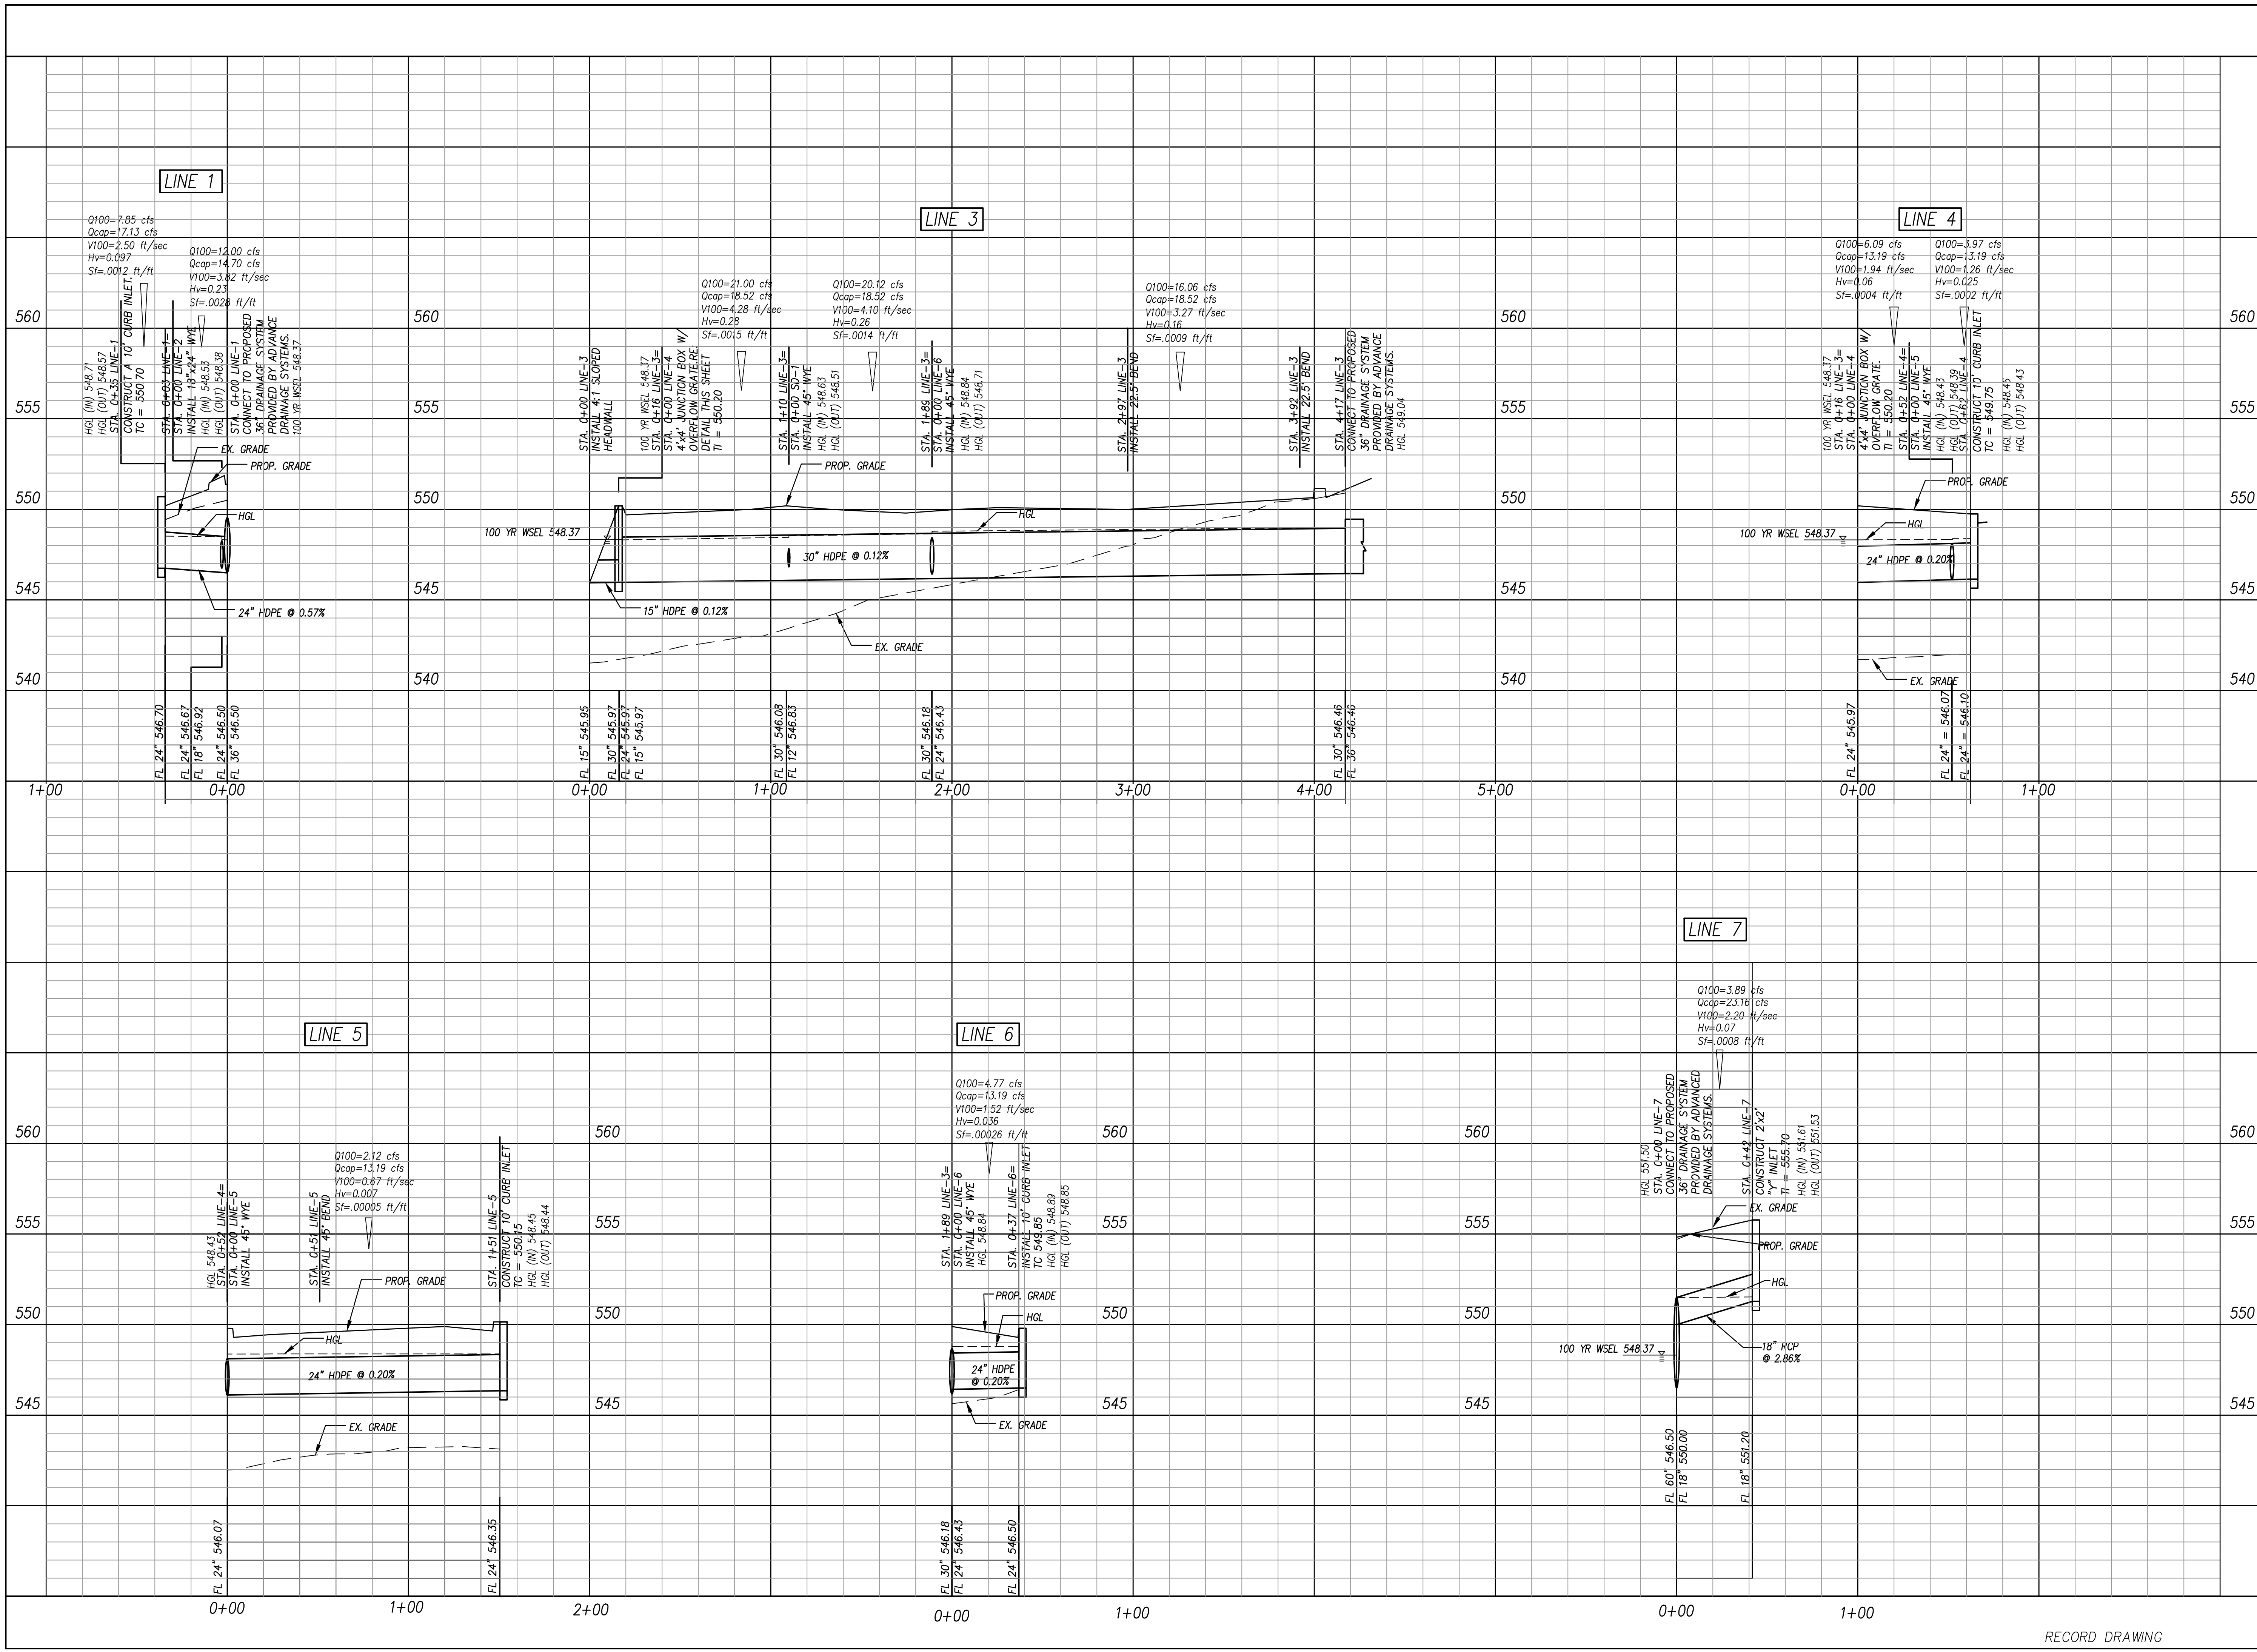

Owner:
Rockwall Rental Properties
 PO Box 818 • Terrell, Texas 75060

RANDALL NOE
SUBARU
 I-30 ROCKWALL, TX

~ Civil Engineer ~
F.C. CUNY CORPORATION
 #2 Horizon Court • Ste. 500 • Heath, Texas 75032
 Phone: 469-402-7700
 Fax: 469-402-0700
 Texas Registered Engineering Firm F-7449

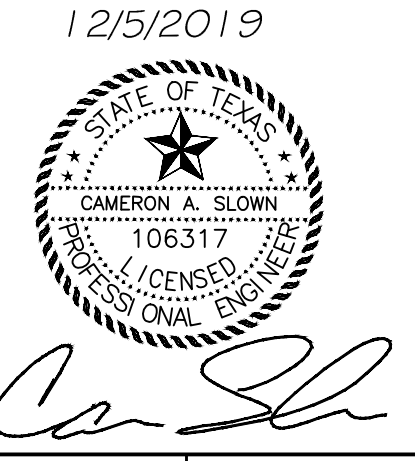

Drawn By: F.C. CUNY	Checked By: F.C. CUNY
Date: 09/18	Project No.:
Sheet Title: Storm Line Profiles	
Scale: 1"=40'	Sheet No.: