

SUBWAY/GATEWAY/HEALTH FOOD STORE

CITY OF ROCKWALL


ROCKWALL COUNTY, TEXAS

JUNE 2006

PREPARED BY:



1120 S. FREEWAY SUITE 118
 FT WORTH, TX 76104
 PHONE (817) 885-8600
 FAX (817) 796-1042

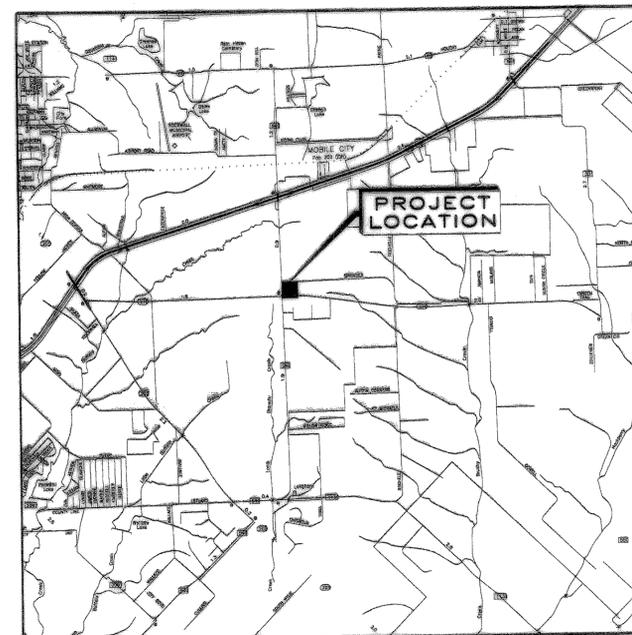

VICINITY MAP
 SCALE: N.T.S.

6/4/07 RECORD DRAWING
 5/30/06 ISSUE FOR PERMIT

STREET INDEX:

■ ■	C-0.0	COVER SHEET
■ ■		FINAL PLAT
■ ■	C-2.0	GENERAL NOTES
■ ■	C-3.0	SITE PLAN
■ ■	C-3.1	PAVING PLAN
■ ■	C-4.0	GRADING PLAN
■ ■	C-4.1	DRAINAGE AREA MAP
■ ■	C-4.2	EROSION CONTROL PLAN
■ ■	C-5.0	UTILITY PLAN
■ ■	C-5.1	SANITARY AND STORM SEWER PROFILE
■ ■	C-6.0	CONSTRUCTION DETAILS

LEGAL DESCRIPTION

BEING A TRACT OF LAND SITUATED IN THE J.A. RAMSAY SURVEY ABSTRACT NO. 186, ROCKWALL COUNTY, TEXAS AND BEING THAT TRACT OF LAND CONVEYED BY ROLAND E. COBB, JR. AND MARTHA COBB TO STEVE WAGNER BY DEED AS RECORDED IN VOLUME 3103, PAGE 92, OF THE DEED RECORDS OF ROCKWALL COUNTY, TEXAS.

RECORD DRAWINGS

THE DRAWINGS CONTAINED IN THIS SET ARE "RECORD DRAWINGS". THE INFORMATION SHOWN ON THESE SHEETS, WHERE IT DIFFERS FROM THE PERMITTED SET, IS TAKEN FROM FIELD OBSERVATIONS AND NOTES PROVIDED BY THE GENERAL CONTRACTOR.

