


# CONSTRUCTION PLANS FOR SURGERY CENTER OF ROCKWALL ON LOT 3R, BLOCK B THE WOODS AT ROCKWALL ADDITION NO. 1

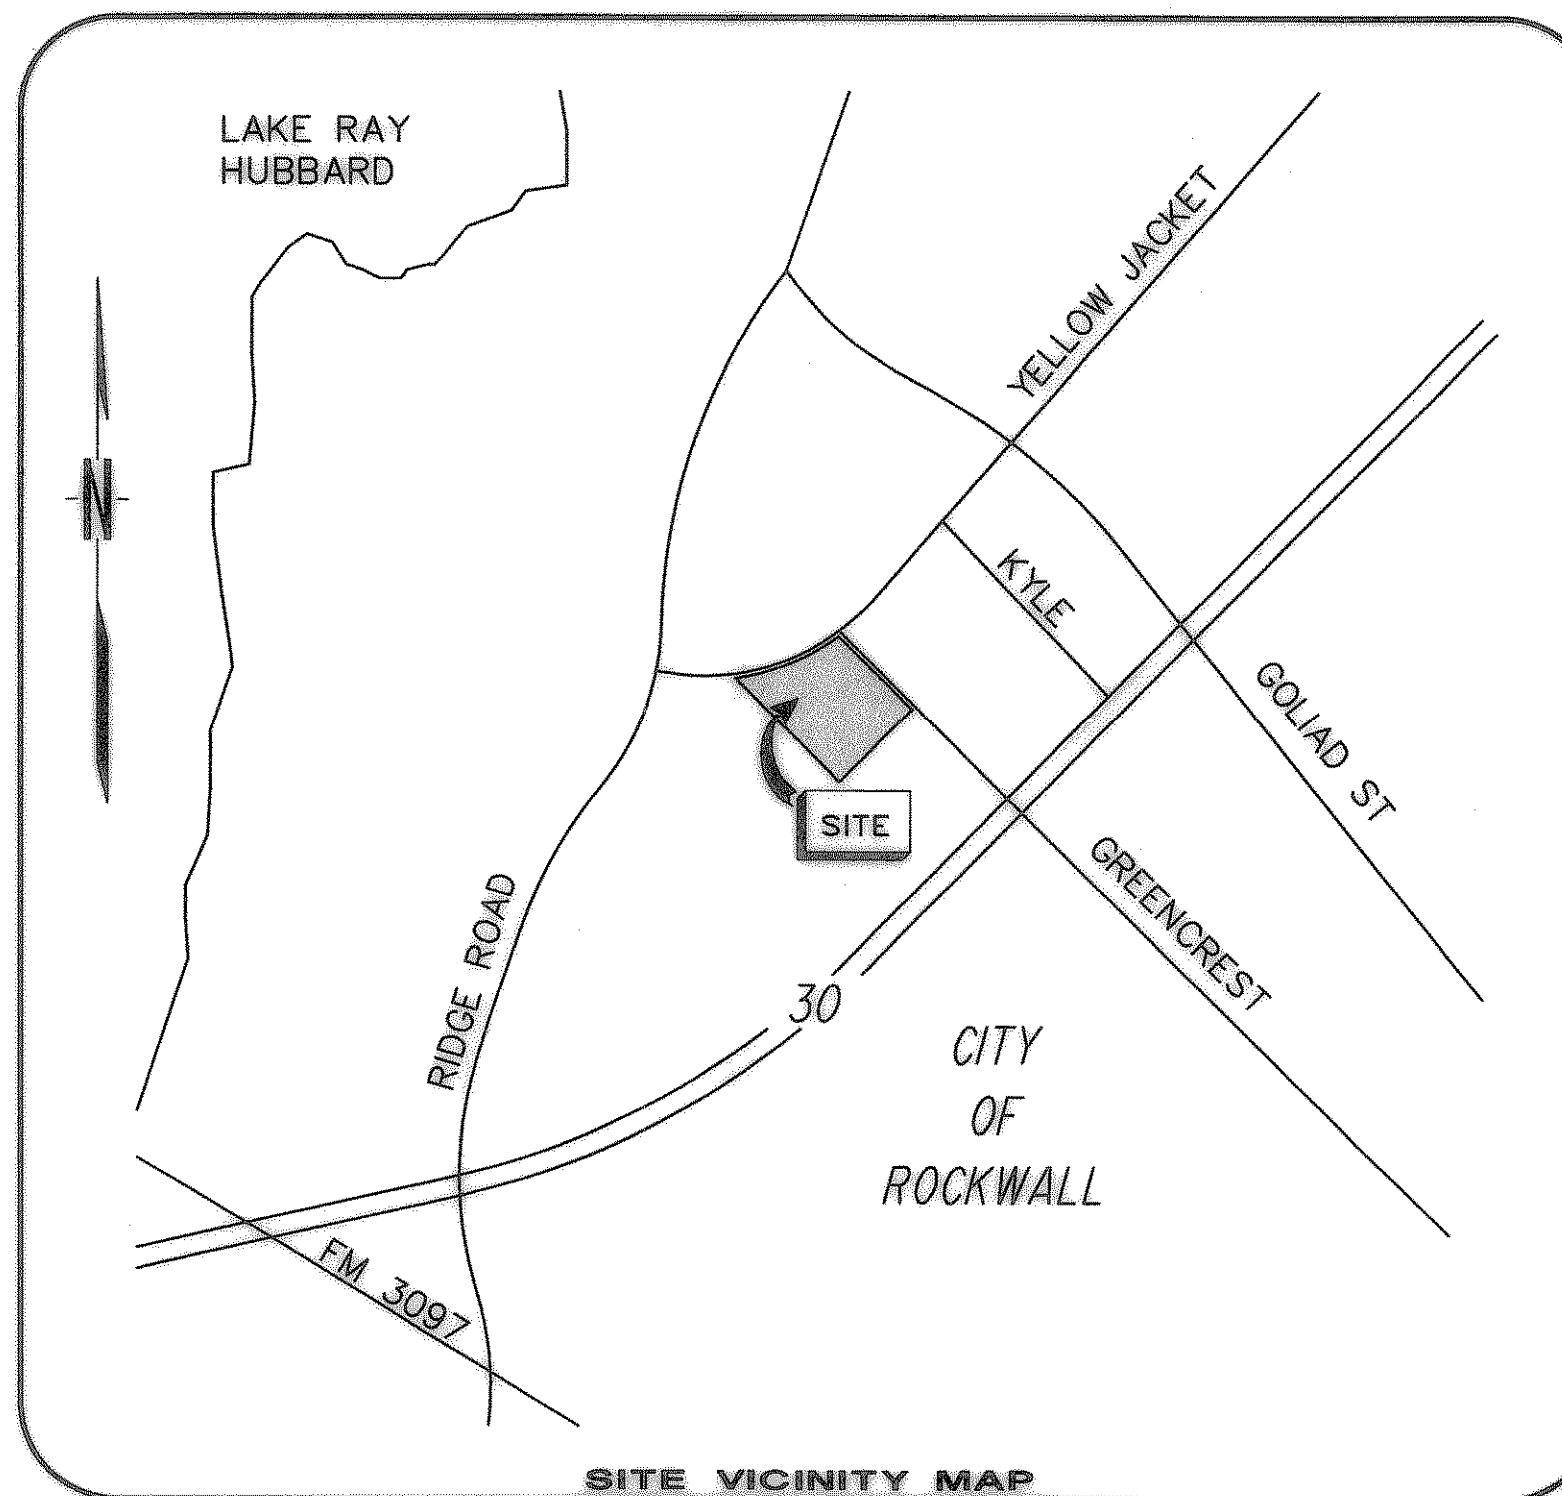

SITE VICINITY MAP

**PLANS PROFILES AND DETAILS  
APPROVED FOR THIS PROJECT**

SHEETS	DESCRIPTION
1	COVER SHEET
2	FINAL PLAT
3	SITE DIMENSIONAL CONTROL PLAN
4	GRADING & DRAINAGE PLAN
5	DETENTION CALCULATIONS
6	PAVING PLAN
7	EROSION CONTROL PLAN
8	UTILITY PLAN
9	TREE / EXISTING CONDITIONS SURVEY
10	STORM SEWER PLAN & PROFILE
L1.1	TREE MITIGATION
L1.2	LANDSCAPE PLAN

## OWNER


ROCKWALL ASC REAL ESTATE, L.L.P.  
c/o LESLIE T. HANSEN  
DUVALL/HANSEN AND ASSOCIATES INC.  
310 E-INTERSTATE 30, SUITE B-107  
GARLAND, TEXAS 75043  
(972) 226-6564



## ENGINEER/SURVEYOR

GONZALEZ & SCHNEEBERG  
660 N. CENTRAL EXPRESSWAY, SUITE 250  
PLANO, TEXAS 75074  
(972) 516-8855  
(972) 516-8901 fax

### RECORD DRAWING

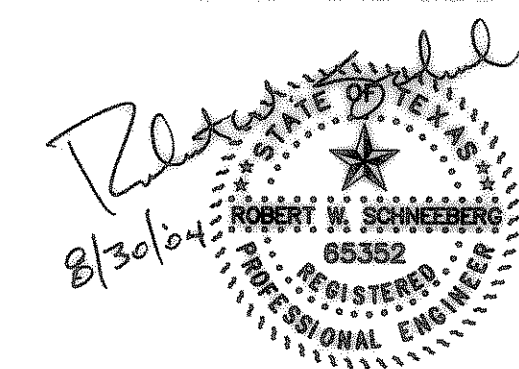THIS DRAWING HAS BEEN REVISED TO  
REFLECT CONSTRUCTION RECORDS  
MAINTAINED BY THE GENERAL CONTRACTOR:  
RIDGEMONT COMMERCIAL CONSTRUCTION  
DATE OF REVISION: AUGUST 30, 2004


  
THE SEAL APPEARING ON THIS DOCUMENT WAS  
AUTHORIZED BY ROBERT W. SCHNEEBERG, P.E.  
65352 ON 08/30/2004. ALTERATION OF A  
SEALED DOCUMENT WITHOUT PROPER NOTIFICATION  
TO THE RESPONSIBLE ENGINEER IS AN OFFENSE  
UNDER THE TEXAS ENGINEERING PRACTICE ACT.

 Changes for record drawing 8-30-04  
 REVISED SHEET LIST 12-01-03