

RUNOFF CALCULATIONS

100-YEAR EXISTING CONDITIONS

Area	Acreeage	c	I	Q
1	0.12	0.35	8.3	0.35
2	0.26	0.35	8.3	0.76
3	0.29	0.35	8.3	0.84
4	0.65	0.35	8.3	1.89
5	0.42	0.35	8.3	1.22
6	0.13	0.35	8.3	0.38
Total =	1.87			5.43

100-YEAR PROPOSED CONDITIONS

Area	Acreeage	c	I	Q
1	0.12	0.35	8.3	0.35
2	0.26	0.35	8.3	0.76
3	0.29	0.35	8.3	0.84
4	0.65	0.35	8.3	1.89
5	0.42	0.35	8.3	1.22
6	0.13	0.35	8.3	0.38
Total =	1.87			12.53

50-YEAR EXISTING CONDITIONS

Area	Acreeage	c	I	Q
1	0.12	0.35	7.4	0.31
2	0.26	0.35	7.4	0.67
3	0.29	0.35	7.4	0.75
4	0.65	0.35	7.4	1.68
5	0.42	0.35	7.4	1.09
6	0.13	0.35	7.4	0.34
Total =	1.87			4.84

50-YEAR PROPOSED CONDITIONS

Area	Acreeage	c	I	Q
1	0.12	0.35	7.4	0.31
2	0.26	0.35	7.4	0.67
3	0.29	0.35	7.4	0.75
4	0.65	0.35	7.4	1.68
5	0.42	0.35	7.4	1.09
6	0.13	0.35	7.4	0.34
Total =	1.87			11.46

25-YEAR EXISTING CONDITIONS

Area	Acreeage	c	I	Q
1	0.12	0.35	6.6	0.28
2	0.26	0.35	6.6	0.60
3	0.29	0.35	6.6	0.67
4	0.65	0.35	6.6	1.50
5	0.42	0.35	6.6	0.97
6	0.13	0.35	6.6	0.30
Total =	1.87			4.32

25-YEAR PROPOSED CONDITIONS

Area	Acreeage	c	I	Q
1	0.12	0.35	6.6	0.28
2	0.26	0.35	6.6	0.60
3	0.29	0.35	6.6	0.67
4	0.65	0.35	6.6	1.50
5	0.42	0.35	6.6	0.97
6	0.13	0.35	6.6	0.30
Total =	1.87			10.51

10-YEAR EXISTING CONDITIONS

Area	Acreeage	c	I	Q
1	0.12	0.35	5.8	0.24
2	0.26	0.35	5.8	0.53
3	0.29	0.35	5.8	0.59
4	0.65	0.35	5.8	1.32
5	0.42	0.35	5.8	0.85
6	0.13	0.35	5.8	0.26
Total =	1.87			3.80

10-YEAR PROPOSED CONDITIONS

Area	Acreeage	c	I	Q
1	0.12	0.35	5.8	0.24
2	0.26	0.35	5.8	0.53
3	0.29	0.35	5.8	0.59
4	0.65	0.35	5.8	1.32
5	0.42	0.35	5.8	0.85
6	0.13	0.35	5.8	0.26
Total =	1.87			9.14

Allowable pond outflow is computed by taking the Total Existing Conditions Runoff and subtracting the Proposed Conditions Runoff from Areas 1 and 2 (which are undetained) to determine the maximum allowable discharge from the Detention Pond to insure that there is no increase in Runoff from the 10-year, 25-year, 50-year and 100-year design storms. The Actual Pond Outflow is taken from the routing computations below.

CALCULATION OF REQUIRED DETENTION VOLUME

Storm Duration	Rainfall Intensity	Volume	Required Storage
15	9.0	Inflow = 8424 Outflow = 2511	5913
20	8.3	Inflow = 10358 Outflow = 2930	7429
30	6.9	Inflow = 12917 Outflow = 3767	9150
40	5.8	Inflow = 14477 Outflow = 4604	9873
50	5.0	Inflow = 15600 Outflow = 5441	10160 REQUIRED
60	4.3	Inflow = 16099 Outflow = 6278	9822
70	3.9	Inflow = 17035 Outflow = 7115	9921
80	3.6	Inflow = 17971 Outflow = 7952	10020
90	3.3	Inflow = 18533 Outflow = 8789	9744
100	3.0	Inflow = 18720 Outflow = 9626	9095
110	2.8	Inflow = 19219 Outflow = 10463	8757
120	2.6	Inflow = 19469 Outflow = 11300	8169

STAGE/STORAGE CURVE FOR POND

Rockwall-DET-Final
Prepared by Gonzalez & Schneeberg, Engineers & Surveyors, Inc.
HydroCAD® 6.00 s/n 001875 © 1986-2001 Applied Microcomputer Systems
Type II 24-hr Rainfall=9.80"
Page 1
12/16/2003

Pond 1P: ROCKWALL			Pond 1P: ROCKWALL		
Elevation (feet)	Surface (sq-ft)	Storage (cubic-feet)	Elevation (feet)	Surface (sq-ft)	Storage (cubic-feet)
486.20	0	0	491.40	2,865	13,056
486.30	325	130	491.50	2,871	13,352
486.40	650	260	491.60	2,877	13,639
486.50	975	390	491.70	2,884	13,925
486.60	1,300	520	491.80	2,890	14,212
486.70	1,625	650			
486.80	1,950	780			
486.90	2,275	910			
487.00	2,600	1,040			
487.10	2,925	1,303			
487.20	3,250	1,566			
487.30	3,575	1,829			
487.40	3,900	2,092			
487.50	4,225	2,355			
487.60	4,550	2,618			
487.70	4,875	2,881			
487.80	5,200	3,144			
487.90	5,525	3,407			
488.00	5,850	3,670			
488.10	6,175	3,933			
488.20	6,500	4,208			
488.30	6,825	4,477			
488.40	7,150	4,746			
488.50	7,475	5,015			
488.60	7,800	5,284			
488.70	8,125	5,553			
488.80	8,450	5,822			
488.90	8,775	6,091			
489.00	9,100	6,360			
489.10	9,425	6,635			
489.20	9,750	6,910			
489.30	10,075	7,185			
489.40	10,400	7,460			
489.50	10,725	7,735			
489.60	11,050	8,010			
489.70	11,375	8,285			
489.80	11,700	8,560			
489.90	12,025	8,835			
490.00	12,350	9,110			
490.10	12,675	9,391			
490.20	13,000	9,672			
490.30	13,325	9,953			
490.40	13,650	10,234			
490.50	13,975	10,515			
490.60	14,300	10,796			
490.70	14,625	11,077			
490.80	14,950	11,358			
490.90	15,275	11,639			
491.00	15,600	11,920			
491.10	15,925	12,201			
491.20	16,250	12,482			
491.30	16,575	12,763			

STAGE/DISCHARGE CURVE VERTICAL ORIFICE WITH OVERFLOW TO LIP OF WYE INLET


Rockwall-DET-Final
Prepared by Gonzalez & Schneeberg, Engineers & Surveyors, Inc.
HydroCAD® 6.00 s/n 001875 © 1986-2001 Applied Microcomputer Systems
Type II 24-hr Rainfall=9.80"
Page 1
12/16/2003

Pond 1P: ROCKWALL

Elevation (feet)	Primary (cfs)	Elevation (feet)	Primary (cfs)	Elevation (feet)	Primary (cfs)
486.20	0.00	488.26	1.67	490.36	2.46
486.24	0.01	488.32	1.69	490.40	2.47
486.28	0.02	488.38	1.71	490.44	2.49
486.32	0.05	488.40	1.73	490.48	2.50
486.36	0.08	488.44	1.75	490.52	2.51
486.40	0.12	488.48	1.76	490.56	2.52
486.44	0.17	488.52	1.78	490.60	2.54
486.48	0.23	488.56	1.80	490.64	2.57
486.52	0.29	488.60	1.82	490.68	2.59
486.56	0.35	488.64	1.83	490.72	2.61
486.60	0.42	488.68	1.85	490.76	2.63
486.64	0.48	488.72	1.87	490.80	2.65
486.68	0.55	488.76	1.88	490.84	2.67
486.72	0.61	488.80	1.90	490.88	2.69
486.76	0.66	488.84	1.92	490.92	2.71
486.80	0.70	488.88	1.93	490.96	2.73
486.84	0.74	488.92	1.95	491.00	2.75
486.88	0.78	488.96	1.97	491.04	2.77
486.92	0.82	489.00	1.98	491.08	2.79
486.96	0.86	489.04	2.00	491.12	2.81
487.00	0.90	489.08	2.01	491.16	2.83
487.04	0.93	489.12	2.03	491.20	2.85
487.08	0.96	489.16	2.04	491.24	2.87
487.12	0.99	489.20	2.06	491.28	2.89
487.16	1.03	489.24	2.07	491.32	2.91
487.20	1.06	489.28	2.09	491.36	2.93
487.24	1.08	489.32	2.10	491.40	2.95
487.28	1.11	489.36	2.12	491.44	2.97
487.32	1.14	489.40	2.13	491.48	2.99
487.36	1.17	489.44	2.15	491.52	3.01
487.40	1.19	489.48	2.16	491.56	3.03
487.44	1.22	489.52	2.18	491.60	3.05
487.48	1.25	489.56	2.19	491.64	3.07
487.52	1.27	489.60	2.21	491.68	3.09
487.56	1.29	489.64	2.22	491.72	3.11
487.60	1.32	489.68	2.23	491.76	3.13
487.64	1.34	489.72	2.25	491.80	3.15
487.68	1.37	489.76	2.26		
487.72	1.39	489.80	2.28		
487.76	1.41	489.84	2.29		
487.80	1.43	489.88	2.30		
487.84	1.45	489.92	2.32		
487.88	1.48	489.96	2.33		
487.92	1.50	490.00	2.34		
487.96	1.52	490.04	2.35		
488.00	1.54	490.08	2.37		
488.04	1.56	490.12	2.38		
488.08	1.58	490.16	2.40		
488.12	1.60	490.20	2.41		
488.16	1.62	490.24	2.42		
488.20	1.64	490.28	2.43		
488.24	1.66	490.32	2.45		

BENCHMARKS:
TOP OPERATING NUT OF FIRE HYDRANT AT INTERSECTION OF YELLOW JACKET LN. AND KYLE DR.
ELEV. = 529.26

Robert W. Schneeberg 8/30/04
THE SEAL APPEARING ON THIS DOCUMENT WAS AUTHORIZED BY ROBERT W. SCHNEEBERG, P.E. 65352 ON 08/30/2004. ALTERATION OF A SEALED DOCUMENT WITHOUT PROPER NOTIFICATION TO THE RESPONSIBLE ENGINEER IS AN OFFENSE UNDER THE TEXAS ENGINEERING PRACTICE ACT.

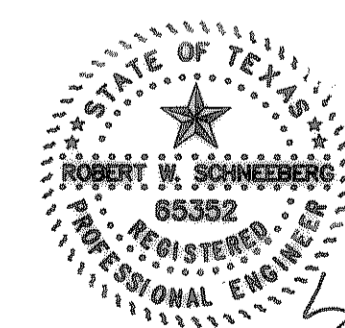

RECORD DRAWING
THIS DRAWING HAS BEEN REVISED TO REFLECT CONSTRUCTION RECORDS MAINTAINED BY THE GENERAL CONTRACTOR: RIDGEMONT COMMERCIAL CONSTRUCTION
DATE OF REVISION: AUGUST 30, 2004

PROJ. NO. 4956-03-07-15 DWG. NO. 4956rd.dwg
Gonzalez & Schneeberg engineers = surveyors
860 N. Central Expressway Suite 250, Plano, Texas 75074 (972) 516-8855 Fax: (972) 516-8801
DETENTION CALCULATIONS
LOT 3R, BLOCK B, THE WOODS AT ROCKWALL ADDITION NO. 1
SURGERY CENTER OF ROCKWALL
CITY OF ROCKWALL, TEXAS

DESIGN	DRAWN	DATE	SCALE	NOTES	FILE	NO.
GES	GES	NOVEMBER 2003	1"=20'			

NO. DATE REVISION

100-YEAR STORM ROUTING

Rockwall-DET-Final
Prepared by Gonzalez & Schneeberg, Engineers & Surveyors, Inc.
HydroCAD® 6.00 s/n 001875 © 1986-2001 Applied Microcomputer Systems
Type II 24-hr Rainfall=9.80"
Page 1
12/16/2003

Pond 1P: ROCKWALL

Inflow = 12.91 cfs @ 12.02 hrs, Volume= 0.700 af
Outflow = 2.54 cfs @ 12.27 hrs, Volume= 0.694 af, Atten= 80%, Lag= 15.5 min
Primary = 2.54 cfs @ 12.27 hrs, Volume= 0.694 af

Routing by Stor-Ind method, Time Span= 0.00-24.00 hrs, dt= 0.01 hrs
Peak Elev= 490.60' Storage= 10,799 cf
Plug-Flow detention time= 43.8 min calculated for 0.694 af (99% of inflow)
Storage and wetted areas