


A TREE MITIGATION PLAN
SCALE: 1"=16'-0"



LEGEND

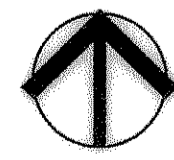

EXISTING TREE TO REMAIN
RE: EXISTING TREE LIST



EXISTING TREE TO BE REMOVED
RE: EXISTING TREE LIST

EXISTING TREE LIST


TREE #	CALIPER & SPECIES	CONDITION	TREE CREDITS
1 *	14 1/2" RED OAK	HEALTHY/TO REMAIN	0
2	10 1/2" TEXAS ASH	EXCESSIVE DIEBACK	0
3 *	17 1/2" RED OAK	HEALTHY/TO REMAIN	0
4 *	26" RED OAK	HEALTHY/TO REMAIN	+26
5 *	17" RED OAK	HEALTHY/TO REMAIN	0
6	19" WHITE OAK	REMOVE	-19
7	8" EASTERN RED CEDAR	HEALTHY/TO REMAIN	0
8	4" RED OAK	REMOVE/TOO SMALL TO COUNT	0
9	9 1/2" RED OAK	REMOVE	-9.5
10	HACKBERRY	DEAD/REMOVE	0
11	HACKBERRY	DEAD/REMOVE	0
12	8" TEXAS ASH	EXCESSIVE DIEBACK	0
13	11" PECAN	REMOVE	-11
14	10 1/2" RED OAK	REMOVE	-10.5
15	4" RED OAK	REMOVE/TOO SMALL TO COUNT	0
16	8 1/2" RED OAK	REMOVE	-8.5
17	15" TEXAS ASH	EXCESSIVE DIEBACK	0
18	HACKBERRY	DEAD/REMOVE	0
19	12 1/2" PECAN	REMOVE	-12.5
20	12 1/2" CEDAR ELM	REMOVE	-12.5
21	8 1/2" CEDAR ELM	REMOVE	-8.5
22	12 1/2" TEXAS ASH	REMOVE	-12.5
23	11 1/2" OSAGE ORANGE	REMOVE	-8.62
24	12" TEXAS ASH	EXCESSIVE DIEBACK	0
25	12" CEDAR ELM	REMOVE	-12
26	15 1/2" BOX ELDER	REMOVE	-15.5
27	15" BOX ELDER	REMOVE	-15
28	9" COTTONWOOD	REMOVE	-6.75
29	16" OSAGE ORANGE	REMOVE	-12
30	14" TEXAS ASH	REMOVE	-14
31	11" TEXAS ASH	REMOVE	-11
32	9 1/2" CEDAR ELM	REMOVE	-9.5
33	10 1/2" CEDAR ELM	EXCESSIVE LEAN	0
34	11" CEDAR ELM	REMOVE	-11
35	9" TEXAS ASH	REMOVE	-9
36	9" CEDAR ELM	REMOVE	-9
37	9" CEDAR ELM	REMOVE	-9
38	10 1/2" CEDAR ELM	REMOVE	-10.5
39	11 1/2" TEXAS ASH	REMOVE	-11.5
40	8" WILLOW	REMOVE	-8
41	15" WILLOW	REMOVE	-11.25
42	9 1/2" CEDAR ELM	REMOVE	-9.5
43	13" TEXAS ASH	REMOVE	-13
44	7" HACKBERRY	REMOVE	-5.25
45	7 1/2" HACKBERRY	REMOVE	-5.62
46	10 1/2" TEXAS ASH	REMOVE	-10.5
47	7 1/2" TEXAS ASH	REMOVE	-7.5
48	11 1/2" TEXAS ASH	REMOVE	-11.5
49	13 1/2" TEXAS ASH	REMOVE	-13.5
50	9" ERC	HEALTHY/TO REMAIN	0
51	9" EASTERN RED CEDAR	HEALTHY/TO REMAIN	0
52	4" TEXAS ASH	REMOVE/TOO SMALL TO COUNT	0
53	17" RED OAK	REMOVE	-17
54	5 1/2" RED OAK	REMOVE/TOO SMALL TO COUNT	-5.5
55	6 1/2" RED OAK	REMOVE/EXCESSIVE DECAY	-6.5
56	6 1/2" COTTONWOOD	REMOVE	-4.87
57	8" TEXAS ASH	REMOVE	-8
58	17" RED OAK	REMOVE	-17
TOTAL NEGATIVE EXISTING TREES TO BE REMOVED			-395.36
CREDIT FOR NEW TREES (PLANT LIST/RE:L.1.2) BC=9x3=27" CAL. (STREET FRONTAGE TREES ON GREENCREST BLVD WILL COUNT PER ROBERT LACROIX) CE=12x3=36" CAL. CM=11x3=33" CAL. ERC=41x4=164" CAL.			+260
TOTAL NEGATIVE TREE CREDITS TO BE REPLACED			-135.36

* GRADING AROUND THESE TREES WILL BE MODIFIED TO SAVE THEM

THIS SURVEY HAS BEEN REVISED TO REFLECT THE RESULTS OF A FORMAL TREE INVENTORY COMPLETED BY RON WYATT, CONSULTING ARBORIST - WYATT'S TREE SERVICE, INC. ON DECEMBER 4, 2003.

RECORD DRAWING
THIS DRAWING HAS BEEN REVISED TO REFLECT CONSTRUCTION RECORDS MAINTAINED BY THE GENERAL CONTRACTOR: RIDGEMONT COMMERCIAL CONSTRUCTION
DATE OF REVISION: AUGUST 30, 2004


OWNER:
LESLIE T. HANSEN
DUVALL/HANSEN & ASSOCIATES INC.
310 E. I-30, SUITE B107
GARLAND, TX 75043-8099
877-887-6564 PH.
972-226-6567 FAX

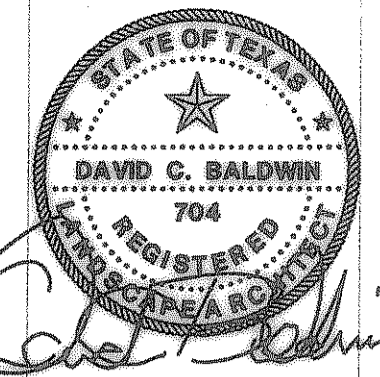

No.	Date	REVISIONS
1	12-19-03	CITY COMMENTS
2		CITY COMMENTS
3		CITY COMMENTS
4		CITY COMMENTS
5		CITY COMMENTS

ROCKWALL SURGERY CENTER
ROCKWALL, TEXAS

DAVID C. BALDWIN
INCORPORATED

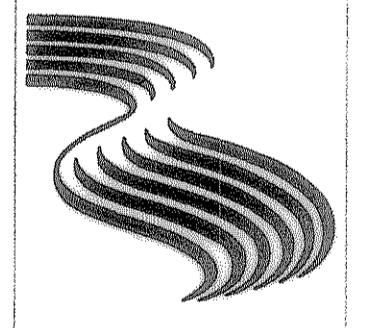

LANDSCAPE ARCHITECTURE PLANNING
730 EAST PARK BOULEVARD
SUITE 100 PLANO, TX 75074
TEL: (972) 509-1286
FAX: (972) 509-1280

Sheet Title:
TREE MITIGATION
Proj. No.:
Date: 30 SEPT 03
Drawn: SC
Checked: DCB
Approved: DCB
sheet number
L1.1
of sheets