


GAINES CHISUM SURVEY, A - 64


LOT 2 - BLOCK A

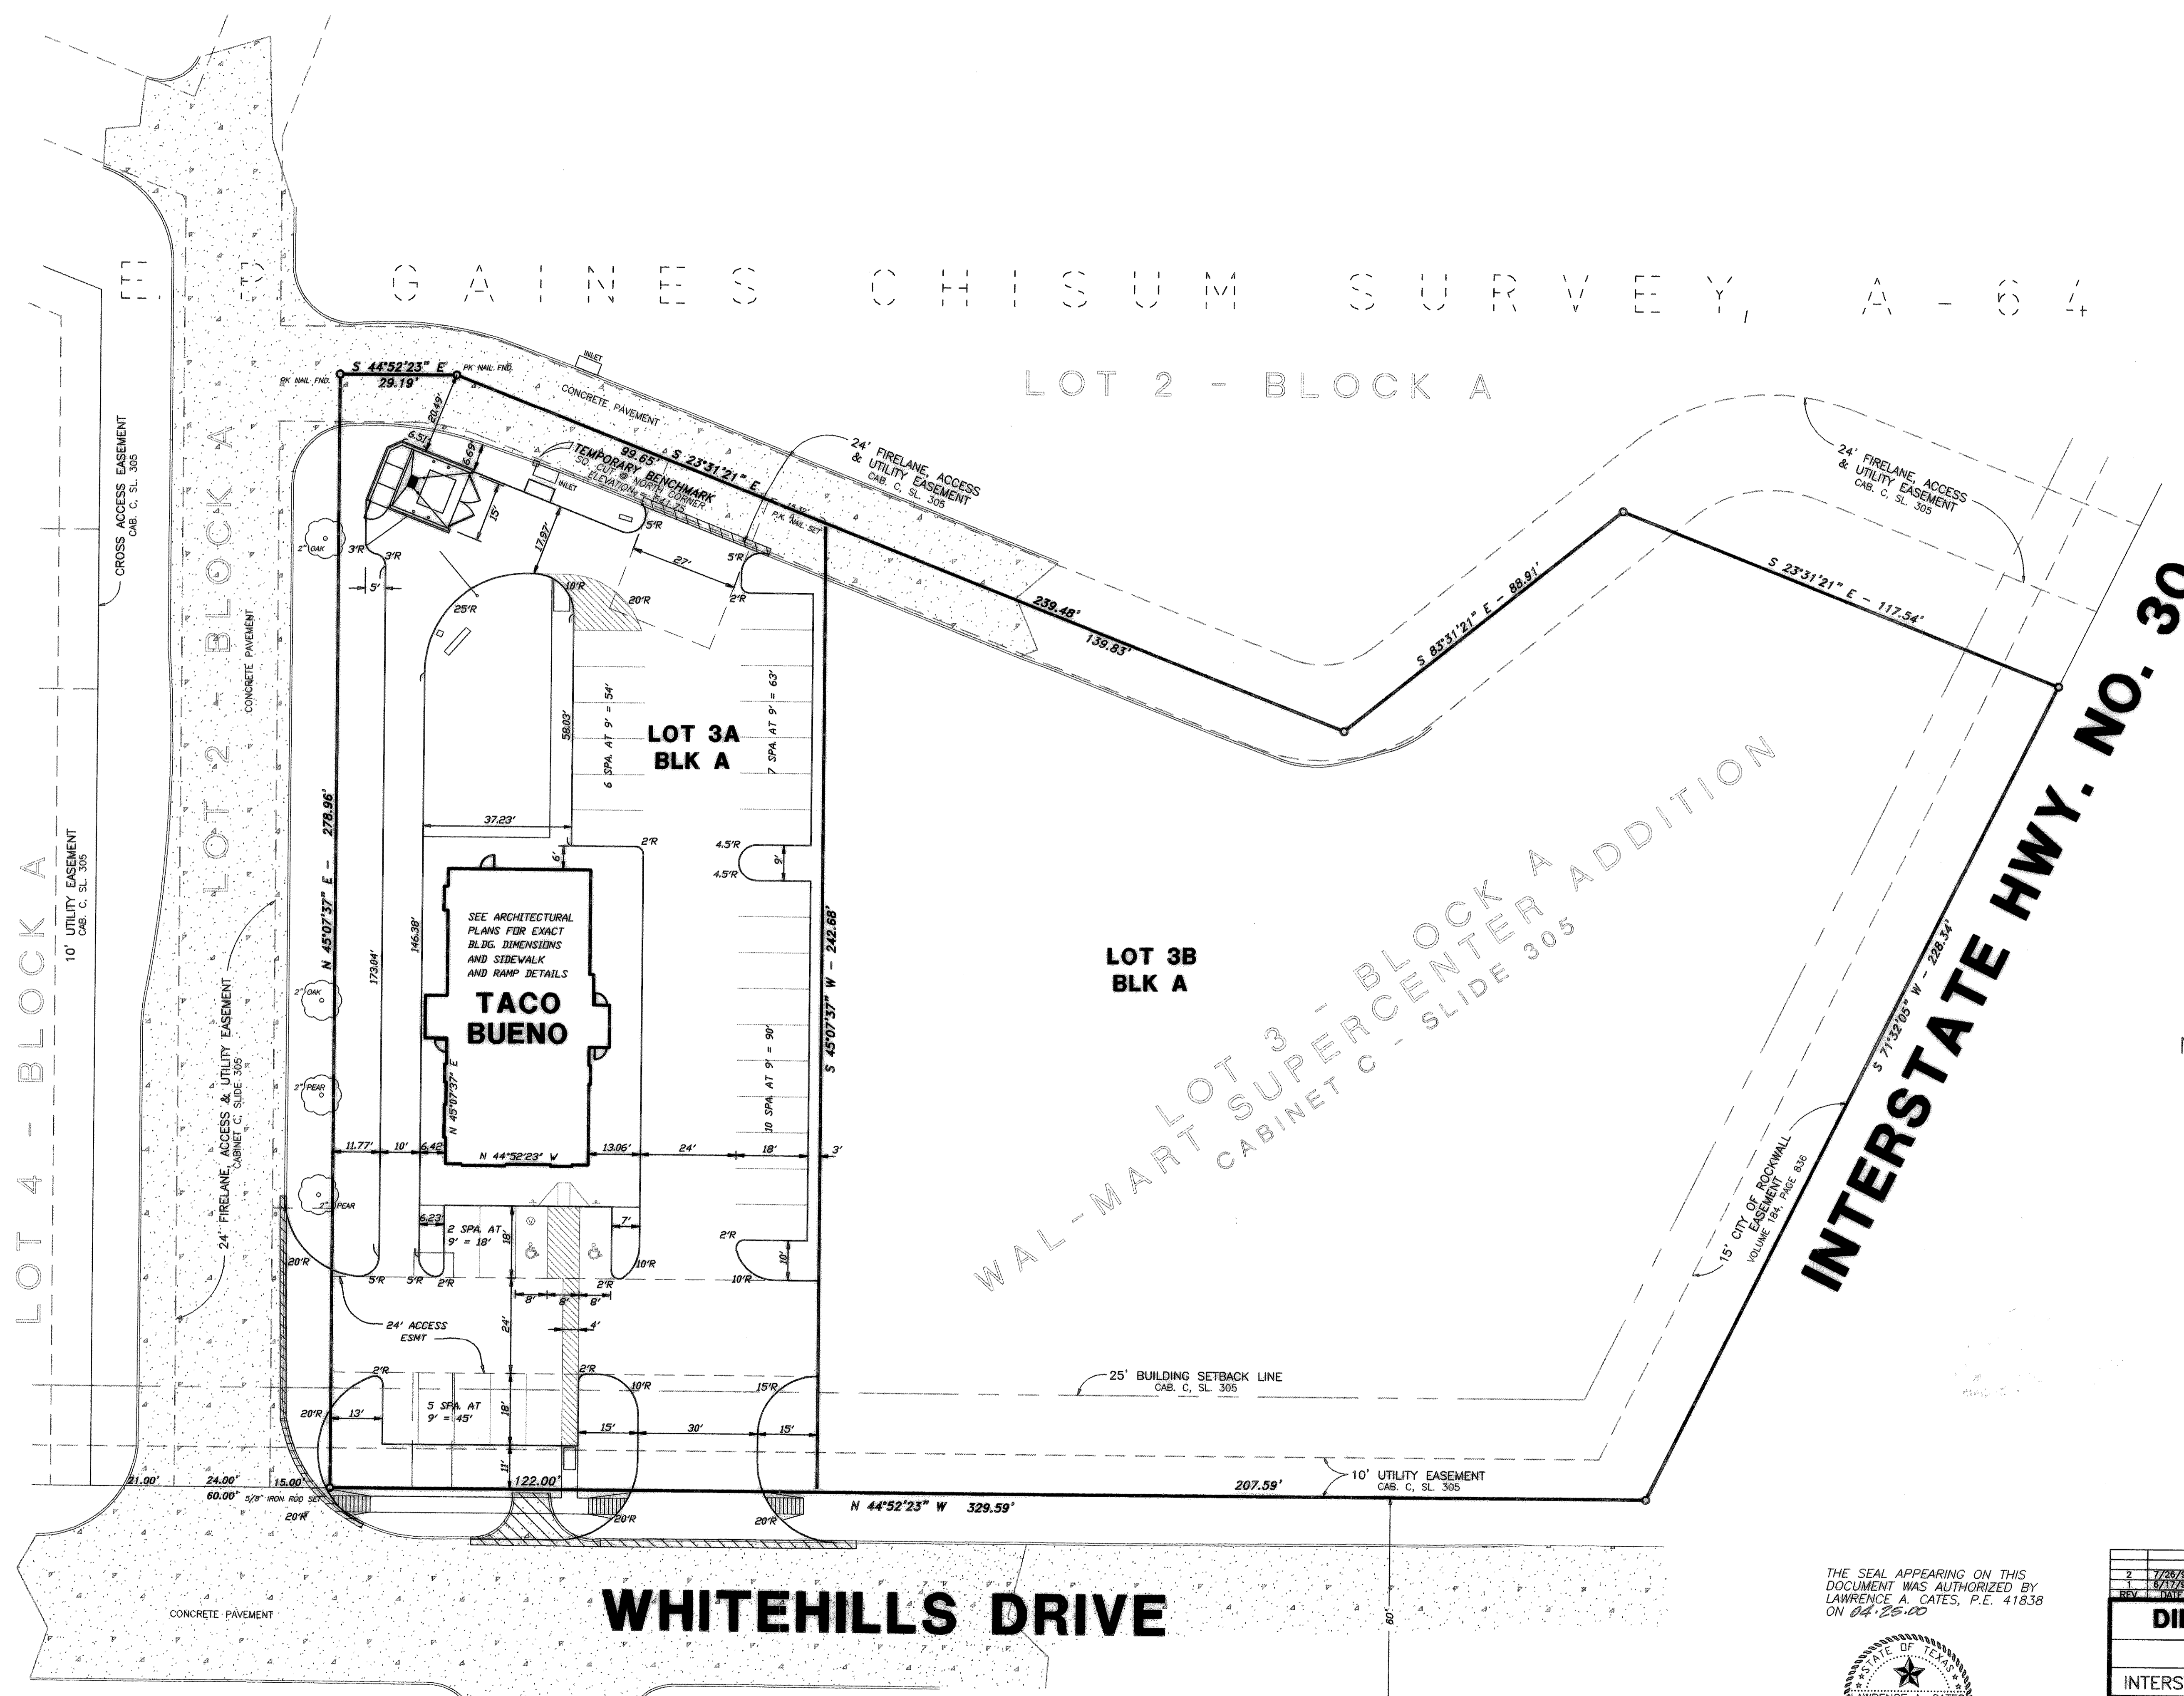


- LEGEND
- F.H. FIRE HYDRANT
 - X SET CHISELED "X" SET
 - F.X. CHISELED "X" FOUND
 - F.I.R. IRON ROD FOUND (SIZE AS NOTED)
 - S.I.R. IRON ROD SET (SIZE AS NOTED)
 - U.P. UNDERGROUND UTILITY POLE W/ GUY
 - L.P. UNDERGROUND ELECTRIC OR TELEPHONE LIGHT POLE
 - S.S.M.H. SANITARY SEWER MANHOLE
 - C.O. SAN. SWR. CLEAN OUT
 - G.V. GAS VALVE
 - W.V. WATER VALVE
 - T. TREE
 - ▨ REMOVE EXIST. PVMT.

NOTE:
ALL DIMENSIONS ARE TO FACE OF CURB UNLESS OTHERWISE NOTED

AS BUILT
DATE 4-25-00

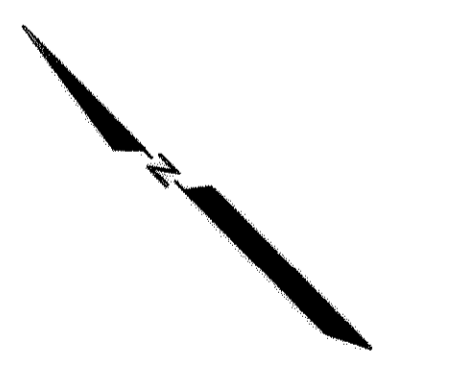

THE SEAL APPEARING ON THIS DOCUMENT WAS AUTHORIZED BY LAWRENCE A. CATES, P.E. 41838 ON 04-25-00

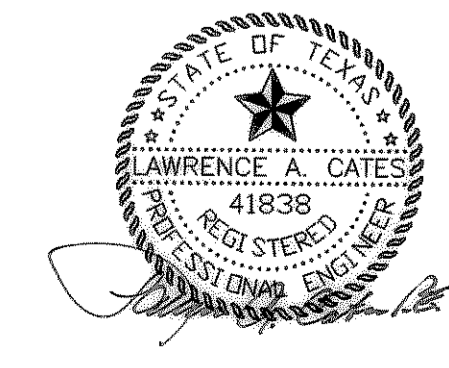

DIMENSION CONTROL PLAN						
TACO BUENO						
INTERSTATE HIGHWAY #30 & WHITEHILLS DRIVE						
ROCKWALL, TEXAS						
LAWRENCE A. CATES & ASSOC., INC.				CONSULTING ENGINEERS		
14200 MIDWAY ROAD, SUITE 122				DALLAS, TEXAS		
DESIGN	DRAWN	DATE	SCALE	NOTES	FILE	NO.
LAC	RPM	4/1/99	1" = 20'	D.P.	98072b DIMCTRL	C-3