

E P GAINES CHISUM SURVEY, A - 6 4

LOT 2 - BLOCK A

INTERSTATE HWY. NO. 30

WHITEHILLS DRIVE

TACO BUENO  
FF=544.00

LOT 3A  
BLK A

LOT 3B  
BLK A


- NOTE:
1. 18" STORM SEWER TO BE CLASS III REINFORCED CONCRETE PIPE
  2. 6" DUMPSTER DRAIN PIPE TO BE PVC SDR 35

NOTE: SEE ARCHITECTURAL PLANS FOR ALL ON SITE SIDEWALK AND RAMP DETAILS.


LEGEND

- EXISTING SPOT ELEVATION
- PROPOSED SPOT ELEVATION
- PROPOSED TOP OF CURB ELEVATION
- PROPOSED GUTTER ELEVATION
- PROPOSED CONTOUR
- EXISTING CONTOUR
- REMOVE EXIST. CONC. PAVEMENT
- LIMITS OF FILL
- F.H. FIRE HYDRANT
- CHISELED "X" SET
- IRON ROD FOUND (SIZE AS NOTED)
- IRON ROD SET (SIZE AS NOTED)
- OVERHEAD UTILITY POLE W/ GUY
- UNDERGROUND ELECTRIC OR TELEPHONE
- LIGHT POLE
- SANITARY SEWER MANHOLE
- SAN. SWR. CLEAN OUT
- G.V. GAS VALVE
- W.V. WATER VALVE
- TREE

AS BUILT  
DATE 4-25-00

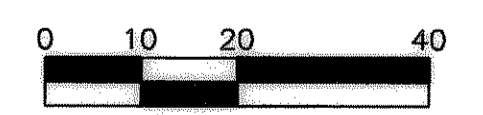

THE SEAL APPEARING ON THIS DOCUMENT WAS AUTHORIZED BY LAWRENCE A. CATES, P.E. 41838 ON 04-25-00

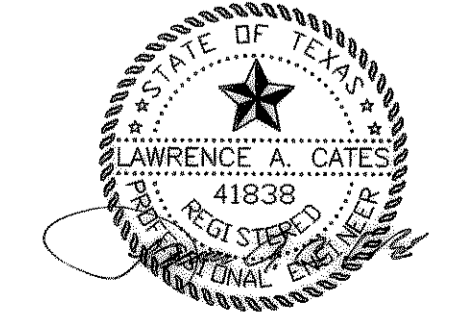

|   |          |                              |
|---|----------|------------------------------|
| 2   | 7/23/99  | REV PER CITY COMMENTS        |
| 1   | 07/17/99 | REVISE PER CITY COMMENTS     |
| REV                                       | DATE     | REMARKS                      |
| <b>GRADING AND DRAINAGE PLAN</b>          |          |                              |
| TACO BUENO                                |          |                              |
| INTERSTATE HIGHWAY #30 & WHITEHILLS DRIVE |          |                              |
| ROCKWALL, TEXAS                           |          |                              |
| LAWRENCE A. CATES & ASSOC., INC.          |          | CONSULTING ENGINEERS         |
| 14200 MIDWAY ROAD, SUITE 122              |          | (972) 385-2272 DALLAS, TEXAS |
| DESIGN                                    | DRAWN    | DATE                         |
| LAC                                       | RM       | 4/1/99                       |
| SCALE                                     | NOTES    | FILE                         |
| 1" = 20'                                  | D.P.     | 98072b GRA/DRA               |
| NO.                                       | C-6      |                              |