

CONSTRUCTION PLANS
FOR
TACO CABANA
STORE #
PROPOSED LOT 14, BLOCK A
WILKINSON COMMONS ADDITION
IN
THE CITY OF ROCWALL
ROCKWALL COUNTY, TEXAS
NOVEMBER, 2007



RECORD DRAWINGS:
TO THE BEST OF OUR KNOWLEDGE BURY+PARTNERS, HEREBY STATES THAT THIS PLAN IS AS-BUILT. THE INFORMATION PROVIDED IS BASED ON SURVEYING CONDUCTED BY BURY+PARTNERS ON 06/09/08 AT THE SITE AND INFORMATION PROVIDED BY THE CONTRACTOR.


Thomas Khamooshi 06-12-08
ENGINEER DATE

OWNER/DEVELOPER: TACO CABANA
8918 TESORO DRIVE STE. 200
LANCASTER, TEXAS 78217
PH: (210)283-5565
CONTACT: MARK CRAMER

CIVIL ENGINEER: BURY + PARTNERS-DFW, INC.
5310 HARVEST HILL ROAD
SUITE 100
DALLAS, TEXAS 75230
PH: (972)991-0011
FAX: (972)991-0278
CONTACT: THOMAS O. KHAMOOSHI, P.E.

SURVEYOR: BURY + PARTNERS-DFW, INC.
5310 HARVEST HILL ROAD
SUITE 100
DALLAS, TEXAS 75230
PH: (972)991-0011
FAX: (972)991-0278
CONTACT: DAVID DE WEIRD, R.P.L.S.


ARCHITECT: MDN ARCHITECTS
9639 MCCULLOUGH AVE.
LANCASTER, TEXAS 78216
PH: (210)340-2400
CONTACT: TIMOTHY McCARTY

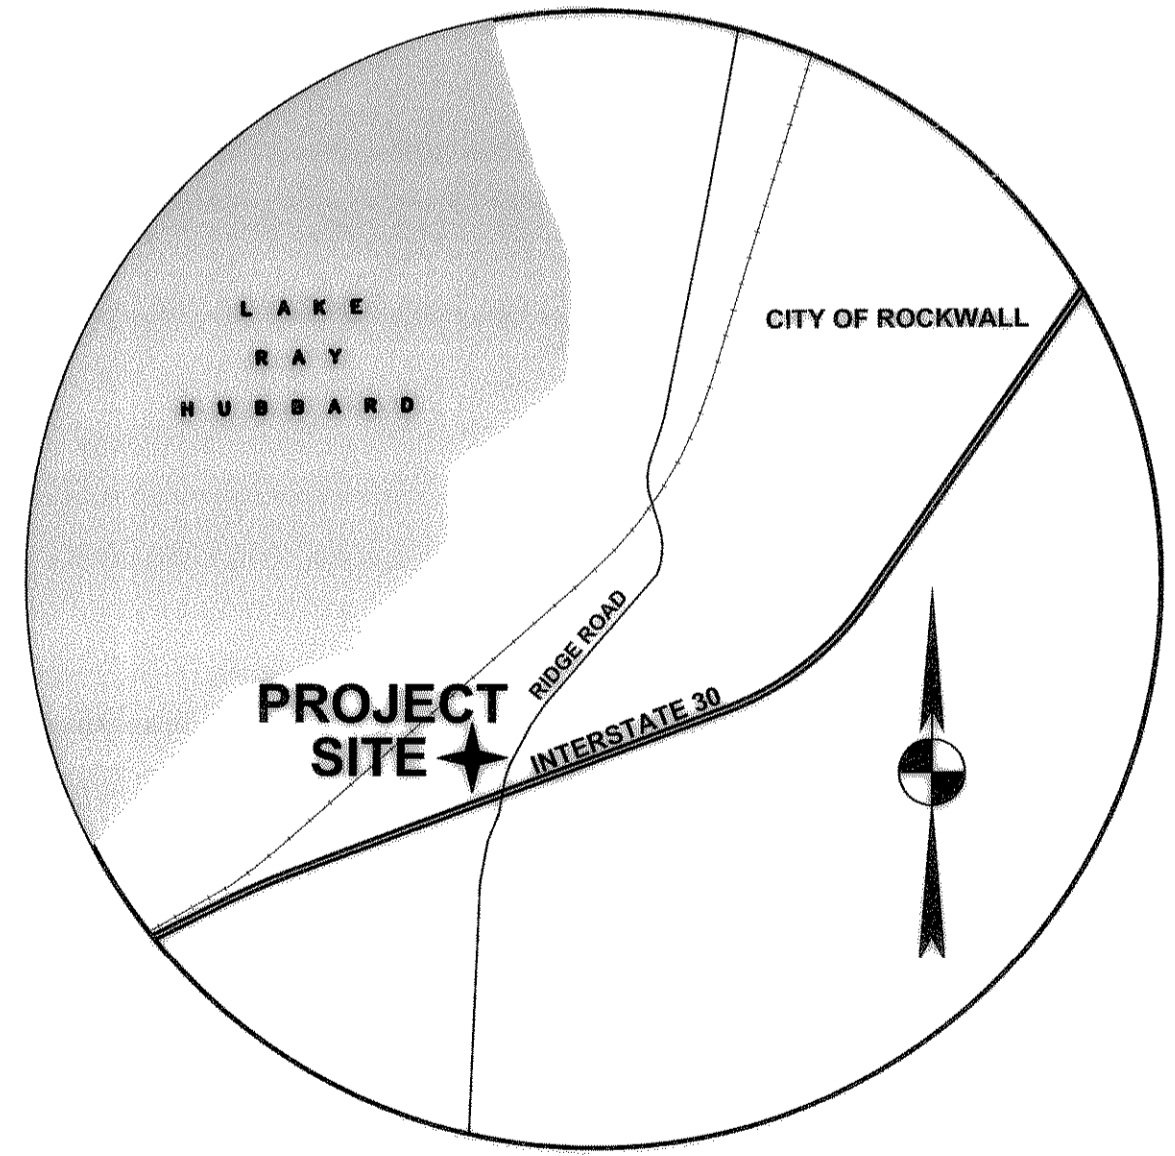

VICINITY MAP
NTS
(MAPSCO GRID 30C-F)

INDEX OF SHEET NO.	DESCRIPTION
	COVER SHEET
C1	GENERAL CONSTRUCTION NOTES, LEGEND & ABBREVIATIONS
1	SURVEY (NOT INCLUDED)
C3	SITE PLAN
C4	PAVING PLAN
C5	GRADING PLAN
C6	DRAINAGE AREA MAP
C7	EROSION & SEDIMENTATION CONTROL PLAN
C8	UTILITY PLAN
C9	SITE DETAILS
C10	SITE DETAILS
C11	EROSIONS & SEDIMENTATION CONTROL DETAILS
1L	LANDSCAPE PLAN (NOT INCLUDED)

Bury+Partners
ENGINEERING SOLUTIONS
5310 Harvest Hill Road, Suite 100
Dallas, Texas 75230
Tel. (972)991-0011 Fax (972)991-0278
Bury+Partners-DFW, Inc. ©Copyright 2007

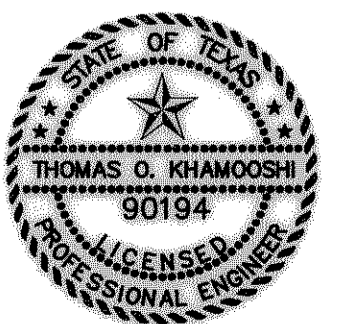

06-12-08
Thomas Khamooshi

ISSUED FOR BID _____ ISSUED FOR CONSTRUCTION _____