



**CAUTION !!**  
 CONTRACTOR IS TO CONTACT TEXAS ONE-CALL SYSTEM (1-800-248-4545) OR OTHER UTILITY LOCATING SERVICES AT LEAST 48 HOURS PRIOR TO CONSTRUCTION ACTIVITIES. BURY & PARTNERS IS NOT RESPONSIBLE FOR KNOWING ALL EXISTING UTILITIES IN THE PROJECT AREA NOR FOR DEPICTING THE EXACT LOCATIONS OF UTILITIES ON THESE DRAWINGS.

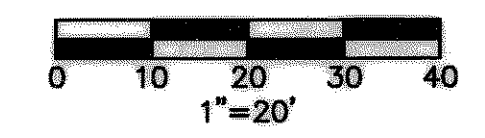

- LEGEND**
- ==== SAWCUT, REMOVE AND DISPOSE OF EXISTING CURB, GUTTER & PAVEMENT
  - CONTROL JOINT
  - EJ EXPANSION JOINT

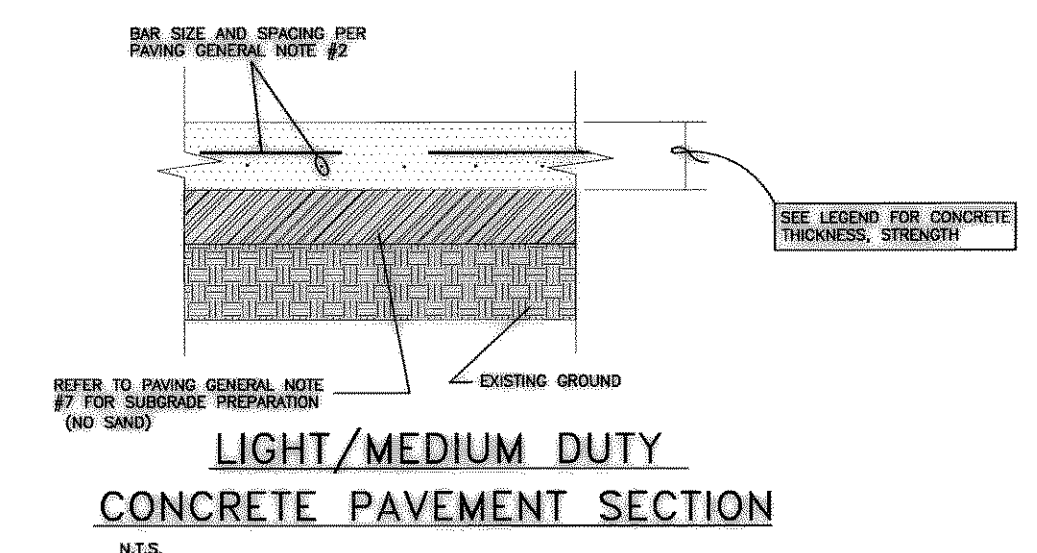

- LEGEND**
- HEAVY DUTY CONCRETE PAVEMENT:**  
 7" 3600 PSI CONCRETE PAVEMENT W/#3 BARS AT 18" O.C.E.W. ON 6" COMPACTED TO 95% OR ABOVE OPTIMUM MOISTURE CONTENT (ASTM D698)
  - LIGHT DUTY CONCRETE PAVEMENT:**  
 5" 3600 PSI CONCRETE PAVEMENT W/#3 BARS AT 18" O.C.E.W. ON 6" COMPACTED TO 95% OR ABOVE OPTIMUM MOISTURE CONTENT (ASTM D698)
  - SIDEWALK & FLATWORK:**  
 4" REINFORCED CONCRETE SIDEWALK FLATWORK (3,000 PSI AT 28 DAYS) W/#3 BARS @ 18" O.C.E.W. REFERENCE STANDARD DETAILS.
  - PROPOSED CONCRETE PAVEMENT (BY DEVELOPER)**
  - CONCRETE PAVEMENT:**  
 6" 3600 PSI CONCRETE PAVEMENT W/#3 BARS AT 18" O.C.E.W. ON 6" COMPACTED TO 95% OR ABOVE OPTIMUM MOISTURE CONTENT (ASTM D698)

**RIDGE ROAD (F.M. 740)**  
 (A VARIABLE WIDTH RIGHT-OF-WAY)

**WEST BOUND FRONTAGE ROAD INTERSTATE HIGHWAY 30**  
 (A VARIABLE WIDTH RIGHT-OF-WAY)

**RECORD DRAWINGS:**  
 TO THE BEST OF OUR KNOWLEDGE BURY+PARTNERS, HEREBY STATES THAT THIS PLAN IS AS-BUILT. THE INFORMATION PROVIDED IS BASED ON SURVEYING CONDUCTED BY BURY+PARTNERS ON 06/09/08 AT THE SITE AND INFORMATION PROVIDED BY THE CONTRACTOR.

Thomas Khamooshi 06-12-08  
 ENGINEER DATE

NO.	REVISION	BY	DATE
1	REPLACED CURB DRAIN WITH 3-3" PIPES	TKK	06/02/08
2	REMOVED ADA ACCESS TO 130 ROW	TKK	03/15/08
3	REVISED PAVEMENT LIMITS & ADDED DETAIL	TKK	03/07/08
4	UPDATED DRAWING TO SHOW BUILT FIRELANE	TKK	02/25/08

**Bury+Partners**  
 ENGINEERING SOLUTIONS  
 5510 Harwood Hill Road, Suite 100  
 Dallas, Texas 75206  
 Tel: (972)981-0011 Fax: (972)981-0278  
 Bury+Partners-BPFL, Inc. ©Copyright 2007

06-12-08  
 THOMAS O. KHAMOOSHI  
 90194  
 LICENSED PROFESSIONAL ENGINEER

THE ORIGINAL  
**TACO CABANA**  
 MEXICAN PATIO CAFE  
 ROCKWALL, TEXAS

**PAVING PLAN**  
**TACO CABANA #**  
 PROPOSED LOT 14, BLOCK A  
 ROCKWALL, TEXAS

Scale: 1"=20' Date: 11-13-07  
 Designed By: BPI  
 Drawn By: MRG/HQG  
 Checked By: SMH/TKK  
 File: F:\50109-133\1091.33PVP  
 Project No.: 50109-133

SHEET  
**C4**