
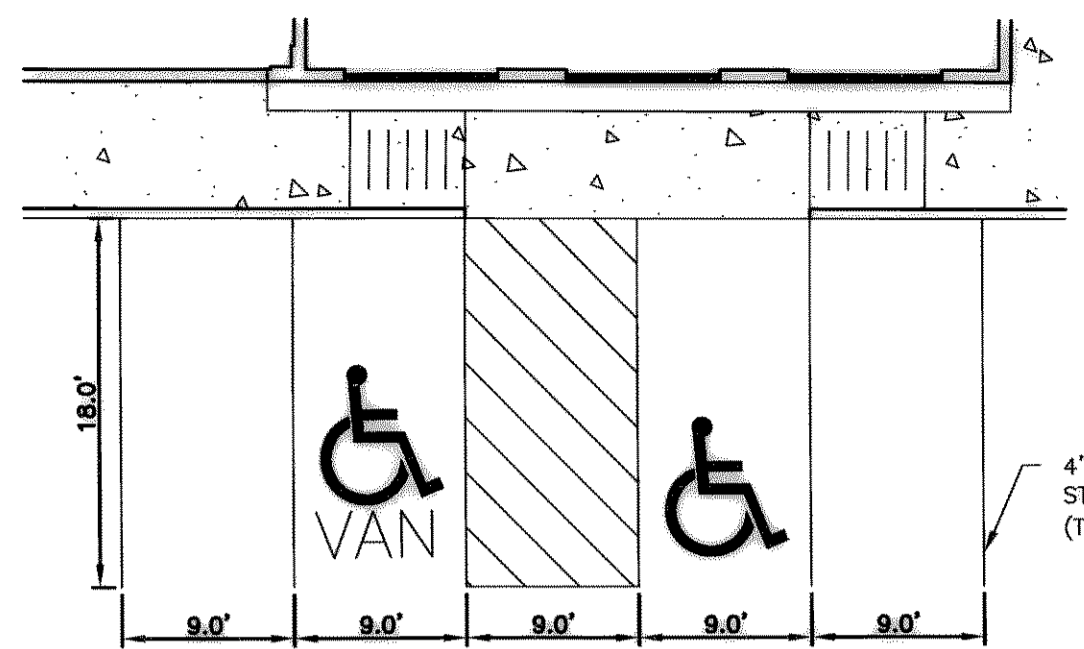


NOTES:
 1. 2% MAXIMUM SLOPE IN ALL DIRECTIONS WITHIN ACCESSIBLE ROUTE.
 2. STRIPING SHALL BE SHERWIN WILLIAMS PRO-MAR TRAFFIC MARKING PAINT - YELLOW.

NOTES:
 1. ALL WALKWAYS, RAMPS, HANDICAP PARKING SIGNAGE, ETC. SHALL MEET APPROVED A.D.A. AND TAS STANDARDS
 2. 2% MAX. SLOPE IN ALL DIRECTION IN AREAS OF HANDICAP PARKING SPACES


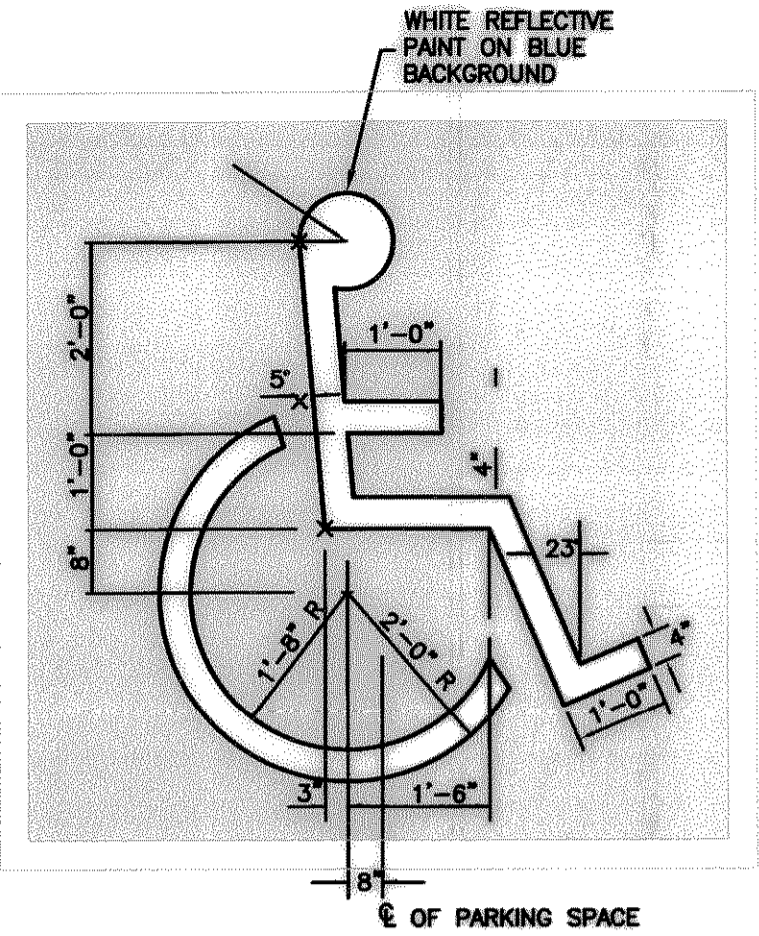


NOTES:
 1. ALL WALKWAYS, RAMPS AND HANDICAP PARKING SIGNAGE, ETC. SHALL MEET APPROVED ADA STANDARDS.
 2. 2% MAXIMUM SLOPE IN ALL DIRECTIONS IN AREAS OF HANDICAP PARKING SPACES.
 3. ALL PAVEMENT MARKINGS SHALL BE SHERWIN WILLIAMS PRO-MAR TRAFFIC MARKING PAINT


C8.1 ACCESSIBLE ROUTE STRIPING
SCALE: N.T.S.

C8.2 HANDICAP STRIPING DETAIL
SCALE: N.T.S.

C8.3 TYPICAL HANDICAP PARKING DETAIL
SCALE: N.T.S.

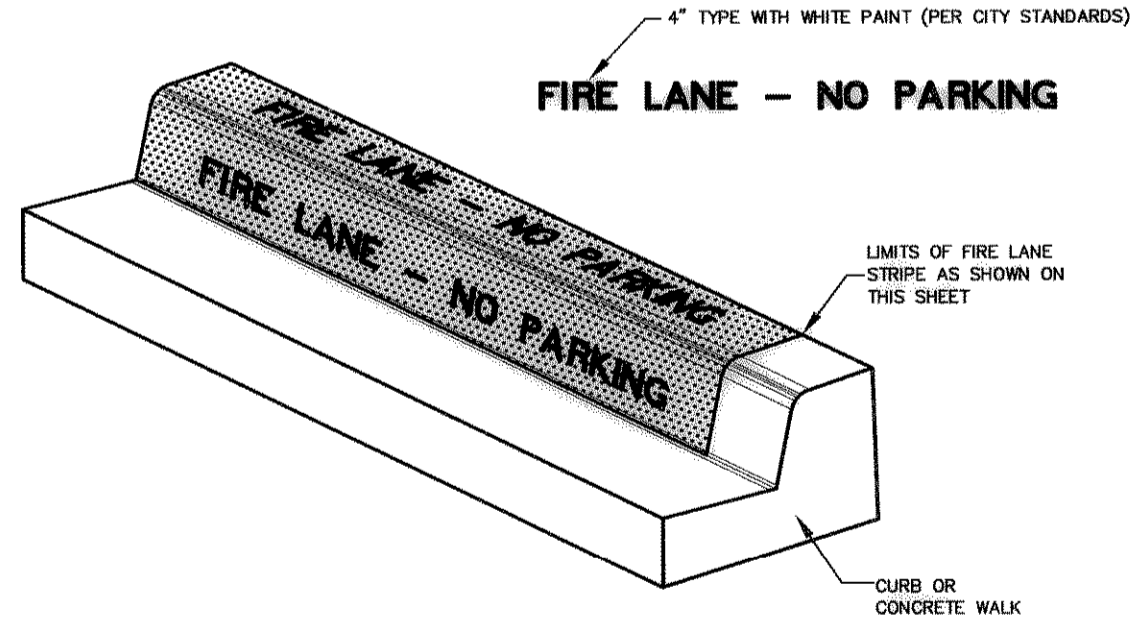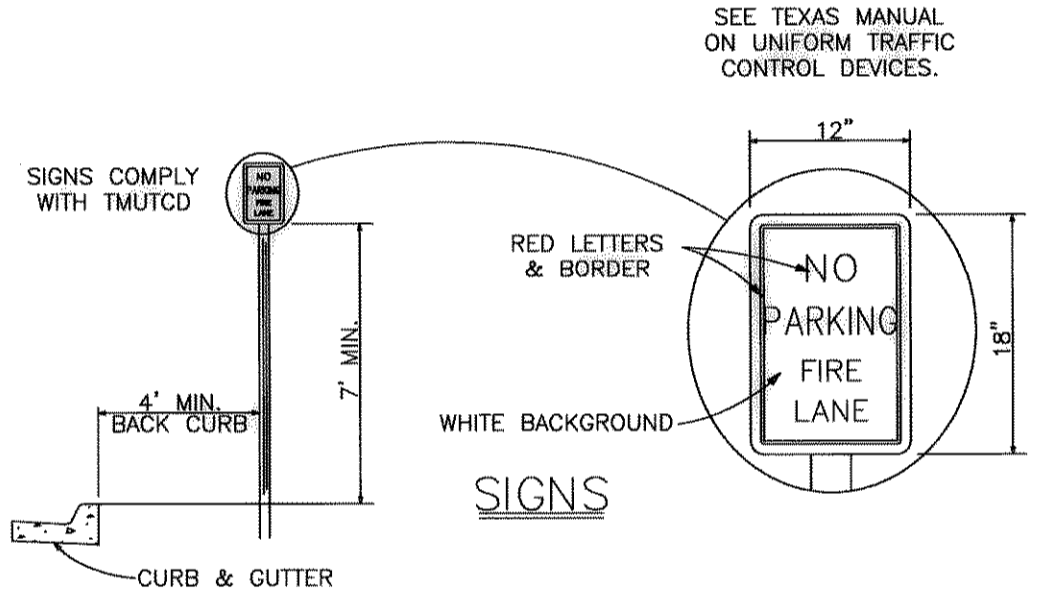



APPLICATION:
 1. ON 6" CURB:
 PAINT 6" RED LANE STRIPE ON BOTH FACE AND TOP OF CURB
 PAINT 4" WHITE LETTERS (PER CITY STANDARDS).
 2. LOW CURB (HEADER CURB):
 PAINT RED LANE STRIPE AND WHITE LETTERS ON TOP OF CURB
 3. 25 FEET INTERVALS ON THE RED BORDER MARKINGS ALONG BOTH SIDE OF THE FIRE LANES (PER CITY STANDARDS).

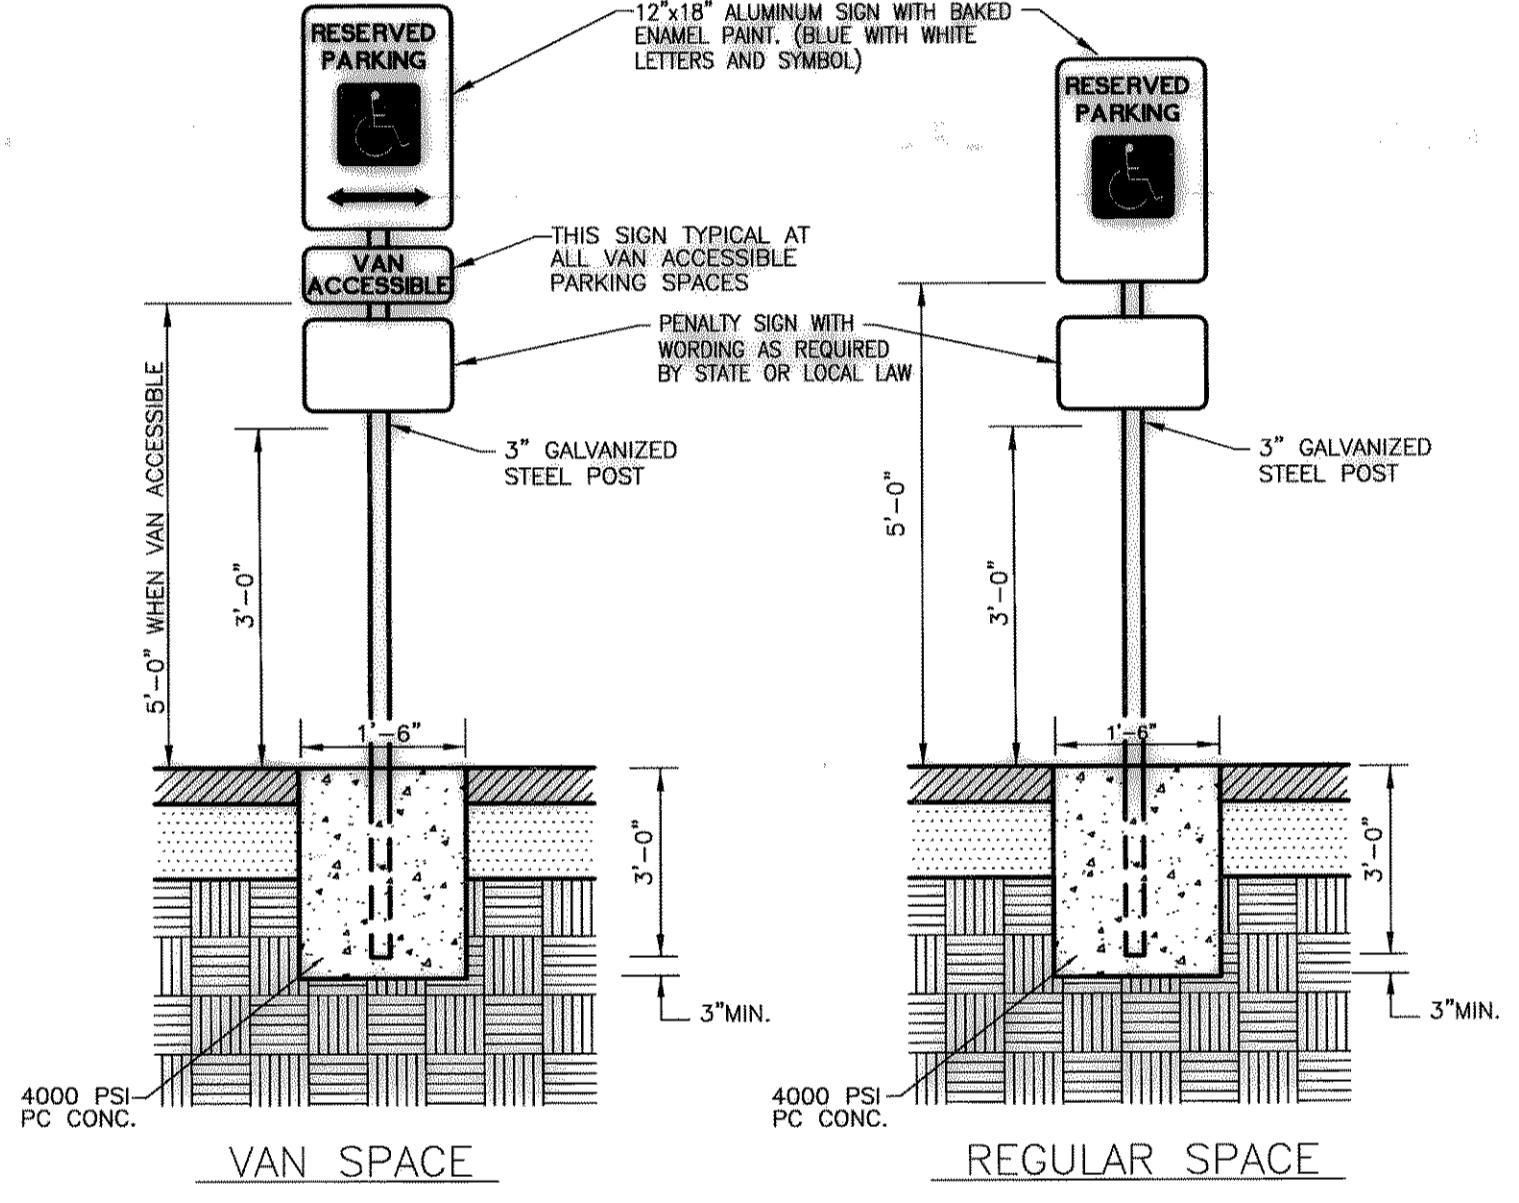

C8.5 HANDICAP SIGN ASSEMBLY
SCALE: N.T.S.

RECORD DRAWINGS:
 TO THE BEST OF OUR KNOWLEDGE BURY+PARTNERS, HEREBY STATES THAT THIS PLAN IS AS-BUILT. THE INFORMATION PROVIDED IS BASE ON SURVEYING CONDUCTED BY BURY+PARTNERS ON 06/09/08 AT THE SITE AND INFORMATION PROVIDED BY THE CONTRACTOR.
 Thomas Khamooshi 06-12-08
 ENGINEER DATE

C8.6 NOT USED
SCALE: N.T.S.

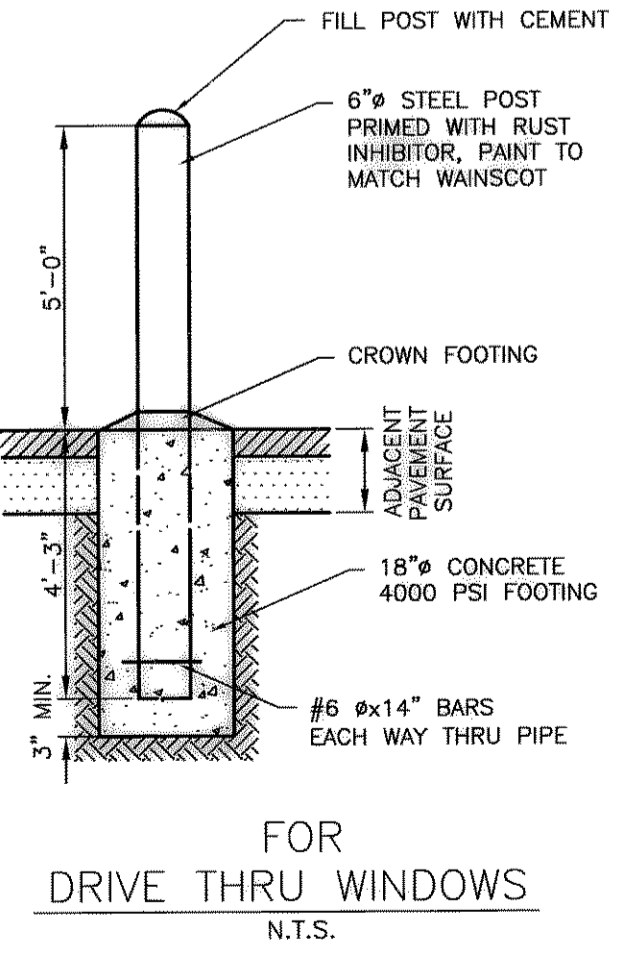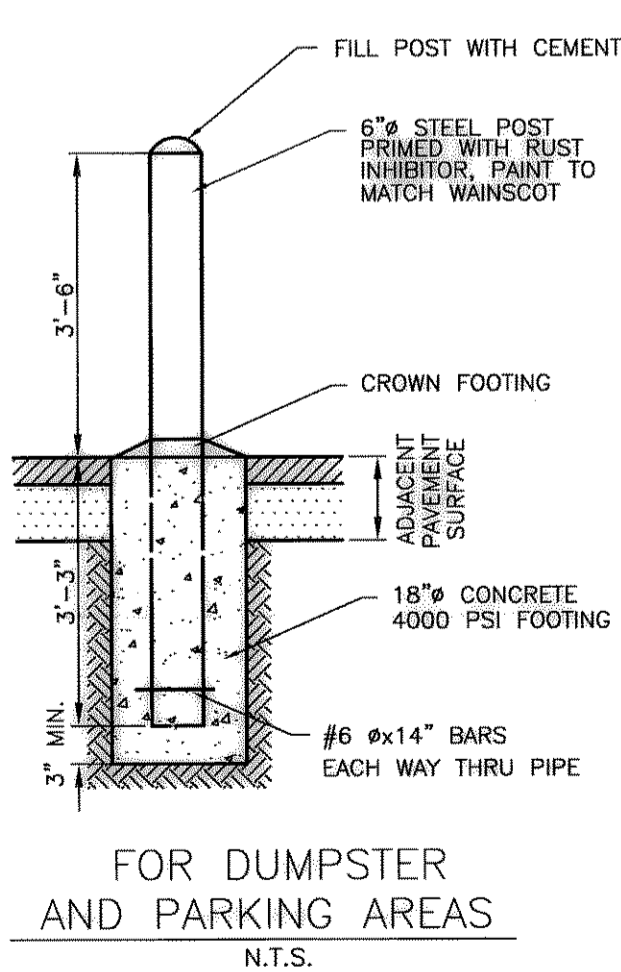


C8.4 STANDARD FIRE LANE SPECIFICATIONS
SCALE: N.T.S.

C8.7 NOT USED
SCALE: N.T.S.

C8.8 BOLLARD DETAIL
SCALE: N.T.S.

REVISION BY DATE
 NO. 1
 Bury+Partners
 ENGINEERING SOLUTIONS
 5310 Harvest Hill Road, Suite 100
 Dallas, Texas 75220
 Tel: (972)941-0011 Fax: (972)941-0276
 Bury+Partners-DFW, Inc. © Copyright 2007
 06-12-08
 STATE OF TEXAS
 THOMAS O. KHAMOOSHI
 LICENSED PROFESSIONAL ENGINEER
 90194
 Thomas Khamooshi

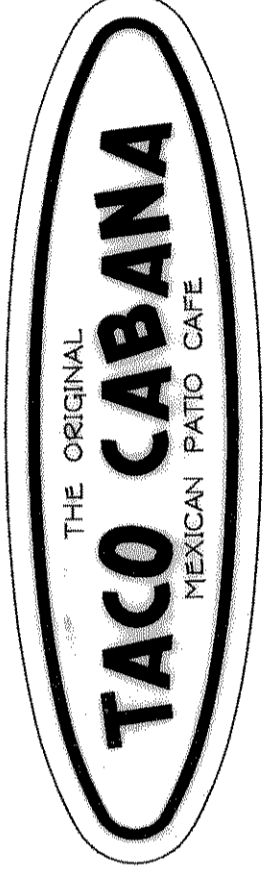

SITE DETAILS
TACO CABANA #
 PROPOSED LOT 14, BLOCK A
 ROCKWALL, TEXAS

Scale: N.T.S. Date: 11-13-07
 Designed By: BPI
 Drawn By: HQG
 Checked By: TOK
 File: F:\50109-133\DTLS-SPN
 Project No.: 50109-133

SHEET
C9