

| LARGE TREES | | | | |
|-------------|--------|---------------------|--|--------------------|
| QUANTITY | SYMBOL | COMMON NAME | SCIENTIFIC NAME | SIZE & CONDITION |
| 5 | | Bald Cypress | <i>Taxodium distichum</i> | 3' caliper, 1" Ht. |
| 10 | | October Glory Maple | <i>Acer rubrum</i> <i>October glory</i> | 4" caliper, 8' Ht. |

| ORNAMENTAL TREES | | | | |
|------------------|--------|----------------------|---|---|
| QUANTITY | SYMBOL | COMMON NAME | SCIENTIFIC NAME | SIZE AND CONDITION |
| 13 | | Forest Pansy Red Bud | <i>Cercis canadensis</i> <i>Forest Pansy</i> | 6 1/4" spread, 1 1/2' caliper, 8 1/2' or container. |
| 14 | | Florida Sabal | <i>Sabal palmetto</i> | 45 gallon, 10' Ht. container. |

| SHRUBS | | | | |
|----------|--------|-----------------------|-------------------------------|---|
| QUANTITY | SYMBOL | COMMON NAME | SCIENTIFIC NAME | SIZE AND CONDITION |
| 44 | | Eleoagnus | <i>Eleoagnus pungens</i> | 3 gallon, 6x30", 3' O.C. spacing |
| 31 | | Variegated Privet | <i>L. sinense Variegata</i> | 3 gallon, 6x30", 3' O.C. spacing |
| 15 | | Red Tip Photinia | <i>Photinia x 'Transect'</i> | 3 gallon, 6x30", 3' O.C. spacing |
| 16 | | Chinese Fringe Flower | <i>Loropetalum chinense</i> | 3 gallon, 14x18", 3' O.C. spacing |
| 15 | | Cherry Sage | <i>Salvia greggii</i> | 5 gallon, 18" Ht./18" spread |
| 10 | | Rosemary Upright | <i>Rosmarinus officinalis</i> | 5 gallon, 12" Ht./12" spread |
| 5 | | Red Yucca | <i>Hesperaloe parviflora</i> | 5 gallon, 12" Ht./12" spread |
| 8 | | Sage Palm | <i>Cycas revoluta</i> | 7 gallon, 24" Ht./24" spread, container |

| GROUNDCOVERS / PERENNIALS | | | | | |
|---------------------------|--------|-------------------|-------------------|----------------------------|----------------------|
| QUANTITY | SYMBOL | CALLOUT | COMMON NAME | SCIENTIFIC NAME | SIZE AND CONDITION |
| 4 | | BLACKFOOT DAISSY | Blackfoot Daisy | <i>Helianthus annuus</i> | 1 gallon at 18" o.c. |
| 7 | | DAYLILY #1 | Daylily #1 | <i>Hemerocallis Hybrid</i> | 1 gallon at 18" o.c. |
| 13 | | PURPLE CONEFLOWER | Purple Coneflower | <i>Echinacea purpurea</i> | 1 gallon at 18" o.c. |

| TURF GRASS | | | | |
|------------|----------|----------------|-------------------------|--------------------|
| QUANTITY | CALLOUT | COMMON NAME | SCIENTIFIC NAME | SIZE AND CONDITION |
| 22803 | S.F. SOD | Common Bermuda | <i>Cynodon dactylon</i> | solid sod |



| MISCELLANEOUS | | | |
|---------------|-----------|--|--|
| QUANTITY | CALLOUT | DESCRIPTION | |
| 118 | L.F. EDGE | L.F. Steel edge 1/8" x 4" with 12" stakes green in color | |
| 300 | | SF 2" bed preparation as per specifications | |
| 1900 | | SF 3" hardwood mulch as per specifications | |

NOTES

- Quantities shown are for contractor's convenience only. Contractor is responsible for verification of all quantities.
- Contractor to provide separate line item for a one(1) year maintenance package - see maintenance specifications.

- GENERAL LANDSCAPE CONSTRUCTION NOTES**
- Contractor shall provide all labor and materials necessary to complete the work shown on the plans.
 - All proposed landscaping is to be installed as per local city ordinances and codes. Notify owner's representative and landscape architect of any discrepancies prior to construction.
 - All plant material shall comply with plant size per container as stated by the American Association of Nurserymen.
 - Plans are subject to inspection and approval by the landscape architect prior to installation. The plants may be inspected and found to be in poor condition before the plants are installed.
 - Planting mix to be 50% complete mix by Living Earth Technology #12-8664-4332 (Dallas) or approved equal.
 - Groundcover bed preparation shall be 2 inches of planting mix tilled & inches into bed areas.
 - Shrubs and trees shall be pocket planted. Excavate planting hole 1-1/2 times the width and height of the root ball. Backfill with 1/3 planting mix, 1/3 native soil and 1/3 sand/loam from buildings and other structures. Fine grade for positive drainage to prevent ponding.
 - Quantities provided in the plant list are for general use only. Contractor is responsible for verification of all plant quantities and scheduling of work.
 - Contractor is responsible for removal of trash and job safety conditions. to provide (1) year warranty on all plant material.
 - No trees should be planted within 5 feet of the utilities.

| NO. | REVISION | DATE |
|-----|----------------|----------|
| 1 | RESUBMITTAL #1 | 9/02/07 |
| 2 | RESUBMITTAL #2 | 11/08/07 |
| 3 | RESUBMITTAL #3 | 11/13/07 |
| 4 | RESUBMITTAL #4 | 11/29/07 |

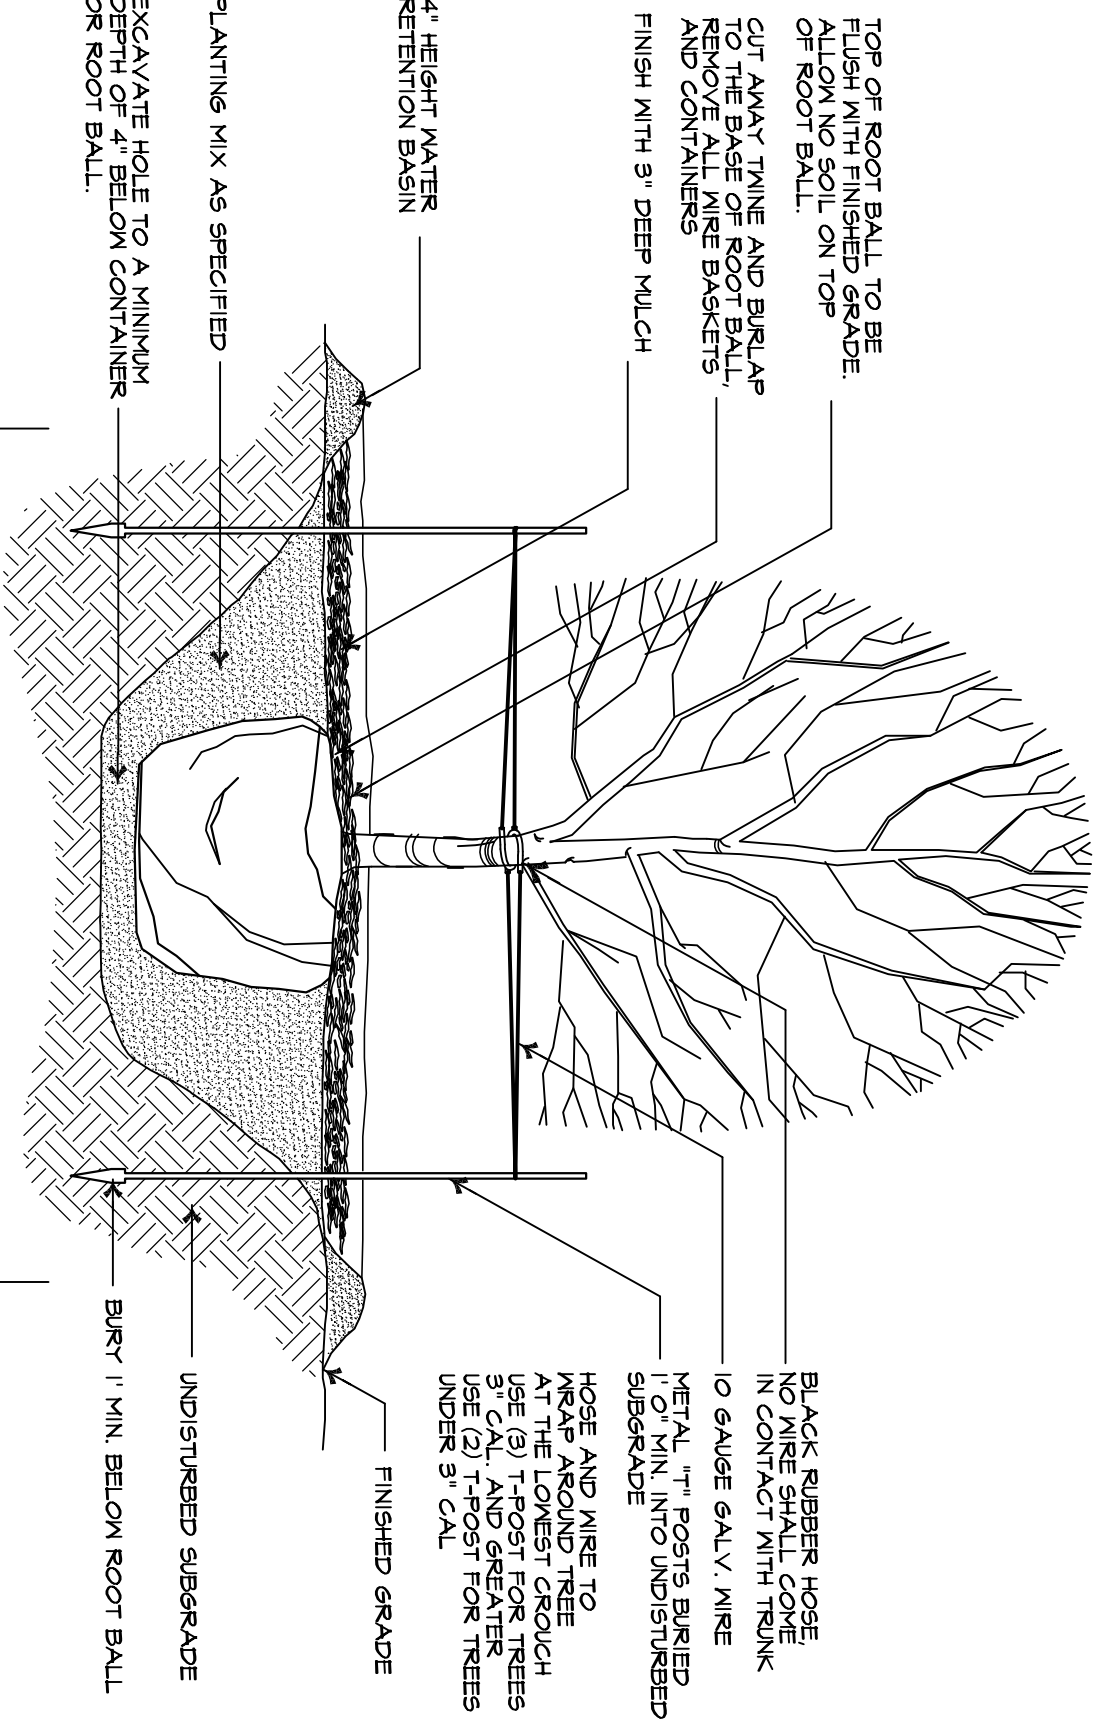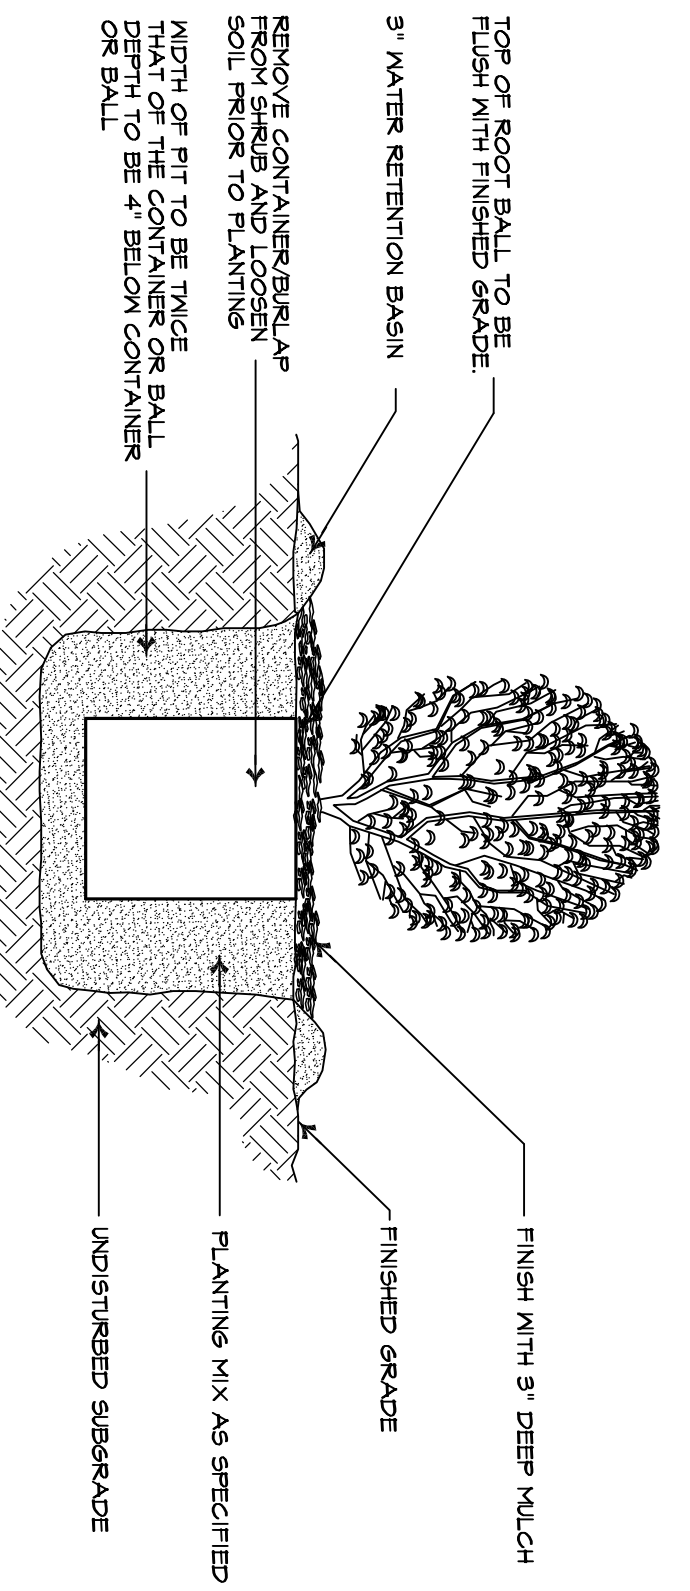


LANDSCAPE ARCHITECTS
DESIGN PARTNERS
PLANNERS

271 West Loop West, Suite 300
Austin, Texas 78701
Phone: 512.227.5900
Fax: 512.228.1233

LANDSCAPE PLAN - ASBUILT

TACO CABANA #
PROPOSED LOT 14, BLOCK A
ROCKWALL, TEXAS

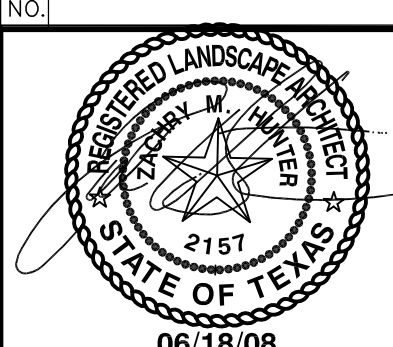

Bury+Partners
ENGINEERING SOLUTIONS
5310 Harvest Hill Road, Suite 100
Dallas, Texas 75230
Tel. (972)991-0011 Fax (972)991-0278
Bury+Partners-DWF, Inc. © Copyright 2007

Scale: 1"=20' Date: 05-02-07
Designed By: LDP
Drawn By: LDP
Checked By: LDP
File: L/003/94/softscape/01L
Project No.: 40003-94