OF

CONSTRUCTION PLANS FOR

TERRACINA ESTATES PHASE 2

CONTACT INFORMATION:

Rockwall Engineer and Public Works:

Mary Smith (972) 771-7700

Amy Williams, P.E. (972) 771-7746

Matthew Teems (469) 626-4750

CITY OF ROCKWALL, ROCKWALL COUNTY, TEXAS

> 94 RESIDENTIAL LOTS 31.331 ACRES



VICINITY MAP N.T.S.

- trucks, shall be restricted to specific crossing points across NTMWD easements, as approved by the NTMWD. The crossings shall be designated and verified to provide a minimum of five-
- C. To assure that placing of significant loads over the NTMWD pipeline does not damage the existing pipeline, no materials shall be stockpiled on the NTMWD easement without authorization from the NTMWD. If the contractor desires to use NTMWD's easement for stockpile of materials, contact NTMWD Engineering at (972) 442-5405 so your plans for use of NTMWD's easement can be reviewed.
- D. A minimum of 3 feet separation between bottom of pavement and top of NTMWD pipeline is required. In addition, if separation between bottom of pavement and top of pipeline is less than 3.5 feet, than a thickened pavement section is required.
- E. Crossing of the NTMWD easement with other utilities, such as TV cable, phone, gas and electric, shall be coordinated with the NTMWD to avoid damage to the NTMWD facilities.
- F. Outdoor lighting, landscaping, screening walls or other facilities shall not be installed in NTMWD easements without written approval of the NTMWD.
- G.Unless otherwise shown or required, a minimum of two-foot clearance shall be provided for all utilities crossing the NTMWD
- H. "The contractor shall contact NTMWD Engineering at (972) 442-5405 at least 48 hours prior to performing any work in the vicinity of the NTMWD facilities."
- *ALL RESPONSIBILITY FOR ADEQUACY OF DESIGN REMAINS WITH THE DESIGN ENGINEER. THE CITY OF ROCKWALL, IN REVIEWING AND RELEASING PLANS FOR CONSTRUCTION, ASSUMES NO RESPONSIBILITY FOR ADEQUACY OR ACCURACY OF DESIGN.





CAUTION! EXISTING UTILITIES

THE UTILITIES SHOWN ON THESE PLANS WERE COMPILED FROM VARIOUS SOURCES AND ARE INTENDED TO SHOW THE GENERAL EXISTENCE AND LOCATION OF UTILITIES IN THE AREA OF CONSTRUCTION. THE ENGINEER ASSUMES NO RESPONSIBILITY FOR THE ACCURACY OF THE UTILITY INFORMATION SHOWN ON THESE PLANS. THE CONTRACTOR SHALL VERIFY THE EXACT LOCATION OF ALL UTILITIES PRIOR TO CONSTRUCTION. THE CONTRACTOR SHALL CONTACT UTILITY COMPANIES 48 HOURS IN ADVANCE OF ANY CONSTRUCTION ACTIVITIES IN ORDER TO DETERMINE IF THERE ARE ANY CONFLICTS WITH THE PROPOSED FACILITIES. THE CONTRACTOR SHALL NOTIFY THE ENGINEER IMMEDIATELY WHEN CONFLICTS WITH EXISTING UTILITIES ARE DISCOVERED.

CP 101 - Square cut on headwall west side of Rochelle road & 54' south of center of Polar Point Drive Elevation = 559.95 CP 103 - "X" in concrete east side of Rochelle Road, 1834' south of center of Polar Point Dr. Elevation = 564.54' CP 104 - Capped 5/8" Iron rod east side of Rochelle Road & 1250' south of the center of Polar Point Dr. Elevation = 572.70'

CP 105 - Capped 5/8" Iron rod east side of Rochelle Road & 826' south

of the center of Polar Point Dr. Elevation = 568.75'

DEVELOPER

BLOOMFIELD HOMES 1900 W. KIRKLAND BLVD. SUITE 2300B SOUTHLAKE, TX 76092

CONTACT: CLINT VINCENT PHONE: 817-416-1572 FAX: 817-416-1397

PETITT - ECD

ENGINEERING SURVEYING CONSTRUCTION ADMINISTRATION TBPELS REGISTRATION ENGINEERING FIRM #001145 - SURVEYING FIRM #10194792 201 WINDCO CIRCLE 1600 N. COLLINS BLVD **SUITE 3300** WYLIE, TX 75098

8/08/2024 DWG FILE NAME: 06537-C-COVER-2.DWG

L1-L6

TREE MITIGATION PLAN

THIS DOCUMENT IS RELEASED FOR

THE PURPOSE OF CONSTRUCTION.

DOCUMENT WAS AUTHORIZED BY

CHARLES A. LAMPING, P.E. 88554

THE SEAL APPEARING ON THIS

Sheet List Table

GUADALUPE DR PAVING PLAN 8+00 TO 17+00

MESA VERDE DR PAVING PLAN 0+00 TO 7+00

WRENWOOD CT. AND ACACIA DR. PAVING PLAN

TEMPORARY DETENTION POND IMPROVEMENTS

SANITARY SEWER PROFILE SS-1 & SS-2

SANITARY SEWER PROFILE SS-3 & SS-4

LIGHTING AND SIGNAGE PLAN

EROSION CONTROL DETAILS 1

EROSION CONTROL DETAILS 2

EROSION CONTROL PLAN

SHEET NUMBER SHEET TITLE

COVER SHEET

PLAT

PLAT (2)

PLAT (3)

PLAT NOTES

GENERAL NOTES

GRADING PLAN 1

GRADING PLAN 2

LONGBOW DR. PAVING PLAN

PENTRIDGE DR. PAVING PLAN

SEDONA DR. PAVING PLAN

OAKCREST DR. PAVING PLAN

EXISTING DRAINAGE AREA MAP

PROPOSED DRAINAGE AREA MAP

ULTIMATE DRAINAGE AREA MAP

HYDRAULIC CALCULATIONS

STORM LINE D-3 D-4 & D-5

STORM PLAN OVERALL

STORM LINES D & A

STORM LINE G

DETENTION POND

UTILITY SHEET 1

UTILITY SHEET 2

PAVING DETAILS

PAVING DETAILS 2

WATER DETAILS 1

WATER DETAILS 2

SANITARY DETAILS

STORM DETAILS 1

STORM DETAILS 2

LANDSCAPE PLANS



SANITARY SEWER PROFILE SS-5 & SS-6 & WATER LINE PROFILE WL-2


RECORD DRAWINGS

To the best of our knowledge Petitt-ECD, L.P., hereby states that this plan is As-Built. This information provided is based on surveying at the site and information

provided by the contractor.

CHARLES A. LAMPING, P.E. 10-15-2025 CHARLES A. LAMPING, P.E. DATE RELEASED FOR CONSTRUCTION
ALL RESPONSIBILITY FOR ADEQUACY OF DESIGN

REMAINS WITH THE DESIGN ENGINEER. THE CITY OF ROCKWALL, IN REVIEWING AND RELEASING PLANS FOR CONSTRUCTION, ASSUMES NO RESPONSIBILITY FOR ADEQUACY OR ACCURACY OF SHEET

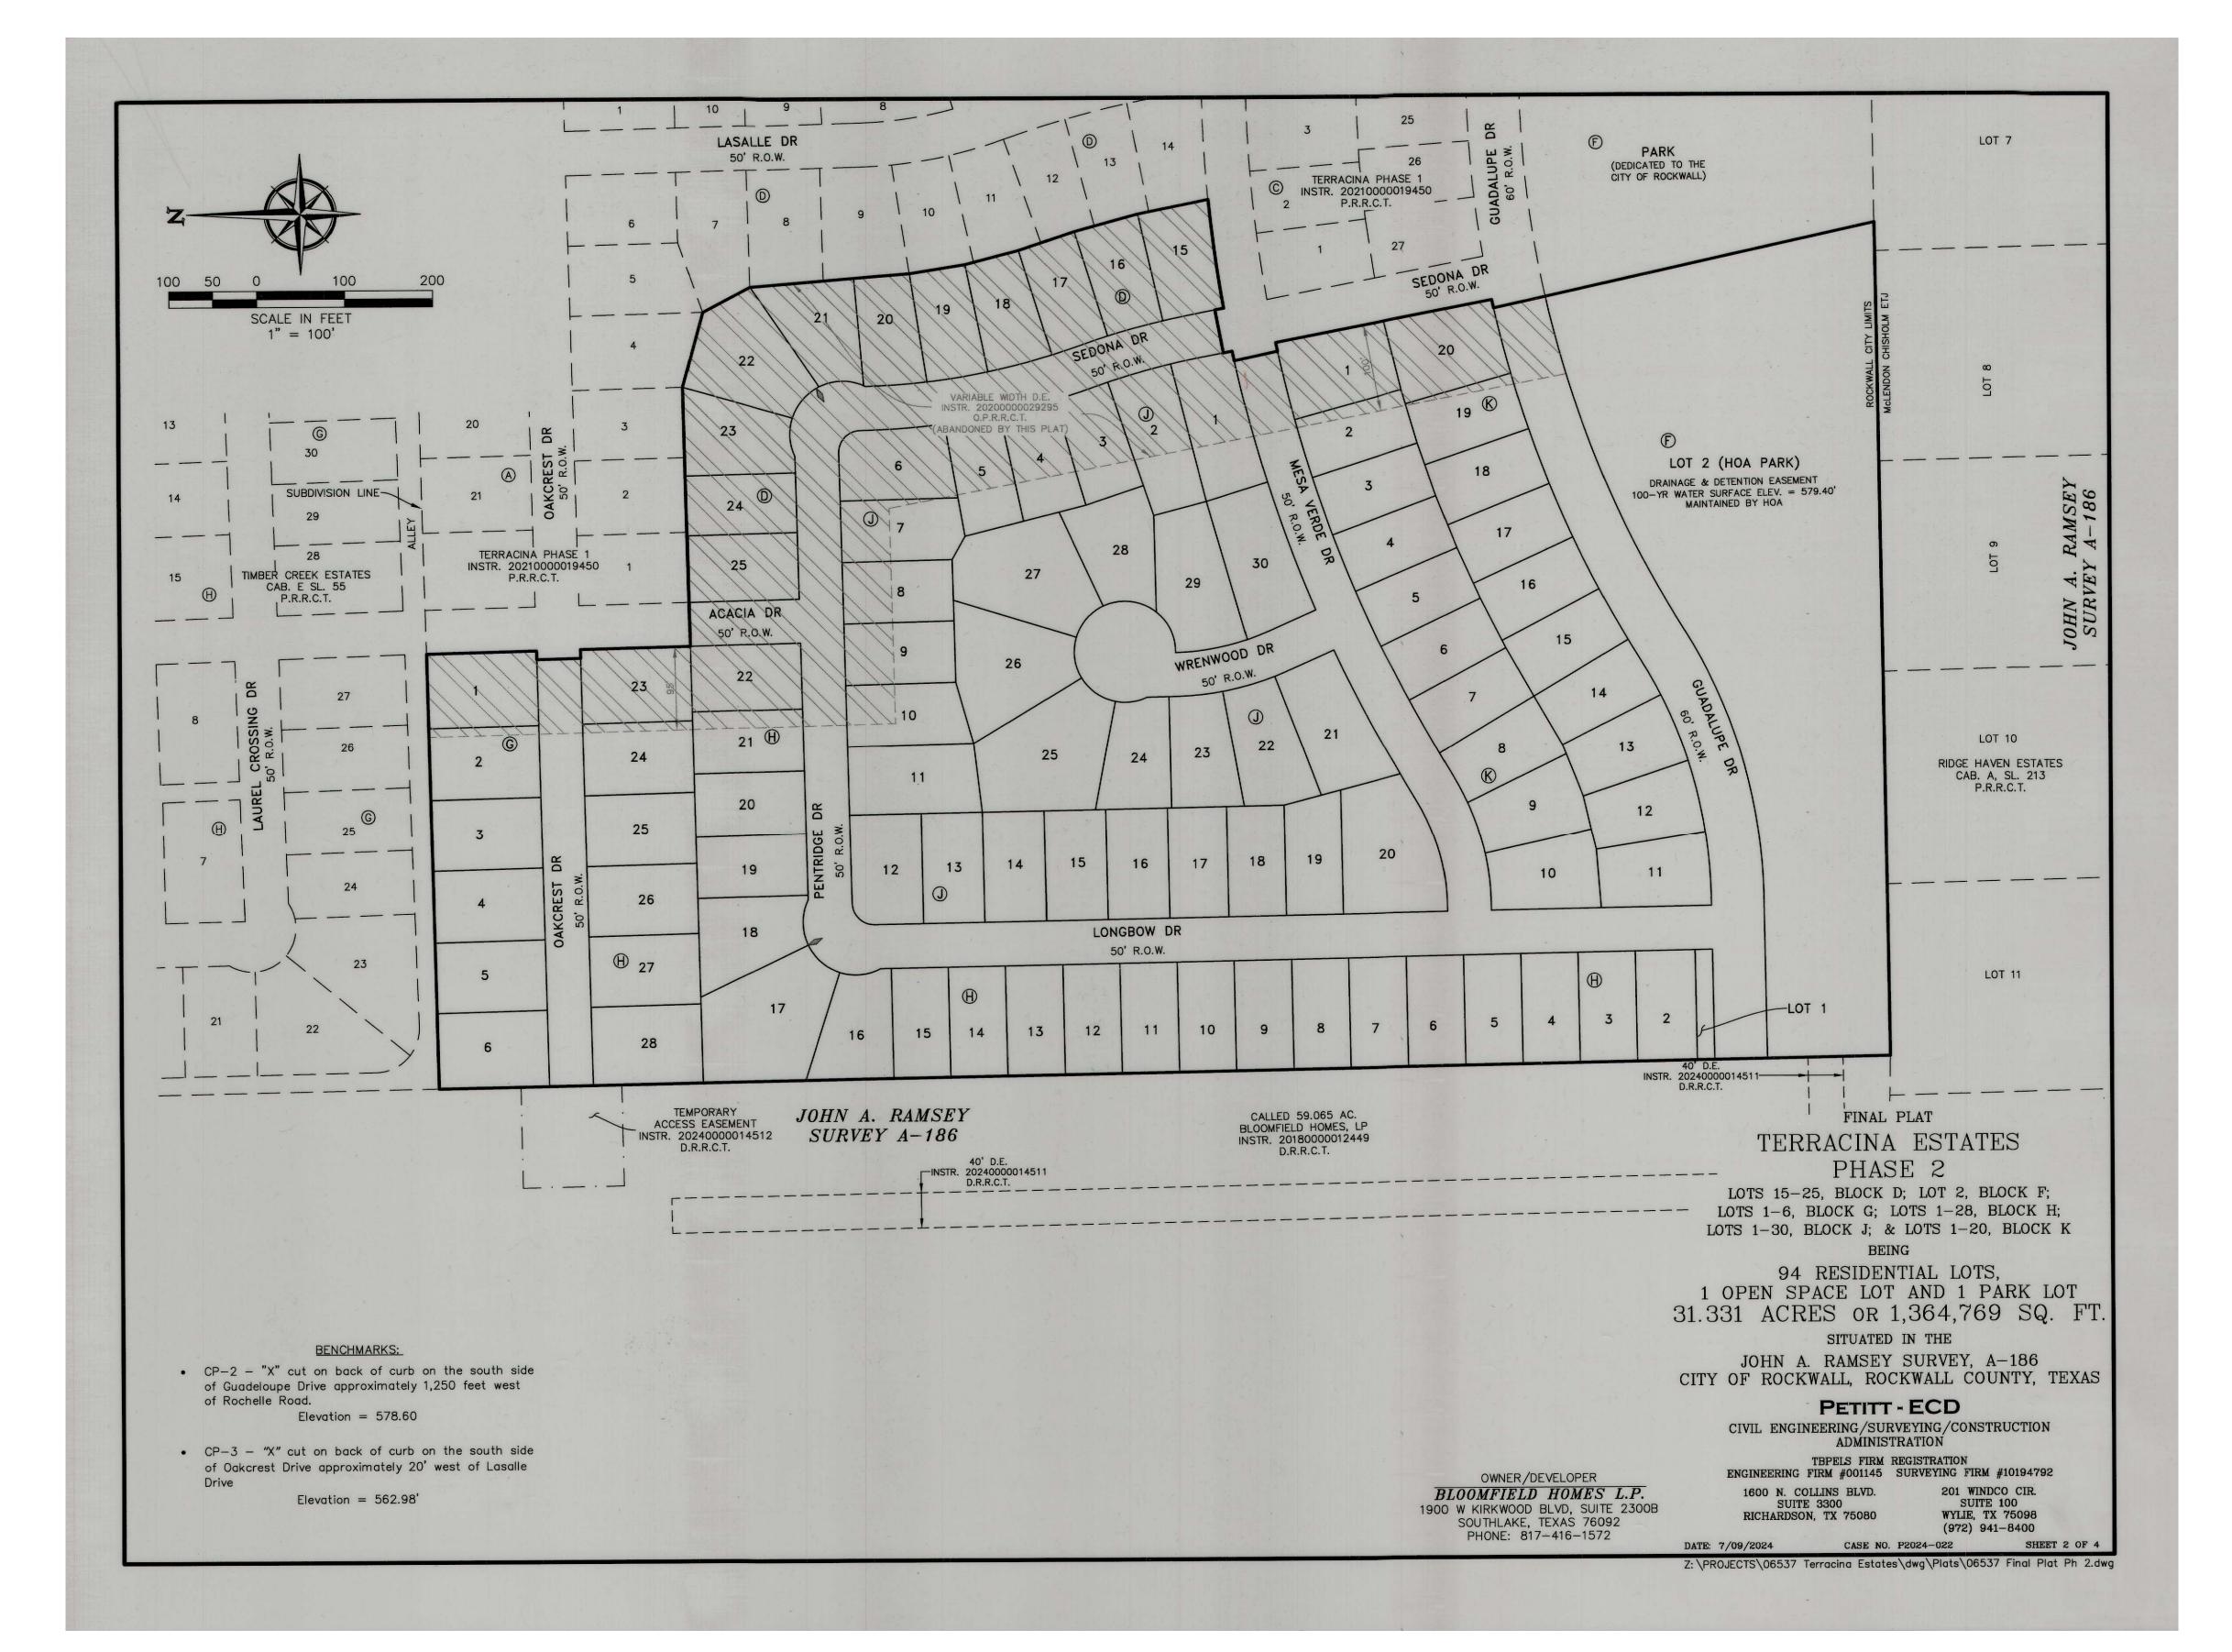

		T		E TABLE			
BLOCK	LOT NO.	AREA	ACREAGE	BLOCK	LOT NO.	AREA	ACREAGE
D			0.216	J	3	8,304	0.191
D	16	8,696	0.200	J	4	8,499	0.195
D	17	8,376	0.192	J	5	8,451	0.194
D	18	8,651	0.199	J	6	10,221	0.235
D	19	8,458	0.194	J	7	9,486	0.218
D	20	8,400	0.193	J	8	8,750	0.201
D	21	10,017	0.230	J	9	8,750	0.201
D	22	13,381	0.307	J	10	9,388	0.216
D	23	10,032	0.230	J	11	11,211	0.257
D	24	8,500	0.195	J	12	9,924	0.228
D	25	9,500	0.218	J	13	8,750	0.201
F	2	210,828	4.840	J	14	8,750	0.201
G	1	10,625	0.244	J	15	8,750	0.201
G	2	10,000	0.230	J	16	8,750	0.201
G	3	10,000	0.230	J	17	8,427	0.193
G	4	10,228	0.235	J	18	8,125	0.187
G	5	10,000	0.230	j	19	8,623	0.198
G	6	10,739	0.247	J	20	15,393	0.353
Н	1	2,500	0.057	J	21	12,239	0.281
Н	2	8,489	0.195	J	22	10,316	0.237
Н	3	8,125	0.187	J	23	9,163	0.210
Н	4	8,125	0.187	J	24	9,011	0.207
Н	5	8,125	0.187	J	25	17,068	0.392
Н	6	8,125	0.187	J	26	14,657	0.336
Н	7	8,125	0.187	J	27	15,959	0.366
Н	8	8,125	0.187	J	28	10,345	0.237
Н	9	8,125	0.187	J	29	12,760	0.293
Н	10	8,125	0.187	J	30	12,383	0.284
Н	11	8,125	0.187	К	1	10,747	0.247
Н	12	8,125	0.187	К	2	8,325	0.191
Н	13	8,125	0.187	K	3	8,325	0.191
Н	14	8,125	0.187	K	4	8,325	0.191
Н	15	8,125	0.187	К	5	8,325	0.191
Н	16	9,590	0.220	K	6	8,325	0.191
Н	17	17,555	0.403	К	7	8,325	0.191
Н	18	10,281	0.236	K	8	8,614	0.198
Н	19	8,750	0.201	K	9	9,219	0.212
Н	20	8,750	0.201	K	10	9,729	0.223
Н	21	8,750	0.201	K	11	9,551	0.219
Н	22	9,375	0.215	K	12	8,956	0.206
Н	23	10,625	0.244	K	13	8,956	0.206
Н	24	10,000	0.230	K	14	8,603	0.198
Н	25	10,000	0.230	K	15	8,697	0.200
	26	10,000	0.230	K	16	8,696	0.200
Н	25	10,000	0.230	K	17	8,695	0.200
H		11,125			18	8,695	0.200
Н	28		0.255	K	19	8,695	0.200
J	2	11,250 11,020	0.258	K	20	11,545	0.200

	LINE TABLE			LINE TABL	E
NO.	DIRECTION	DISTANCE	NO.	DIRECTION	DISTANCE
L1	S 01°26'05" E	125.00'	L23	S 41°55'38" W	41.19'
L2	S 88°33'55" W	10.00'	L24	S 01*26'05" E	57.53
L3	S 01°26'05" E	50.00'	L25	S 85°30'11" W	66.96
L4	N 88'33'55" E	10.00'	L26	S 76°23'43" W	61.57
L5	S 01°26'05" E	125.00'	L27	S 67*34'05" W	61.57
L6	S 74'39'57" E	88.77'	L28	S 59'41'23" W	64.21
L7	S 27*50'10" E	60.72	L29	S 60°25'59" W	63.64
L8	S 09'02'55" E	64.32'	L30	N 63°01'42" E	63.64
L9	S 14'35'37" E	62.88'	L31	N 65*37'26" E	63.64
L10	S 18*37'29" E	67.02'	L32	N 68'13'09" E	63.64
L11	S 15'12'53" E	74.64'	L33	N 70°48'53" E	63.64
L12	S 11*22'18" E	81.90'	L34	N 73°24'36" E	63.64
L13	N 10°58'09" W	10.20'	L35	S 76°21'39" W	81.00'
L14	S 79°01'51" W	50.00'	L36	N 14'16'45" W	66.78
L15	S 10°58'09" E	10.20'	L37	S 82'52'23" W	77.17
L16	S 12°16'48" E	50.00'	L38	N 73°57'31" E	72.34
L17	S 10*58'09" E	250.04	L39	N 60°38'26" W	30.28
L18	S 88'58'40" W	35.00'	L40	S 18*33'56" E	69.05
L19	N 01°01'20" W	56.74'	L41	S 14°29'17" E	62.00'
L20	S 88*58'40" W	27.24'	L42	S 17*28'56" E	72.75
L21	S 46°26'05" E	40.00'	L43	S 79*53'09" W	130.22
L22	S 01°26'05" E	150.00'	L44	N 10'58'09" W	31.71

			CURVE T	ABLE		
CURVE	DELTA	RADIUS	TANGENT	LENGTH	CHORD BEARING	CHORD
C1	04.32,28,	1580.00'	62.65'	125.23'	S 82°12'29" W	125.19
C2	00°24'15"	1580.00'	5.57'	11.15'	S 77*55'20" W	11.15'
СЗ	00°22'28"	1530.00'	5.00'	10.00'	S 77*54'26" W	10.00'
C4	00°26'52"	1280.00'	5.00'	10.00'	S 77*41'16" W	10.00'
C5	30*59'26"	555.00'	153.87	300.19	N 73°28'57" E	296.55
C6	19*28'37"	1250.00'	214.53'	424.92'	S 67°43'32" W	422.88
C7	30'59'27"	250.00'	69.31'	135.22	N 73°28'57" E	133.58
C8	19*43'58"	1555.00'	270.45	535.55	S 67*51'13" W	532.91
C9	23*01'04"	300.00'	61.08'	120.52'	S 12'31'52" E	119.71
C10	18*23'27"	800.00'	129.51'	256.78'	S 10°37'48" E	255.68'
C11	08*51'23"	800.00'	61.95'	123.66'	N 15°23'50" W	123.53'
C12	90'00'00"	25.00'	25.00'	39.27'	N 46°26'05" W	35.36
C13	89*35'15"	25.00'	24.82'	39.09'	S 43°46'18" W	35.23

NOTES:

- The bearings and coordinates shown and recited hereon are referenced to the Texas Coordinate System of 1983 North Central Zone No. 4202 — NAD83. All distances are surface distances with a surface to grid scale factor of 1.000146135
- 2. Subdivision property corners are 5/8—inch iron rods with caps marked "PETITT—ECD 6134" found or set, unless noted otherwise. Lot corners are 5/8—inch iron rods with cap marked "PETITT— ECD 6134" set or an "X" cut set in concrete, unless otherwise noted. When a retaining wall or screening fence has been placed at the rear lot corner, a 5/8—inch iron rod may be set five feet (5') from the rear lot corner along the side lot line
- 3. Subject tract is located in Zone X (Areas determined to be outside the 0.2% annual chance floodplain) according to Federal Emergency Management Area Flood Insurance Rate Maps for Ellis County, Texas and incorporated areas ~ Map Number 48397C0045L, Effective Date September 26, 2008. Floodplain lines plotted hereon are graphically shown according to this map and should be considered approximate.
- 4. All Open Space tracts, Drainage, & Detention Easements will be maintained, repaired and replaced by the Homeowners
- 5. Lot 1, Block H and Lot 2, Block F will be dedicated to the Homeowners Association. They will be maintained by the Homeowners Association.
- 6. Retaining Walls in the Lot 2, Block F (Park Area) will be maintained, repaired and replaced by the Homeowners Association.
- 7. Driveway depth must be 25' or more between the front of garage and edge of sidewalk.
- 8. Retaining Walls in Residential Lots will be maintained, repaired and replaced by the Property Owners.
- 9. The flood information shown on this plat is based on the August 20, 2020 Terracina Detention Study completed by McLendon Hydrology and Engineering, LLC.
- 10. Subdivider's statement: Selling a portion of this addition by metes and bounds is unlawful and a violation of the subdivision ordinance of the city and chapter 212, municipal regulation of subdivisions and property development, of the Texas Local Government Code, and shall be subject to the city withholding utilities and building permits.
- 11. Public improvement statement: It shall be the policy of the city to withhold issuing buildings permits until all streets, water, sewer and storm drainage systems have been accepted by the city. The approval of a subdivision plat by the city does not constitute any representation, assurance or guarantee that any building within such subdivision plat shall be approved, authorized, or permit issued, nor shall such approval constitute any representation, assurance or guarantee by the city of the adequacy and availability for water and sanitary sewer for personal use and fire protection within such subdivision plat, as required under the subdivision ordinance of the city.
- 12. Drainage and detention easements: The property owner and Homeowners Association shall be responsible for maintaining, repairing, and replacing and shall bear sole liability of all systems within the drainage and detention easements.
- 13. Fire lanes: All fire lanes will be constructed, maintained, repaired and replaced by the property owner. Fire lanes shall be constructed in accordance with the approved civil engineering plans for both on—site and off—site fire lane improvements.
- 14. Street appurtenances: All decorative signage, posts, or lights installed in public right—of—way shall be installed, maintained, repaired, and replaced by the homeowner's association (HOA).
- 15. The source of water for this subdivision will be the City of Rockwall.
- 16. The method of wastewater disposal for this subdivision will be connecting to the City of Rockwall existing systems and facilities.

FINAL PLAT

TERRACINA ESTATES PHASE 2

LOTS 15-25, BLOCK D; LOT 2, BLOCK F; LOTS 1-6, BLOCK G; LOTS 1-28, BLOCK H; LOTS 1-30, BLOCK J; & LOTS 1-20, BLOCK K

94 RESIDENTIAL LOTS, 1 OPEN SPACE LOT AND 1 PARK LOT 31.331 ACRES OR 1,364,769 SQ. FT.

JOHN A. RAMSEY SURVEY, A-186

CITY OF ROCKWALL, ROCKWALL COUNTY, TEXAS

PETITT - ECD

CIVIL ENGINEERING/SURVEYING/CONSTRUCTION

ADMINISTRATION

TBPELS FIRM REGISTRATION
ENGINEERING FIRM #001145 SURVEYING FIRM #10194792

1600 N. COLLINS BLVD. SUITE 3300 RICHARDSON, TX 75080

ON, TX 75080 WYLIE, TX 75098 (972) 941-8400 CASE NO. P2024-022 SHEET 3 (

201 WINDCO CIR.

the City of Rockwall,

APPROVED:
I hereby certify that the above and forgoing subdivision
TERRACINA, PHASE 2, being an addition to the City of Rockwall,
Texas was approved by the city council of the City of Rockwall,
Texas on the _______, 2024.

APPROVAL CERTIFICATE

MAYOR OF THE CITY OF ROCKWALL

PLANNING AND ZONING COMMISSION CHAIRMAN

Sinty Jeagne CITY SECRETARY

Orny william, P.E.

BENCHMARKS:

CP-2 - "X" cut on back of curb on the south side of Guadeloupe Drive approximately 1,250 feet west of Rochelle Road.

Floration = 578.60

Elevation = 578.60

 CP-3 - "X" cut on back of curb on the south side of Oakcrest Drive approximately 20' west of Lasalle Drive

Elevation = 562.98

OWNER/DEVELOPER

BLOOMFIELD HOMES L.P.

1900 W K!RKWOOD BLVD, SUITE 2300B
SOUTHLAKE, TEXAS 76092
PHONE: 817-416-1572

Z:\PROJECTS\06537 Terracina Estates\dwg\Plats\06537 Final Plat Ph 2.dwg

OWNER'S CERTIFICATE AND DEDICATION

STATE OF TEXAS COUNTY OF ROCKWALL

WHEREAS BLOOMFIELD HOMES, LP, BEING THE OWNER OF A TRACT OF land situated in the County of Rockwall, State of Texas, said tract being described as follows:

BEING a 31.331—acre tract of land situated in the John A. Ramsey Survey, Abstract 186, City of Rockwall, Rockwall County, Texas and being part of a called 81.49—acre tract of land described in deed to Bloomfield Homes, LP, as recorded in Instrument Number 20170000022672, Deed Records, Rockwall County, Texas (DRRCT), and being more particularly described by metes and bounds as follows:

BEGINNING at a 5/8-inch iron rod with cap stamped PETITT-ECD 6134 set (hereinafter called "iron rod set") for the southeast corner of Terracina Phase 1, an addition to the City of Rockwall, Texas according to the Final Plat thereof as recorded in Instrument Number 20210000019450 Plat Records Rockwall, County, Texas (PRRCT), and being in the common line of said 81.49—acre tract and Ridge Haven Estates, an addition to Rockwall County, Texas according to the Final Plat thereof as recorded in Cabinet A, Slide 213, PRRCT;

THENCE South 89 degrees 08 minutes 36 seconds West with said common line, a distance of 947.35 feet to an iron rod set for the southwest corner of said 81.49—acre tract also being the southeast corner of a called 59.065—acre tract of land described in deed to Bloomfield Homes, LP, recorded in Instrument Number 20180000012449, from which a 3/8-inch iron rod found bears North 01 degrees 42 minutes East, a distance of 3.8 feet;

THENCE North 01 degrees 01 minute 20 seconds West with the common line of said 81.49—acre tract and said 59.065—acre tract, a distance of 1,648.36 feet to an iron rod set for the northwest corner of said 81.49—acre tract and being the most southerly southwest corner of Timber Creek Estates, an addition to the City of Rockwall, Texas according to the Final Plat thereof, recorded in Cabinet E, Slide 55, PRRCT from which a 1/2-inch iron rod found bears North 80 degrees 35 minutes East, a distance of 1.29 feet;

THENCE North 88 degrees 33 minutes 55 seconds East with the common line of said 81.49—acre tract and said Timber Creek Estates a distance of 492.29 feet to a 5/8-inch iron rod with cap stamped ADAMS SURVEYING CO. found (hereinafter called "iron rod with cap found") for the northwest corner of said Terracina Estates, Phase 1;

THENCE with the west line of said Terracina Phase 1, the following courses;

- South 01 degrees 26 minutes 05 seconds East, a distance of 125.00 feet to an iron rod set for corner:
- South 88 degrees 33 minutes 55 seconds West, a distance of 10.00 feet to an iron rod with cap found for corner;
- South 01 degrees 26 minutes 05 seconds East, a distance of 50.00 feet to an iron rod set for corner:
- North 88 degrees 33 minutes 55 seconds East, a distance of 10.00 feet to an iron 6. No house dwelling unit, or other structure shall be constructed on any lot in this rod set for corner;
- iron rod with cap found for corner • North 88 degrees 33 minutes 55 seconds West, a distance of 295.00 feet to an

• South 01 degrees 26 minutes 05 seconds East, a distance of 125.00 feet to an

- iron rod with cap found for corner;
- South 74 degrees 39 minutes 57 seconds East, a distance of 88.77 feet to a 5/8-inch iron rod found for corner;
- South 27 degrees 50 minutes 10 seconds East, a distance of 60.72 feet to a 5/8-inch iron rod found for corner;
- South 04 degrees 38 minutes 17 seconds East, a distance of 181.25 feet to an iron rod with cap found for corner;
- South 09 degrees 02 minutes 55 seconds East, a distance of 64.32 feet to an iron rod set for corner;
- South 14 degrees 35 minutes 37 seconds East, a distance of 62.88 feet to an iron rod set for corner;
- South 18 degrees 37 minutes 29 seconds West, a distance of 67.02 feet to an iron rod set for corner;
- South 15 degrees 12 minutes 53 seconds East, a distance of 74.64 feet to an iron rod set for corner;
- South 11 degrees 22 minutes 18 seconds West, a distance of 81.90 feet to an iron rod set for the beginning of a non-tangent curve to the left;
- Southwesterly, with said curve, which has a central angle of 04 degrees 32 minutes 28 seconds, a radius of 1,580.00 feet, a chord that bears South 82 degrees 12 minutes 29 seconds West, with a chord length of 125.19 feet and an arc length of
- 125.23 feet to an iron rod set for the end of said curve; • North 10 degrees 58 minutes 09 seconds West, a distance of 10.20 feet to an iron
- rod set for corner; • South 79 degrees 01 minutes 51 seconds West, a distance of 50.00 feet to an iron
- rod set for corner;
- South 10 degrees 58 minutes 09 seconds East, a distance of 10.20 feet to an iron
- rod set for the beginning of a non-tangent curve to the left; • Southwesterly, with said curve, which has a central angle of 00 degrees 24 minutes 15 seconds, a radius of 1,580.00 feet, a chord that bears South 77 degrees 55 minutes 20 seconds West, with a chord length of 11.15 feet and an arc length of
- 11.15 feet to an iron rod with cap found for the end of said curve; • South 12 degrees 16 minutes 48 seconds East, a distance of 50.00 feet to an iron
- rod with cap found for the beginning of a non-tangent curve to the right; • Northeasterly, with said curve, which has a central angle of 00 degrees 22 minutes 28 seconds, a radius of 1,530.00 feet, a chord that bears South 77 degrees 54 minutes 26 seconds East, with a chord length of 10.00 feet and an arc length of 10.00 feet to an iron rod set for the end of said curve;

• South 10 degrees 58 minutes 09 seconds East, a distance of 250.04 feet to an

- iron rod set for the beginning of a non-tangent curve to the left; • Southwesterly, with said curve, which has a central angle of 00 degrees 26 minutes 52 seconds, a radius of 1,280.00 feet, a chord that bears South 77 degrees 41 minutes 16 seconds West, with a chord length of 10.00 feet and an arc length of 10.00 feet to an iron rod set for the end of said curve;
- South 12 degrees 32 minutes 10 seconds East, a distance of 443.09 feet to the POINT OF BEGINNING AND CONTAINING 1,364,769 square feet or 31.331 acres of land.

NOW THEREFORE, KNOW ALL MEN BY THESE PRESENTS:

STATE OF TEXAS

COUNTY OF ROCKWALL

I (we) the undersigned owner(s) of the land shown on this plat, and designated herein as the TERRACINA, PHASE 2, a subdivision to the City of Rockwall, Texas, and whose name is subscribed hereto, hereby dedicate to the use of the public forever all streets, alleys, parks, water courses, drains, easements and public places thereon shown on the purpose and consideration therein expressed. I (we) further certify that all other parties who have a mortgage or lien interest in the TERRACINA, PHASE 2 subdivision have been notified and signed this plat. I (we) understand and do hereby reserve the easement strips shown on this plat for the purposes stated and for the mutual use and accommodation of all utilities desiring to use or using same. I (we) also understand the following;

- 1. No buildings shall be constructed or placed upon, over, or across the off-site and on-site utility easements as described herein.
- 2. Any public utility shall have the right to remove and keep removed all or part of any buildings, fences, trees, shrubs, or other growths or improvements which in any way endanger or interfere with construction, maintenance or efficiency of their respective system on any of these easement strips; and any public utility shall at all times have the right of ingress or egress to, from and upon the said easement strips for purpose of construction, reconstruction, inspecting, patrolling, maintaining, and either adding to or removing all or part of their respective system without the necessity of, at any time, procuring the permission of anyone.
- 3. The city will not be responsible for any claims of any nature resulting from or occasioned by the establishment of grade of streets in the subdivision.
- 4. The developer/property owner and subdivision engineer shall bear total responsibility for storm drain improvements.
- 5. The developer/property owner shall be responsible for the necessary facilities to provide drainage patterns and drainage controls such that properties within the drainage area are not adversely affected by storm drainage from the development.
- addition by the owner or any other person until the developer and/or owner has complied with all requirements of the Subdivision Regulations of the city regarding improvements with respect to the entire block on the street or streets on which property abuts, including the actual installation of streets with the required base and paving, curb and gutter, water and sewer, drainage structures, storm structures, storm sewers, and alleys, all according to the specifications of the city; or

Until an escrow deposit, sufficient to pay for the cost of such improvements, as determined by the city's engineer and/or city administrator, computed on a private commercial rate basis, has been made with the city secretary, accompanied by an agreement signed by the developer and/or owner, authorizing the city to make such improvements at prevailing private commercial rates, or have the same made by a contractor and pay for the same out of the escrow deposit, should the developer and/or owner fail or refuse to install the required improvements within the time stated in such written agreement, but in no case shall the City be obligated to make such improvements itself. Such deposit may be used by the owner and/or developer as progress payments as the work progresses in making such improvements by making certified requisitions to the city secretary, supported by evidence of work done; or

Until the developer and/or owner files a corporate surety bond with the city secretary in a sum equal to the cost of such improvements for the designated area, guaranteeing the installation thereof within the time stated in the bond, which time shall be fixed by the city council of the city.

7. Property owner shall be responsible for maintining, repairing and replacing all systems within the drainage and detention easements.

I (we) further acknowledge that the dedications and/or exaction's made herein are proportional to the impact of the Subdivision upon the public services required in order that the development will comport with the present and future growth needs of the City; I (we), my (our) successors and assigns hereby waive any claim, damage, or cause of action that I (we) may have as a result of the dedication of exactions made

BLOOMFIELD HOMES, LP, a Texas limited partnership BY: Bloomfield Properties, Inc. a Texasi corporation, General Partner

Donald J. Dykstra, President

SIGNATURE OF PARTY WITH MORTGAGE OR LIEN INTEREST (IF APPLICABLE)

LENDER: NAME: TITLE:

> STATE OF TEXAS COUNTY OF TARRANT

Before me, the undersigned authority, on this day personally appeared Donald J. Dykstra, known to me to be the person whose name is subscribed to the foregoing instrument, and acknowledged to me that he executed the same for the purpose and consideration therein stated.

Notary Public in and for the State of Texas My Commission Expires:

STATE OF TEXAS COUNTY OF ____

Before me, the undersigned authority, on this day personally appeared ___, known to me to be the person whose name is subscribed to the foregoing instrument, and acknowledged to me that he executed the same for the purpose and consideration therein stated.

Given under my hand and seal of office this ____ day of _____, 2024.

Notary Public in and for the State of Texas My Commission Expires:

SURVEYOR'S CERTIFICATE


NOW, THEREFORE KNOW ALL MEN BY THESE PRESENTS:

THAT I, James Mark Whitkanack, a Registered Public Surveyor of the State of Texas, do hereby certify that I prepared this plat from an actual and accurate survey of the land, and that the corner monuments shown thereon were properly placed under my personal

James Mark Whitkanack Registered Professional Land Surveyor

State Of Texas No. 6134



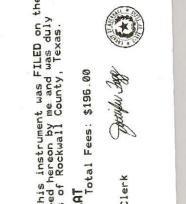

the R 17654 09:52:

OWNER/DEVELOPER BLOOMFIELD HOMES L.P. 1900 W KIRKWOOD BLVD, SUITE 2300B SOUTHLAKE, TEXAS 76092 PHONE: 817-416-1572

FINAL PLAT TERRACINA ESTATES PHASE 2

LOTS 15-25, BLOCK D; LOT 2, BLOCK F; LOTS 1-6, BLOCK G; LOTS 1-28, BLOCK H: LOTS 1-30, BLOCK J; & LOTS 1-20, BLOCK K BEING

94 RESIDENTIAL LOTS, 1 OPEN SPACE LOT AND 1 PARK LOT 31.331 ACRES OR 1,364,769 SQ. FT.

SITUATED IN THE JOHN A. RAMSEY SURVEY, A-186 CITY OF ROCKWALL, ROCKWALL COUNTY, TEXAS

> PETITT - ECD CIVIL ENGINEERING/SURVEYING/CONSTRUCTION ADMINISTRATION

TBPELS FIRM REGISTRATION 1600 N. COLLINS BLVD. SUITE 3300 RICHARDSON, TX 75080

ENGINEERING FIRM #001145 SURVEYING FIRM #10194792 201 WINDCO CIR. SUITE 100 WYLIE, TX 75098 (972) 941-8400

DATE: 7/09/2024 Z:\PROJECTS\06537 Terracina Estates\dwg\Plats\06537 Final Plat Ph 2.dwg

GENERAL ITEMS be on-site". structures which are located within the right-of-ways or defined easements. The two (2) year maintenance bond is to state "from date of City acceptance" as the starting time. A review of the site shall be conducted at twenty (20) months into the two (2) year maintenance period. The design engineer or their designated representative and the CONTRACTOR shall be present to walk the site with the City of Rockwall Engineering Inspection personnel. EROSION CONTROL & VEGETATION The CONTRACTOR or developer shall be responsible, as the entity exercising operational control. for all permitting as required by the Environmental Protection Agency (EPA) and the Texas Commission on Environmental Quality (TCHQ). This includes, but is not limited to, preparation of the Storm Water Pollution Prevention Plan (SWPPP), the Construction Site Notice (CSN), the Notice of Intent (NOI), the Notice of Termination (NOT) and any Notice of Change (NOC) and is required to pay all associated fees Erosion control devices as shown on the erosion control plan for the project shall be installed prior to the start of land disturbing activities. All erosion control devices are to be installed in accordance with the approved plans, specifications and Storm Water Pollution Prevention Plan (SWPPP) for the project, Erosion control devices shall be placed and in working order prior to start of construction. Changes are to be reviewed and approved by the design engineer and the City of Rockwall prior to implementation If the Erosion Control Plans and Storm Water Pollution Prevention Plan (SWPPP) as approved cannot appropriately control erosion and off-site sedimentation from the project, the erosion control plan and/or the SWPPP is required to be revised and any changes reported to the Texas Commission on Environmental Quality (TCEQ), when applicable, All erosion control devices shall be inspected weekly by the CONTRACTOR and after all major rain events, or more frequently as dictated in the project Storm Water Pollution Prevention Plan (SWPPP) CONTRACTOR shall provide copies of inspection's reports to the engineering inspection after each The CONTRACTOR shall not dispose of waste and any materials into streams, waterways or floodplains The CONTRACTOR shall secure all excavation at the end of each day and dispose of all excess materials. CONTRACTOR shall take all available precautions to control dust. CONTRACTOR shall control dust by sprinkling water or other means as approved by the City Engineer. CONTRACTOR shall establish grass and maintain the seeded area, including watering, until a "Permanent Stand of Grass" is obtained at which time the project will be accepted by the City. A "Stand of Grass" (not winter rye or weeds) shall consist of 75% to 80% coverage of all disturbed areas and a minimum of one-inch (1") in height as determined by the City. No bare spots will be allowed. Re-seeding will be required in all washed areas and areas that don't grow. All City right-of-ways shall be sodded if disturbed. No artificial grass is allowed in any City right-of-way and/or easements. 10. All adjacent streets/alleys shall be kept clean at all times 1. CONTRACTOR shall keep construction site clean at all times, immediately contain all debris and trash, all debris and trash shall be removed at the end of each work day, and all vegetation on the construction site 10inches or taller in height must be cut immediately 2. Suspension of all construction activities for the project will be enforced by the City if any erosion control requirements are not meet. Work may commence after deficiency has been rectified During construction of the project, all soil stockpiles and borrow areas shall be stabilized or protected with sediment trapping measures. The CONTRACTOR is responsible for the temporary protection and permanent stabilization of all soil stockpiles on-site as well as borrow areas and soil intentionally transported from the Where construction vehicles access routes intersect paved or public roads/alleys, construction entrances shall be installed to minimize the transport of sediment by vehicular tracking onto paved surfaces. Where sediment is transferred onto paved or public surfaces, the surface shall be immediately cleaned. Sediment shall be DEMOLITION, REMOVAL, DISPOSAL AND EXCAVATION NOTES All payements to be removed and replaced shall be saw cut to full depth along neat squared lines shown in Proposed concrete pavement shall be constructed with longitudinal butt construction joints at all connections to existing concrete pavement. All public concrete pavement to be removed and replaced shall be full panel replacement, 1-inch thicker and on top of 6-inch thick compacted flexbase. No excess excavated material shall be deposited in low areas or along natural drainage ways without written nermission from the affected property owner and the City of Rockwall. No excess excavation shall be deposited in the City Limits without a permit from the City of Rockwall. If the CONTRACTOR places excess materials in these areas without written permission, the CONTRACTOR will be responsible for all damages resulting from such fill and shall remove the material at their own cos PAVING AND GRADING All detention systems are to be installed and verified for design compliance along with the associated storm sewer and outflow structures, prior to the start of any paving operations (including building foundations). Erosion protection shall be placed at the pend outflow structures, silt fence along the perimeter of the pend along with any of the associated crosson BMPs noted on the crosson control plan, and the sides and bottom of the detention system shall have either sod or anchored seeded curlex installed prior to any concrete placement. All paving roadway, driveways, fire lanes, drive-isles, parking, dumpster pads, etc. sections shall have a minimum thickness, strength, reinforcement, joint type, joint spacing and subgrade treatment shall at a minimum conform to the City standards of Design and Construction and table below. Fire Lane 3,000 5" 3,000 7° 3,600 Dumpster Pads Reinforcing steel shall be tied (100%). Reinforcing steel shall be set on plastic chairs. Bar laps shall be minimum 30 diameters. Sawed transverse dummy joints shall be spaced every 15 feet or 1.25 time longitudinal butt joint spacing whichever is less. Sawing shall occur within 5 to 12 hours after the pour, including sealing. Otherwise, the section shall be removed and longitudinal butt joint constructed. No sand shall be allowed under any paving. All concrete mix design shall be submitted to the City for review and approval prior to placement. Fly ash may be used in concrete pavement locations provided that the maximum cement reduction does not exceed 20% by weight per C.Y. of concrete. The fly ash replacement shall be 1.25 lbs. per 1.0 lb. cement All curb and gutter shall be integral (monolithic) with the pavement. All fill shall be compacted by sheep's foot roller to a minimum 95% standard proctor. Maximum loose lift for

All construction shall conform to the requirements set forth in the City of Rockwall's Engineering Department's "Standards of Design and Construction" and the "Standard Specifications for Public Works Construction* by the North Texas Central Council of Governments, 5th edition amended by the City of Rockwall. The CONTRACTOR shall reference the latest City of Rockwall standard details provided in the Rockwall Engineering Departments "Standards of Design and Construction" manual for details not provided in these plans. The CONTRACTOR shall possess one set of the NCTCOG Standard Specifications and Details and the City of Rockwall's "Standards of Design and Construction" manual on the project site at all times Where any conflicting notes, details or specifications occur in the plans the City of Rockwall General Construction Notes, Standards, Details and Specifications shall govern unless detail or specification is more The City of Rockwall Engineering Departments "Standards of Design and Construction" can be found online at: http://www.rockwall.com/engr.asp All communication between the City and the CONTRACTOR shall be through the Engineering Construction Inspector and City Engineer or designated representative only. It is the responsibility of the CONTRACTOR to contact the appropriate department for inspections that do not fall under this approved engineering plan set. Prior to construction, CONTRACTOR shall have in their possession all necessary permits, plans, licenses, The CONTRACTOR shall have at least one original stamped and signed set of approved engineering plans and specifications on-site and in their possession at all times. A stop work order will be issued if items are not on-site. Copies of the approved plans will not be substituted for the required original "approved plans to All material submittals, concrete batch designs and shop drawings required for City review and approval shall be submitted by the CONTRACTOR to the City sufficiently in advance of scheduled construction to allow no less than 10 business days for review and response by the City. All site dimensions are referenced to the face of curb or edge of pavement unless otherwise noted. The City requires ten (10%) percent-two (2) year maintenance bond for paving, paving improvements, water systems, wastewater systems, storm sewer systems including detention systems, and associated fixtures and

removed from the surface by shoveling or sweeping and transported to a sediment disposal area. Pavement washing shall be allowed only after sediment is removed in this manner. . All drainage inlets shall be protected from siltation, ineffective or unmaintained protection devices shall be into a receiving outlet

immediately replaced and the inlet and storm system cleaned. Flushing is not an acceptable method of 16. During all dewatering operations, water shall be pumped into an approved filtering device prior to discharge

TRAFFIC CONTROL All new Detouring or Traffic Control Plans are required to be submitted to the City for review and approval a minimum of 21 calendar days prior to planned day of implementation

public through the area. Consideration for road user safety, worker safety, and the efficiency of road user flow is an integral element of every traffic control zone. All traffic control plans shall be prepared and submitted to the Engineering Department in accordance with the standards identified in Part VI of the most recent edition of the TMUTCD. Lane closures will not occur on roadways without an approval from the Rockwall Engineering Department and an approved traffic control plan. Traffic control plans shall be required on all rondways as determined by the City Engineer or the

All traffic control plans must be prepared, signed, and sealed by an individual that is licensed as a professional engineer in the State of Texas. All traffic control plans and copies of work zone certification must be submitted for review and approval a minimum of three (3) weeks prior to the anticipated temporary traffic control. The CONTRACTOR executing the traffic control plan shall notify all affected property owners two (2) weeks prior to any the closures in writing and verbally.

Any deviation from an approved traffic control plan must be reviewed by the City Engineer or the designated representative. If an approved traffic control plan is not adhered to, the CONTRACTOR will first receive a verbal warning and be required to correct the problem immediately. If the deviation is not corrected, all construction work will be suspended, the lane closure will be removed, and the roadway opened to traffic. All temporary traffic control devices shall be removed as soon as practical when they are no longer needed When work is suspended for short periods of time at the end of the workday, all temporary traffic control devices that are no longer appropriate shall be removed or covered. The first violation of this provision will

result in a verbal warning to the construction foreman. Subsequent violations will result in suspension of all work at the job site for a minimum of 48 hours. All contractors working on City funded projects will be charged one working day for each 24 hour closure. Lane closures on any major or minor arterial will not be permitted between the hours of 6:00 am to 9:00 am and 3:30 pm to 7:00 pm. Where lane closures are needed in a school area, they will not be permitted during peak hours of 7:00 am - 9:00 am and 3:00 pm to 5:00 pm. Closures may be adjusted according to the actual start-finish times of the actual school with approval by the City Engineer. The first violation of this provision will result in a verbal warning to the construction foreman. Subsequent violations will result in suspension of all work at the job site for a minimum of 48 hours. All contractors working on City funded projects will be

charged one working day for each 24 hour closure of a roadway whether they are working or not. No traffic signs shall be taken down without permission from the City. . No street/roadway will be allowed to be fully closed.

It is the CONTRACTOR's responsibility to notify utility companies to arrange for utility locates at least 48 hours prior to beginning construction. The completeness and accuracy of the utility data shown on the plans is not guaranteed by the design engineer or the City. The CONTRACTOR is responsible for verifying the depth and location of existing underground utilities proper to excavating, trenching, or drilling and shall be required to take any precautionary measures to protect all lines shown and .or any other underground utilities tot on record or not shown on the plans.

The CONTRACTOR shall be responsible for damages to utilities CONTRACTOR shall adjust all City of Rockwall utilities to the final grades.

All utilities shall be placed underground. CONTRACTOR shall be responsible for the protection of all existing main lines and service lines crossed or exposed by construction operations. Where existing mains or service lines are cut, broken or damaged, the CONTRACTOR shall immediately make repairs to or replace the entire service line with same type of original construction or better. The City of Rockwall can and will intervene to restore service if deemed necessary and charge the CONTRACTOR for labor, equipment, material and loss of water if repairs aren't made in a timely manner by the CONTRACTOR.

The City of Rockwall (City utilities) is not part of the Dig Tess or Texas one Call - 811 - line locate system. All City of Rockwall utility line locates are to be scheduled with the City of Rockwall Service Center. 972-771-7730. A 48-hour advance notice is required for all non-emergency line locates. Underground utility lines shall be installed in accordance with the following standards in addition to other

a. No more than 500 linear feet of trench may be opened at one time. b. Material used for backfilling trenches shall be properly compacted to 95% standard density in order to minimize crosion, settlement, and promote stabilization that the geotechnical engineer recommends. c. Applicable safety regulations shall be complied with.

This plan details pipes up to 5 feet from the building. Refer to the building plans for building connections. CONTRACTOR shall supply and install pipe adapters as necessary. All underground lines shall be installed, inspected, and approved prior to backfilling 13. All concrete encasement shall have a minimum of 28 days compressive strength at 3,000 psi (min. 5.5 sack

WATER LINE NOTES

The CONTRACTOR shall maintain existing water service at all times during construction Proposed water lines shall be AWWA C900-16 PVC Pipe (blue in color) for all sizes, DR 14 (PC 305) for pipeline sizes 12-inch and smaller, and DR 18 (PC 235) for 14-inch and larger water pipelines unless otherwishown on water plan and profiles sheets. Proposed water lines shall be constructed with minimum cover of feet for 6-inch through 8-inch, 5 feet for 12-inch through 18-inch and 6 feet for 20-inch and larger. Proposed water line embedment shall be NCTCOG Class 'B-3' as amended by the City of Rockwal

engineering standards of design and construction manual. CONTRACTOR shall coordinate the shutting down of all water lines with the City of Rockwall Engineer Inspector and Water Department. The City shall operate all water valves. Allow 5 business days from the date of notice to allow City personnel time to schedule a shut down. Two additional days are required for the When the normal function of the roadway is suspended through closure of any portion of the right-of-way, CONTRACTOR to notify residents in writing of the shut down after the impacted area has been identified. temporary construction work zone traffic control devices shall be installed to effectively guide the motoring Water shut downs impacting businesses during their normal operation hours is not allowed. CONTRACTOR is required to coordinate with the Rockwall Fire Department regarding any fire watch requirements as well as any costs incurred when the loss of fire protection to a structure occurs

CONTRACTOR shall furnish and install gaskets on water lines between all dissimilar metals and at valve (both existing and proposed). All fire hydrants and valves removed and salvaged shall be returned to the City of Rockwall Municipal

Service Center. Blue EMS pads shall be installed at every change in direction, valve, curb stop and service tap on the propose water line and every 250'. All water valve hardware and valve extensions, bolts, nuts and washers shall be 316 stainless stee

All fire hydrants bolts, nuts and washers that are buried shall be 316 stainless steel. 0. Abandoned water lines to remain in place shall be cut and plugged and all void spaces within the abandone line shall be filled with grout, flowable fill or an expandable permanent foam product. Valves to be abandor in place shall have any extensions and the valve box removed and shall be capped in concrete. All fire hydrants will have a minimum of 5 feet of clearance around the appurtenance including but not limit

to parking spaces and landscaping. All joints are to be megalug joints with thrust blocking. Water and sewer mains shall be kept 10 feet apart (parallel) or when crossing 2 feet vertical clearance. . CONTRACTOR shall maintain a minimum of 4 feet of cover on all water lines. . All domestic and irrigation services are required to have a testable backflow device with a double check valve

installed per the City of Rockwall regulations at the property line and shown on plans.

WASTEWATER LINE NOTES

The CONTRACTOR shall maintain existing wastewater service at all times during construction. Wastewater line for 4-inch through 15-inch shall be Green PVC - SDR 35 (ASTM D3034) [less 10 ft cover and SDR 26 (ASTM D3034) [10 ft or more cover). For 18-inch and lazer wastewater line shall be Green PVC - PS 46 (ASTM F679) fless 10 ft coverl and PS 115 (ASTM F679) [10 ft or more coverl. No service will be allowed on a sanitary sewer line deeper than 10 feet. Proposed wastewater line embedment shall be NCTCOG Class 'H' as amended by the City of Rockwal

public works standard design and construction manual. Green EMS pads shall be installed at every 250', manhole, clean out and service lateral on propose CONTRACTOR shall CCTV all existing wastewater lines that are to be abandoned to ensure that all latera

are accounted for and transferred to proposed wastewater lines prior to abandonment. All abandoned wastewater and force main lines shall be cut and plugged and all void spaces within t abandoned line shall be filled with grout, flowable fill or an expandable permanent foam product. Existing manholes and cleanouts not specifically called to be relocated shall be adjusted to match final gra-All wastewater pipes and public services shall be inspected by photographic means (television and DV) prior to final acceptance and after franchise utilities are installed. The CONTRACTOR shall furnish a DVI

to the Engineering Construction Inspector for review, Pipes shall be cleaned prior to TV inspection of the pipes. Any sags, open joints, cracked pipes, etc. shall be repaired or removed by the CONTRACTOR at the CONTRACTOR's expense. A television survey will be performed as part of the final testing in the twentiet (20th) month of the maintenance period. All manholes (public or private) shall be fitted with inflow prevention. The inflow prevention shall conform to the measures called out in standard detail R-5031.

All new or existing manholes being modified shall have corrosion protection being Raven Liner 405 epoxy coating, ConShield, or approved equal. Consheild must have terracotta color dye mixed in the precast and cast-in-place concrete. Where connections to existing manholes are made the CONTRACTOR shall rehab manhole as necessary and install a 125 mil thick coating of Raven Liner 405 or approved equal. All new or existing manholes that are to be placed in pavement shall be fitted with a sealed (gasketed) ris

. If an existing wastewater main or trunk line is called out to be replaced in place a wastewater bypassing pun plan shall be required and submitted to the Engineering Construction Inspector and City Engineer for approva prior to implementation. Bypass pump shall be fitted with an auto dialer and conform to the City's Noise Ordinance. Plan shall be to the City sufficiently in advance of scheduled construction to allow no less that

385 S. Goliad

Rockwall, Texas 75087

10 business days for review and response by the City. CONTRACTOR shall maintain a minimum of 4 feet of cover on all wastewater line



ENERAL CONSTRUCTION NOTES Sheet 1 of 2 October 2020 CITY OF ROCKWALL ENGINEERING DEPARTMENT

P (972) 771-7746

F (972) 771-7748

DRAINAGE / STORM SEWER NOTES

The CONTRACTOR shall maintain drainage at all times during construction. Ponding of water in streets, drives, trenches, etc. will not be allowed. Existing drainage ways shall not be blocked or removed unless explicitly stated in the plans or written approval is given by the City, All structural concrete shall be 4200 psi compressive strength at 28 days minimum 7.0 sack mix, air entrained,

unless noted otherwise. Fly ash shall not be allowed in any structural concrete Proposed storm sewer embedment shall be NCTCOG Class 'B' as amended by the City of Rockwall's Engineering Department Standards of Design and Construction Manual. 4. All public storm pipe shall be a minimum of 18-inch reinforced concrete pipe (RCP), Class III, unless otherwise noted.

All storm pipe entering structures shall be grouted to assure connection at the structure is watertigh All storm structures shall have a smooth uniform poured mortar invert from invert in to invert out.

All storm sewer manholes in paved areas shall be flush with the paving grade, and shall have traffic bearing

All storm sewer pipes and laterals shall be inspected by photographic means (television and DVD) prior to final acceptance and after franchise utilities are installed. The CONTRACTOR shall furnish a DVD to the Engineering Construction Inspector for review. Pipes shall be cleaned prior to TV inspection of the pipes. Any sags, open joints, cracked pipes, etc. shall be repaired or removed by the CONTRACTOR at the CONTRACTOR's expense. A television survey will be performed as part of the final testing in the twentieth (20th) month of the maintenance period.

RETAINING WALLS

Minimum Cement Steel Reinforcement

6.5 #4 bars 6.5 #3 bars

N/A 5.5 #3 bars 5.0 5.5 #3 bars

#3 bars #3 bars #3 bars

#3 bars

#3 bars

All retaining walls, regardless of height, will be reviewed and approved by the City Engineering Department . All retaining walls (including foundation stem walls), regardless of height, will be constructed of rock/stone/brick or rock/stone/brick faced. No smooth concrete walls are allowed. Wall materials shall be the

Space (O.C.E.W.) same for all walls on the project. All portions, including footings, tie-backs, and drainage backfill, of the wall shall be on-site and not encroach into any public easements or right-of-way. The entire wall shall be in one lot and shall not be installed along . All walls 3 feet and taller will be designed and signed/sealed by a registered professional engineer in the State

of Texas. The wall design engineer is required to inspect the wall construction and supply a signed/scaled letter of wall construction compliance to the City of Rockwall along with wall as-builts prior to City Engineering acceptance. No walls are allowed in detention easements. A variance to allow retaining walls in a detention easement will require approval by the Planning and Zoning Commission with appeals being heard by the City Council.

FINAL ACCEPTANCE AND RECORD DRWINGS/AS-BUILTS

Final Acceptance shall occur when all the items on the Checklist for Final Acceptance have been complete. and signed-off by the City. An example of the checklist for final acceptance has been included in the Appendix of the Standards of Design and Construction. Items on the checklist for final acceptance will vary per project and additional items not shown on the check list may be required. After improvements have been constructed, the developer shall be responsible for providing to the City "As

Built" or "Record Drawings". The Design Engineer shall furnish all digital files of the project formatted in Auto Cad 14, or 2000 format or newer and Adobe Acrobat (.pdf) format with a CD-ROM disk or flash drive. The disk or drive shall include a full set of plans along with any landscaping, wall plans, and details sheets. Submit 1-set of printed drawings of the "Record Drawings" containing copies of all sheets to the Engineering Construction Inspector for the project. The printed sheets will be reviewed by the inspector PRIOR to producing the "Record Drawing" digital files on disk or flash drive. This will allow any revisions to be addressed prior to producing the digital files.

Record Drawing Disk drawings shall have the Design Engineers seal, signature and must be stamped and dated as "Record Drawings" or "As Built Drawings" on all sheets.

All concrete compression tests and soil compaction/density tests are required to be submitted to the City's The City of Rockwall will not accept any Record Drawing disk drawings which include a disclaimer. A disclaimer shall not directly or indirectly state or indicate that the design engineer or the design engineer's surveyor/surveyors did not verify grades after construction, or that the Record Drawings were based solely on information provided by the construction contractor/contractors. Any Record Drawings which include like or similar disclaimer verbiage will not be accepted by the City of Rockwall.

Example of Acceptable Disclaimer: "To the best of our knowledge ABC Engineering, Inc., hereby states that this plan is As-Built. This information provided is based on surveying at the site and information provided by the contractor."

To the best of our knowledge Petitt-ECD,

RECORD DRAWINGS

L.P., hereby states that this plan is As-Built. This information provided is based on surveying at the site and information provided by the contractor.

CHARLES A. LAMPING, P.E. 10-15-2025 CHARLES A. LAMPING, P.E. DATE

RELEASED FOR CONSTRUCTION ILL RESPONSIBILITY FOR ADEQUACY OF DESIGN REMAINS WITH THE DESIGN ENGINEER. THE CITY OF ROCKWALL, IN REVIEWING AND RELEASING PLANS FOR CONSTRUCTION, ASSUMES NO RESPONSIBILITY FOR ADEQUACY OR ACCURACY OF

CAUTION! EXISTING UTILITIES

RACTOR SHOULD CALL 1-800-DIG-TESS PRIOR TO BEGINNING ANY CONSTRUCTION CTIVITIES FOR EXISTING UTILITY LOCATIONS. EXISTING UTILITIES AND UNDERGROUN FACILITIES INDICATED ON THESE PLANS HAVE BEEN LOCATED FROM REFERENCE INFORMATION. IT IS THE RESPONSIBILITY OF THE CONTRACTOR TO VERIFY BOTH HORIZONTALLY AND VERTICALLY THE LOCATION OF ALL EXISTING UTILITIES AND UNDERGROUND FACILITIES PRIOR TO CONSTRUCTION AND TO TAKE NECESSARY UTIONS IN ORDER TO PROTECT ALL FACILITIES ENCOUNTERED. THE CONTRACTOR SHALL PRESERVE AND PROTECT ALL EXISTING UTILITIES FROM DAMAGE DURING

CONSTRUCTION

BENCHMARKS:

CP 101 - Square cut on headwall west side of Rochelle road & 54' south of center of Polar Point Drive Elevation = 559.95 CP 103 - "X" in concrete east side of Rochelle Road, 1834' south of center of Polar Point Dr. Elevation = 564.54' CP 104 - Capped 5/8" Iron rod east side of Rochelle Road & 1250' south

CP 105 - Capped 5/8" Iron rod east side of Rochelle Road & 826' south

of the center of Polar Point Dr. Elevation = 572.70'

of the center of Polar Point Dr. Elevation = 568.75'

PETITT - ECD ENGINEERING SURVEYING CONSTRUCTION ADMINISTRATION

compaction shall be 8 inches. All lifts shall be tested for density by an independent laboratory. All laboratory

compaction reports shall be submitted to the City Engineering Construction Inspector once results are

10. All proposed sidewalks shall include barrier free ramps at intersecting streets, alleys, etc. Barrier free ramps

(truncated dome plate in Colonial or brick red color) shall meet current City and ADA requirements and be

. All public sidewalks shall be doweled into pavement where it abuts curbs and driveways. Expansion joint

. All connection of proposed concrete pavement to existing concrete pavement shall include a longitudinal butt

joint as the load transfer device. All longitudinal butt joints shall be clean, straight and smooth (not jagged in

3. Cracks formed in concrete pavement shall be repaired or removed by the CONTRACTOR at the City's discretion. CONTRACTOR shall replace existing concrete curbs, sidewalk, paving, a gutters as indicated on the plans and as necessary to connect to the existing infrastructure, including any damage caused by the

4. All residential lots will require individual grading plans submitted during the building permit process that

. Approval of this plan is not an authorization to grade adjacent properties when the plans or field conditions

warrant off-site grading. Written permission must be obtained and signed from the affected property owner(s)

and temporary construction easements may be required. The written permission shall be provided to the City

as verification of approval by the adjacent property owner(s). Violation of this requirement will result in

7. CONTRACTOR agrees to repair any damage to property and the public right-of-way in accordance with the

 CONTRACTOR shall protect all monuments, iron pins/rods, and property corners during construction. CONTRACTOR shall ensure positive drainage so that runoff will drain by gravity flow to new or existing

All cut or fill slopes of non-paved areas shall be a maximum of 4:1 and minimum of 1%.

received. All reports will be required prior to final acceptance.

correspond with the engineered grading and drainage area plans.

suspension of all work at the job site until issue has been rectified

approved by the Texas Department of Licensing and Regulation (TDLR).

Engineering Inspector immediately upon results.

material shall be used at these locations.


City Standards of Design and Construction.

drainage inlets or sheet flow per these approved plans.

TBPELS REGISTRATION NGINEERING FIRM #001145 - SURVEYING FIRM #10194792 1600 N. COLLINS BLVD 201 WINDCO CIRCLE RICHARDSON, TX 75080 WYLIE, TX 75098 972.941.8401

DRAWN: RH CHECKED: CAL 8/08/2024 PROJECT NO.: 06537 DWG FILE NAME: 06537-C-COVER-2.DWG

THIS DOCUMENT IS RELEASED FOR THE PURPOSE OF CONSTRUCTION THE SEAL APPEARING ON THIS DOCUMENT WAS AUTHORIZED BY CHARLES A. LAMPING, P.E. 88554

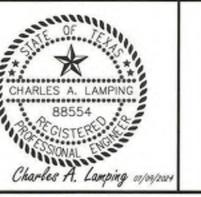

GENERAL CONSTRUCTION NOTES

Sheet 2 of 2

CITY OF ROCKWALL

ENGINEERING DEPARTMENT


F (972) 771-7748


Rockwall, Texas 75087

GENERAL NOTES

TERRACINA ESTATES PHASE 2

CITY OF ROCKWALL, ROCKWALL COUNTY, TEXAS

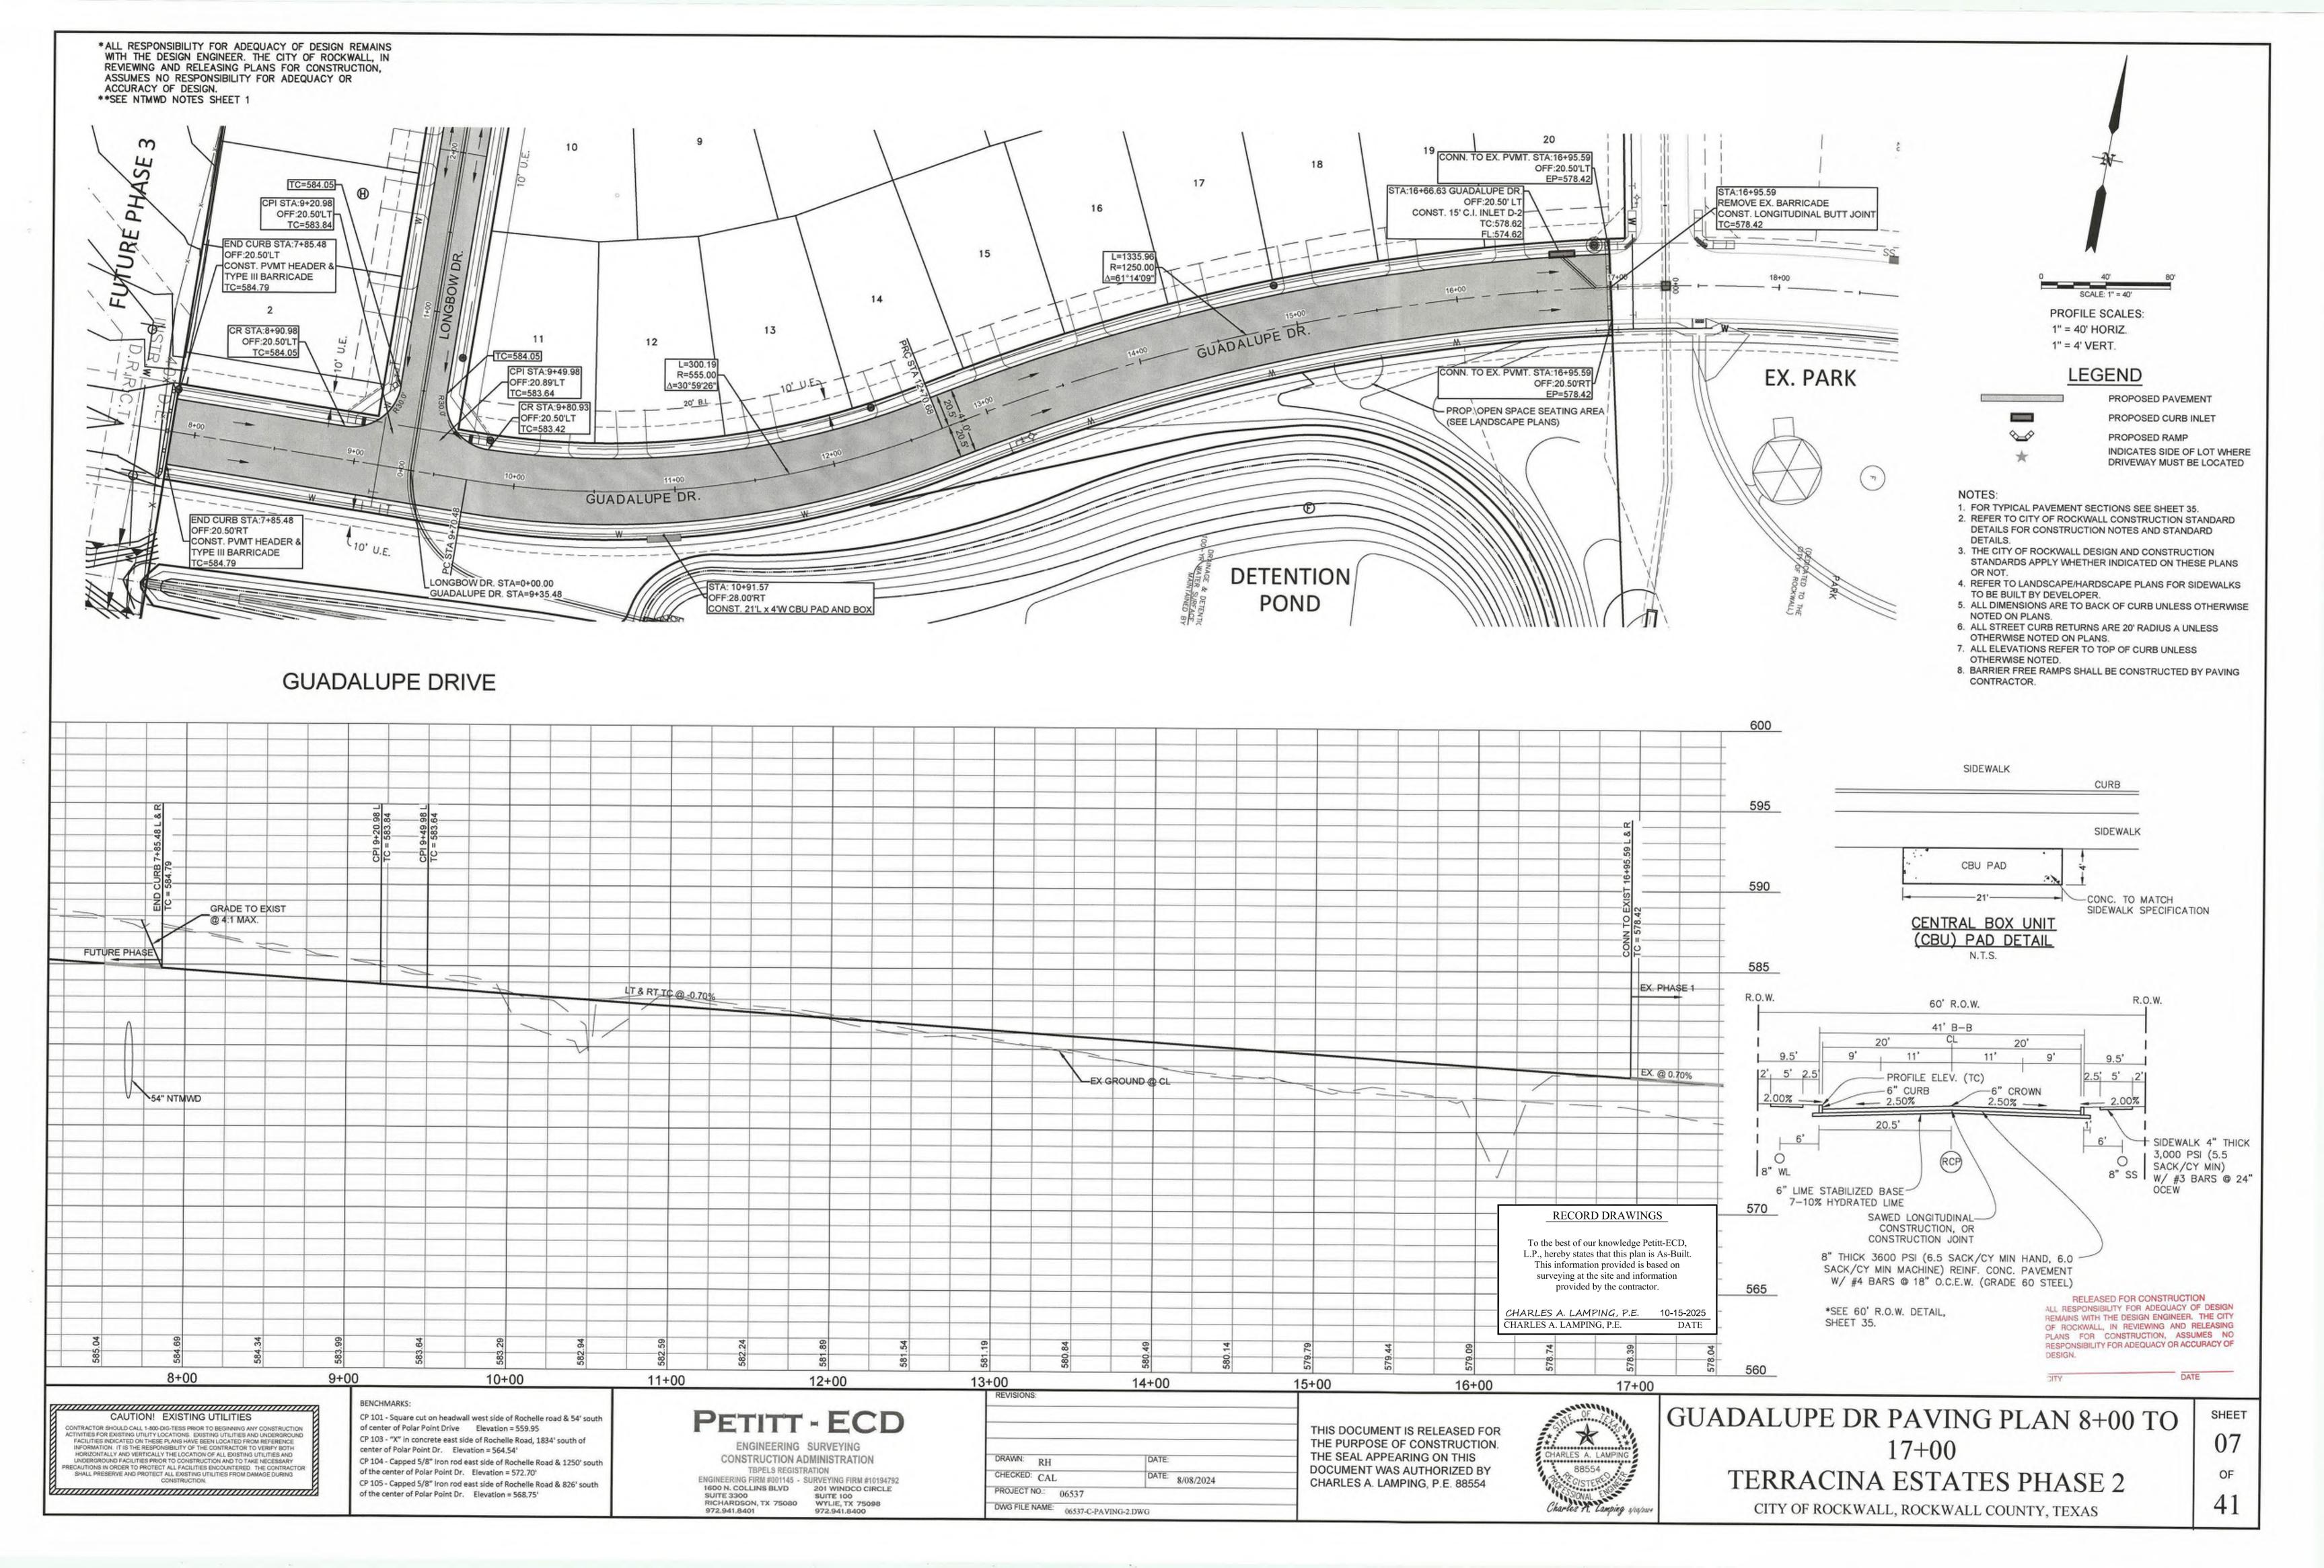

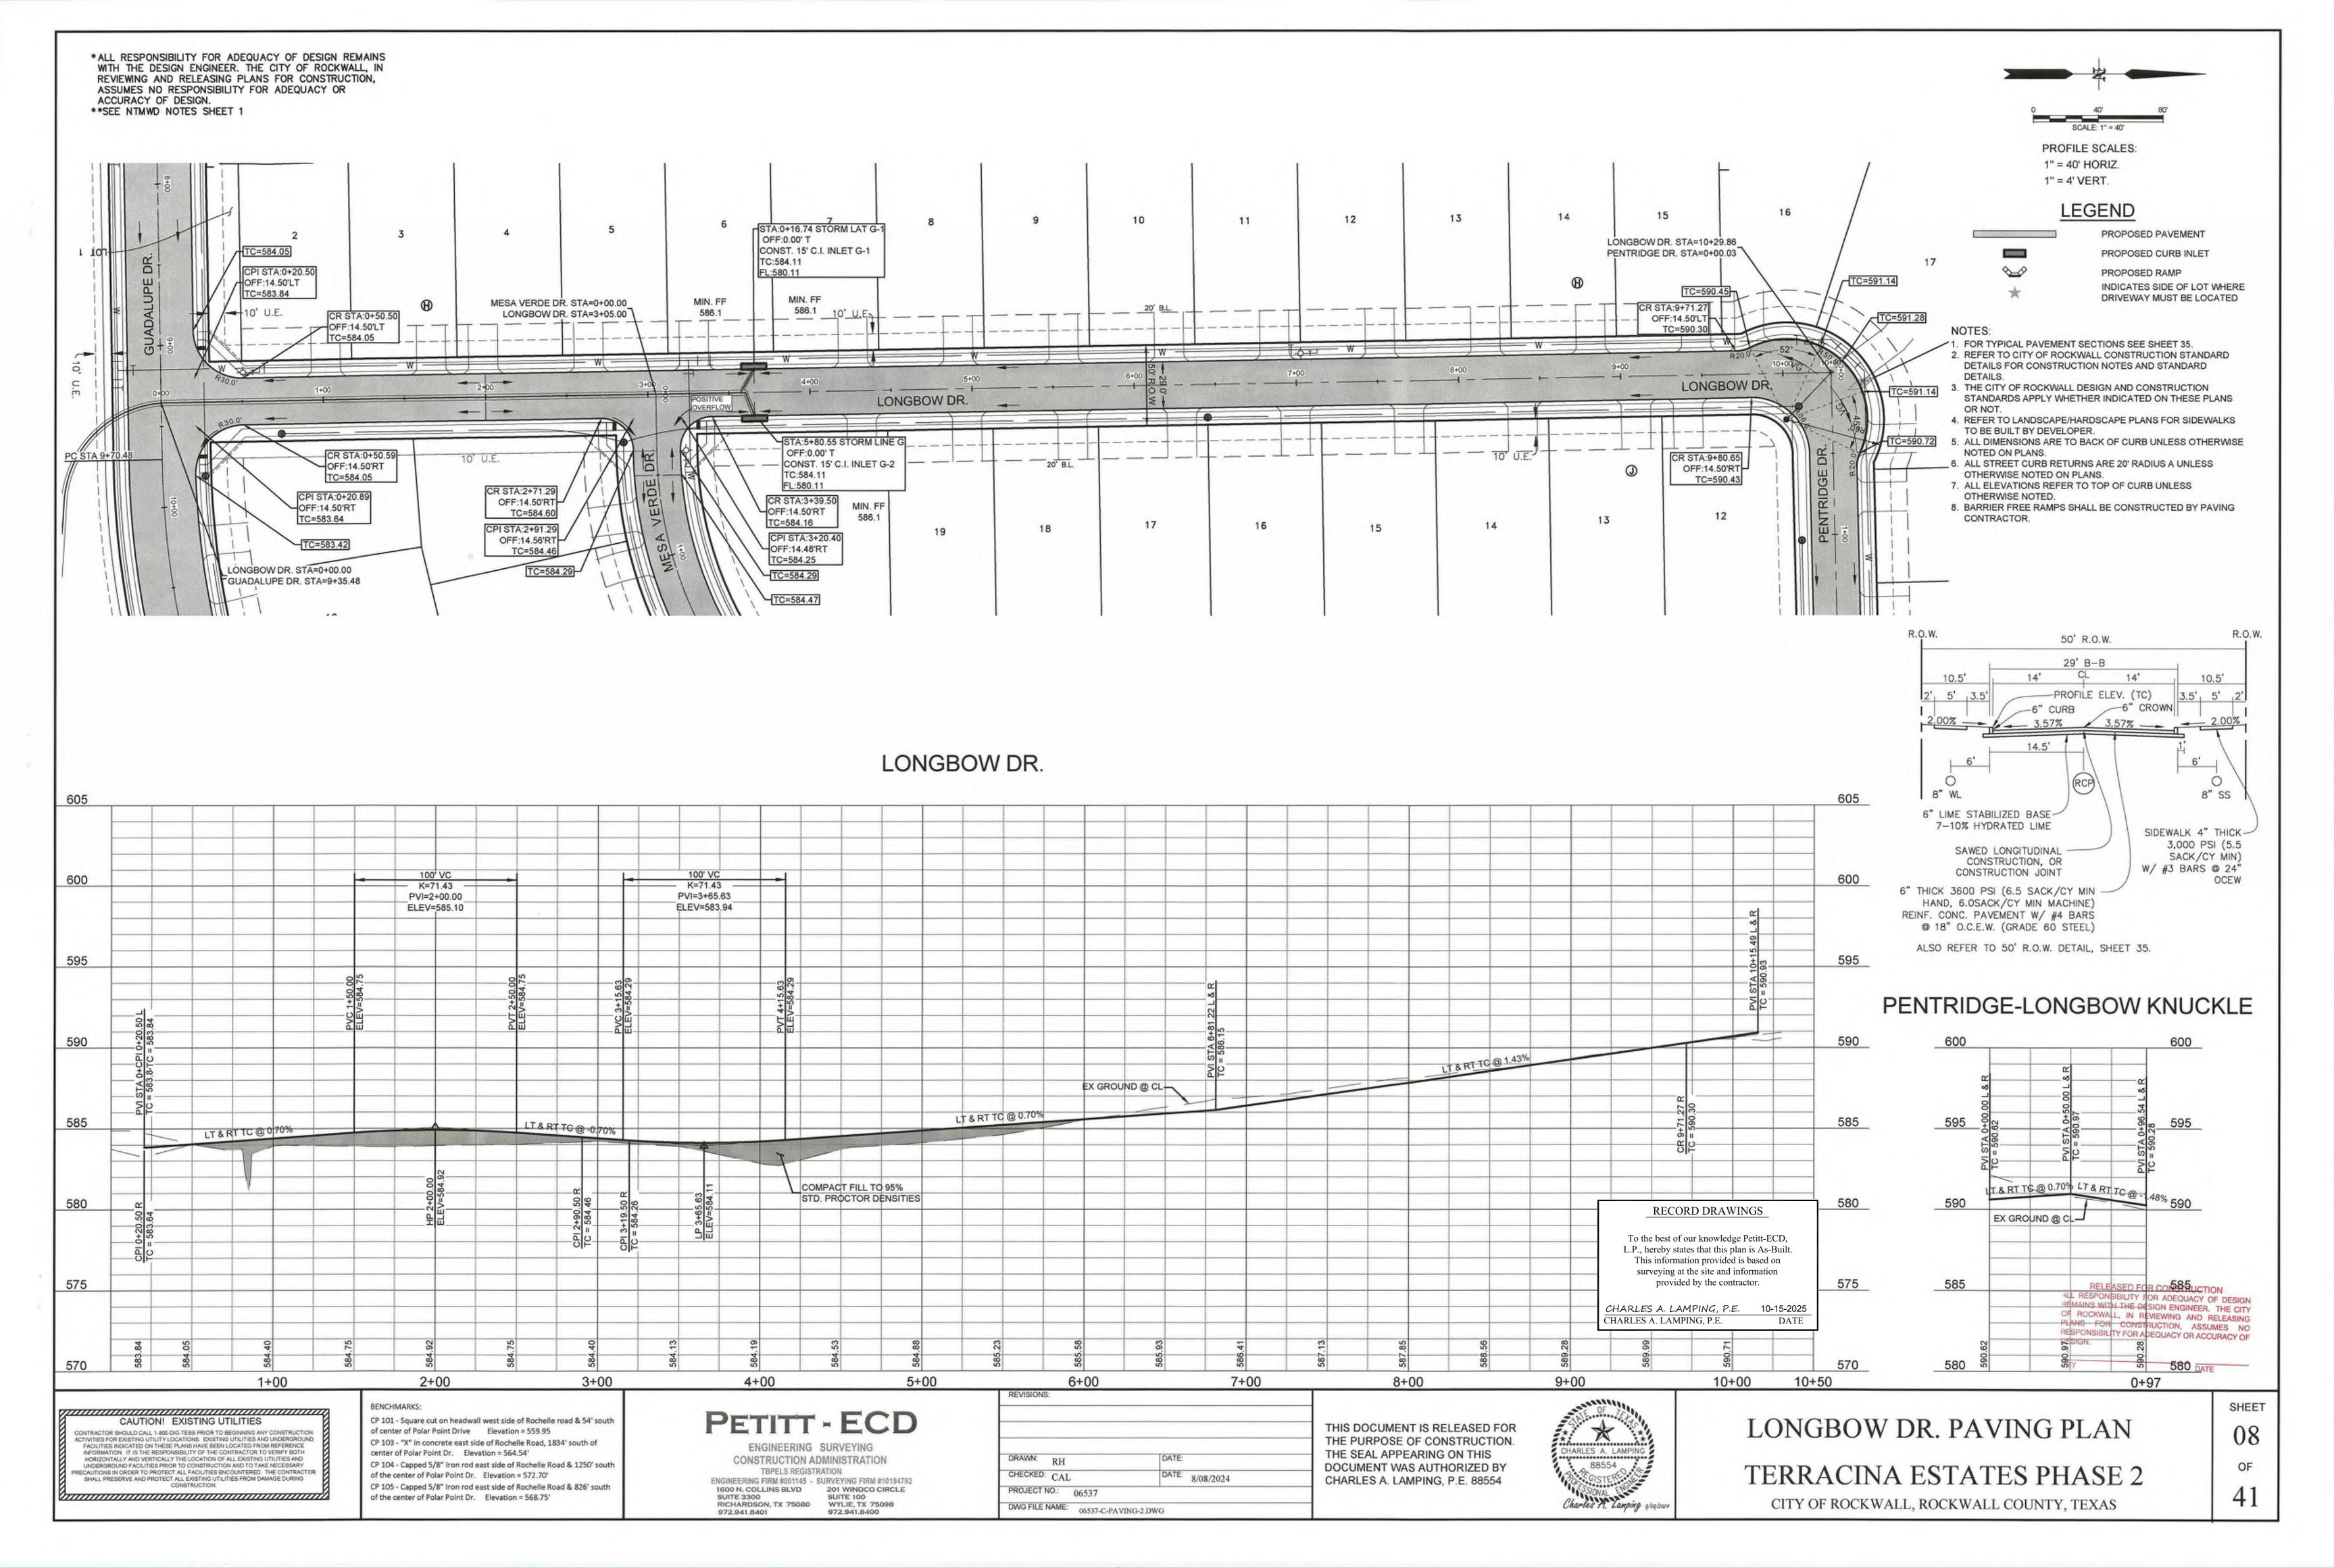


*ALL RESPONSIBILITY FOR ADEQUACY OF DESIGN REMAINS WITH THE DESIGN ENGINEER. THE CITY OF ROCKWALL, IN REVIEWING AND RELEASING PLANS FOR CONSTRUCTION, ASSUMES NO RESPONSIBILITY FOR ADEQUACY OR ACCURACY OF DESIGN. **SEE NTMWD NOTES SHEET 1 19 17 SCALE: 1" = 40" PROFILE SCALES: 1" = 40' HORIZ. PC STA 0+83.06 CONN. TO EX. CURB STA:7+05.77 1" = 4' VERT. OFF:14.50'LT TC=582.18 OFF:15.40'LT TC=580.52 LEGEND GUT:580.52 CPI STA:3+72.67 MESA VERDE DR. STA=0+00.00 OFF:14.19'LT OFF:14.50'LT STA:0+15.48 STORM LAT D-5 LONGBOW DR. STA=3+05.00 CR STA:0+34.45 PROPOSED PAVEMENT TC=582.65 TC=582.85 OFF:0.00' T OFF:14.50'LT CONST. 15' C.I. INLET D-5 CR STA:3+52.85 CR STA:4+20.36 PROPOSED CURB INLET TC=584.29 TC:580.42 OFF:14.50'LT OFF:14.50'LT 582.4 GUT:579.92 PROPOSED RAMP TC=582.99 FL:576.42 INDICATES SIDE OF LOT WHERE DRIVEWAY MUST BE LOCATED MESA VERDE DR. NOTES: SEDONA DR. STA=3+05.00 MESA VERDE DR. STA=7+41.35 FOR TYPICAL PAVEMENT SECTIONS SEE SHEET 35. 2. REFER TO CITY OF ROCKWALL CONSTRUCTION STANDARD DETAILS FOR CONSTRUCTION NOTES AND STANDARD 3. THE CITY OF ROCKWALL DESIGN AND CONSTRUCTION STANDARDS APPLY WHETHER INDICATED ON THESE PLANS CR STA:0+34.54 TA:0+16.75 STORM LAT D-4 OR NOT. OFF:14.50'RT OFF:0.00' T 4. REFER TO LANDSCAPE/HARDSCAPE PLANS FOR SIDEWALKS TC=584.29 TO' V.E.J. CONST. 15' C.I. INLET D-4 L=1680.94 GUT:580.26 TO BE BUILT BY DEVELOPER. CPI STA:0+14.48 TC:580.42 R=1555.01 5. ALL DIMENSIONS ARE TO BACK OF CURB UNLESS OTHERWISE R=250.00 STA:7+05.77 OFF:14.53'RT GUT:579.92 ∆=61°56'09" NOTED ON PLANS. Δ=30°59'26' REMOVE EX. BARRICADE TC=584.46 FL:576.42 ALL STREET CURB RETURNS ARE 20' RADIUS A UNLESS MESA VERDE DR. STA=3+86.61 CONST. LONGITUDINAL BUTT JOINT OTHERWISE NOTED ON PLANS. WRENWOOD CT. STA=0+00.00 TC=580.52 TC=584.60 7. ALL ELEVATIONS REFER TO TOP OF CURB UNLESS CONN. TO EX. CURB STA:7+05.77 OTHERWISE NOTED. OFF:14.50'RT MIN. FF 8. BARRIER FREE RAMPS SHALL BE CONSTRUCTED BY PAVING TC=580.52 582.4 CONTRACTOR. MIN. FF 582.4 REFER TO 50' R.O.W. MESA VERDE DRIVE DETAIL, SHEET 08. 595 K=30.00 PVI=0+50.00 ELEV=584.71 590 - K=40.11 PVI=6+08.00 PVI=6+71.00 ELEV=580.33 ELEV=580.76 585 585 L & RT C @ -1.3 1.51% LT & RT TC @ -0.70% EX. LT. TC LT & RT TC @ 0.70% 580 LT & RT TC @ -0.70% LEX GROUND @ CL COMPACT FILL TO 95% RECORD DRAWINGS @ -1.66% STD. PROCTOR DENSITIES To the best of our knowledge Petitt-ECD, 575 L.P., hereby states that this plan is As-Built. 575 This information provided is based on surveying at the site and information provided by the contractor. CHARLES A. LAMPING, P.E. 10-15-2025 CHARLES A. LAMPING, P.E. DATE 570 570 RELEASED FOR CONSTRUCTION


A RESPONSIBILITY FOR ADEQUACY OF DESIGN EMAINS WITH THE DESIGN ENGINEER. THE CITY OF ROCKWALL, IN REVIEWING AND RELEASING PLANS FOR CONSTRUCTION, ASSUMES NO RESPONSIBILITY FOR ADEQUACY OR ACCURACY OF 565 2+00 3+00 4+00 5+00 6+00 7+00 7+25 0+00 1+00 REVISIONS: SHEET MESA VERDE DR PAVING PLAN 0+00 TO BENCHMARKS: PETITT - ECD CP 101 - Square cut on headwall west side of Rochelle road & 54' south CAUTION! EXISTING UTILITIES * * THIS DOCUMENT IS RELEASED FOR CONTRACTOR SHOULD CALL 1-800-DIG-TESS PRIOR TO BEGINNING ANY CONSTRUCTION ACTIVITIES FOR EXISTING UTILITY LOCATIONS. EXISTING UTILITIES AND UNDERGROUND FACILITIES INDICATED ON THESE PLANS HAVE BEEN LOCATED FROM REFERENCE INFORMATION. IT IS THE RESPONSIBILITY OF THE CONTRACTOR TO VERIFY BOTH HORIZONTALLY AND VERTICALLY THE LOCATION OF ALL EXISTING UTILITIES AND UNDERGROUND FACILITIES PRIOR TO CONSTRUCTION AND TO TAKE NECESSARY of center of Polar Point Drive Elevation = 559.95 7+00THE PURPOSE OF CONSTRUCTION. CP 103 - "X" in concrete east side of Rochelle Road, 1834' south of ENGINEERING SURVEYING CHARLES A. LAMPING THE SEAL APPEARING ON THIS center of Polar Point Dr. Elevation = 564.54' DRAWN: RH CONSTRUCTION ADMINISTRATION CP 104 - Capped 5/8" Iron rod east side of Rochelle Road & 1250' south 88554 OF DOCUMENT WAS AUTHORIZED BY TERRACINA ESTATES PHASE 2 CHECKED: CAL TBPELS REGISTRATION DATE: 8/08/2024 ECAUTIONS IN ORDER TO PROTECT ALL FACILITIES ENCOUNTERED. THE CONTRACTOR SHALL PRESERVE AND PROTECT ALL EXISTING UTILITIES FROM DAMAGE DURING CONSTRUCTION. of the center of Polar Point Dr. Elevation = 572.70' CHARLES A. LAMPING, P.E. 88554 ENGINEERING FIRM #001145 - SURVEYING FIRM #10194792 CP 105 - Capped 5/8" Iron rod east side of Rochelle Road & 826' south PROJECT NO.: 06537 1600 N. COLLINS BLVD 201 WINDCO CIRCLE SUITE 100 WYLIE, TX 75098 of the center of Polar Point Dr. Elevation = 568.75' SUITE 3300 CITY OF ROCKWALL, ROCKWALL COUNTY, TEXAS DWG FILE NAME: 06537-C-PAVING-2.DWG RICHARDSON, TX 75080 972.941.8401

*ALL RESPONSIBILITY FOR ADEQUACY OF DESIGN REMAINS WITH THE DESIGN ENGINEER. THE CITY OF ROCKWALL, IN REVIEWING AND RELEASING PLANS FOR CONSTRUCTION, ASSUMES NO RESPONSIBILITY FOR ADEQUACY OR ACCURACY OF DESIGN.

**SEE NTMWD NOTES SHEET 1

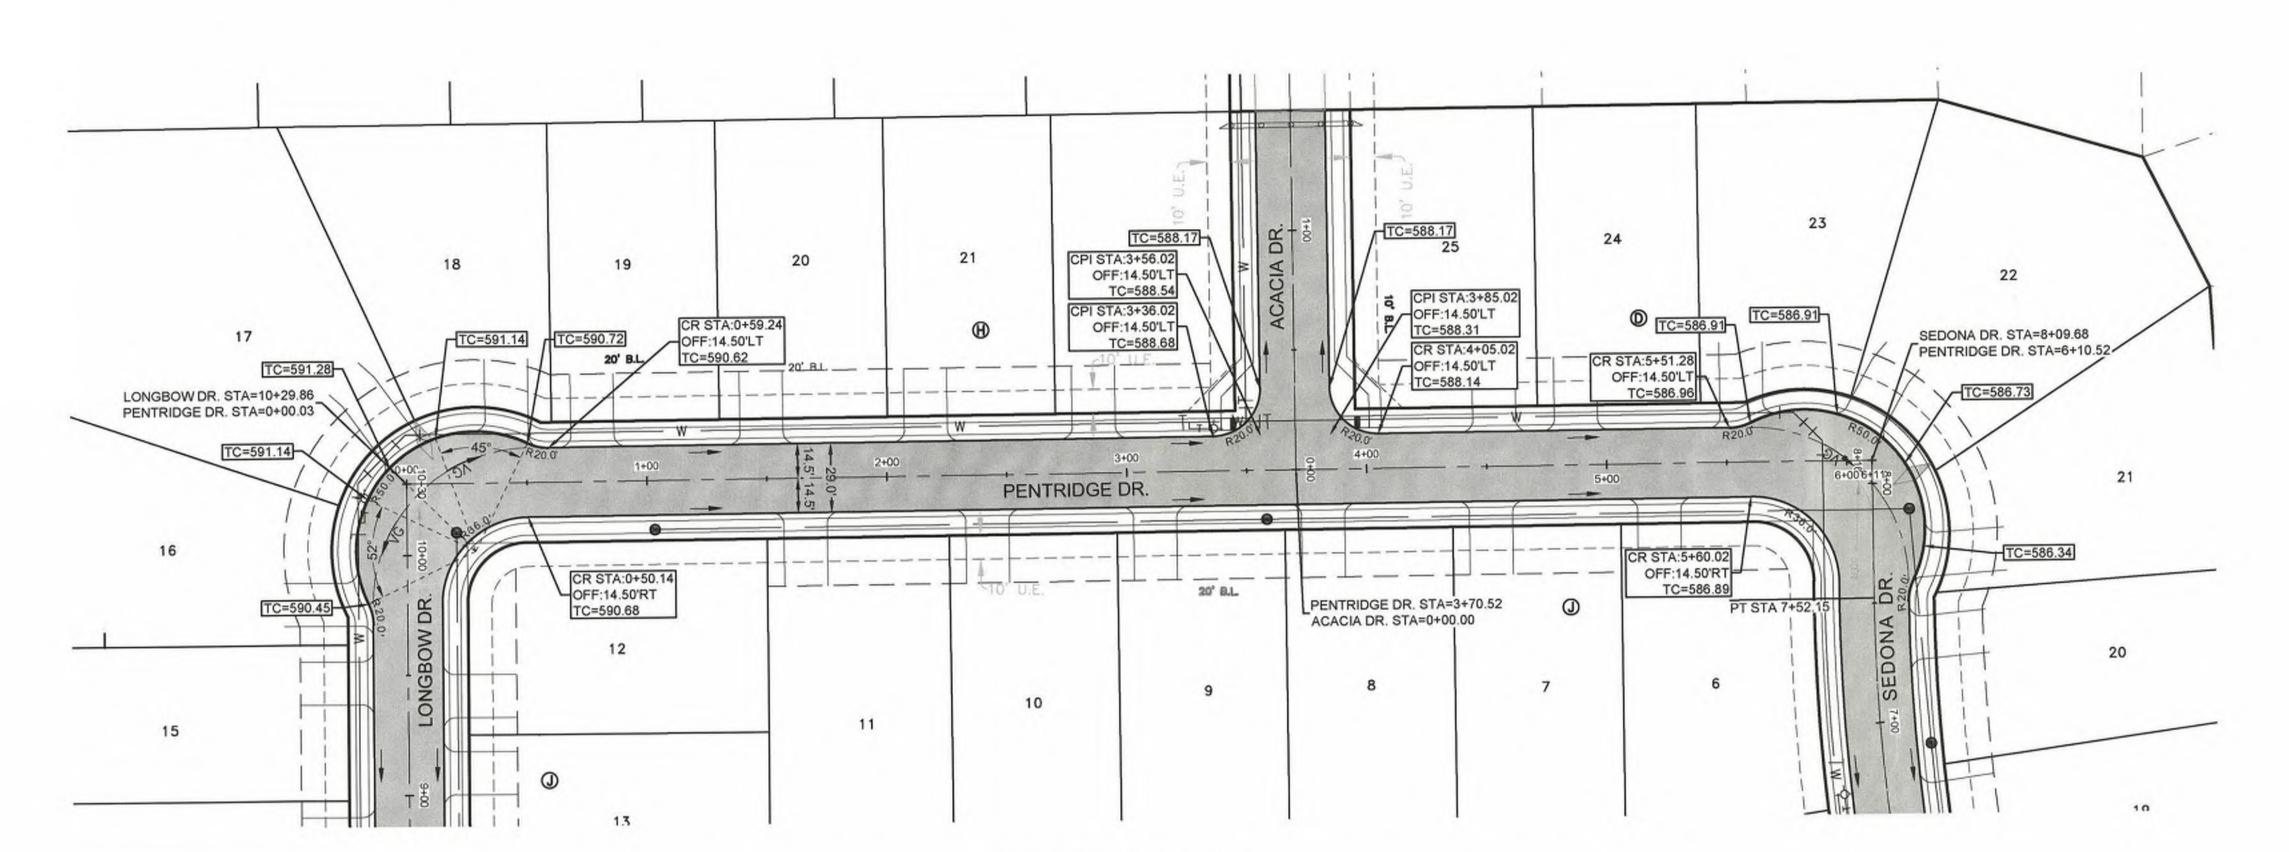

PENTRIDGE DR.

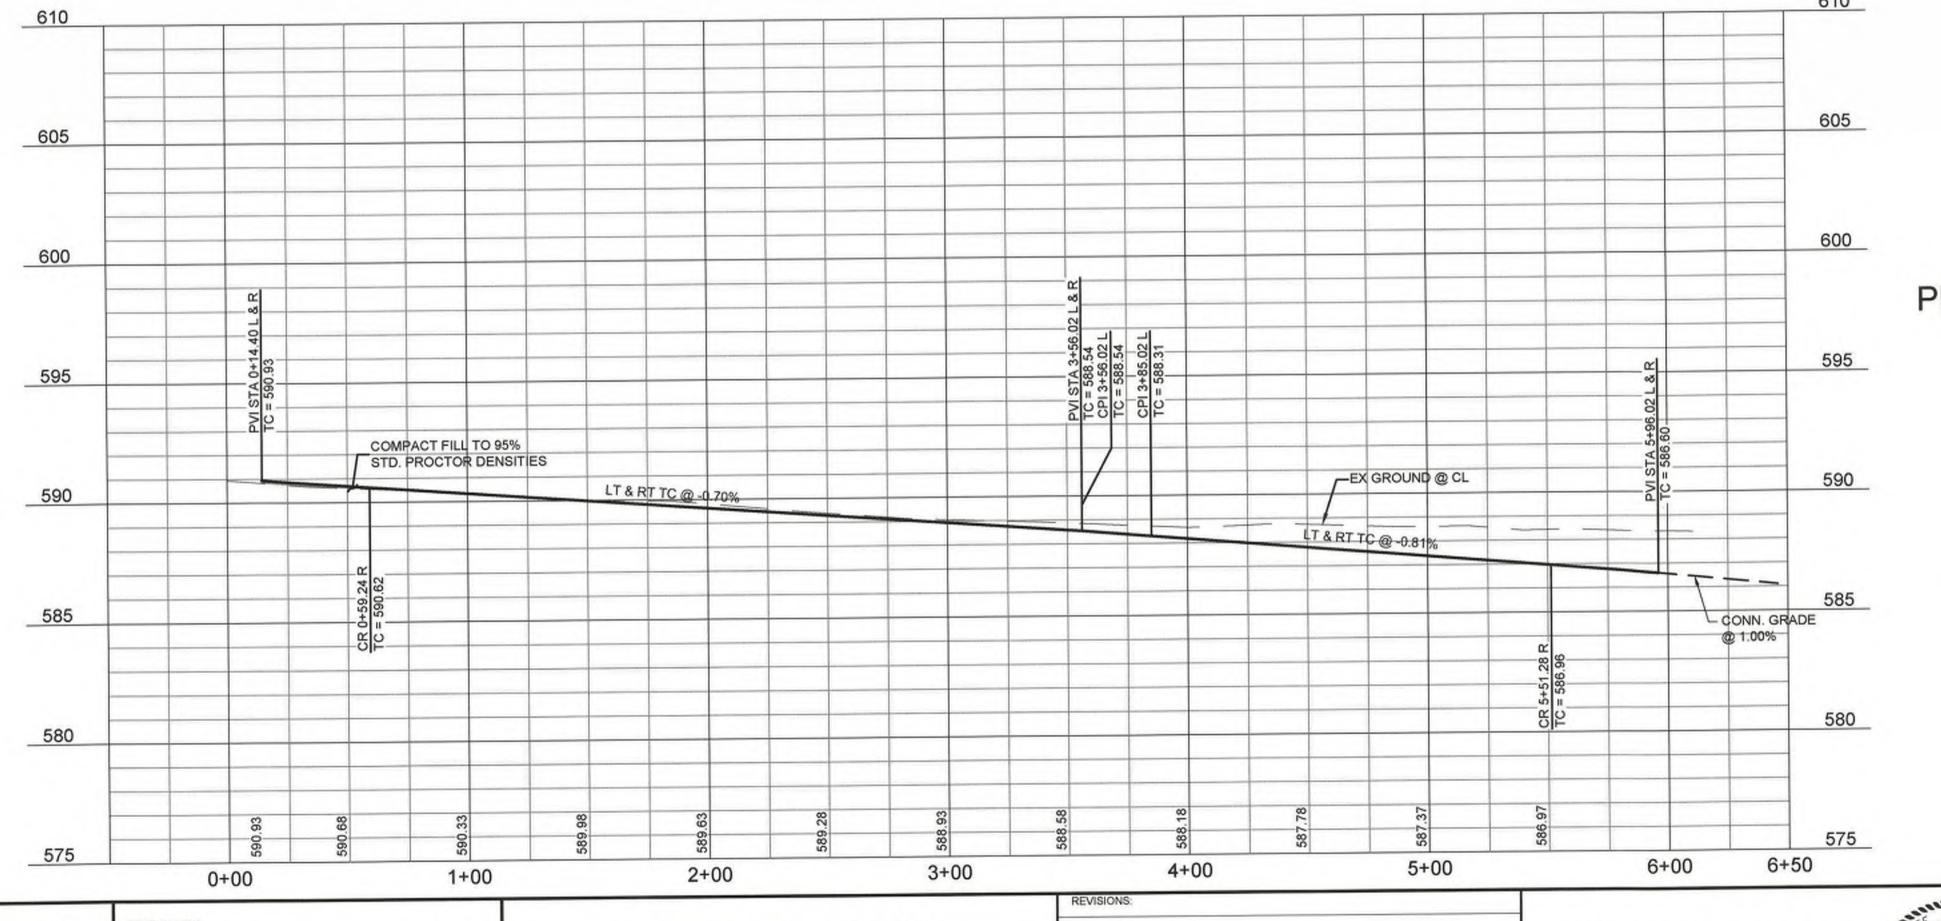

0 40' 8X SCALE: 1" = 40' PROFILE SCALES: 1" = 40' HORIZ. 1" = 4' VERT.

LEGEND

□

PROPOSED CURB INLET

PROPOSED PAVEMENT

PROPOSED RAMP
INDICATES SIDE OF LOT WHERE
DRIVEWAY MUST BE LOCATED


NOTES:

- 1. FOR TYPICAL PAVEMENT SECTIONS SEE SHEET 35.
- REFER TO CITY OF ROCKWALL CONSTRUCTION STANDARD
 DETAILS FOR CONSTRUCTION NOTES AND STANDARD
- THE CITY OF ROCKWALL DESIGN AND CONSTRUCTION STANDARDS APPLY WHETHER INDICATED ON THESE PLANS OR NOT.
- REFER TO LANDSCAPE/HARDSCAPE PLANS FOR SIDEWALKS TO BE BUILT BY DEVELOPER.
- ALL DIMENSIONS ARE TO BACK OF CURB UNLESS OTHERWISE NOTED ON PLANS.
- 6. ALL STREET CURB RETURNS ARE 20' RADIUS A UNLESS
- OTHERWISE NOTED ON PLANS.
- ALL ELEVATIONS REFER TO TOP OF CURB UNLESS OTHERWISE NOTED.

 BARRIER FREE RAMPS SHALL BE CONSTRUCTED BY PAVING CONTRACTOR.

REFER TO 50' R.O.W. DETAIL, SHEET 08.

PENTRIDGE-SEDONA KNUCKLE

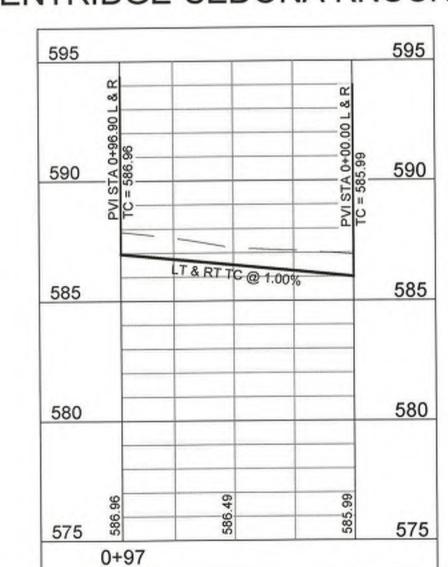

RECORD DRAWINGS

To the best of our knowledge Petitt-ECD, L.P., hereby states that this plan is As-Built. This information provided is based on surveying at the site and information provided by the contractor.

CHARLES A. LAMPING, P.E.10-15-2025CHARLES A. LAMPING, P.E.DATE

RELEASED FOR CONSTRUCTION

LL RESPONSIBILITY FOR ADEQUACY OF DESIGN
REMAINS WITH THE DESIGN ENGINEER. THE CITY
OF ROCKWALL, IN REVIEWING AND RELEASING
PLANS FOR CONSTRUCTION, ASSUMES NO
RESPONSIBILITY FOR ADEQUACY OR ACCURACY OF
DESIGN.

CAUTION! EXISTING UTILITIES

CONTRACTOR SHOULD CALL 1-800-DIG-TESS PRIOR TO BEGINNING ANY CONSTRUCTION ACTIVITIES FOR EXISTING UTILITY LOCATIONS. EXISTING UTILITIES AND UNDERGROUND FACILITIES INDICATED ON THIESE PLANS HAVE BEEN LOCATED FROM REFERENCE INFORMATION. IT IS THE RESPONSIBILITY OF THE CONTRACTOR TO VERRIFY BOTH HORIZONTALLY AND VIRTICALLY THE LOCATION OF ALL EXISTING UTILITIES AND UNDERGROUND FACILITIES PRIOR TO CONSTRUCTION AND TO TAKE NECESSARY PRECAUTIONS IN ORDER TO PROTECT ALL FACILITIES ENCOUNTERED. THE CONTRACTOR SHALL PRESERVE AND PROTECT ALL EXISTING UTILITIES FROM DAMAGE DURING CONSTRUCTION.

BENCHMARKS:

CP 101 - Square cut on headwall west side of Rochelle road & 54' south of center of Polar Point Drive Elevation = 559.95

CP 103 - "X" in concrete east side of Rochelle Road, 1834' south of

CP 103 - "X" in concrete east side of Rochelle Road, 1834' south of center of Polar Point Dr. Elevation = 564.54'

CP 104 - Capped 5/8" Iron rod east side of Rochelle Road & 1250' south of the center of Polar Point Dr. Elevation = 572.70'

CP 105 - Capped 5/8" Iron rod east side of Rochelle Road & 826' south of the center of Polar Point Dr. Elevation = 568.75'

PETITT - ECD

ENGINEERING SURVEYING
CONSTRUCTION ADMINISTRATION
TBPELS REGISTRATION
ENGINEERING FIRM #001145 - SURVEYING FIRM #10194792
1600 N. COLLINS BLVD
SUITE 3300
RICHARDSON, TX 75080
ENGINEERING SURVEYING FIRM #10194792
201 WINDCO CIRCLE
SUITE 100
WYLIE, TX 75098

DRAWN: RH

CHECKED: CAL

PROJECT NO.: 06537

DWG FILE NAME: 06537-C-PAVING-2.DWG


THIS DOCUMENT IS RELEASED FOR THE PURPOSE OF CONSTRUCTION. THE SEAL APPEARING ON THIS DOCUMENT WAS AUTHORIZED BY CHARLES A. LAMPING, P.E. 88554



PENTRIDGE DR. PAVING PLAN


TERRACINA ESTATES PHASE 2
CITY OF ROCKWALL, ROCKWALL COUNTY, TEXAS

10 of

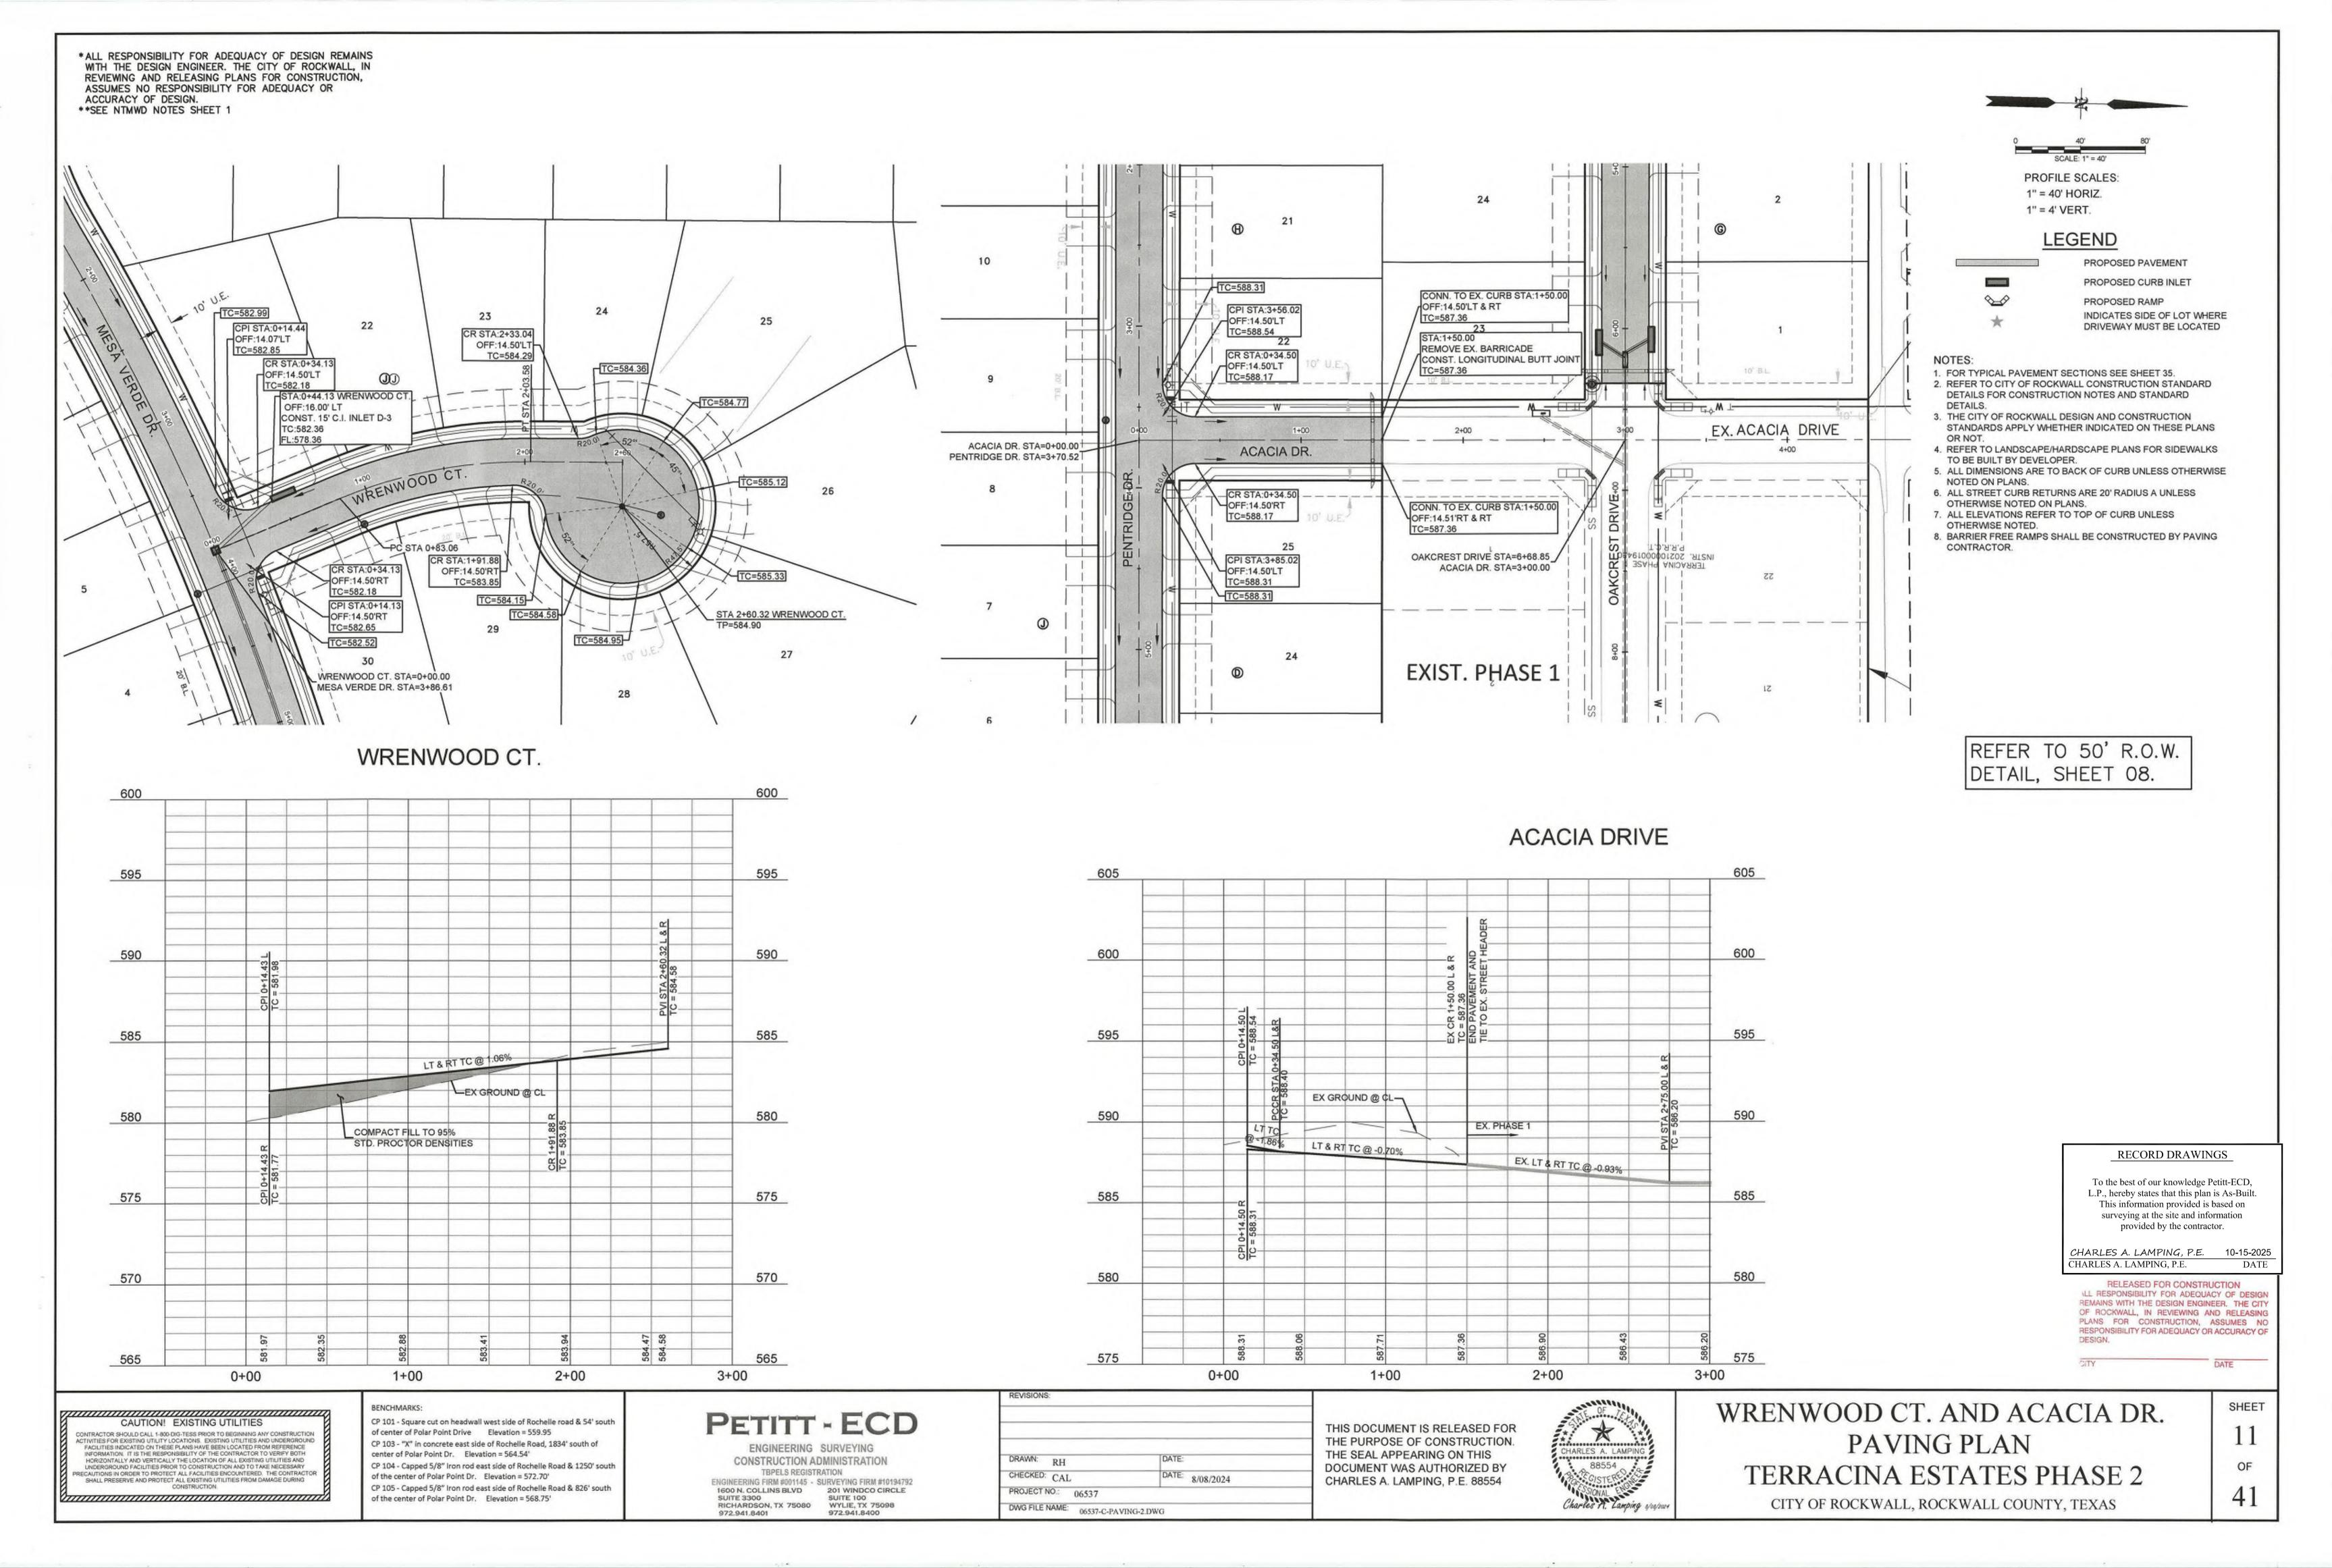



*ALL RESPONSIBILITY FOR ADEQUACY OF DESIGN REMAINS WITH THE DESIGN ENGINEER. THE CITY OF ROCKWALL, IN REVIEWING AND RELEASING PLANS FOR CONSTRUCTION, ASSUMES NO RESPONSIBILITY FOR ADEQUACY OR ACCURACY OF DESIGN.

**SEE NTMWD NOTES SHEET 1

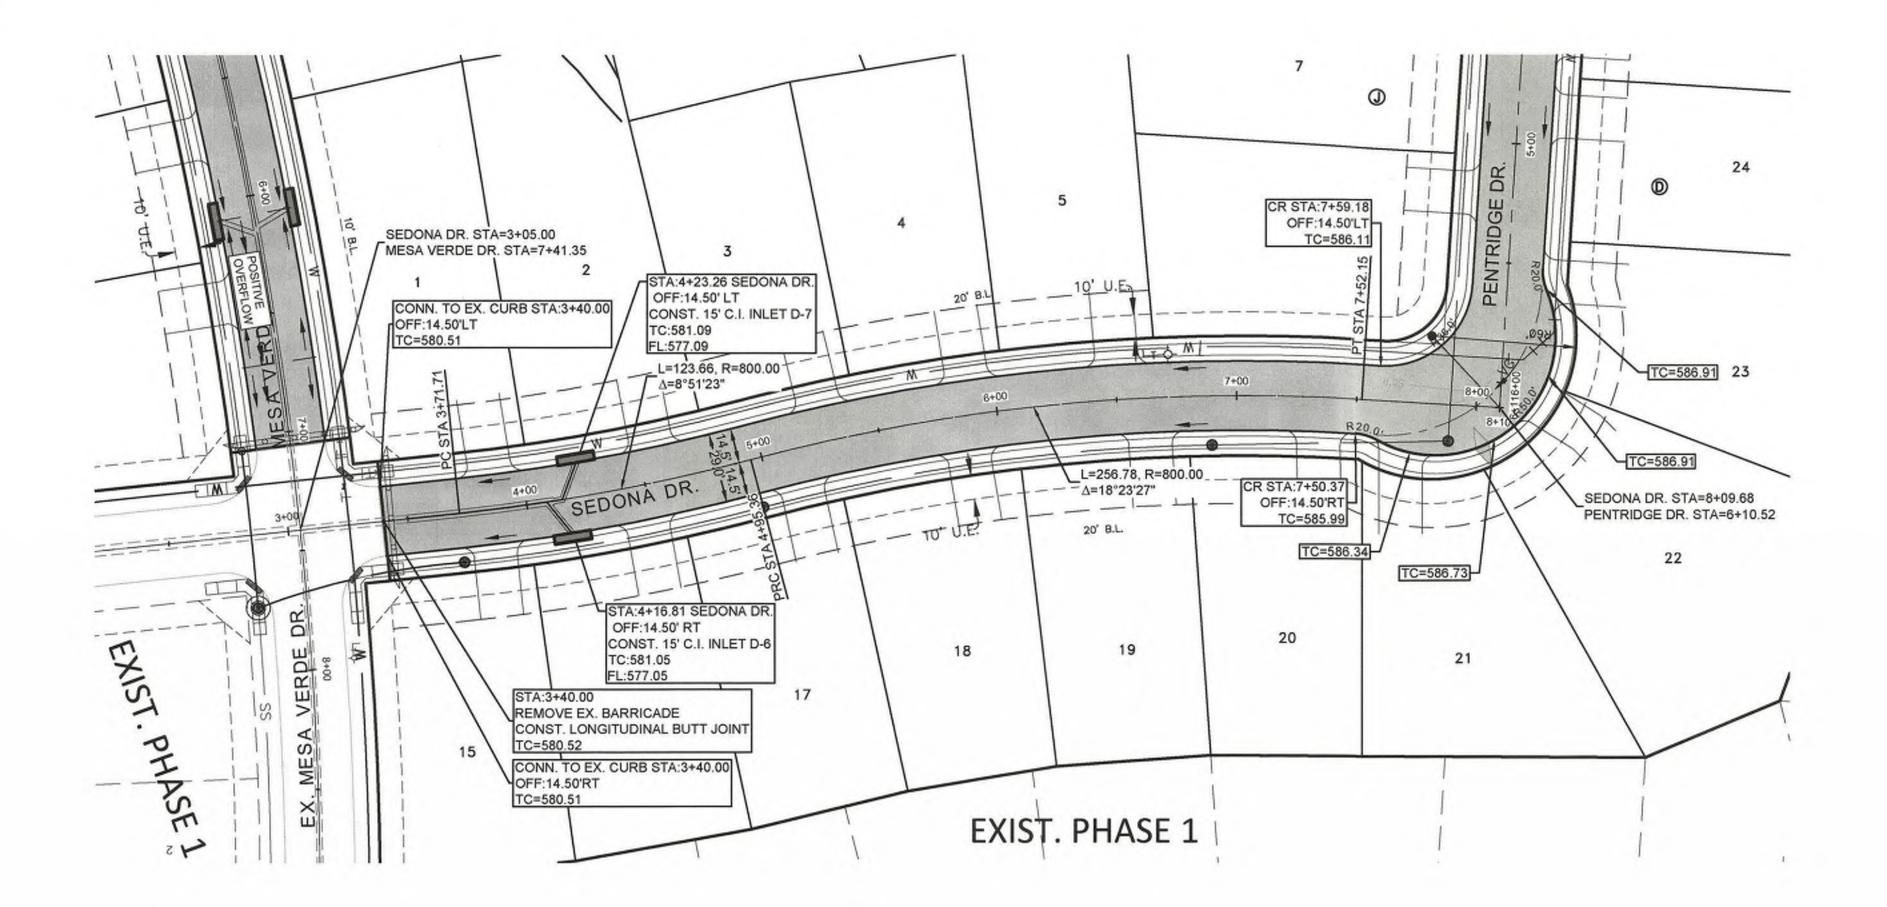



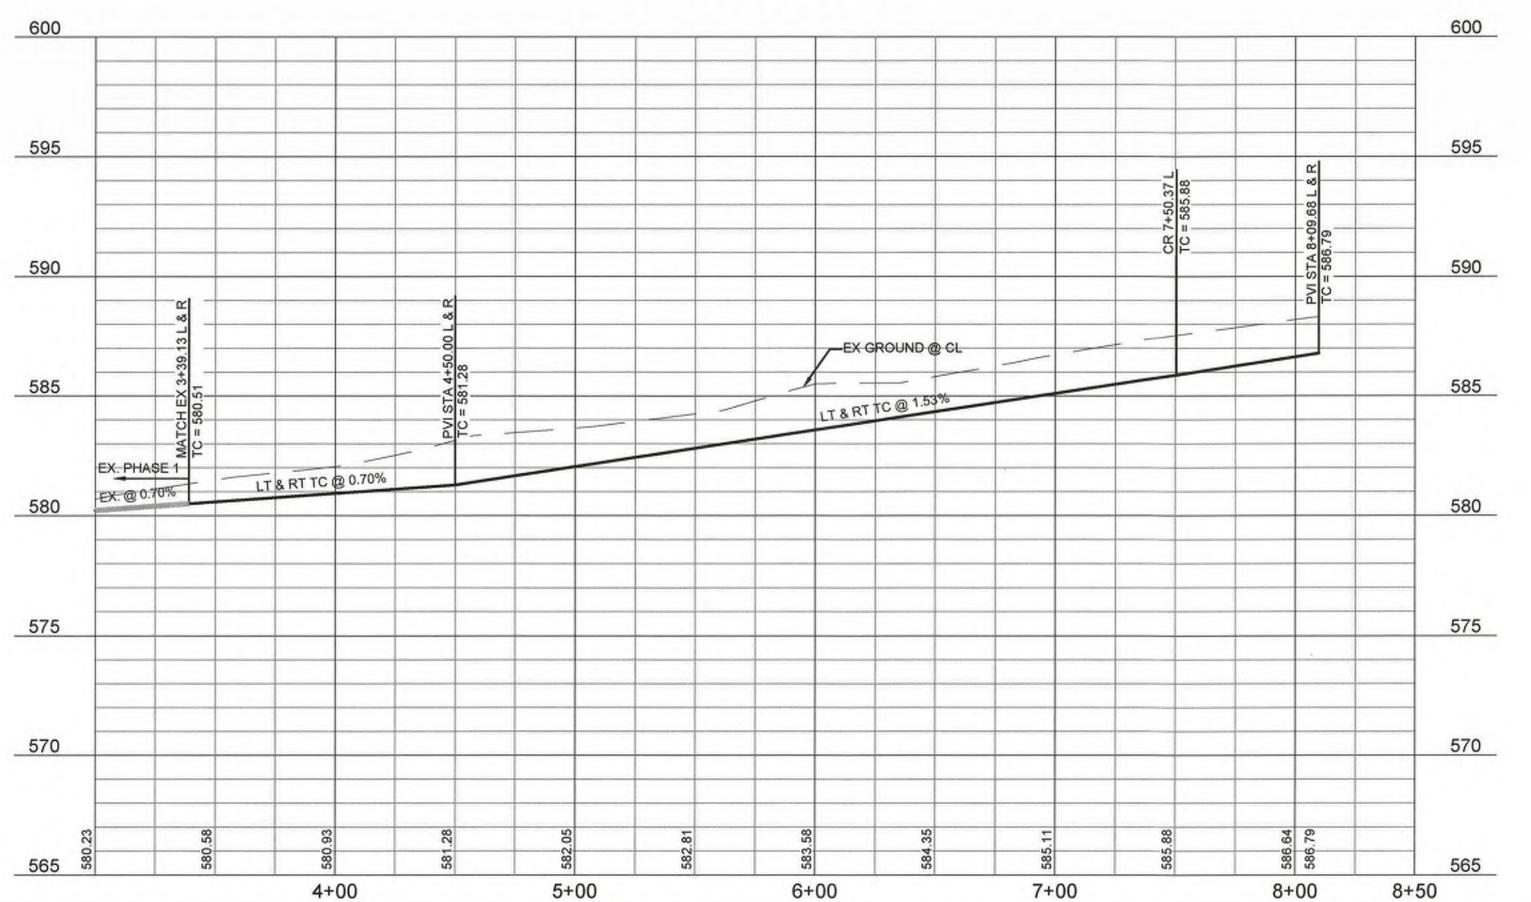

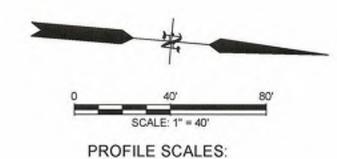

1" = 4' VERT.

LEGEND

1" = 40' HORIZ.

-

PROPOSED PAVEMENT

PROPOSED CURB INLET
PROPOSED RAMP

INDICATES SIDE OF LOT WHERE DRIVEWAY MUST BE LOCATED

NOTES:

1. FOR TYPICAL PAVEMENT SECTIONS SEE SHEET 35.

- REFER TO CITY OF ROCKWALL CONSTRUCTION STANDARD DETAILS FOR CONSTRUCTION NOTES AND STANDARD DETAILS.
- THE CITY OF ROCKWALL DESIGN AND CONSTRUCTION STANDARDS APPLY WHETHER INDICATED ON THESE PLANS OR NOT.
- REFER TO LANDSCAPE/HARDSCAPE PLANS FOR SIDEWALKS TO BE BUILT BY DEVELOPER.
 ALL DIMENSIONS ARE TO BACK OF CURB UNLESS OTHERWISE
- NOTED ON PLANS.

 6. ALL STREET CURB RETURNS ARE 20' RADIUS A UNLESS
- OTHERWISE NOTED ON PLANS.

 7. ALL ELEVATIONS REFER TO TOP OF CURB UNLESS
- ALL ELEVATIONS REFER TO TOP OF CURB UNLESS OTHERWISE NOTED.
- BARRIER FREE RAMPS SHALL BE CONSTRUCTED BY PAVING CONTRACTOR.

REFER TO 50' R.O.W. DETAIL, SHEET 08.

RECORD DRAWINGS

To the best of our knowledge Petitt-ECD, L.P., hereby states that this plan is As-Built. This information provided is based on surveying at the site and information provided by the contractor.

CHARLES A. LAMPING, P.E. 10-15-2025 CHARLES A. LAMPING, P.E. DATE

RELEASED FOR CONSTRUCTION
*LL RESPONSIBILITY FOR ADEQUACY OF DESIGN
REMAINS WITH THE DESIGN ENGINEER. THE CITY
OF ROCKWALL, IN REVIEWING AND RELEASING
PLANS FOR CONSTRUCTION, ASSUMES NO
RESPONSIBILITY FOR ADEQUACY OR ACCURACY OF

DATE

CAUTION! EXISTING UTILITIES

CONTRACTOR SHOULD CALL 1-800-DIS-TESS PRIOR TO BEGINNING ANY CONSTRUCTION ACTIVITIES FOR EXISTING UTILITY LOCATIONS. EXISTING UTILITIES AND UNDERGROUND FACILITIES INDICATED ON THESE PLANS HAVE BEEN LOCATED FROM REFERENCE INFORMATION. IT IS THE RESPONSIBILITY OF THE CONTRACTOR TO VERHIP BOTH HORIZONTALLY AND VERTICALLY THE LOCATION OF ALL EXISTING UTILITIES AND UNDERGROUND FACILITIES PRIOR TO CONSTRUCTION AND TO TAKE NECESSARY RECAUTIONS IN ORDER TO PROTECT ALL FACILITIES ENCOUNTERED. THE CONTRACTOR SHALL PRESERVE AND PROTECT ALL EXISTING UTILITIES FROM DAMAGE DURING

BENCHMARKS:

CP 101 - Square cut on headwall west side of Rochelle road & 54' south of center of Polar Point Drive Elevation = 559.95

CP 103 - "X" in concrete east side of Rochelle Road, 1834' south of center of Polar Point Dr. Elevation = 564.54'

CP 104 - Capped 5/8" Iron rod east side of Rochelle Road & 1250' south of the center of Polar Point Dr. Elevation = 572.70'

CP 105 - Capped 5/8" Iron rod east side of Rochelle Road & 826' south

of the center of Polar Point Dr. Elevation = 568.75'

PETITT - ECD

ENGINEERING SURVEYING
CONSTRUCTION ADMINISTRATION
TBPELS REGISTRATION
ENGINEERING FIRM #001145 - SURVEYING FIRM #10194792
1600 N. COLLINS BLVD
SUITE 3300
RICHARDSON, TX 75080
972.941.8401
SURVEYING
SURVEYING FIRM #10194792
201 WINDCO CIRCLE
SUITE 100
WYLIE, TX 75098
972.941.8400
972.941.8400

DRAWN: RH CHECKED: CAL PROJECT NO.: 06537 DWG FILE NAME: 06537-C-PAVING-2.DWG

THIS DOCUMENT IS RELEASED FOR THE PURPOSE OF CONSTRUCTION. THE SEAL APPEARING ON THIS DOCUMENT WAS AUTHORIZED BY CHARLES A. LAMPING, P.E. 88554



SEDONA DR. PAVING PLAN TERRACINA ESTATES PHASE 2


CITY OF ROCKWALL, ROCKWALL COUNTY, TEXAS

12

SHEET

WITH THE DESIGN ENGINEER. THE CITY OF ROCKWALL, IN REVIEWING AND RELEASING PLANS FOR CONSTRUCTION, ASSUMES NO RESPONSIBILITY FOR ADEQUACY OR ACCURACY OF DESIGN. **SEE NTMWD NOTES SHEET 1 EXIST. ALLEY FF 597.10 INSTALL 250 SY OF 6" THICK FP 596.40 CONN. TO EX. CURB STA:6+34.35 REINFORCED 3600 PSI CONCRETE, MIN 6.5 SACK MIX OFF:14.50'LT TEMPORARY TURN-AROUND (NO CURBS) STA:10+22.98 STORM LINE A < † \$ INSTALL FULL DEPTH OFF:0.00' T CONSTRUCTION JOINT TO CONST. 15' C.I. INLET A-7 SEPARATE PERMANENT TC:586.43 AND TEMPORARY PAVING FL:582.43 END CURB STA:1+50.49 (NO CURBS) OFF:14.50'LT TC=592.12 END CURB STA:0+47.24 OFF:14.50'LT CONST. PVMT HEADER & TYPE III BARRICADE OAKCREST DRIVE END CURB STA:0+47.24 OFF:14.50'RT CONST. PVMT HEADER & OFF:0.00' T ACACIA DR. STA=3+00.00 10' U.E. TYPE III BARRICADE CONST. 15' C.I. INLET A-6 END CURB STA:1+50.49 OAKCREST DRIVE STA=6+68.85 TC=594.14 TC:586.41 OFF:14.50'RT FL:582.41 TC=592.12 STA:6+33.85 EASEMENT BY REMOVE EX. BARRICADE FP 594.45 SEPARATE INSTR. CONST. LONGITUDINAL BUTT JOINT 25 28 27 26 TC=586.18 23 INSTALL 250 SY OF 6" THICK CONN. TO EX. CURB STA:6+33.85 REINFORCED 3600 PSI OFF:14.50'RT CONCRETE, MIN 6.5 SACK MIX TC=586.18 TEMPORARY TURN-AROUND (NO CURBS) FF 595.20 FP 594.50

OAKCREST DRIVE

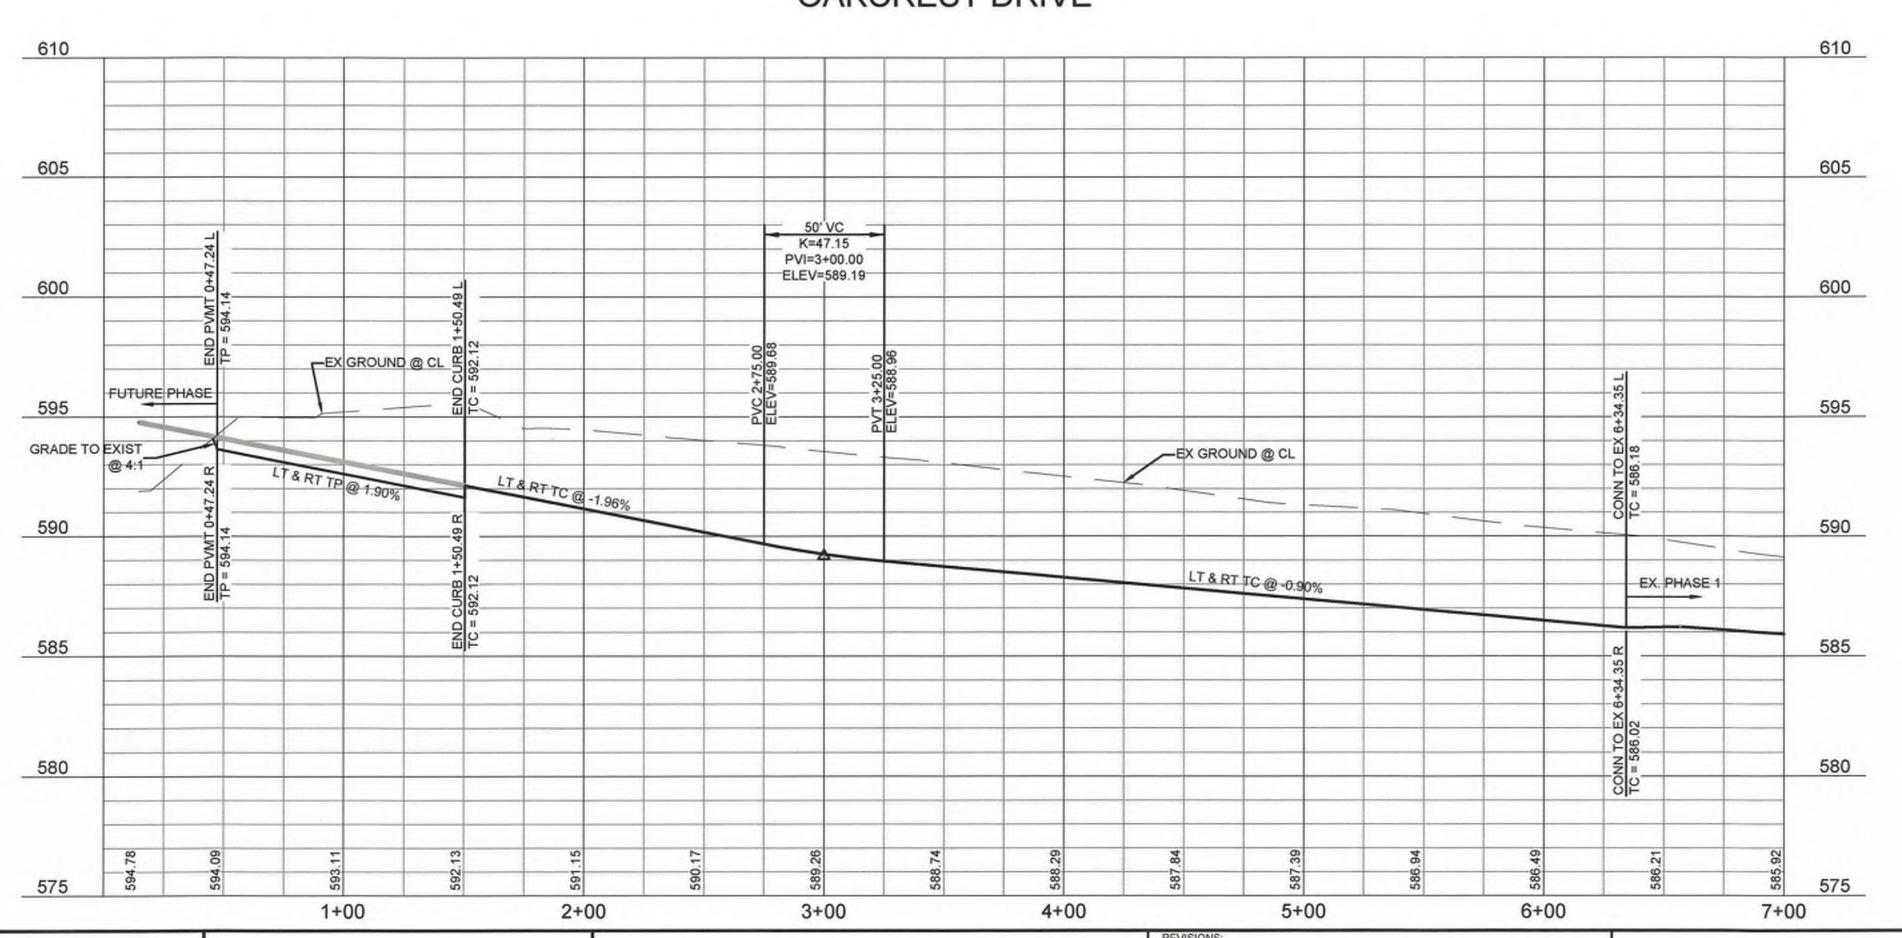



PROFILE SCALES: 1" = 40' HORIZ. 1" = 4' VERT.

LEGEND

PROPOSED PAVEMENT

PROPOSED CURB INLET PROPOSED RAMP

INDICATES SIDE OF LOT WHERE DRIVEWAY MUST BE LOCATED

NOTES:

- FOR TYPICAL PAVEMENT SECTIONS SEE SHEET 35. 2. REFER TO CITY OF ROCKWALL CONSTRUCTION STANDARD DETAILS FOR CONSTRUCTION NOTES AND STANDARD
- 3. THE CITY OF ROCKWALL DESIGN AND CONSTRUCTION STANDARDS APPLY WHETHER INDICATED ON THESE PLANS OR NOT.
- 4. REFER TO LANDSCAPE/HARDSCAPE PLANS FOR SIDEWALKS TO BE BUILT BY DEVELOPER.
- 5. ALL DIMENSIONS ARE TO BACK OF CURB UNLESS OTHERWISE NOTED ON PLANS.
- 6. ALL STREET CURB RETURNS ARE 20' RADIUS A UNLESS OTHERWISE NOTED ON PLANS.
- 7. ALL ELEVATIONS REFER TO TOP OF CURB UNLESS OTHERWISE NOTED.
- 8. BARRIER FREE RAMPS SHALL BE CONSTRUCTED BY PAVING

CONTRACTOR.

REFER TO 50' R.O.W. DETAIL, SHEET 08.

RECORD DRAWINGS

To the best of our knowledge Petitt-ECD, L.P., hereby states that this plan is As-Built. This information provided is based on surveying at the site and information provided by the contractor.

CHARLES A. LAMPING, P.E. 10-15-2025 CHARLES A. LAMPING, P.E. DATE

RELEASED FOR CONSTRUCTION ALL RESPONSIBILITY FOR ADEQUACY OF DESIGN REMAINS WITH THE DESIGN ENGINEER. THE CITY OF ROCKWALL, IN REVIEWING AND RELEASING PLANS FOR CONSTRUCTION, ASSUMES NO RESPONSIBILITY FOR ADEQUACY OR ACCURACY OF

CAUTION! EXISTING UTILITIES

- CONTRACTOR SHOULD CALL 1-800-DIG-TESS PRIOR TO BEGINNING ANY CONSTRUCTION ACTIVITIES FOR EXISTING UTILITY LOCATIONS. EXISTING UTILITIES AND UNDERGROUND FACILITIES INDICATED ON THESE PLANS HAVE BEEN LOCATED FROM REFERENCE.
- INFORMATION. IT IS THE RESPONSIBILITY OF THE CONTRACTOR TO VERIFY BOTH HORIZONTALLY AND VERTICALLY THE LOCATION OF ALL EXISTING UTILITIES AND UNDERGROUND FACILITIES PRIOR TO CONSTRUCTION AND TO TAKE NECESSARY RECAUTIONS IN ORDER TO PROTECT ALL FACILITIES ENCOUNTERED. THE CONTRACTOR SHALL PRESERVE AND PROTECT ALL EXISTING UTILITIES FROM DAMAGE DURING

CP 101 - Square cut on headwall west side of Rochelle road & 54' south of center of Polar Point Drive Elevation = 559.95 CP 103 - "X" in concrete east side of Rochelle Road, 1834' south of

BENCHMARKS:

*ALL RESPONSIBILITY FOR ADEQUACY OF DESIGN REMAINS

center of Polar Point Dr. Elevation = 564.54' CP 104 - Capped 5/8" Iron rod east side of Rochelle Road & 1250' south of the center of Polar Point Dr. Elevation = 572.70' CP 105 - Capped 5/8" Iron rod east side of Rochelle Road & 826' south of the center of Polar Point Dr. Elevation = 568.75'

PETITT - ECD

ENGINEERING SURVEYING CONSTRUCTION ADMINISTRATION TBPELS REGISTRATION ENGINEERING FIRM #001145 - SURVEYING FIRM #10194792 201 WINDCO CIRCLE 1600 N. COLLINS BLVD RICHARDSON, TX 75080 WYLIE, TX 75098 972.941.8401 972.941.8401


DRAWN: RH DATE: 8/08/2024 CHECKED: CAL PROJECT NO.: 06537 DWG FILE NAME: 06537-C-PAVING-2.DWG


THIS DOCUMENT IS RELEASED FOR THE PURPOSE OF CONSTRUCTION. THE SEAL APPEARING ON THIS DOCUMENT WAS AUTHORIZED BY CHARLES A. LAMPING, P.E. 88554





OAKCREST DR. PAVING PLAN TERRACINA ESTATES PHASE 2

CITY OF ROCKWALL, ROCKWALL COUNTY, TEXAS

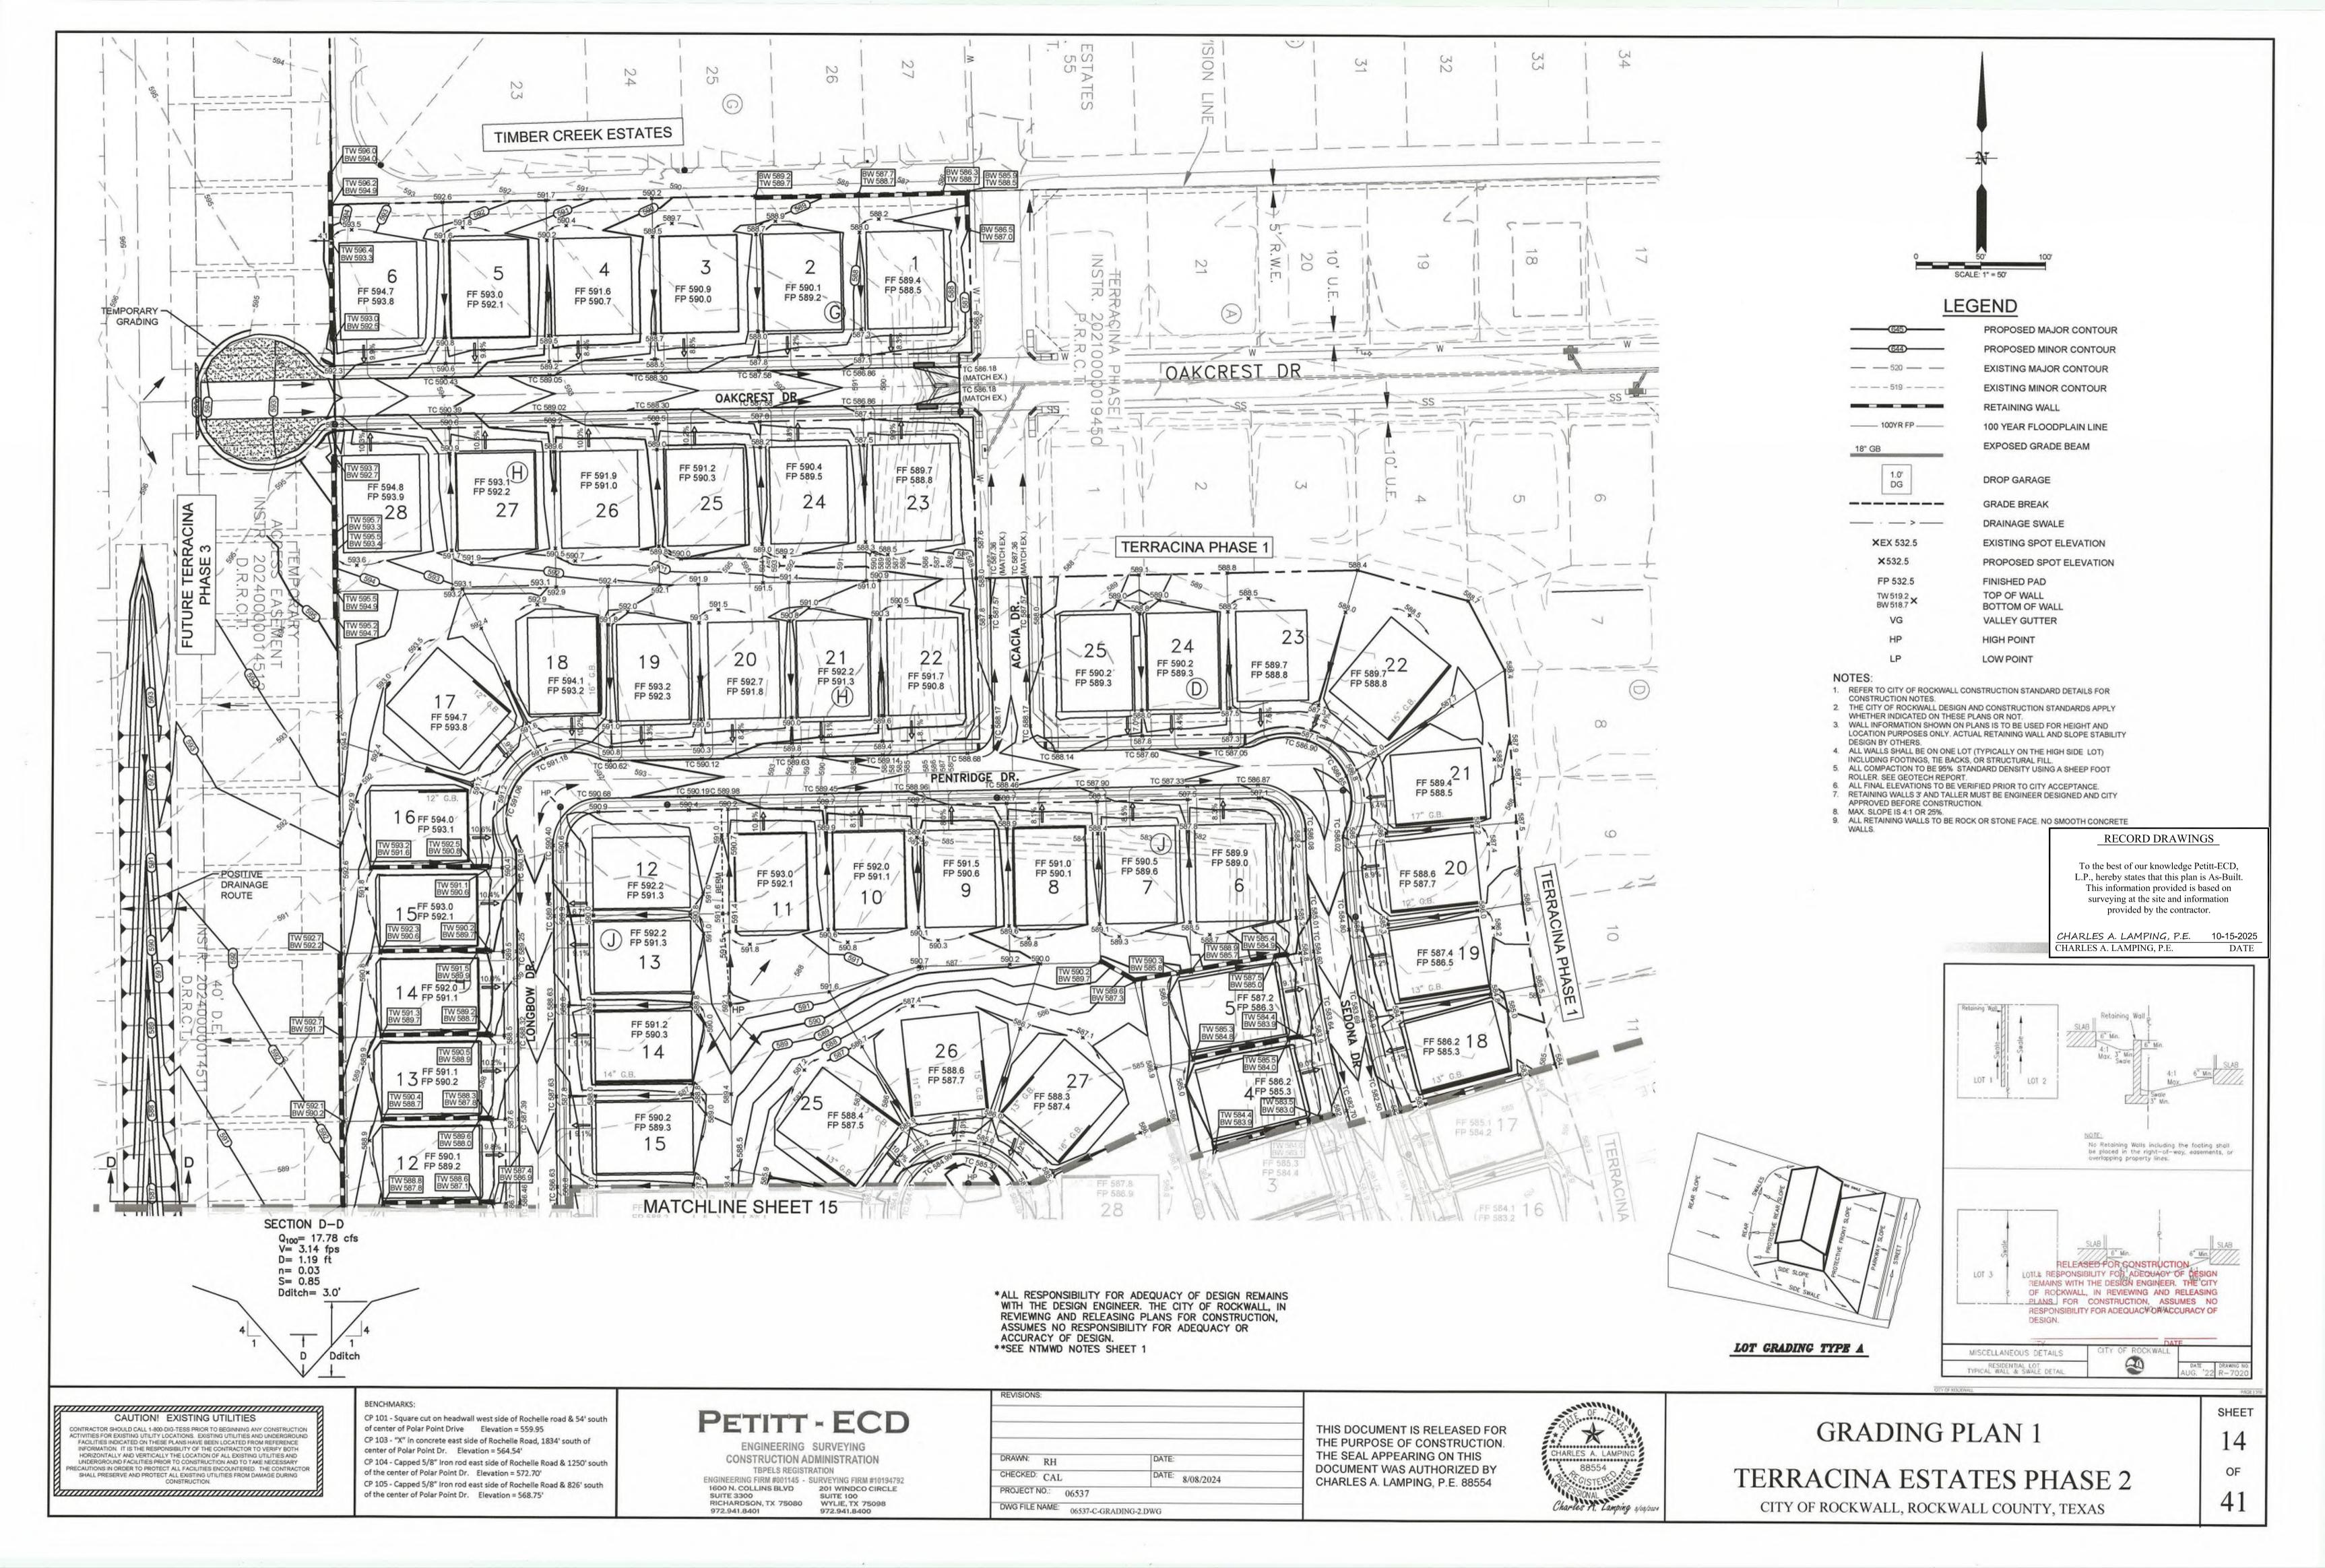

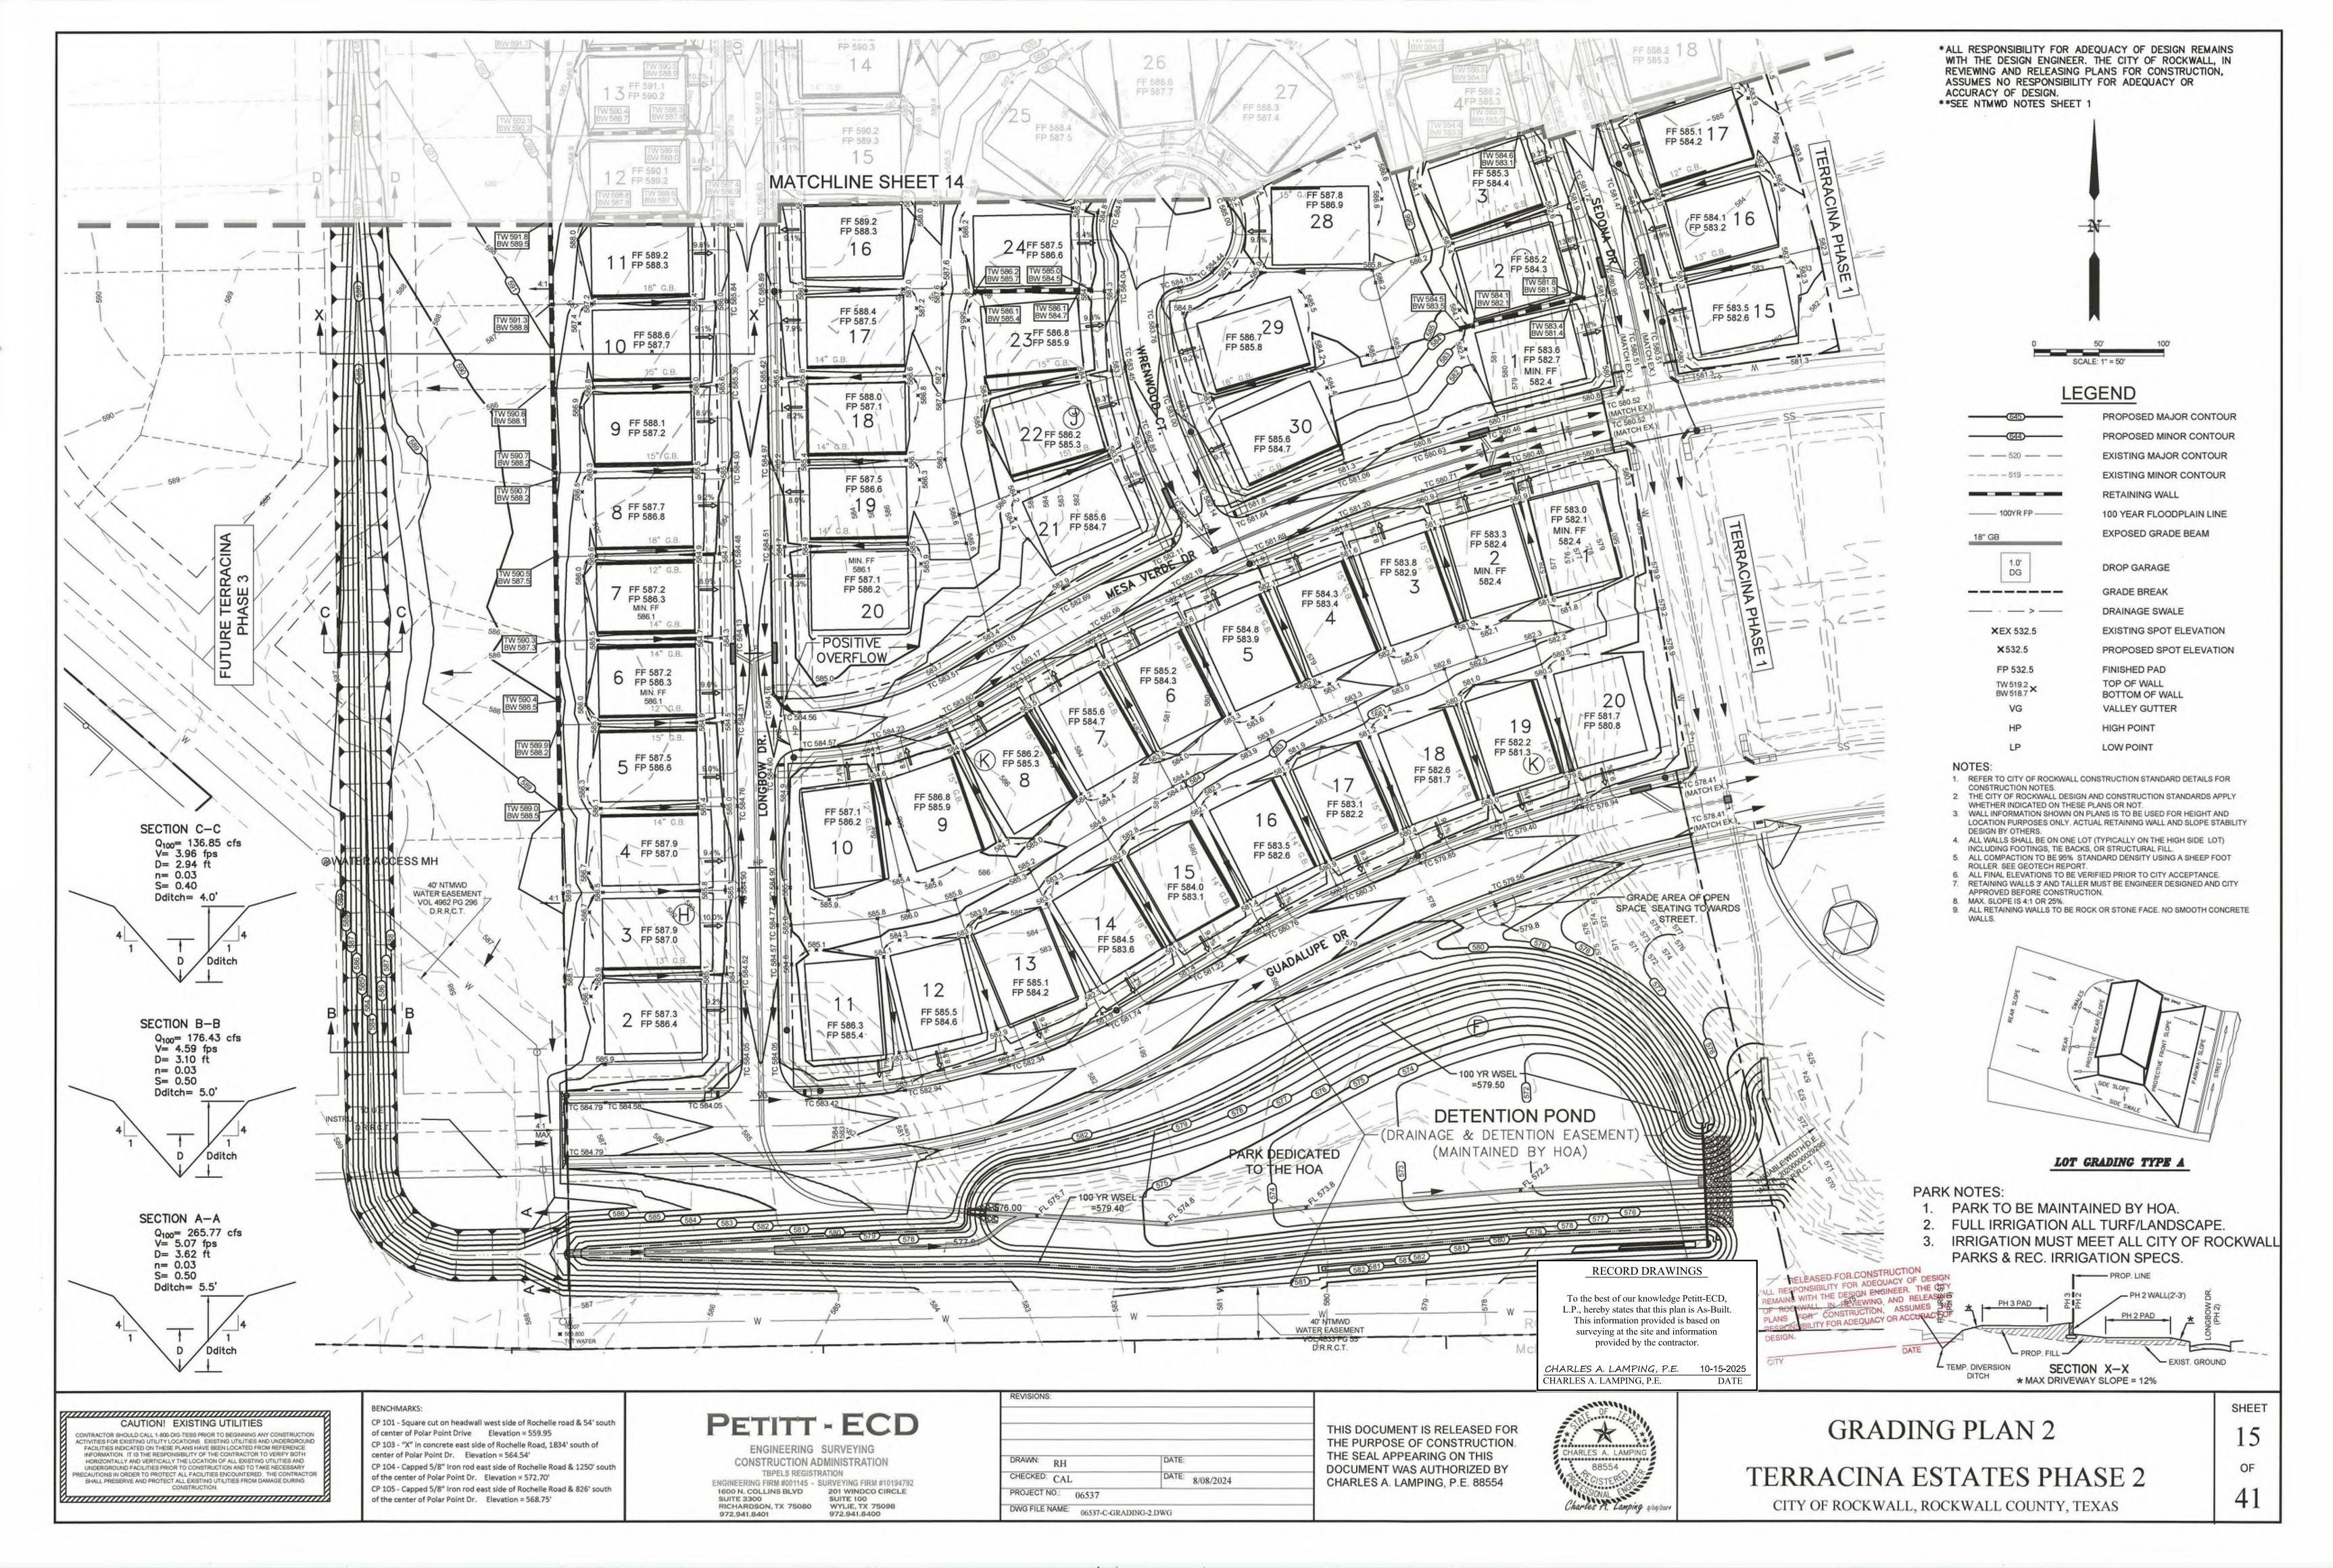

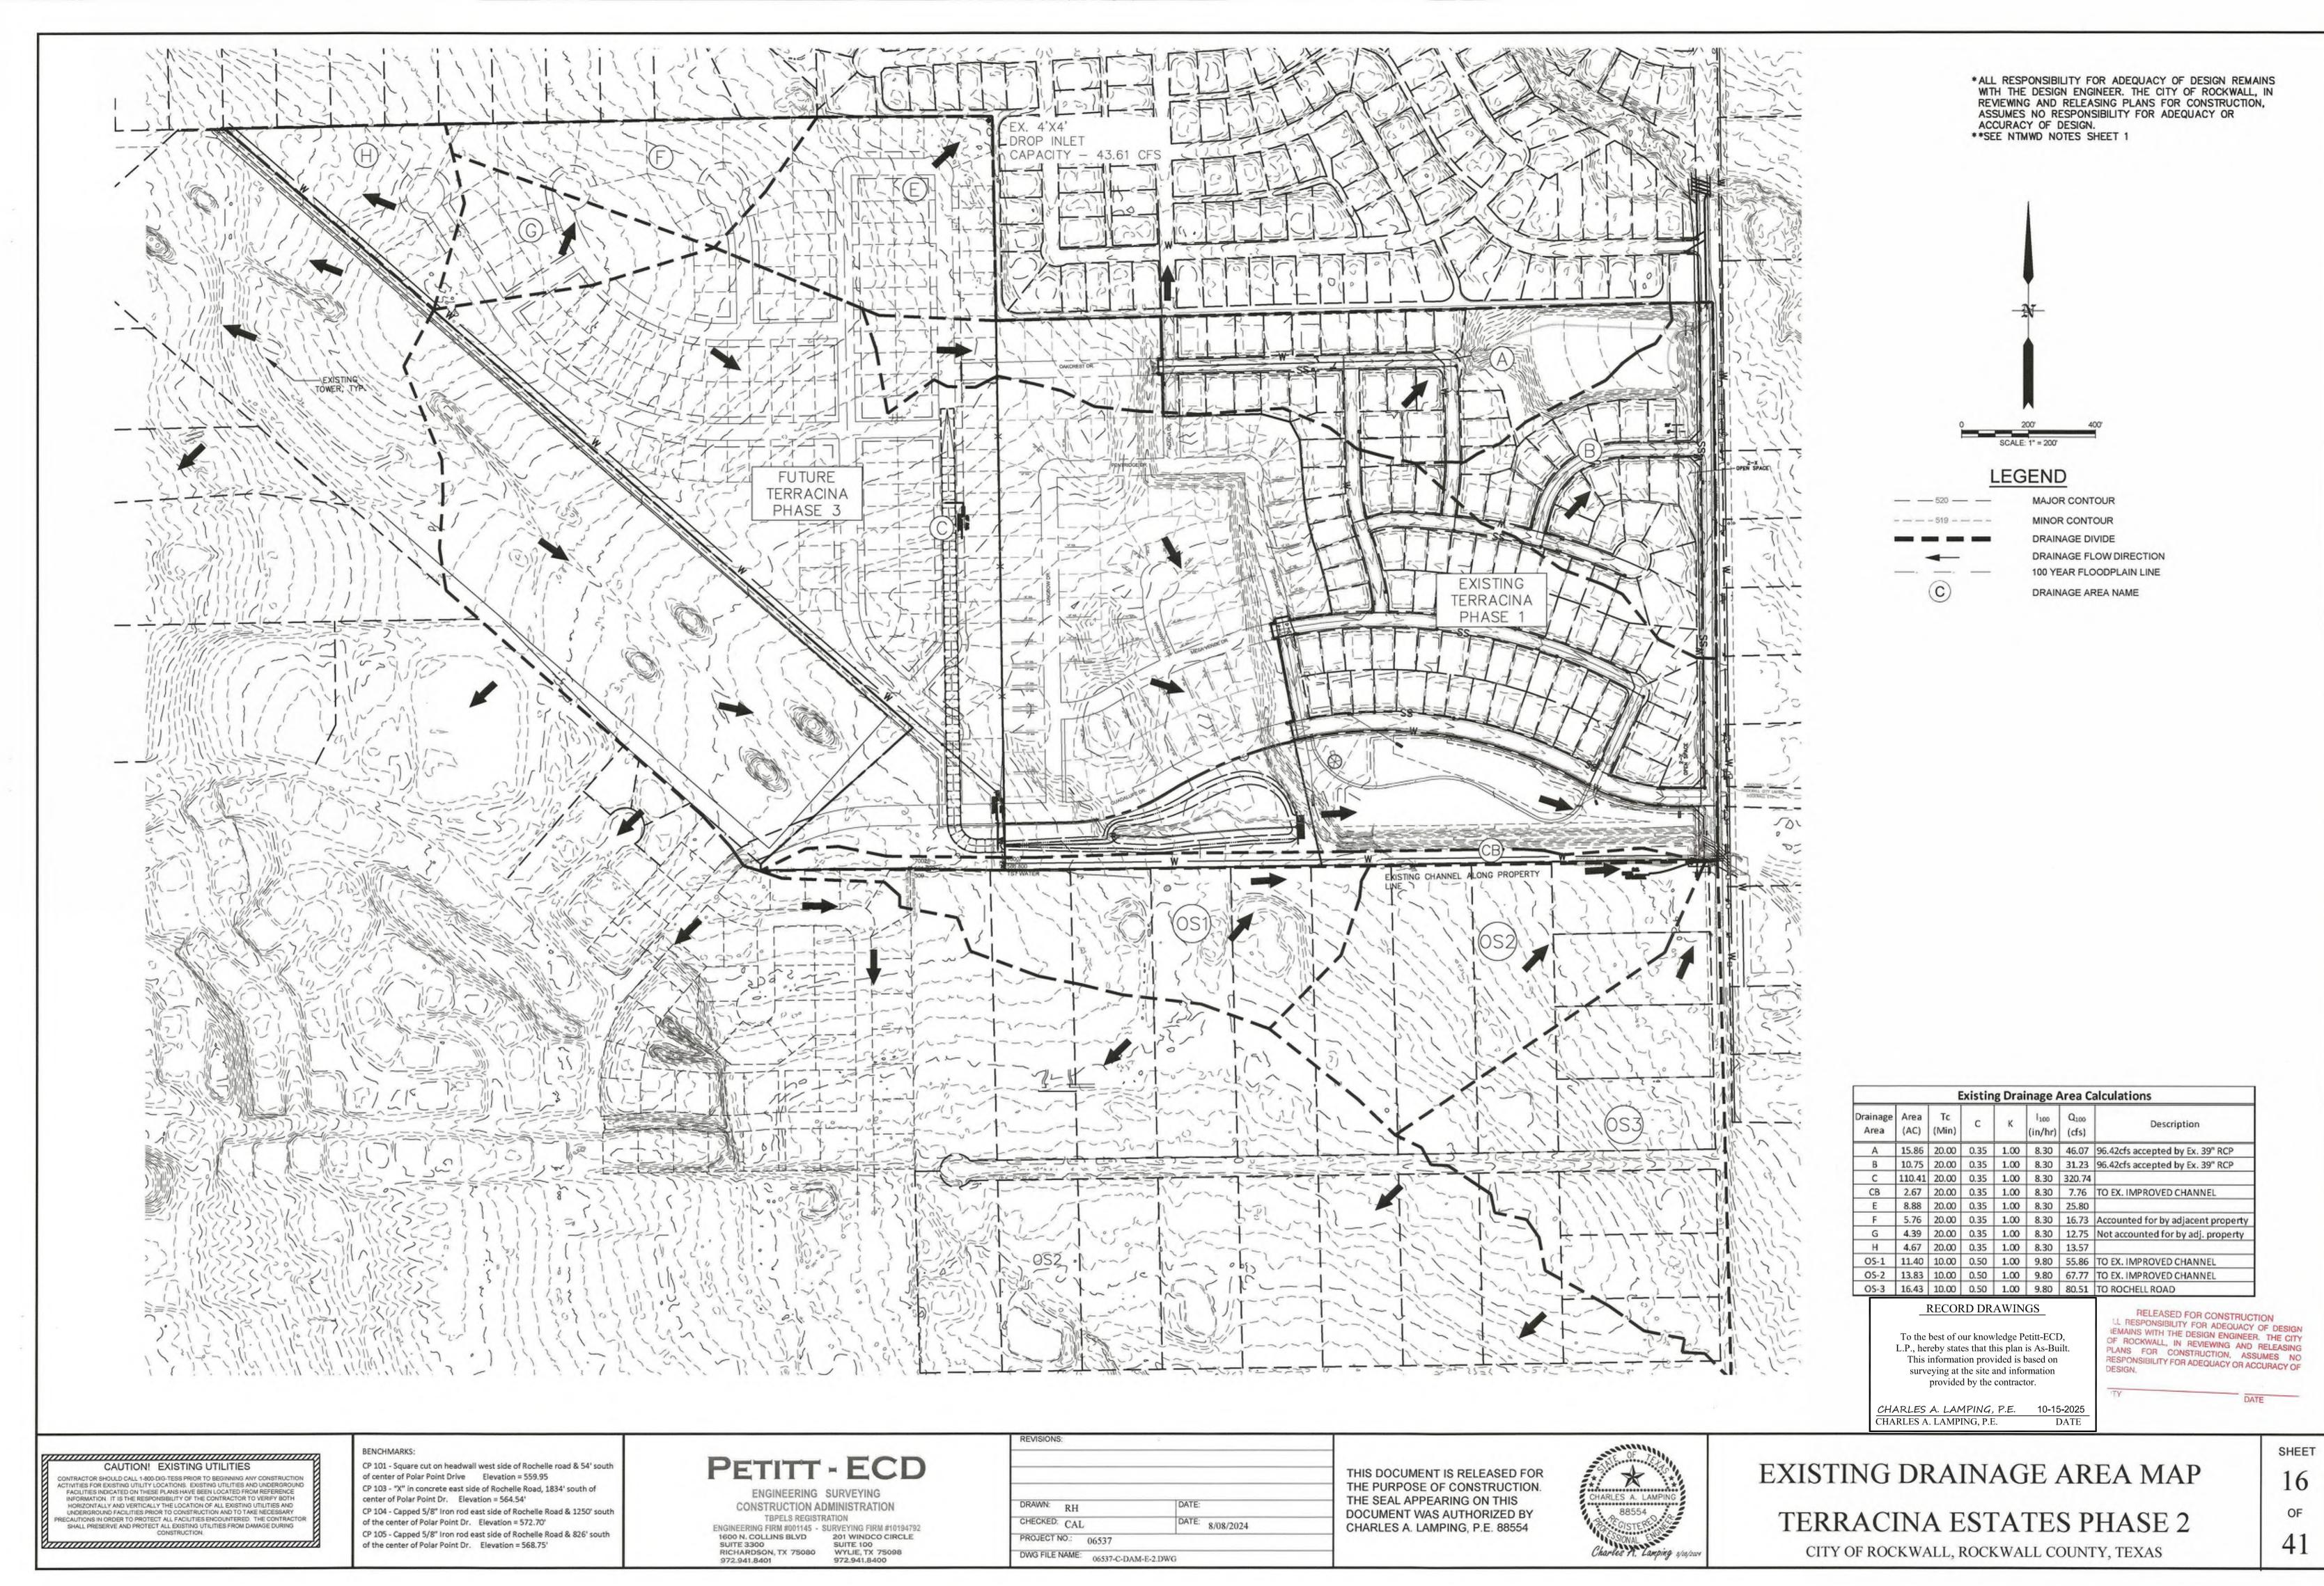

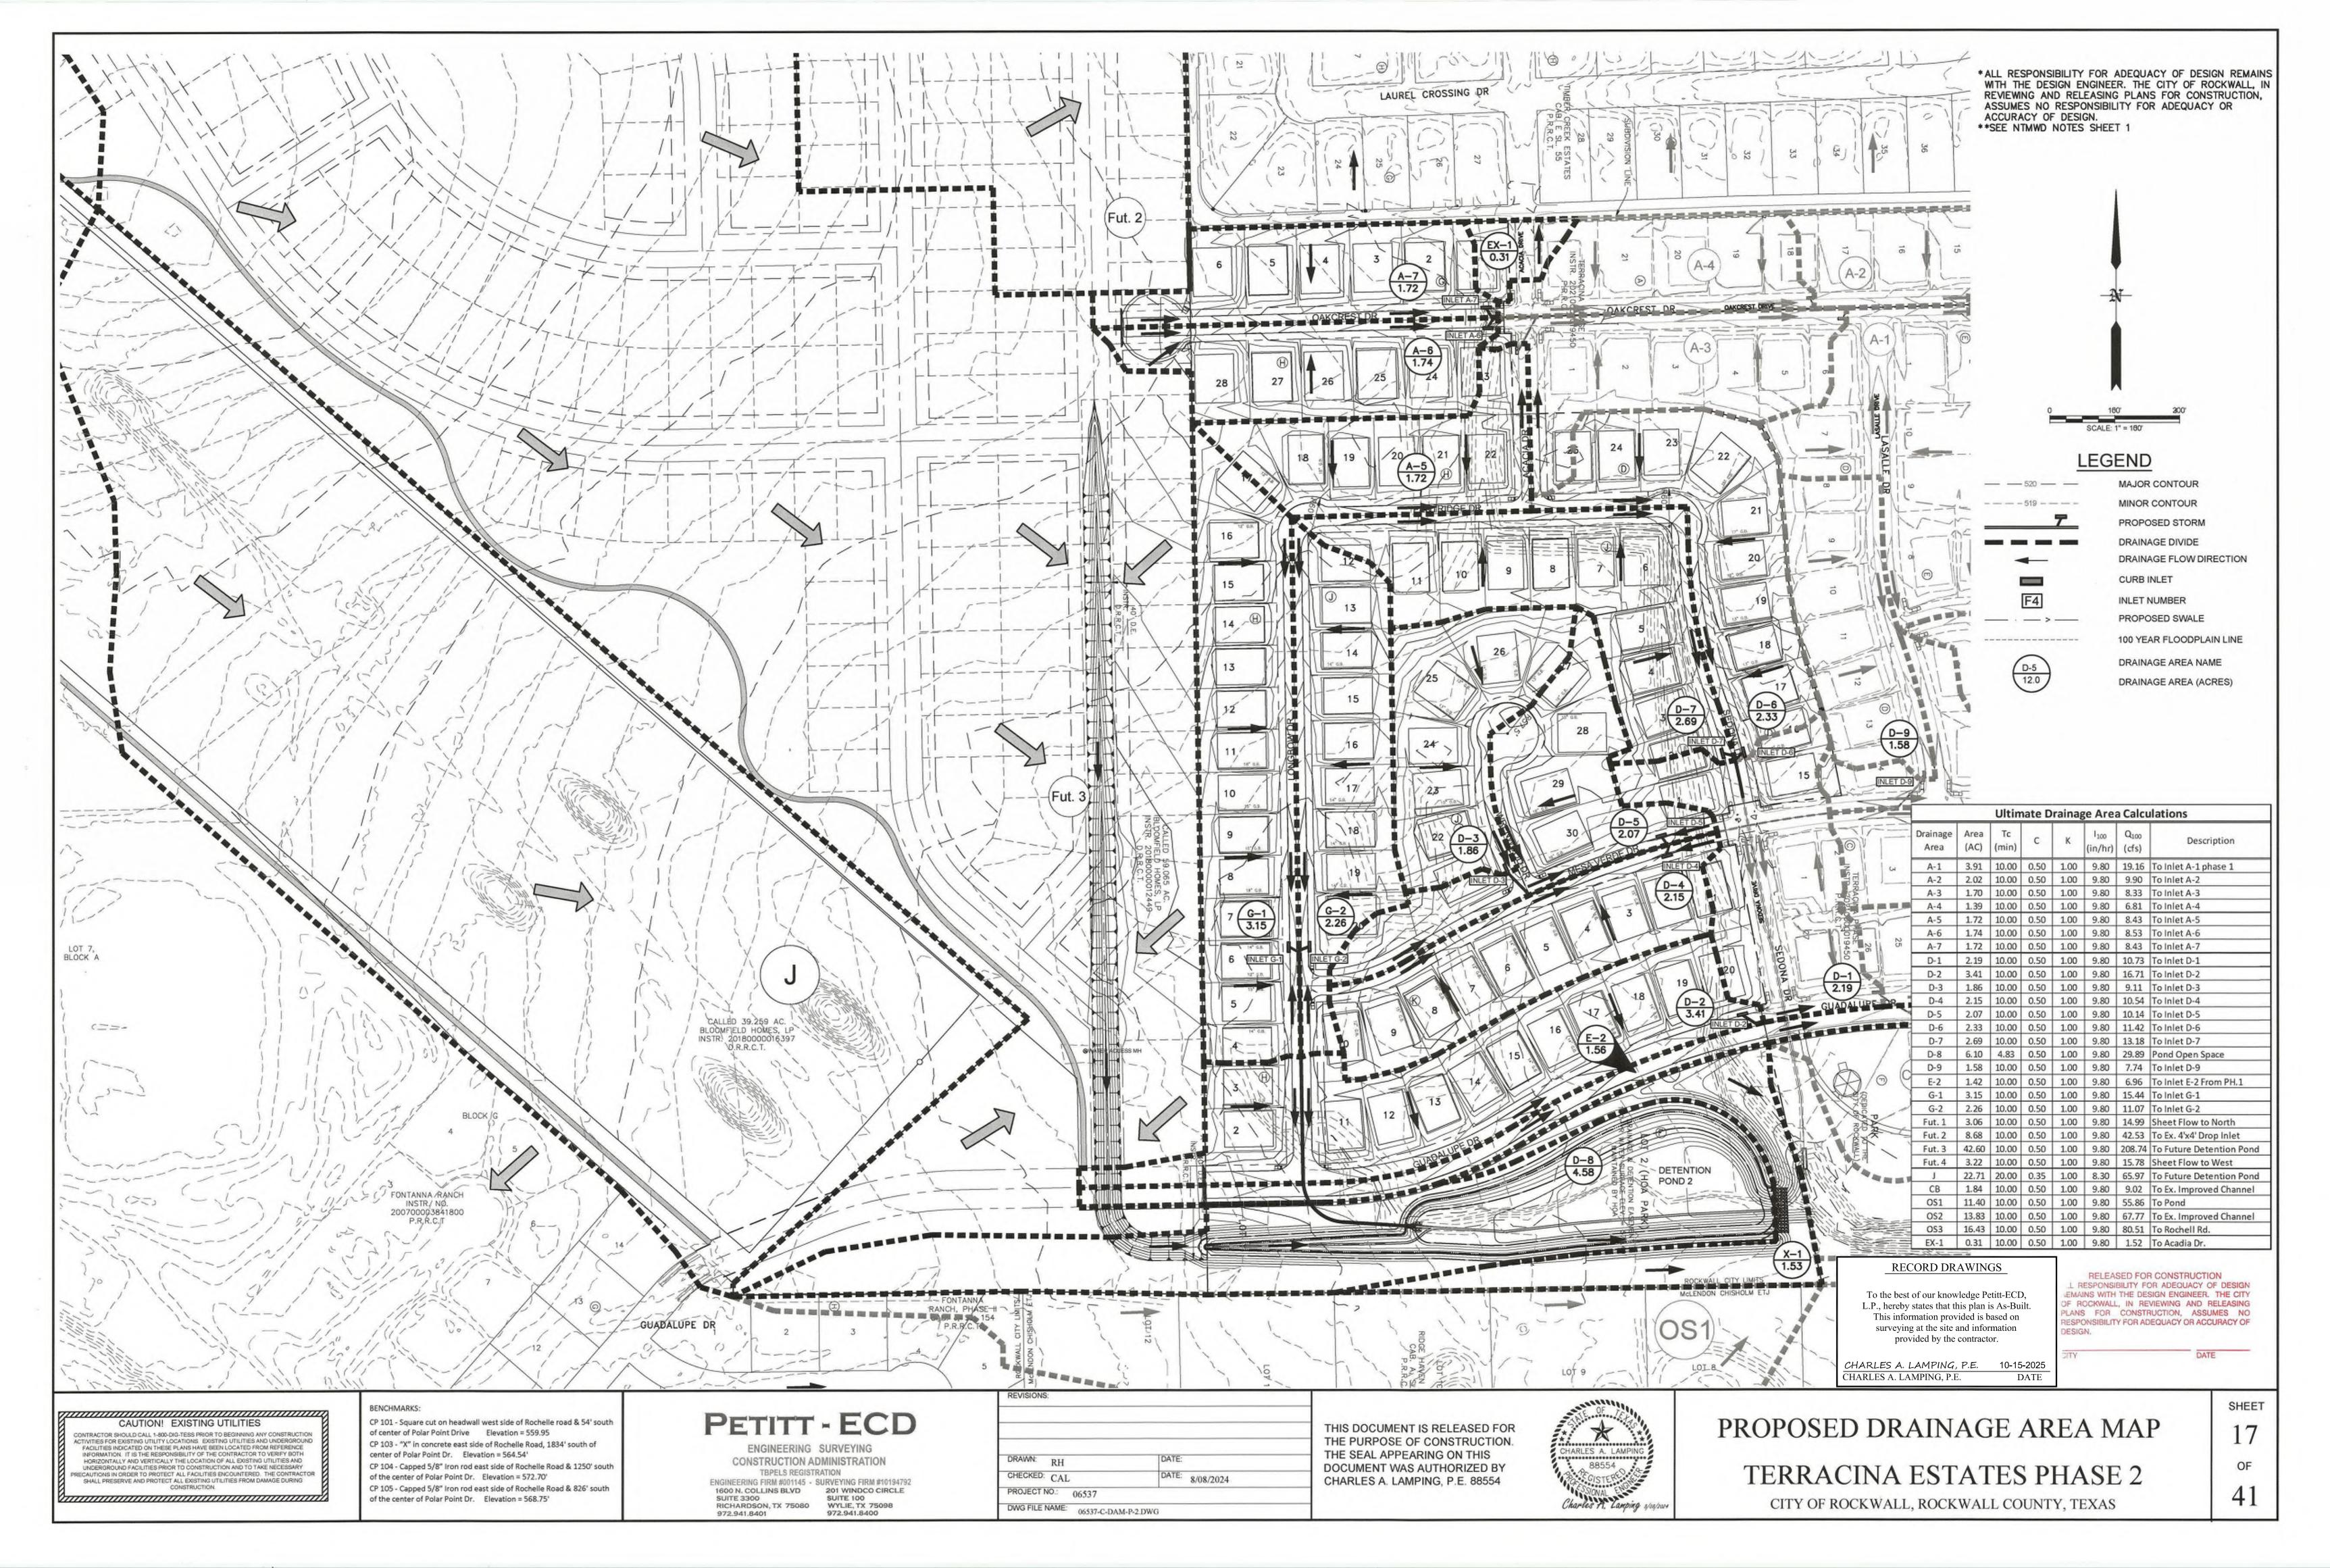

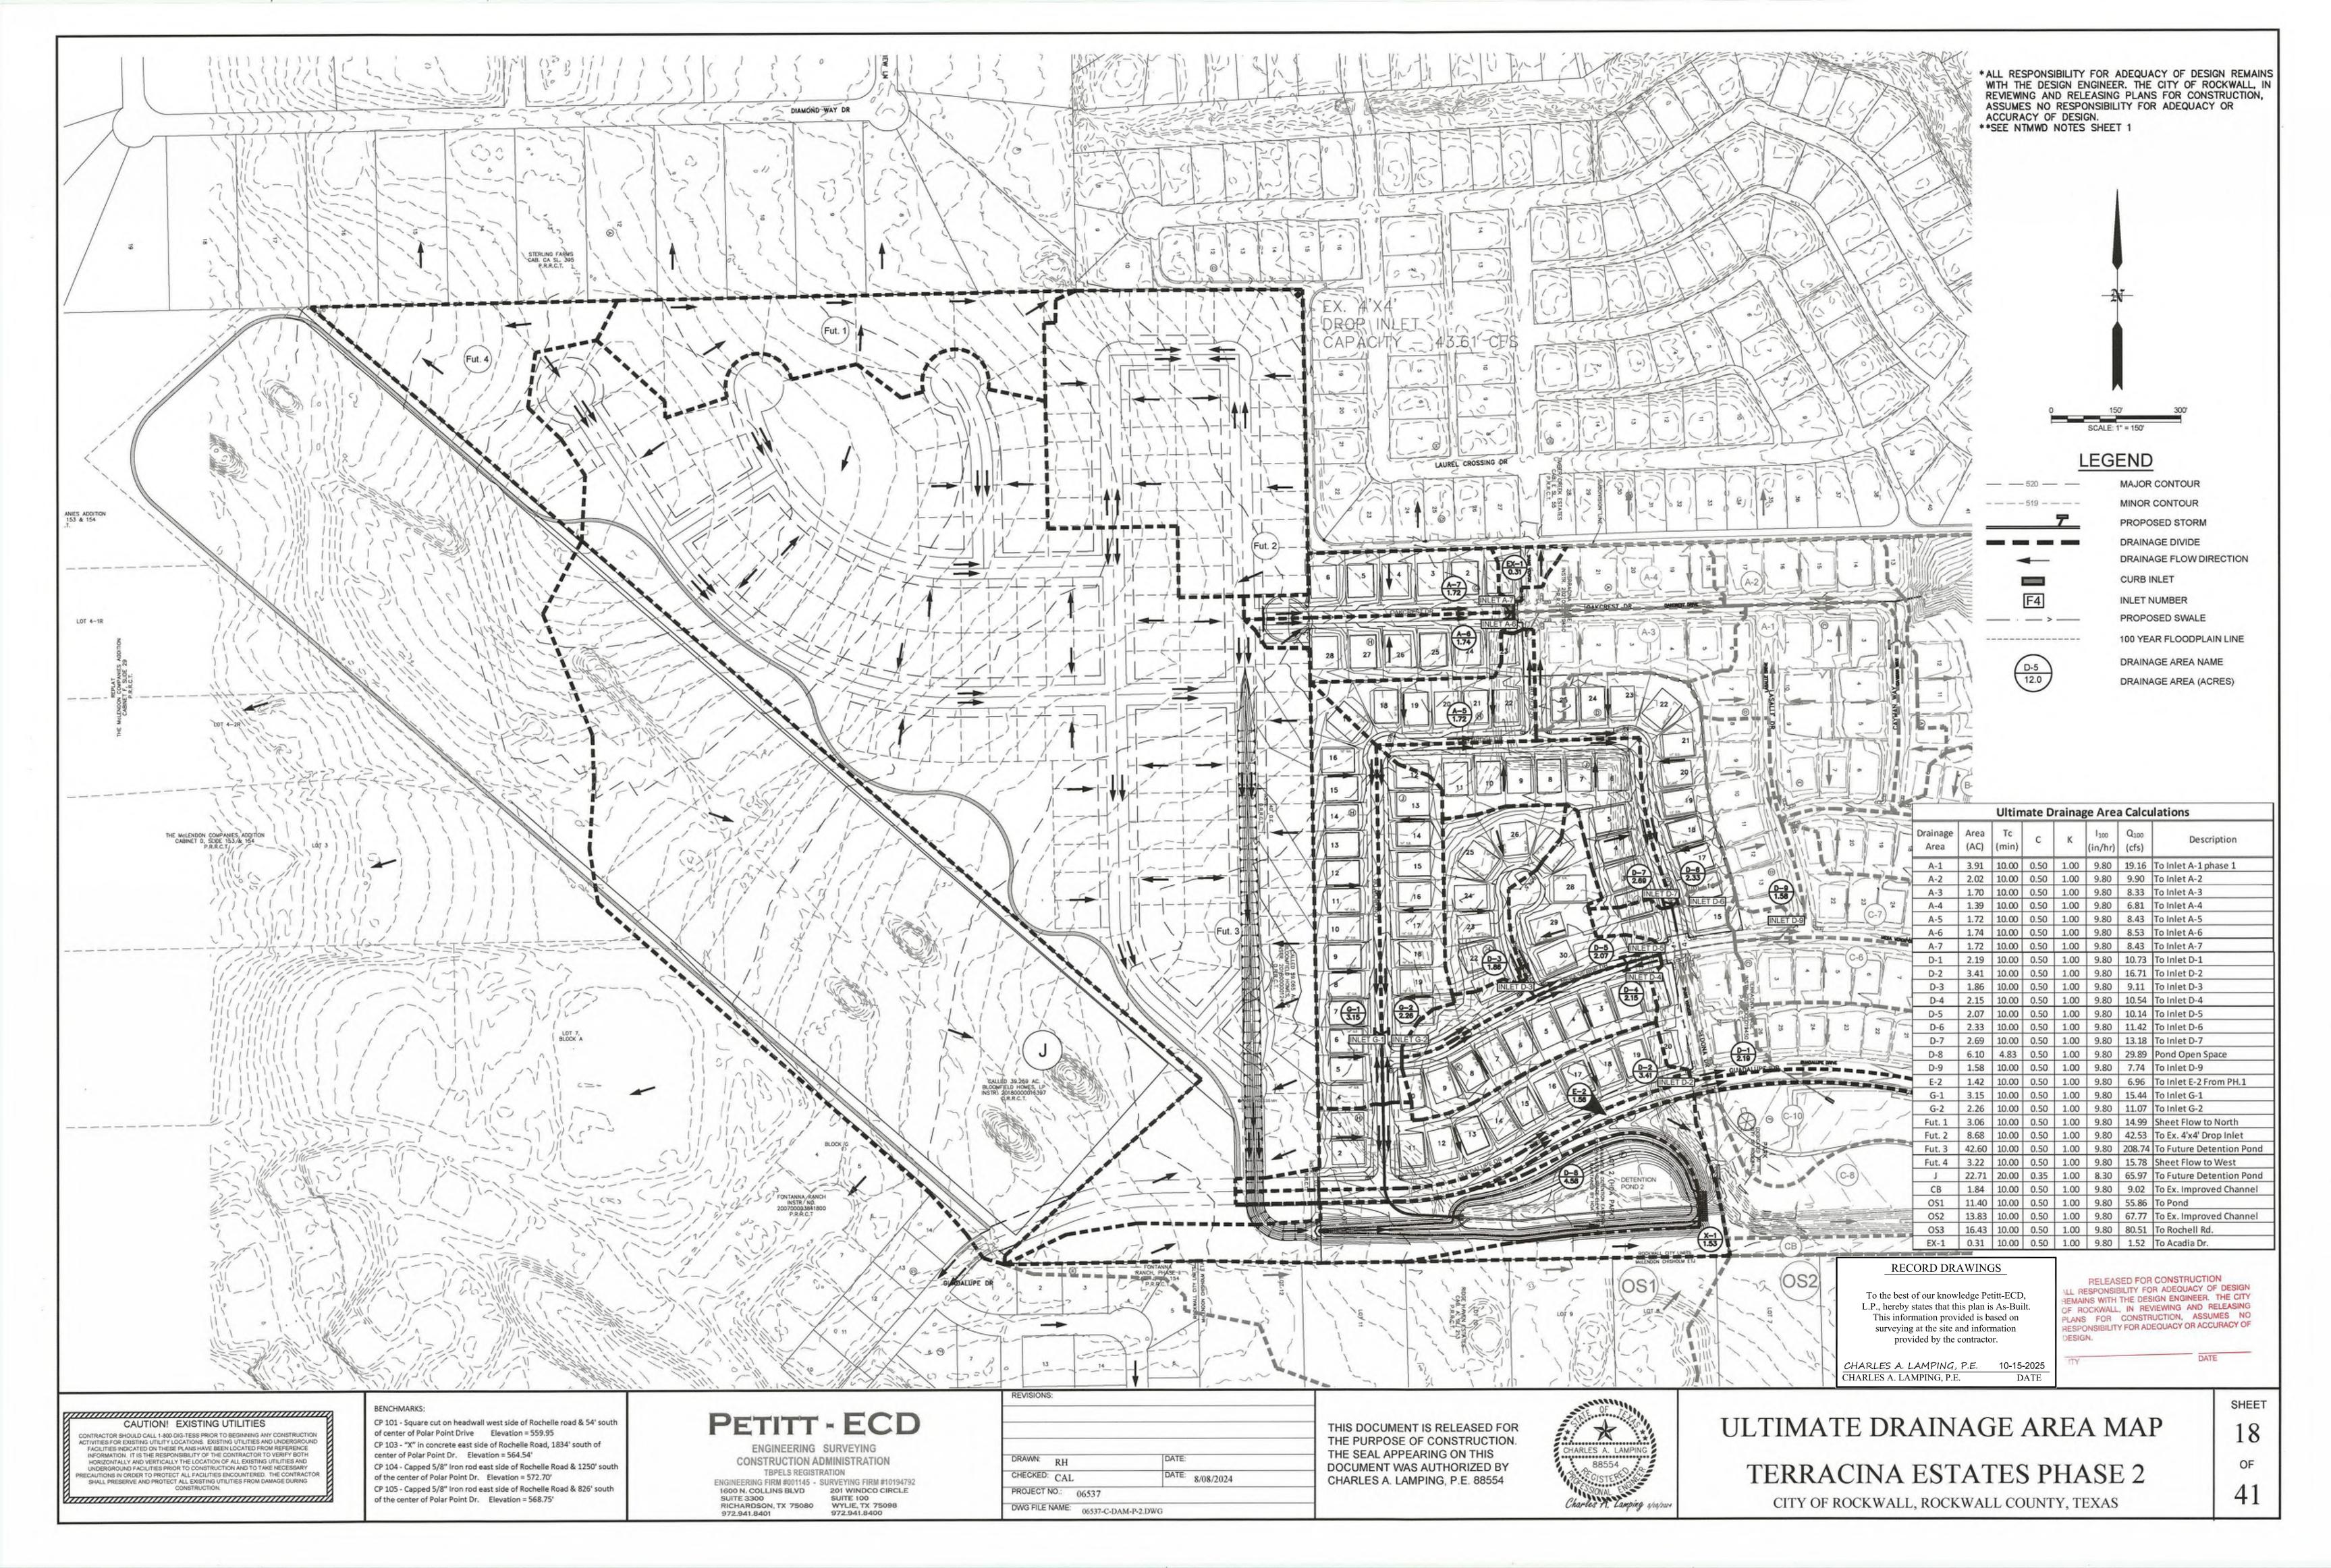


Fig. Section																					Pipe Ca	lculation	ıs																				
No.																R	CP							Elevation																			
No.	Land Landson		Dist.					Accum-	_	Design	Rainfall		Cum.		Storm Sewer						Hydraulio	Mann.		1	Slope of	Velocity		The second second					Head		Inlet and	Flow Time	Flow Time of	Down-	Hasteria	Chartina	Top of	HGL	
State Stat			Btwn.		DA (AC)			ulated		Storm	Intensity	, Runoff, O	Runoff Q	of Barrels	Diameter, Ø						Radius of		Un-	Down-			Clone C.		200	L*Sf	V1 ² /2g	V2 ² /2g		Unetroom	Bend		Downstream	stream			Curb	Ton of	Remarks
The color The		3.55	Points					CA		Freq.	I (in/hr)		(cfs)		(in)	Span (ft)	Rise (ft)		1 , , , ,		Pipe (ft)	(in)			Pipe (%)	Pipe (fps)	(ft/ft)						Coeff, Kj	(ft)	Losses		Sta. (min)	HGL	1000		Elevation		
The color The																																											
A	A 2	3	4	417.5	18			21	22	_	24	_		5	6	7	8	9	10	11			14	_			30	26	27	31	34	35		38	38	29	10.00	33		39		41	42
No.			_		1.72					_				1	24		0	-													0.15						10.11				360,43	3.23	
A	A 1003.24	937.01								_				1	24	-	0	77.41		6.28		_																					
A			_						_		7.7	_		1	30	-	0																										
1														1		-	0																						574.53				
A	A 112.53	50.00	62.53	MH	5.93	0.50	2.97	6.24	12.09	100-YR	9.43	27.97	67.23	1	42	0	0	RCP	9.62	11.00	0.88	0.0130	567.66	567.35	0.50%	6.99	0.0045	71.14	No	0.279	0.99	0.76	1.00	-0.12	0.00	0.15	12.24	571.13	571.01	570.85			
A																																											
Math					3.91			1.96	10.00		9.80	-		1	24	0	0			6.28									No												576.33	2.68	
A					2.02									1		-	0			7.85			_		-															571 94			
A		0.00	50.10		2.02	0.50	1.01	2.57	10.07	_	3.73	3.03	25.05	-	30	- 0	-	Ker	4.51	7.05	0.05	0.0130	300.23	307.00	0.5070		0.0050	25.05	103	0.452						0.2.1	20102	572.57		0,2,0,			
A		0.00	20.51		2.02	0.50	1.01	1.01	10.00	_	9.80	9.90	9.90	1	21	0	0	RCP	2.41	5.50	0.44	0.0130	572.33	569.67	17.87%		0.0039	66.98	No	0.080	0.00					0.08	10.08	573.74		573.66	576.33	2.26	
A		0.00	16.74		1.70	0.50	0.85	0.85	10.00		9.80	8.33	8.33	1	18	0	0	RCP	1.77	4.71	0.38	0.0130	578.92	573.97	28.11%		0.0063	55.69	Yes	0.105	0.26					0.06	10.06	575.48		575.38	582.68	6.76	
A										100-YR																					0.35	0.99	0.35	0.87	0.35				574.16				
A		0.00	16.74		1.39	0.50	0.70	0.70	10.00		9.80	6.81	6.81	1	18	0	0	RCP	1.77	4.71	0.38	0.0130	579.12	574.67	26.02%		0.0042	53.58	Yes	0.070	0.22					0.07	10.07	575.65		575.58	583.03	7.09	
Act Part P		0.00	60.04		1.72	0.50	0.86	0.86	10.00		9.80	8.43	8.43	1	21	0	0	RCP	2.41	5.50	0.44	0.0130	582.54	578.14	16.53%		0.0028	64.42	No	0.170	0.23					0.29	10.29	581.07		580.90	586.54	5.23	
A																															0.19		0.35		0.33								
2 85.5. 82.5 93.9 Nich 2 80 05 15 15 300 999 80 113 114 1 21 0 0 7 No 128 114 1 12 0 0 0 1 No 128 114 1 12 0 0 0 1 No 128 114 1 12 0 0 0 1 No 128 114 1 12 0 0 0 1 No 128 114 1 12 0 0 0 1 No 128 114 1 12 0 0 0 1 No 128 114 1 12 0 0 0 1 No 128 114 1 12 0 0 0 1 No 128 114 1 12 0 0 0 1 No 128 114 1 12 0 0 0 1 No 128 114 1 12 0 0 0 1 No 128 114 1 12 0 0 0 1 No 128 114 1 12 0 0 0 1 No 128 114 1 12 0 0 0 1 No 128 114 1 12 0 0 0 1 No 128 114 1 12 0 0 0 1 No 128 114 1 12 0 0 No 128 114 1 12 0		0.00	17.40		1.74	0.50	0.87	0.87	10.00		9.80	8.53	8.53	1	18	0	0	RCP	1.77	4.71	0.38	0.0130	582.41	578.83	20.69%		0.0066	47.78	Yes	0.115	0.36					0.06	10.06	581.10		580.99	586.41	4.85	
Part	A-0			WILK						200 110																5.22					0.50	0.72	0.00	0.20	0.21								
D Size Prop. D Size Lamp Lamp Lamp Size D Size Lamp Size D Size Size D Size		_	_		2.69		-				_	20,20		1	21	0	0			0.00													2100								581.09	-39.56	
Part					2.33		1.17	2.51	24-72-7		1-1			1	30	0	0			7.85						5.01		36.69	2.4							1-1-1-1							
No. 19.20	D 709.22	404.22					_	6.34		_			61.86	1	42	0	0	RCP	9.62	11.00					213551				Yes														
Part					3.41									1	48	0	0		MALO 1	and to 7									1.00											573.55			
Part	0 202.20	102.50	113.70	DENO		0.50						0.00	70.21		40	v	-	ner	12.57	12.57	1.00	0.0130	307.77	307.12	0.5070	U.ZZ	0.0050	70.00	163	0.333	0.00	0.00	1.00	0.00	0.00	0.02	22.00	373.30	373.33	5,5.55			
D	D-1 181.78	1.13	180.65	INL D-1	2.19	0.50	1.10	1.10	10.00	100-YR	9.80	10.73	10.73	1	18	0	0	RCP	1.77	4.71	0.38	0.0130	572.66	570.92	4.00%	6.07	0.0104	21.01	No	1.886		0.57	1.25	0.00	0.72	0.50	10.50	573.30	574.01	571.41	577.17	3.16	
D-3	D-2 71.78	0.00	71.78	INL D-2	3.41	0.50	1.71	1.71	10.00	100-YR	9.80	16.71	16.71	1	24	0	0	RCP	3.14	6.28	0.50	0.0130	574.62	572.35	5.83%	5.32	0.0055	54.62	Yes	0.392		0.44	1.00	0.00	0.00	0.22	10.22	575.30	575.30	574.91	578.62	3.32	
Start Star				MH D						100-YR																6.22					0.44			0.49									
Paragraphy Par			_		1.86			100000					9.12	1	21	0	0												1											_	582.36	4.31	
Day 1249 1 1249 1 1249 1 1249 1 1249 1 1 1 1 1 1 1 1 1							_						9.12	1	24	0	0							-							0.22												
Note												9.93		1	24	0	0				•										0.13									-	500.50	4.53	
Decoration Control C	D-3 124.91	0.00	124.91		2.15	0.50	1.08	1.08	11.22		9.80	10.54	29.58	1	24	0	0	RCP	3.14	6.28	0.50	0.0130	5/6.13	5/5.4/	1.00%	6.22	0.01/1	29.58	Yes	2.136	1.38					0.22	11.44	5/6.02		5/3.88	580.59	4.57	
D-S 15.48 0.00 15.48 END 2.07 0.50 1.04 1.04 1.00		0.00	16.75	END	2.15	0.50	1.08	1.08	10.00	100-YR	+	10.54	10.54	1	18	0	0	RCP	1.77	4.71	0.38	0.0130	576.38	576.42	0.28%		0.0101	10.54	Yes	0.169		0.55	1.00	0.00	0.00	0.05	10.05	576.80	576.80	576.63	580.42	3.62	
D-S C		0.00	15.40		2.07	0.50	1.04	1.04	10.00		_	10.14	10.14	1	10	0	0	DCD.	1 77	A 71	0.39	0.0120	576 29	576.42	0.25%		0.0003	10.14	Vac	0.144	0.55				1000000	0.04	10.04	577 77		577.63	580.42	2.65	
D-6 D-6 D-7		0.00	15.48		2.07	0.50	1.04	1.04	10.00		+	10.14	10.14	1	10	U	U	NCP	1.//	4.71	0.38	0.0130	370.38	370.42	0.25%		0.0093	10.14	ies	0.144	0.51					0.04	10.04	311.11		377.03	300.42	2.00	
0-9 294.11 231.53 62.58 INLD-5 2.07 0.50 1.04 1.04 1.00 100-FR 9.80 1.04 1.014 1 21 0 0 0 RCP 2.41 5.50 0.44 0.0130 575.90 574.78 1.68% 4.22 0.0041 20.54 Feb 0.256 0.00 0.35 0.25 10.25 577.44 577.79 0 579.90 2.11 0.99 0.99 0.99 0.99 0.99 0.99 0.99 0		0.00	16.79		2.33	0.50	1.17	1.17	10.00	_		11.42	11.42	1	21	0	0	RCP	2.41	5.50	0.44	0.0130	574.09	570.38	4.81%	4.75	0.0052	34.75	Yes	0.087						0.06	10.06	576.51		576.42	581.05	4.54	
D-9 231.53 0.00 231.53 BEND 0.50 0.00 1.04 10.25 100-YR 9.76 0.00 10.14 1 21 0 0 0 RCP 2.41 5.50 0.44 0.0130 574.78 570.38 1.41% 4.22 0.0041 18.81 No 0.949 0.28 0.28 0.37 0.00 0.10 0.92 11.16 577.08 577.18 576.13 U 575.40 U 575.		231 53	62.58		2.07	0.50	1.04	1.04	10.00		_	10.14	10.14	1	21	0	0	RCP	2.41	5.50	0.44	0.0130	575.90	574.78	1.68%	5.01	0.0041	20.54	Yes	0.256	0.35					0.25	10.25	577.44			579.90	2.11	
G 580.55 565.09 15.46 INLG-2 2.26 0.50 1.13 1.13 10.00 100-YR 9.80 11.07 11.07 1 24 0 0 RCP 5.94 8.64 0.69 0.0130 579.29 0.26% 1.86 0.0004 26.97 Yes 0.001 0.19 0.05 0.32 0.00 0.02 0.03 10.10 581.29 581.30 0 0 RCP 5.94 8.64 0.69 0.0130 579.29 578.12 0.26% 1.86 0.0004 26.97 Yes 0.001 0.19 0.05 0.32 0.00 0.02 0.03 10.10 581.29 581.30 0 0 RCP 5.94 8.64 0.69 0.0130 579.29 578.12 0.26% 1.86 0.0004 26.97 Yes 0.001 0.19 0.05 0.32 0.00 0.02 0.03 10.10 581.29 581.30 0 0 RCP 5.94 8.64 0.69 0.0130 579.29 578.12 0.26% 1.86 0.0004 26.97 Yes 0.001 0.19 0.05 0.32 0.00 0.02 0.03 10.10 581.29 581.30 0 0 RCP 5.94 8.64 0.69 0.0130 579.29 578.12 0.26% 1.86 0.0004 26.97 Yes 0.001 0.19 0.05 0.32 0.00 0.02 0.03 10.10 581.29 581.30 0 0 RCP 5.94 8.64 0.69 0.0130 579.29 578.12 0.26% 1.86 0.0004 26.97 Yes 0.010 0.19 0.05 0.32 0.00 0.02 0.03 10.10 581.29 581.30 0 0 RCP 5.94 8.64 0.69 0.0130 579.29 578.12 0.26% 1.86 0.0004 26.97 Yes 0.010 0.19 0.05 0.31 0.35 0.29 0.11 1.68 11.78 580.89 581.29 0.00 0.00 0.00 0.00 0.00 0.00 0.00 0					2.07				-	_	_			1	21	0	0		_													0.28	0.37	0.00					577.18	576.13	2,3,50		
G 565.09 562.10 2.99 PIPE SIZE 0.50 0.00 1.13 10.07 100-YR 9.79 0.00 1.10 100-YR 9.79 0.00 1.00-YR 9.79 0.00-YR 9.	D-9			MH D						100-YR																6.43					0.28	0.64	0.25	0.57	0.16				575.40				
G 565.09 562.10 2.99 PIPE SIZE 0.50 0.00 1.13 10.07 100-YR 9.79 0.00 1.10 100-YR 9.79 0.00 1.00-YR 9.79 0.00-YR 9.	G 580.55	565.09	15.46	INL G-2	2.26	0.50	1.13	1.13	10.00	100-YR	9.80	11.07	11.07	1	24	0	0	RCP	3.14	6.28	0.50	0.0130	580.11	580.05	0.38%	3.52	0.0024	13.95	Yes	0.037		0.19	1.25	0.00	0.24	0.07	10.07	581.34	581.58		584.11	2.53	
G 111.78 0.00 111.78 BEND 0.50 0.00 2.71 11.78 100-YR 9.49 0.00 26.49 1 33 0 0 RCP 5.94 8.64 0.69 0.0130 578.12 576.00 1.90% 4.46 0.0025 72.90 Yes 0.281 0.31 0.31 0.25 0.00 0.08 0.42 12.20 579.68 579.76 579.40 0.0130 578.12 576.00 1.90% 4.46 0.0025 72.90 Yes 0.281 0.31 0.31 0.25 0.00 0.08 0.42 12.20 579.68 579.76 579.40 0.0130 578.12 576.00 1.90% 4.46 0.0025 72.90 Yes 0.281 0.31 0.31 0.25 0.00 0.08 0.42 12.20 579.68 579.76 579.40 0.0130 579.76 579.40 0.0130 579.76 579.91 1.14% 8.73 0.0216 15.44 No 0.361 0.31 1.18 1.25 0.00 1.48 0.03 10.03 581.20 582.68 584.11 1.43	G 565.09	562.10	2.99	PIPE SIZE		0.50	0.00	1.13	10.07	100-YR	9.79	0.00	11.07	1	33	0	0	RCP	5.94	8.64	0.69	0.0130	579.30	579.29	0.26%	1.86	0.0004	26.97	Yes	0.001		0.05	0.32	0.00	0.02	0.03	10.10	581.29	581.30				
G-1 16.74 0.00 16.74 INLG-1 3.15 0.50 1.58 1.58 10.00 100-YR 9.80 15.44 15.44 1 18 0 0 0 RCP 1.77 4.71 0.38 0.0130 579.76 579.91 1.14% 8.73 0.0216 15.44 No 0.361 0.31 1.18 1.25 0.00 1.48 0.03 10.03 581.20 582.68 584.11 1.43					3.15									1	33	0	0					_																		579.40			
	5 111.78	0.00	111.70	DEMO		0.50	0.00	2./1	11.70	100-11	3,43	0.00	20.45	1	33	U	J	Nor	3,34	0.04	0.03	0.0130	370.12	570.00	1.50/0	7.70	0.0023	72.30	163	0.201	VIJI	0.01	0.23	0.00	0.00	J.12	22.20	5.5.00	575.70	373.40			
		0.00	46.71	INU C 4	2.45	0.50	4.50	4.50	40.00	100 110	0.00	45.44	45.44		40	^	_	0.00	4.77	4.74	0.00	0.0100	F70 76	E70.01	4.4467	0.70	0.0044	45.41	Atte	0.204	0.24	1.10	1.05	0.00	1.40	0.02	10.02	F01.20	F02.62		F04.44	4.42	
		0.00	16.74		5.15	0.50	1,58	1.58	10.00	_		15.44	15.44	1	18	U	U	KCP	1.//	4./1	0.38	0.0130	5/9./6	5/9.91	1.14%		0.0216	15.44	No	0.361						0.03	10.03	261.20	362.68	580.89	384.11	1.43	

													Ini	et Calcul	ations													
Inlet Number	Inlet Location	Drainage Area No.	Time of Concen- tration (min)		Design Freq. (Yr)	с	К	I ₁₀₀ (in/hr)	Q ₁₀₀ (cfs)	Mannings n	Long Gutter Slope, S _I %	Crown Cross Slope, S _x	Upstream Bypass and Crossover, Q ₁₀₀ (cfs)	Total Gutter Flow, Q ₁₀₀ (cfs)	Depth of Flow in Gutter, d ₁₀₀ (ft)	Depr. Depth at Inlet a, (ft)	Depr. Wdith at Inlet, W (ft)	Spread of Flow at Inlet, T ₁₀₀ (ft)	Allowed Spread of Flow at Inlet, T ₁₀₀ (ft)	Max.Depth of Flow in Gutter, d ₁₀₀ (ft)	Gutter Capacity, Q ₁₀₀ (cfs)	Inlet Length Req'd, Lt (ft)			Inlet Efficiency, %	Inlet Intecept Capacity, Q ₁₀₀ (cfs)	100	To Inlet
1	2/3	7	8	10	5	6		9	11	16	17	19	12	13	25	20	21	23	22	24	26	35	36	15			38	38
A-6	6+08.61 OAKCREST	A-6	10	1.74	100YR	0.50	1.00	9.80	8.53	0.0175	0.90%	0.03570		8.53	0.42	0.50	2.0	11.80	14	0.5	13.38	10.91	15	On Grade	100.0%	8.53	0.00	
A-7	6+06.78 OAKCREST	A-7	10	1.72	100YR	0.50	1.00	9.80	8.43	0.0175	0.90%	0.03570		8.43	0.42	0.50	2.0	11.75	14	0.5	13.38	10.84	15	On Grade	100.0%	8.43	0.00	
D-1	18+74.14 GUADALUPE	D-1	10	2.19	100YR	0.50	1.00	9.80	10.73	0.0175	0.70%	0.02500		10.73	0.42	0.50	2.0	16.84	20	0.5	16.87	12.82	15	On Grade	100.0%	10.73	0.00	
D-2	16+66.77 GUADALUPE	D-2	10	3.41	100YR	0.50	1.00	9.80	16.71	0.0175	0.70%	0.02500		16.71	0.50	0.50	2.0	19.88	20	0.5	16.87	16.74	15	On Grade	89.6%	14.97	1.74	
D-3	0+40.26 WRENWOOD CT.	D-3	10	1.86	100YR	0.50	1.00	9.80	9.11	0.0175	1.06%	0.03570		9.11	0.42	0.50	2.0	11.73	14	0.5	14.52	11.75	15	On Grade	100.0%	9.11	0.00	
D-4	6+08.02 MESA VERDE	D-4	10	2.15	100YR	0.50	1.00	9.80	10.54	0.0175	0.70%	0.03570		10.54	0.48	0.50	2.0	13.39	14	0.5	11.80	11.62	15	Sag	100.0%	10.54	0.00	
D-5	6+08+02 MESA VERDE	D-5	10	2.07	100YR	0.50	1.00	9.80	10.14	0.0175	0.70%	0.03570		10.14	0.47	0.50	2.0	13.20	14	0.5	11.80	11.37	15	Sag	100.0%	10.14	0.00	
D-6	4+16.81 SEDONA	D-6	10	2.33	100YR	0.50	1.00	9.80	11.42	0.0175	0.70%	0.03570		11.42	0.49	0.50	2.0	13.80	14	0.5	11.80	12.17	15	On Grade	100.0%	11.42	0.00	
D-7	4+23.26 SEDONA	D-7	10	2.69	100YR	0.50	1.00	9.80	13.18	0.0175	0.70%	0.03570		13.18	0.52	0.50	2.0	14.56	14	0.5	11.80	13.23	15	On Grade	100.0%	13.18	0.00	
E-2	28+37.68 GUADALUPE	E-2	10	1.56	100.00	0.50	1.00	9.80	7.64	0.0175	1.40%	0.02500		7.64	0.33	0.50	2.0	13.02	20	0.5	23.85	12.21	15	On Grade	100.0%	7.64	0.00	
G-1	3+90.20 LONGBOW	G-1	10	3.15	100YR	0.50	1.00	9.80	15.44	0.0175	0.70%	0.03570		15.44	0.55	0.50	2.0	15.45	14	0.5	11.80	14.50	15	Sag	100.0%	15.44	0.00	
G-2	3+90.20 LONGBOW	G-2	10	2.26	100YR	0.50	1.00	9.80	11.07	0.0175	0.70%	0.02500		11.07	0.43	0.50	2.0	17.04	14	0.5	6.52	13.06	15	Sag	100.0%	11.07	0.00	

RECORD DRAWINGS

To the best of our knowledge Petitt-ECD, L.P., hereby states that this plan is As-Built. This information provided is based on surveying at the site and information provided by the contractor.

CHARLES A. LAMPING, P.E. 10-15-2025 CHARLES A. LAMPING, P.E.

RELEASED FOR CONSTRUCTION IL RESPONSIBILITY FOR ADEQUACY OF DESIGN HEMAINS WITH THE DESIGN ENGINEER. THE CITY OF ROCKWALL, IN REVIEWING AND RELEASING PLANS FOR CONSTRUCTION, ASSUMES NO RESPONSIBILITY FOR ADEQUACY OR ACCURACY OF DESIGN.

*ALL RESPONSIBILITY FOR ADEQUACY OF DESIGN REMAINS WITH THE DESIGN ENGINEER. THE CITY OF ROCKWALL, IN REVIEWING AND RELEASING PLANS FOR CONSTRUCTION, ASSUMES NO RESPONSIBILITY FOR ADEQUACY OR ACCURACY OF DESIGN. **SEE NTMWD NOTES SHEET 1

CAUTION! EXISTING UTILITIES

CONTRACTOR SHOULD CALL 1-800-DIG-TESS PRIOR TO BEGINNING ANY CONSTRUCTION ACTIVITIES FOR EXISTING UTILITY LOCATIONS. EXISTING UTILITIES AND UNDERGROUND FACILITIES INDICATED ON THESE PLANS HAVE BEEN LOCATED FROM REFERENCE INFORMATION. IT IS THE RESPONSIBILITY OF THE CONTRACTOR TO VERIFY BOTH HORIZONTALLY AND VERTICALLY THE LOCATION OF ALL EXISTING UTILITIES AND UNDERGROUND FACILITIES PRIOR TO CONSTRUCTION AND TO TAKE NECESSARY PRECAUTIONS IN ORDER TO PROTECT ALL FACILITIES ENCOUNTERED. THE CONTRACTOR SHALL PRESERVE AND PROTECT ALL EXISTING UTILITIES FROM DAMAGE DURING CONSTRUCTION.

BENCHMARKS:

CP 101 - Square cut on headwall west side of Rochelle road & 54' south of center of Polar Point Drive Elevation = 559.95 CP 103 - "X" in concrete east side of Rochelle Road, 1834' south of center of Polar Point Dr. Elevation = 564.54'

CP 104 - Capped 5/8" Iron rod east side of Rochelle Road & 1250' south of the center of Polar Point Dr. Elevation = 572.70' CP 105 - Capped 5/8" Iron rod east side of Rochelle Road & 826' south of the center of Polar Point Dr. Elevation = 568.75'

PETITT - ECD

ENGINEERING SURVEYING CONSTRUCTION ADMINISTRATION TBPELS REGISTRATION ENGINEERING FIRM #001145 - SURVEYING FIRM #10194792 1600 N. COLLINS BLVD 201 WINDCO CIRCLE SUITE 3300 SUITE 100 RICHARDSON, TX 75080 WYLIE, TX 75098 972.941.8401 972.941.8400

DRAWN:	RH	DATE:	
CHECKED:		DATE: 8/08/2024	


THIS DOCUMENT IS RELEASED FOR THE PURPOSE OF CONSTRUCTION. THE SEAL APPEARING ON THIS DOCUMENT WAS AUTHORIZED BY CHARLES A. LAMPING, P.E. 88554




HYDRAULIC CALCULATIONS


TERRACINA ESTATES PHASE 2

CITY OF ROCKWALL, ROCKWALL COUNTY, TEXAS

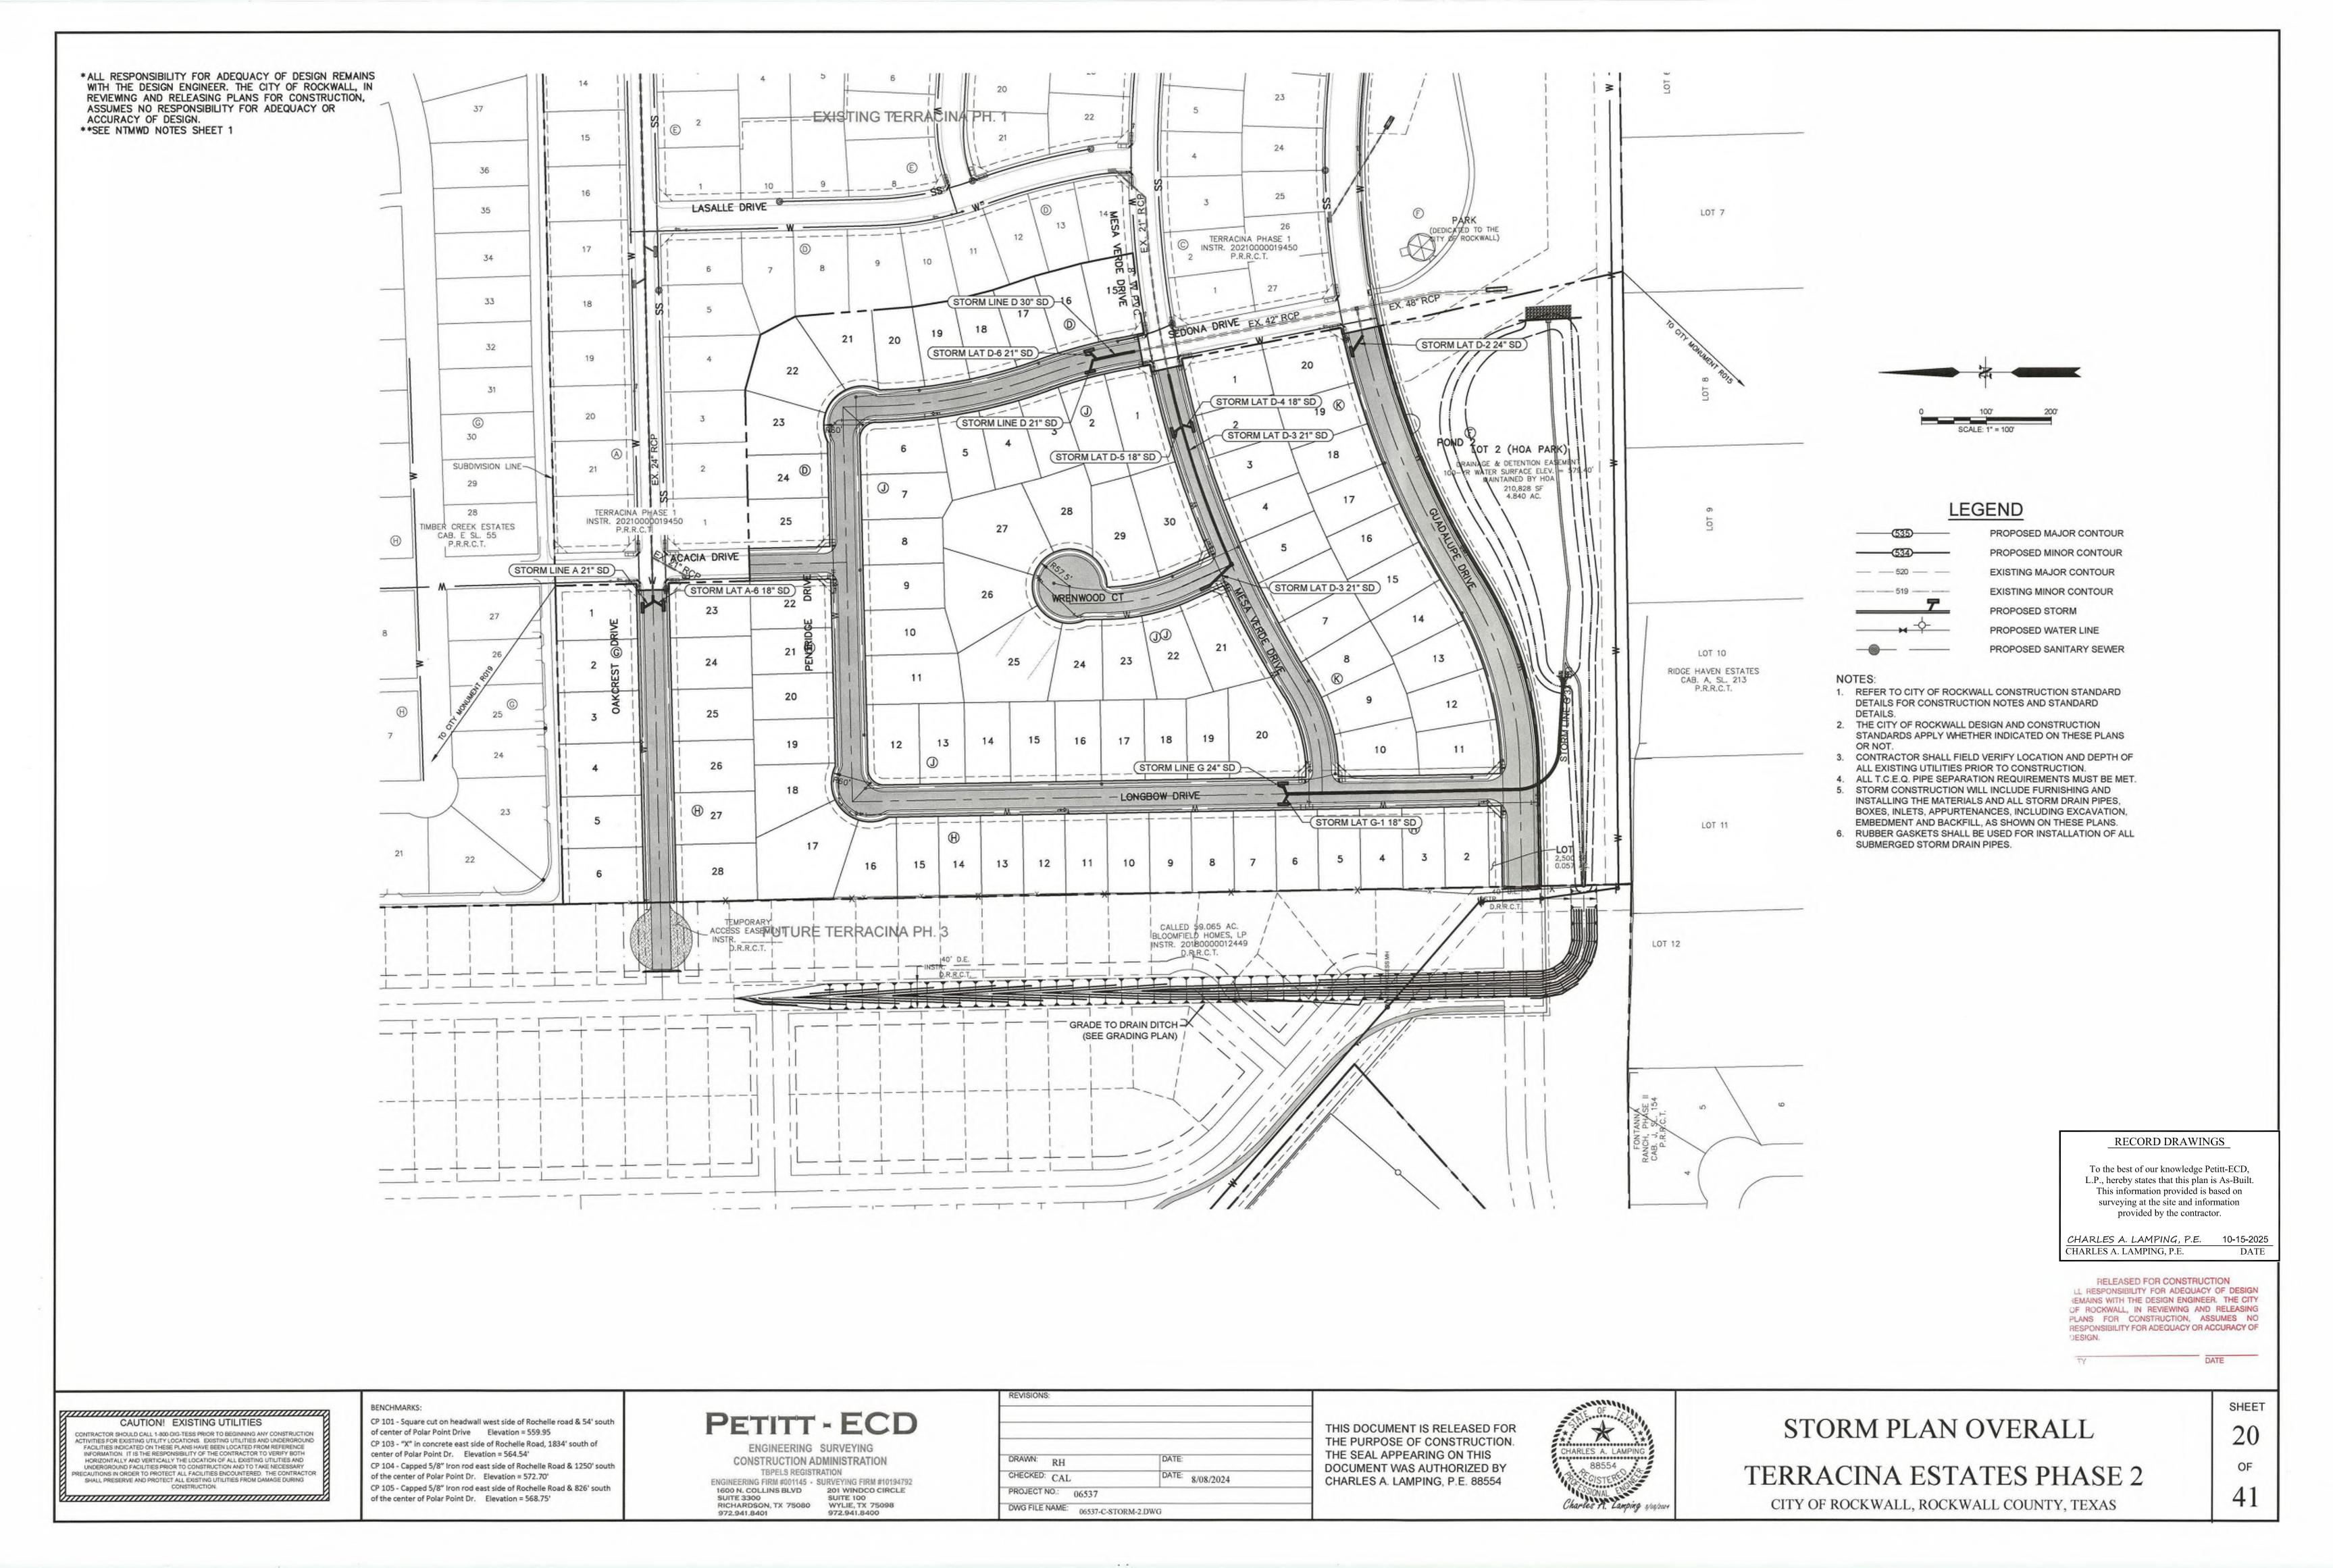

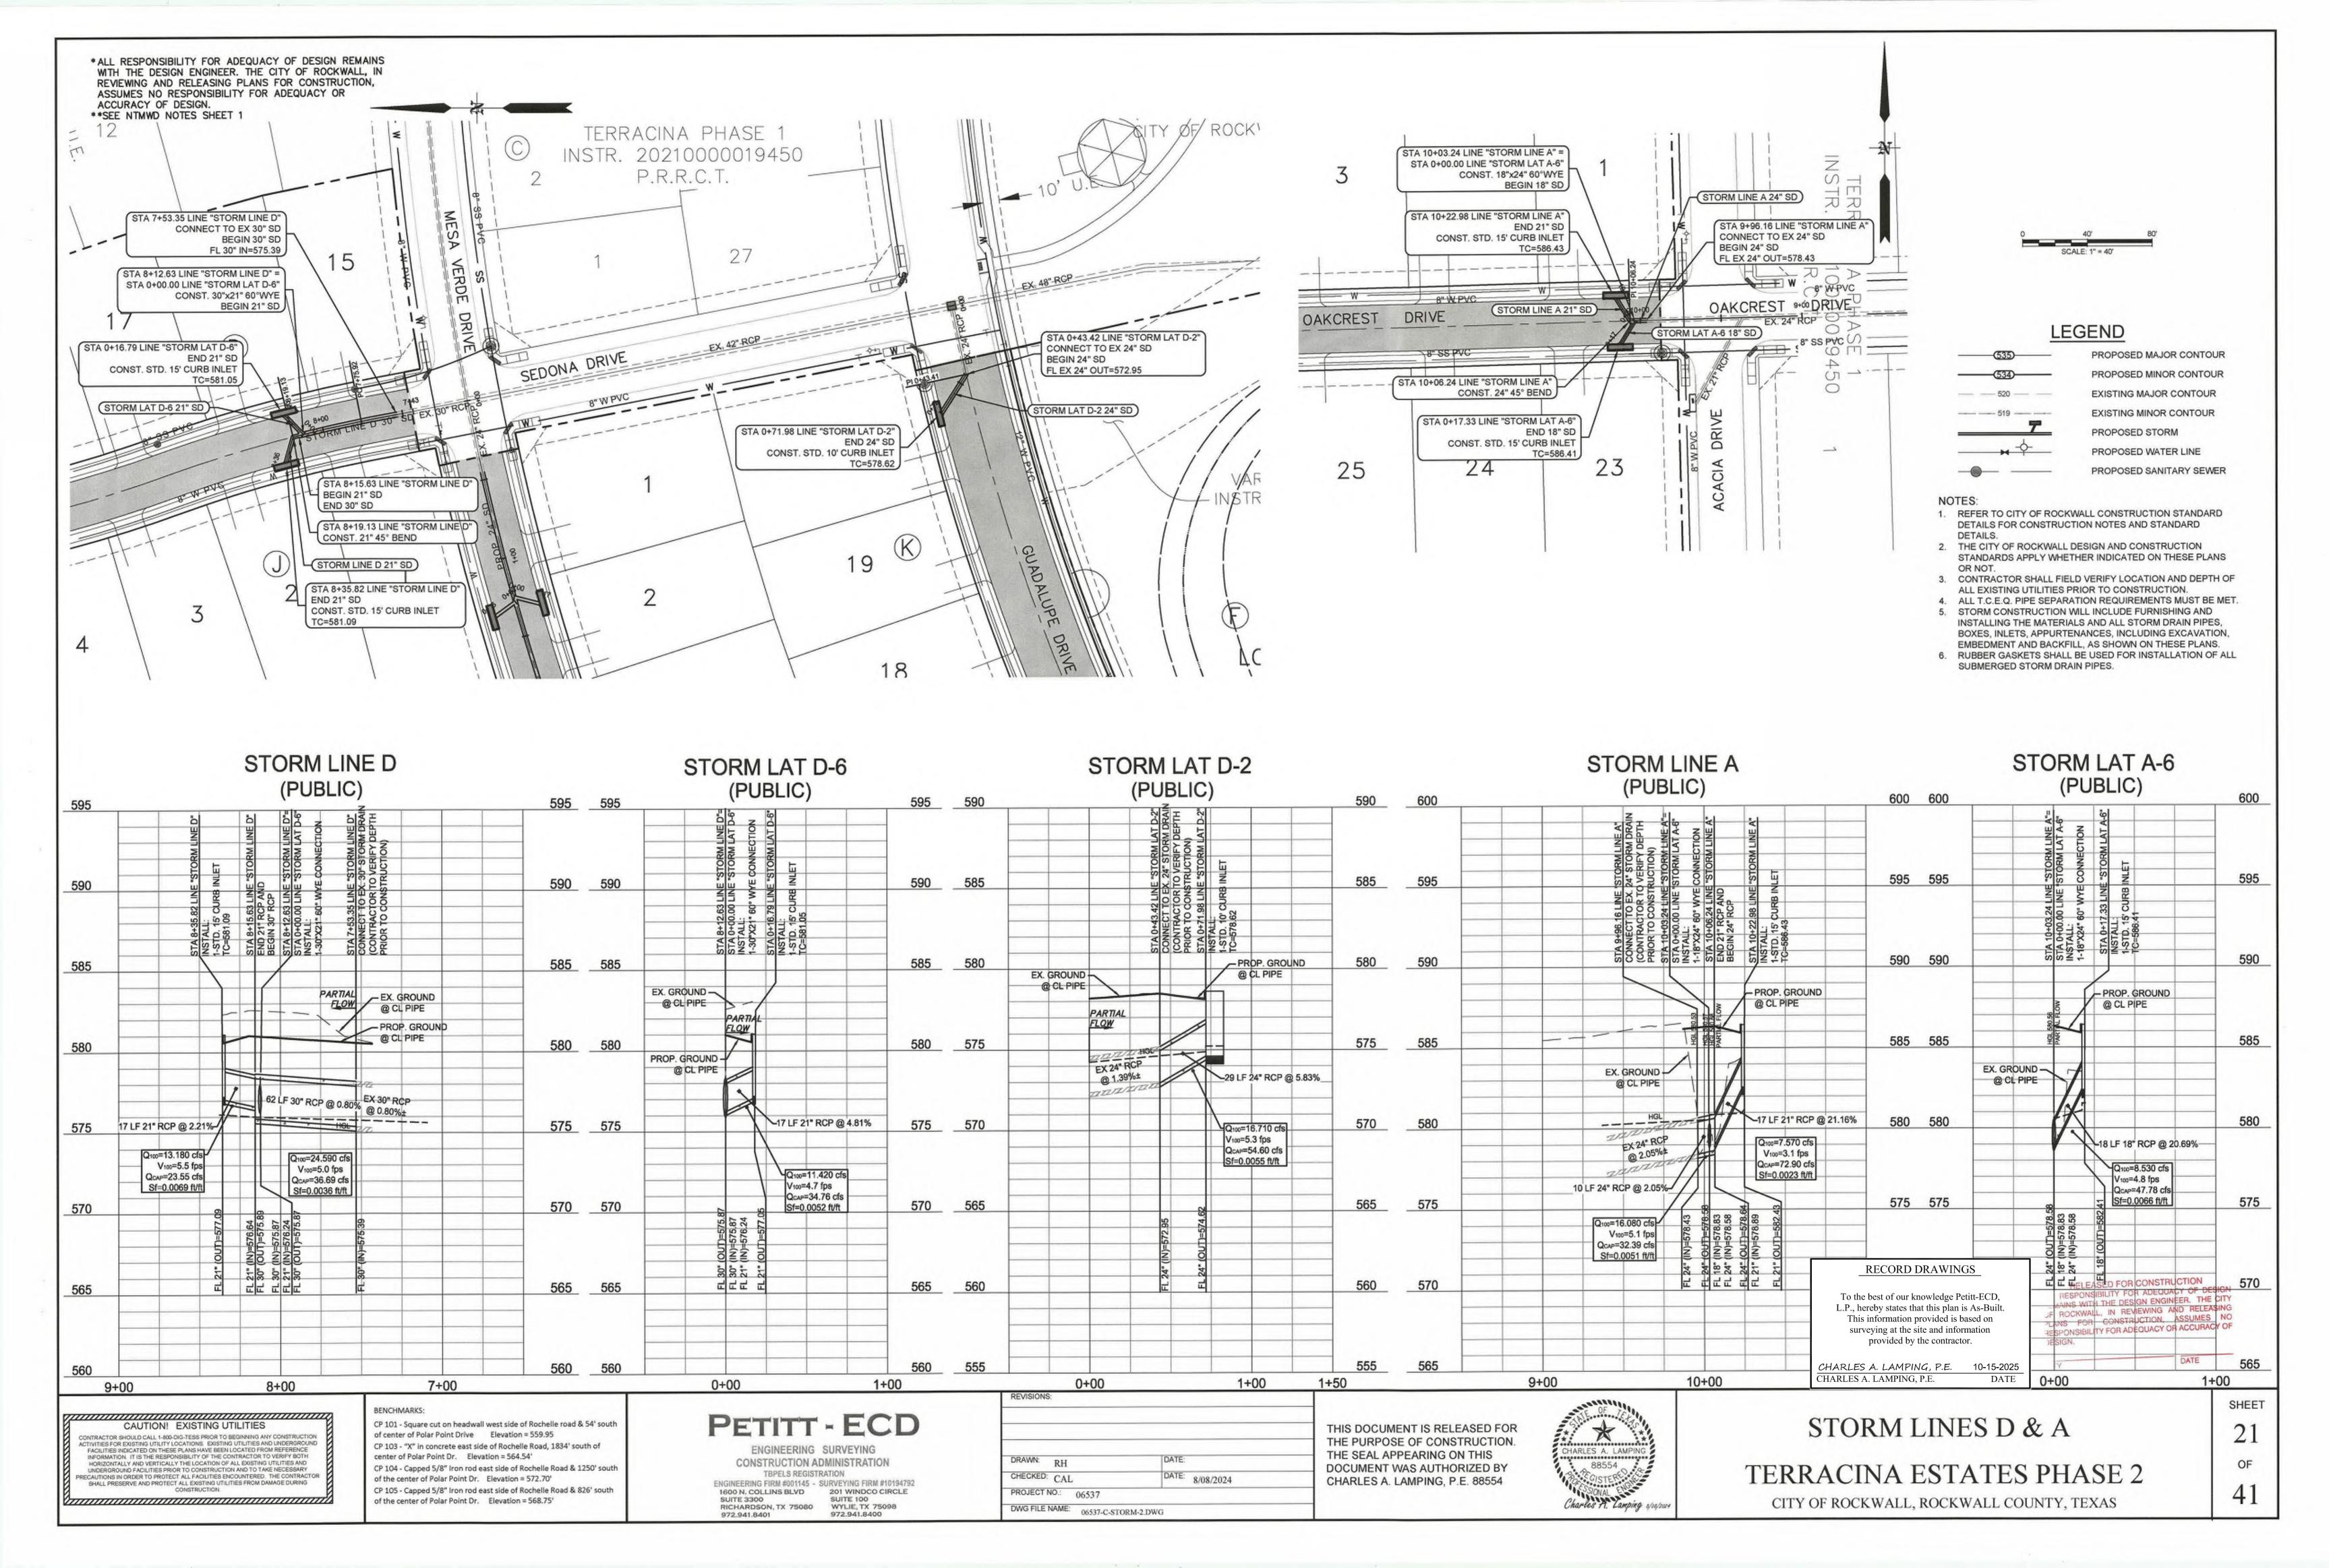


*ALL RESPONSIBILITY FOR ADEQUACY OF DESIGN REMAINS WITH THE DESIGN ENGINEER. THE CITY OF ROCKWALL, IN REVIEWING AND RELEASING PLANS FOR CONSTRUCTION, ASSUMES NO RESPONSIBILITY FOR ADEQUACY OR ACCURACY OF DESIGN. **SEE NTMWD NOTES SHEET 1

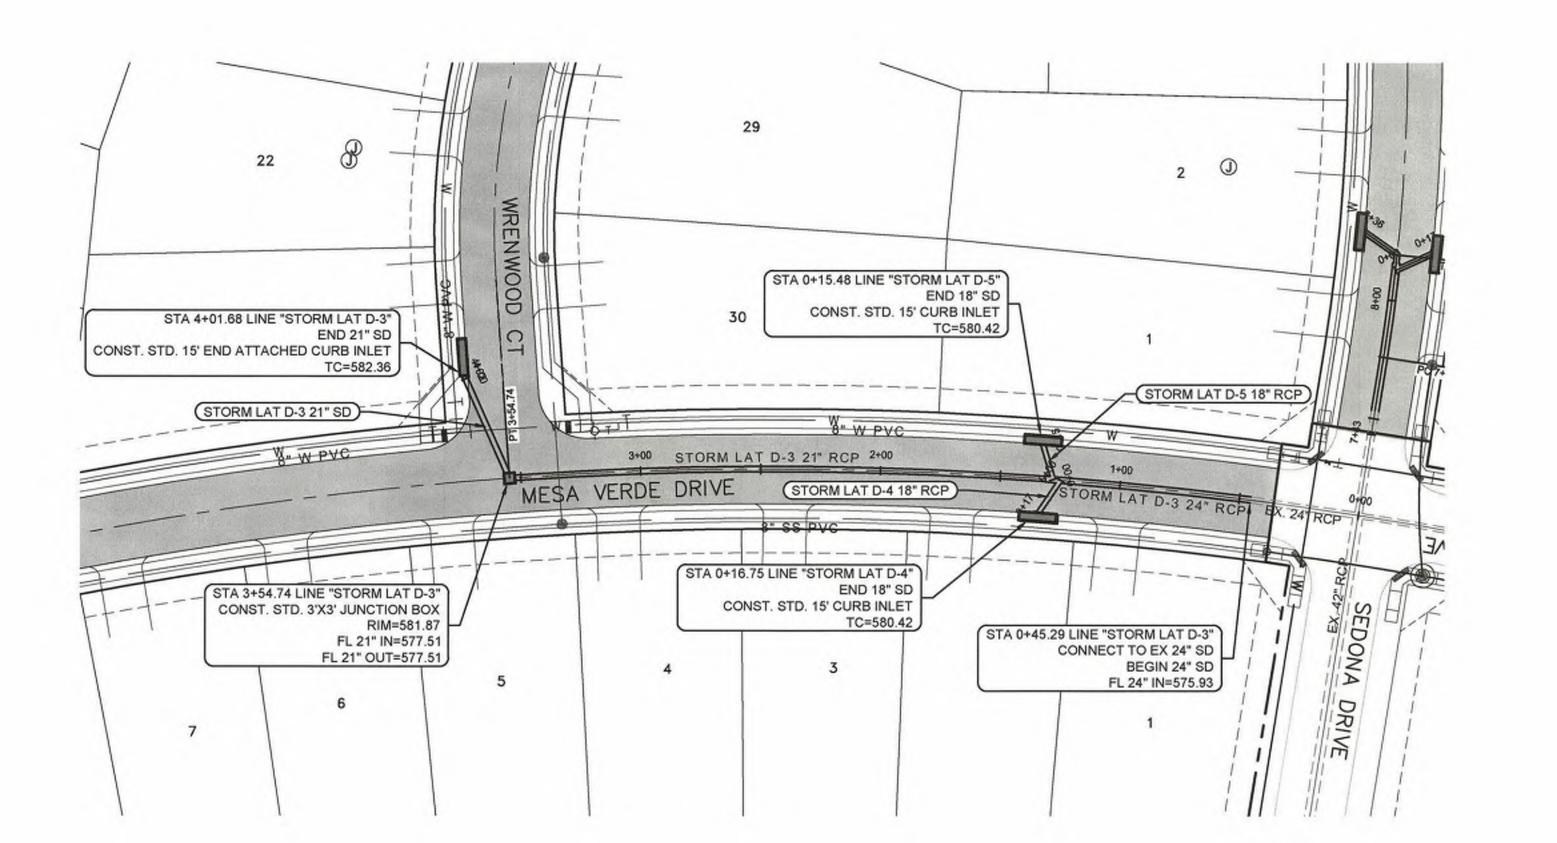




LEGEND

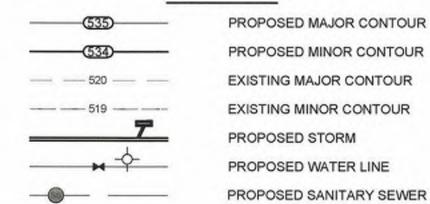

- 1. REFER TO CITY OF ROCKWALL CONSTRUCTION STANDARD DETAILS FOR CONSTRUCTION NOTES AND STANDARD DETAILS.
- 2. THE CITY OF ROCKWALL DESIGN AND CONSTRUCTION STANDARDS APPLY WHETHER INDICATED ON THESE PLANS
- 3. CONTRACTOR SHALL FIELD VERIFY LOCATION AND DEPTH OF
- ALL EXISTING UTILITIES PRIOR TO CONSTRUCTION. ALL T.C.E.Q. PIPE SEPARATION REQUIREMENTS MUST BE MET STORM CONSTRUCTION WILL INCLUDE FURNISHING AND INSTALLING THE MATERIALS AND ALL STORM DRAIN PIPES.
- EMBEDMENT AND BACKFILL, AS SHOWN ON THESE PLANS. RUBBER GASKETS SHALL BE USED FOR INSTALLATION OF ALL SUBMERGED STORM DRAIN PIPES.

BOXES, INLETS, APPURTENANCES, INCLUDING EXCAVATION,

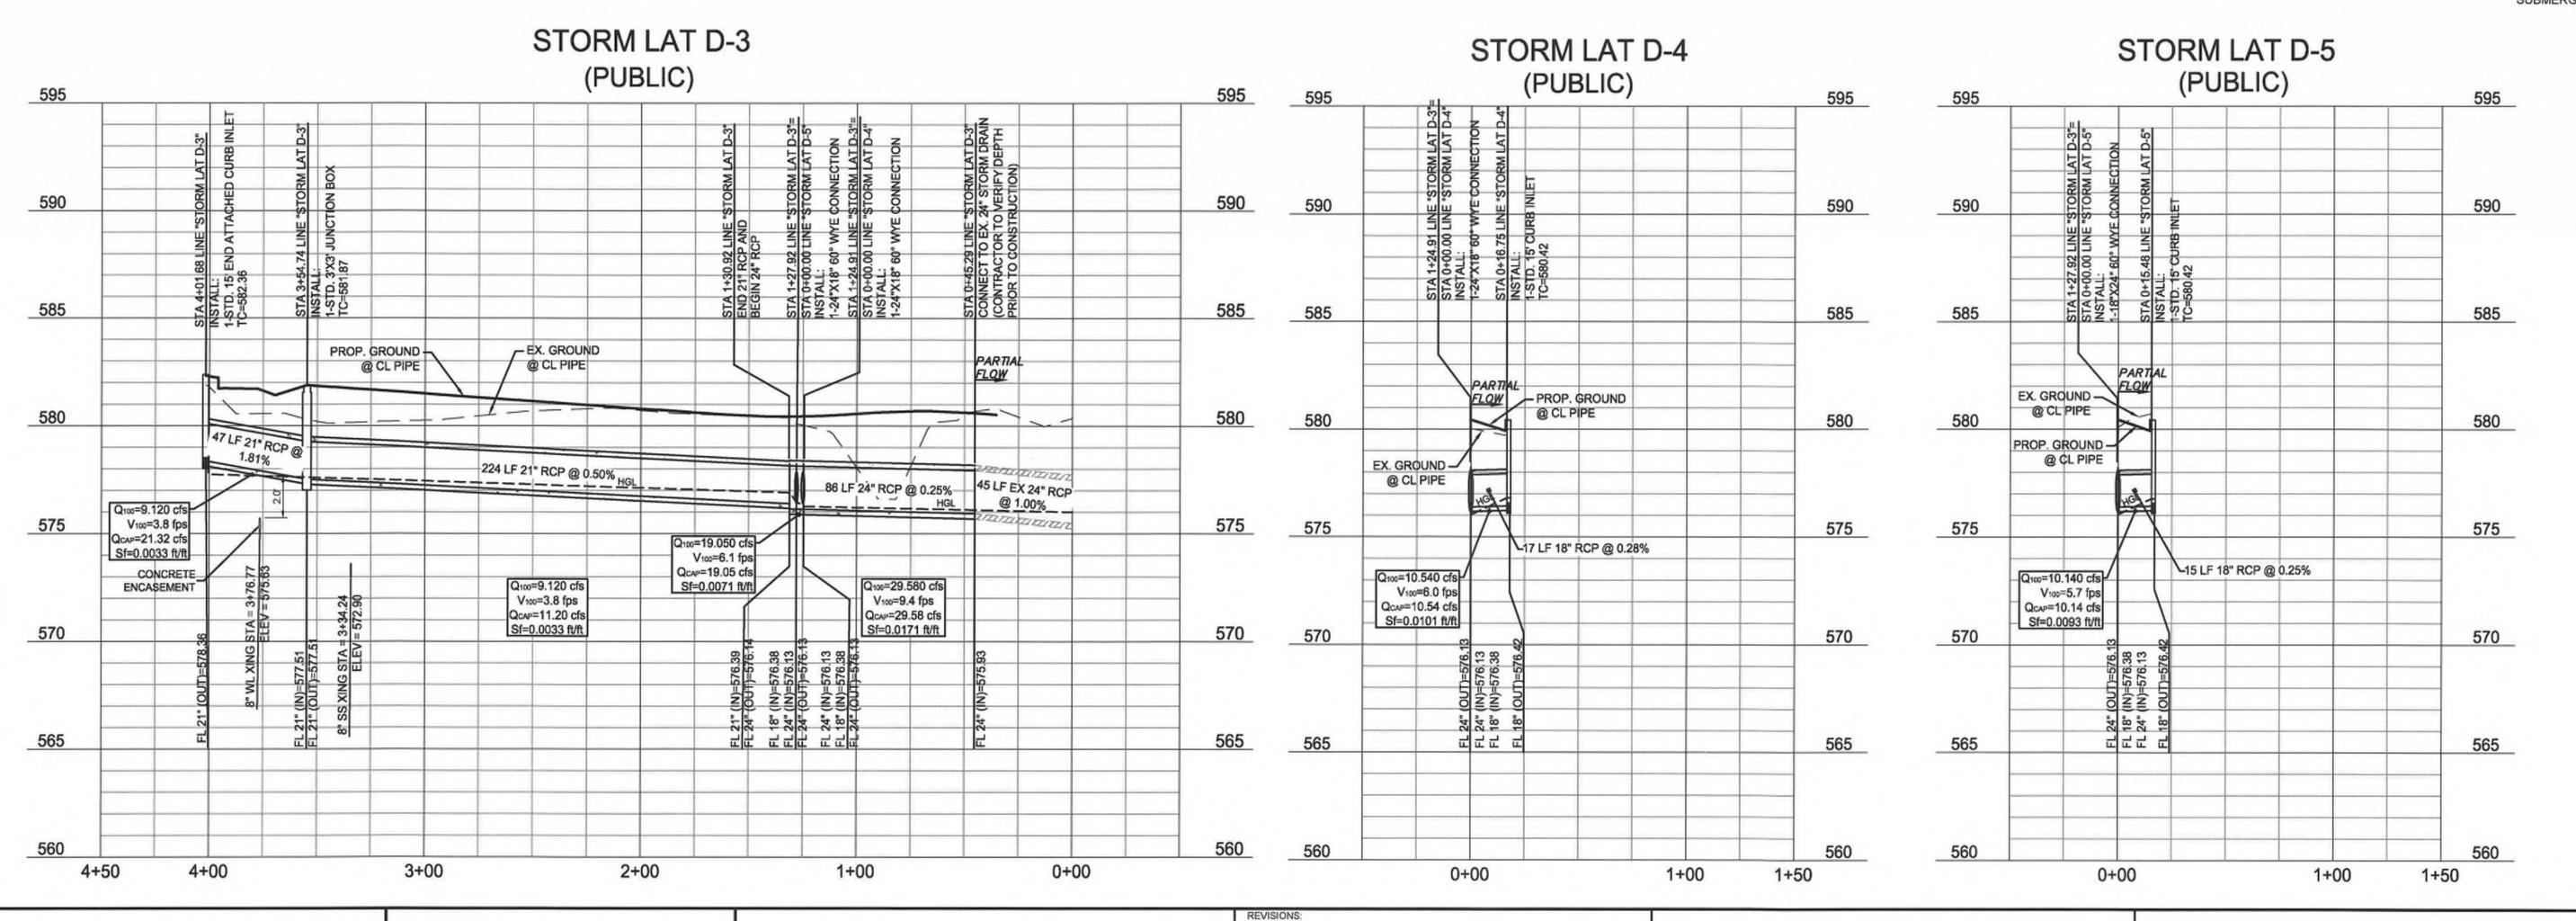

RECORD DRAWINGS

To the best of our knowledge Petitt-ECD, L.P., hereby states that this plan is As-Built. This information provided is based on surveying at the site and information provided by the contractor.

CHARLES A. LAMPING, P.E. 10-15-2025 CHARLES A. LAMPING, P.E.

RELEASED FOR CONSTRUCTION RESPONSIBILITY FOR ADEQUACY OF DESIGN AINS WITH THE DESIGN ENGINEER. THE CITY ROCKWALL, IN REVIEWING AND RELEASING ANS FOR CONSTRUCTION, ASSUMES NO ESPONSIBILITY FOR ADEQUACY OR ACCURACY OF

CAUTION! EXISTING UTILITIES

CONTRACTOR SHOULD CALL 1-800-DIG-TESS PRIOR TO BEGINNING ANY CONSTRUCTION ACTIVITIES FOR EXISTING UTILITY LOCATIONS. EXISTING UTILITIES AND UNDERGROUND FACILITIES INDICATED ON THESE PLANS HAVE BEEN LOCATED FROM REFERENCE INFORMATION. IT IS THE RESPONSIBILITY OF THE CONTRACTOR TO VERBY BOTH HORIZONTALLY AND VERTICALLY THE LOCATION OF ALL EXISTING UTILITIES AND UNDERGROUND FACILITIES PRIOR TO CONSTRUCTION AND TO TAKE NECESSARY PRECAUTIONS IN ORDER TO PROTECT ALL FACILITIES ENCOUNTERED. THE CONTRACTOR SHALL PRESERVE AND PROTECT ALL EXISTING UTILITIES FROM DAMAGE DURING

BENCHMARKS:

CP 101 - Square cut on headwall west side of Rochelle road & 54' south of center of Polar Point Drive Elevation = 559.95 CP 103 - "X" in concrete east side of Rochelle Road, 1834' south of center of Polar Point Dr. Elevation = 564.54' CP 104 - Capped 5/8" Iron rod east side of Rochelle Road & 1250' south of the center of Polar Point Dr. Elevation = 572.70'

CP 105 - Capped 5/8" Iron rod east side of Rochelle Road & 826' south

of the center of Polar Point Dr. Elevation = 568.75°

PETITT - ECD

ENGINEERING SURVEYING CONSTRUCTION ADMINISTRATION TBPELS REGISTRATION ENGINEERING FIRM #001145 - SURVEYING FIRM #10194792 1600 N. COLLINS BLVD 201 WINDCO CIRCLE SUITE 3300 SUITE 100 RICHARDSON, TX 75080 WYLIE, TX 75098

DRAWN: RH CHECKED: CAL DATE: 8/08/2024 PROJECT NO.: 06537 DWG FILE NAME: 06537-C-STORM-2.DWG

THIS DOCUMENT IS RELEASED FOR THE PURPOSE OF CONSTRUCTION THE SEAL APPEARING ON THIS DOCUMENT WAS AUTHORIZED BY CHARLES A. LAMPING, P.E. 88554




STORM LINE D-3 D-4 & D-5

TERRACINA ESTATES PHASE 2

CITY OF ROCKWALL, ROCKWALL COUNTY, TEXAS


OF

SHEET

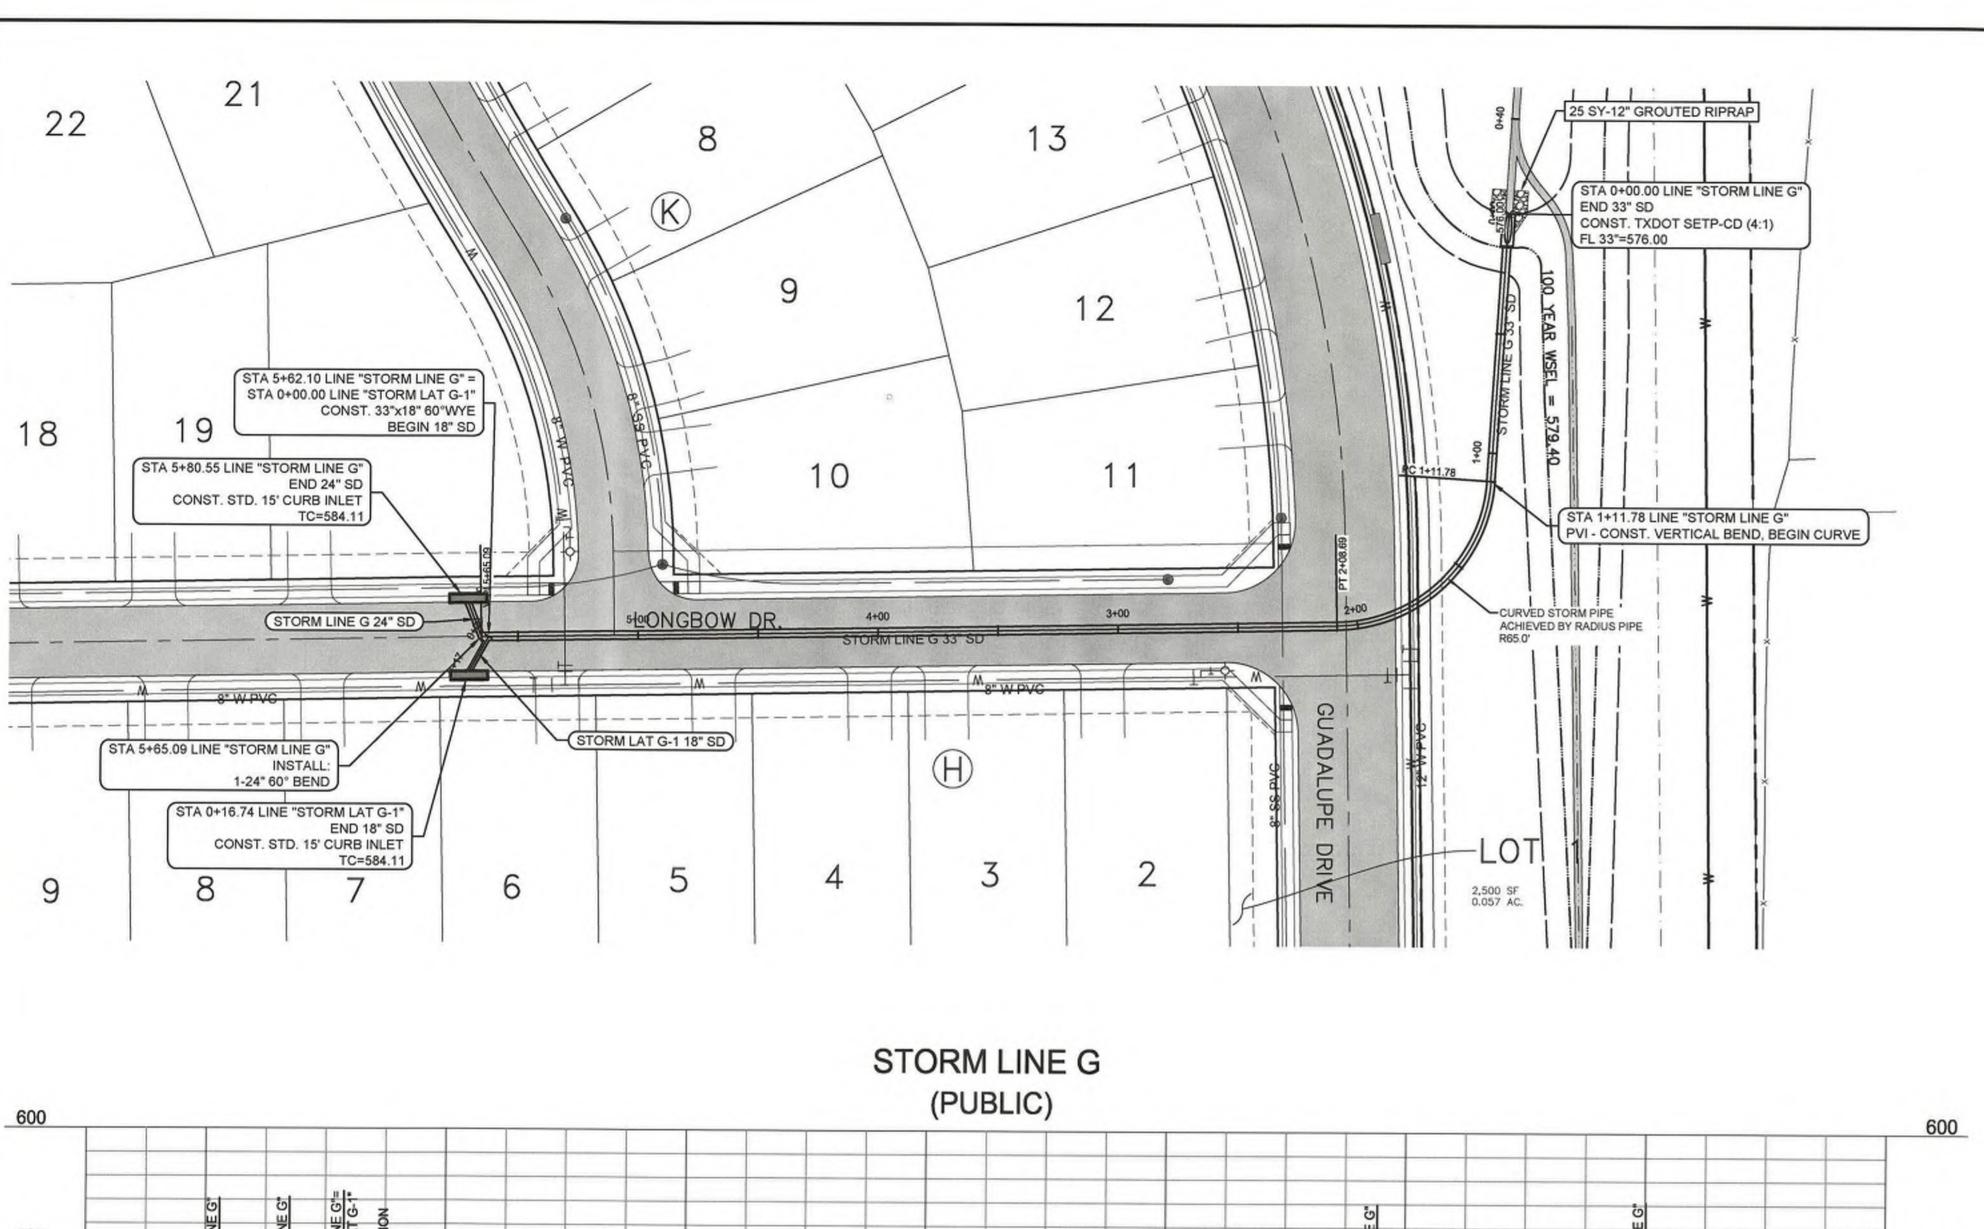


*ALL RESPONSIBILITY FOR ADEQUACY OF DESIGN REMAINS WITH THE DESIGN ENGINEER. THE CITY OF ROCKWALL, IN REVIEWING AND RELEASING PLANS FOR CONSTRUCTION, ASSUMES NO RESPONSIBILITY FOR ADEQUACY OR ACCURACY OF DESIGN.

**SEE NTMWD NOTES SHEET 1

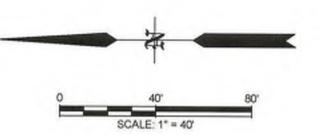



LEGEND

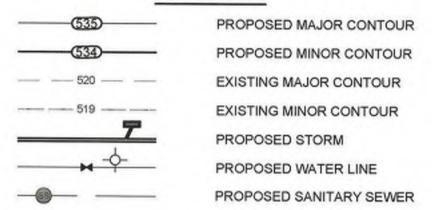

NOTES:

- 1. REFER TO CITY OF ROCKWALL CONSTRUCTION STANDARD DETAILS FOR CONSTRUCTION NOTES AND STANDARD
- THE CITY OF ROCKWALL DESIGN AND CONSTRUCTION STANDARDS APPLY WHETHER INDICATED ON THESE PLANS
- 3. CONTRACTOR SHALL FIELD VERIFY LOCATION AND DEPTH OF ALL EXISTING UTILITIES PRIOR TO CONSTRUCTION.
- ALL T.C.E.Q. PIPE SEPARATION REQUIREMENTS MUST BE MET. STORM CONSTRUCTION WILL INCLUDE FURNISHING AND INSTALLING THE MATERIALS AND ALL STORM DRAIN PIPES. BOXES, INLETS, APPURTENANCES, INCLUDING EXCAVATION,
- EMBEDMENT AND BACKFILL, AS SHOWN ON THESE PLANS. RUBBER GASKETS SHALL BE USED FOR INSTALLATION OF ALL

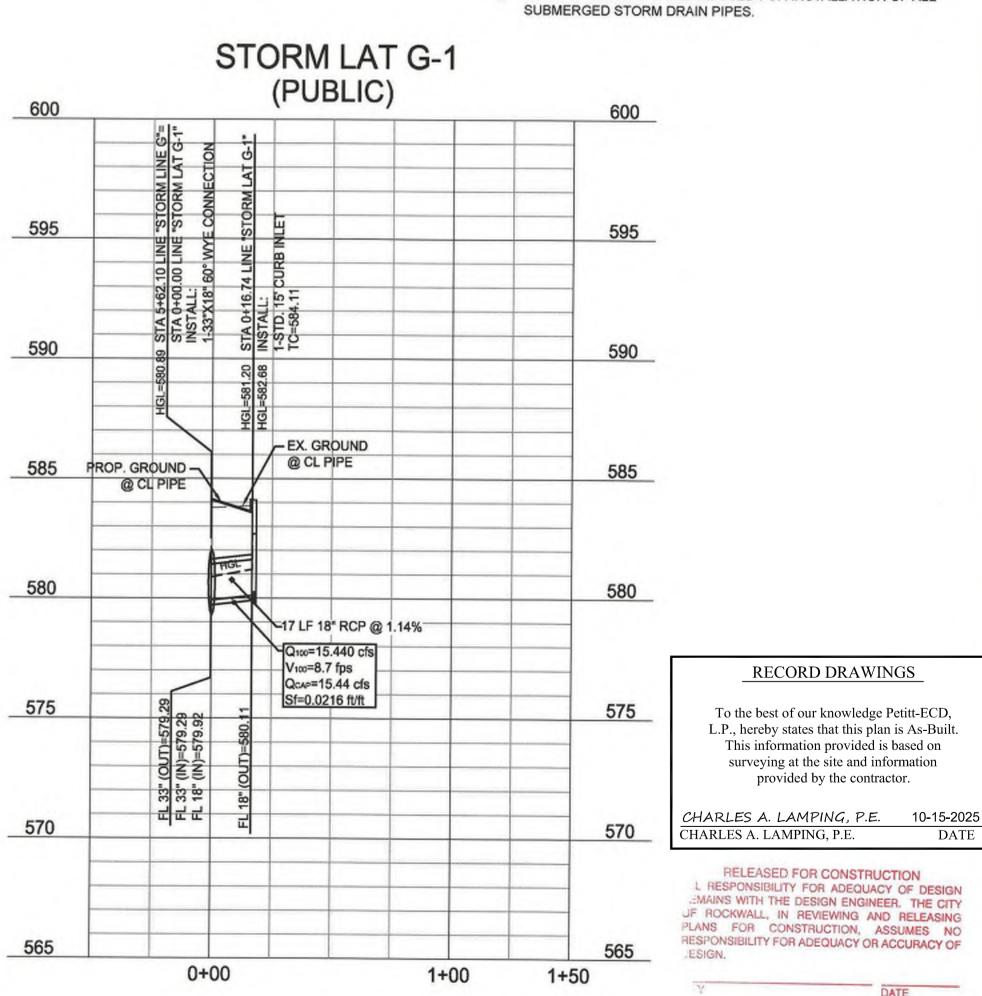

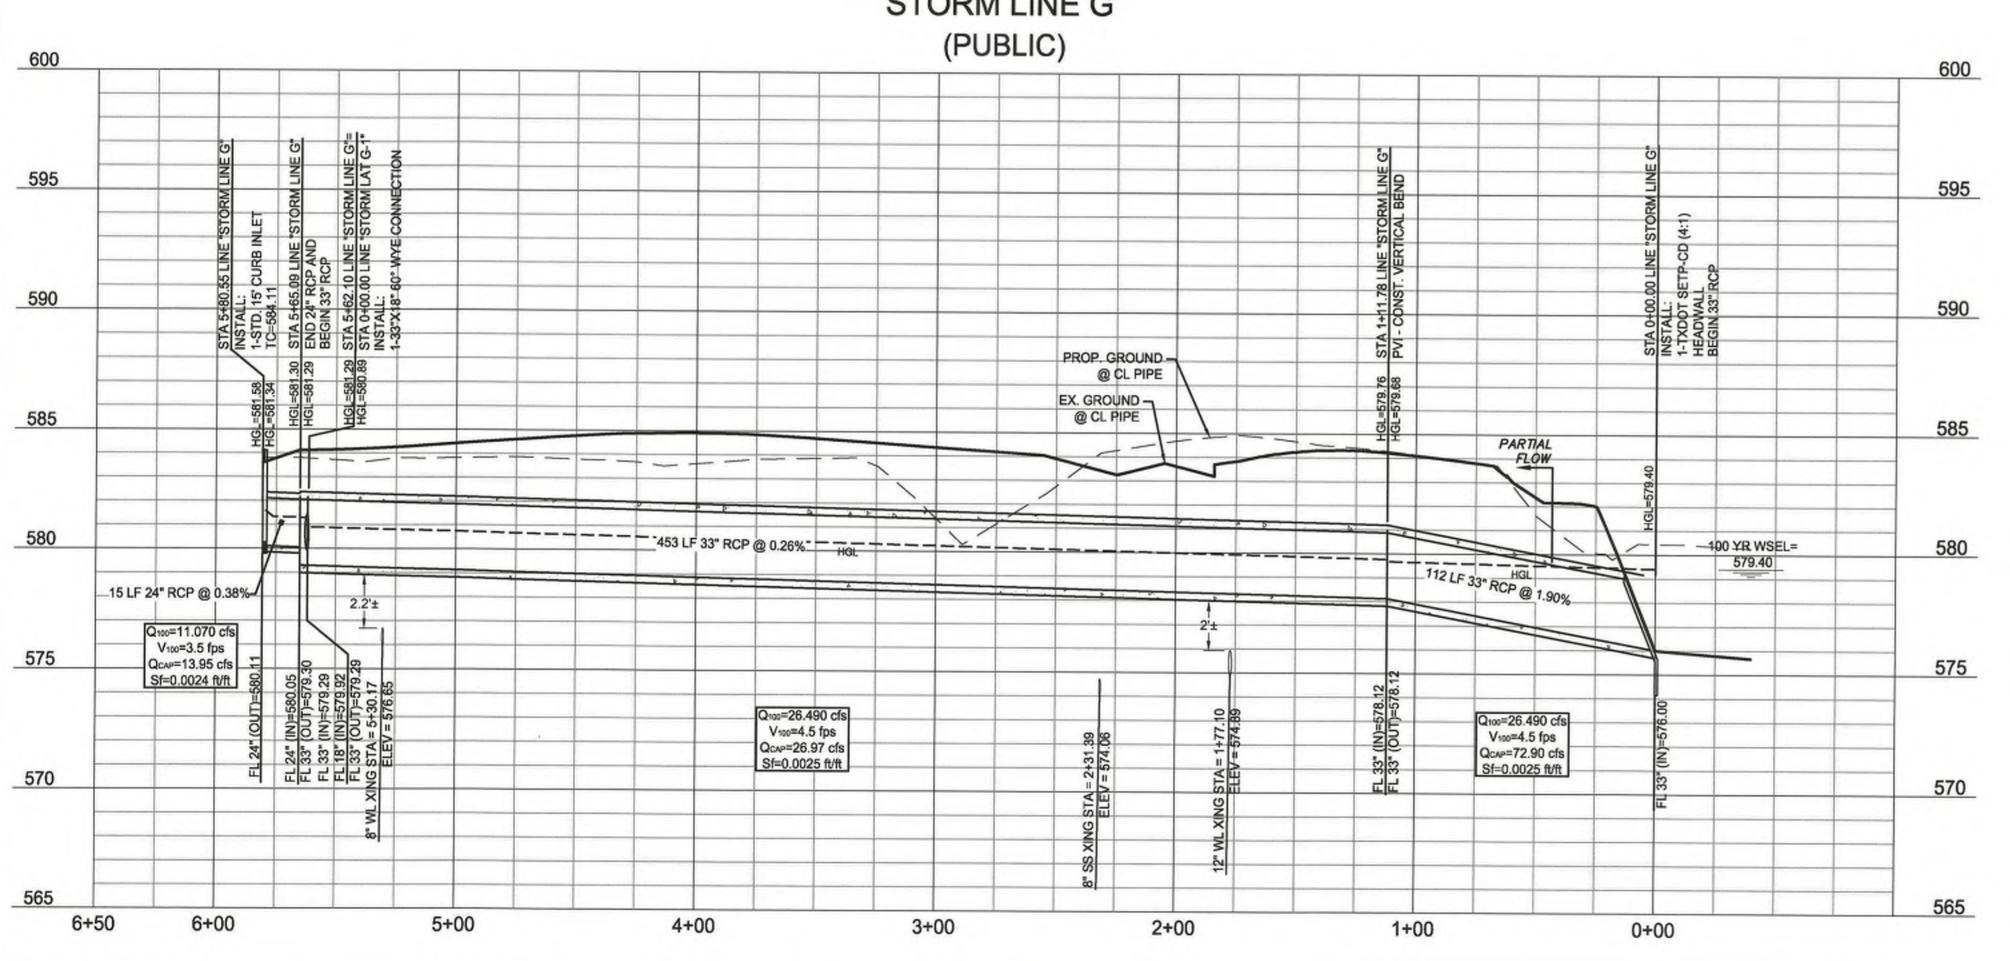

CAUTION! EXISTING UTILITIES

CONTRACTOR SHOULD CALL 1-800-DIG-TESS PRIOR TO BEGINNING ANY CONSTRUCTION ACTIVITIES FOR EXISTING UTILITY LOCATIONS. EXISTING UTILITIES AND UNDERGROUND FACILITIES INDICATED ON THESE PLANS HAVE BEEN LOCATED FROM REFERENCE INFORMATION. IT IS THE RESPONSIBILITY OF THE CONTRACTOR TO VERIFY BOTH HORIZONTALLY AND VERTICALLY THE LOCATION OF ALL EXISTING UTILITIES AND UNDERGROUND FACILITIES PRIOR TO CONSTRUCTION AND TO TAKE NECESSARY PRECAUTIONS IN ORDER TO PROTECT ALL FACILITIES ENCOUNTERED. THE CONTRACTOR SHALL PRESERVE AND PROTECT ALL EXISTING UTILITIES FROM DAMAGE DURING CONSTRUCTION.

BENCHMARKS:

CP 101 - Square cut on headwall west side of Rochelle road & 54' south of center of Polar Point Drive Elevation = 559.95 CP 103 - "X" in concrete east side of Rochelle Road, 1834' south of center of Polar Point Dr. Elevation = 564.54' CP 104 - Capped 5/8" Iron rod east side of Rochelle Road & 1250' south of the center of Polar Point Dr. Elevation = 572.70' CP 105 - Capped 5/8" Iron rod east side of Rochelle Road & 826' south

of the center of Polar Point Dr. Elevation = 568.75'

PETITT - ECD

ENGINEERING SURVEYING CONSTRUCTION ADMINISTRATION TBPELS REGISTRATION ENGINEERING FIRM #001145 - SURVEYING FIRM #10194792 1600 N. COLLINS BLVD 201 WINDCO CIRCLE SUITE 3300 RICHARDSON, TX 75080 SUITE 100 WYLIE, TX 75098

DRAWN: RH CHECKED: CAL DATE: 8/08/2024 PROJECT NO.: 06537 DWG FILE NAME: 06537-C-STORM-2.DWG

THIS DOCUMENT IS RELEASED FOR THE PURPOSE OF CONSTRUCTION. THE SEAL APPEARING ON THIS DOCUMENT WAS AUTHORIZED BY CHARLES A. LAMPING, P.E. 88554



STORM LINE G


TERRACINA ESTATES PHASE 2

CITY OF ROCKWALL, ROCKWALL COUNTY, TEXAS

OF

SHEET

provided by the contractor.

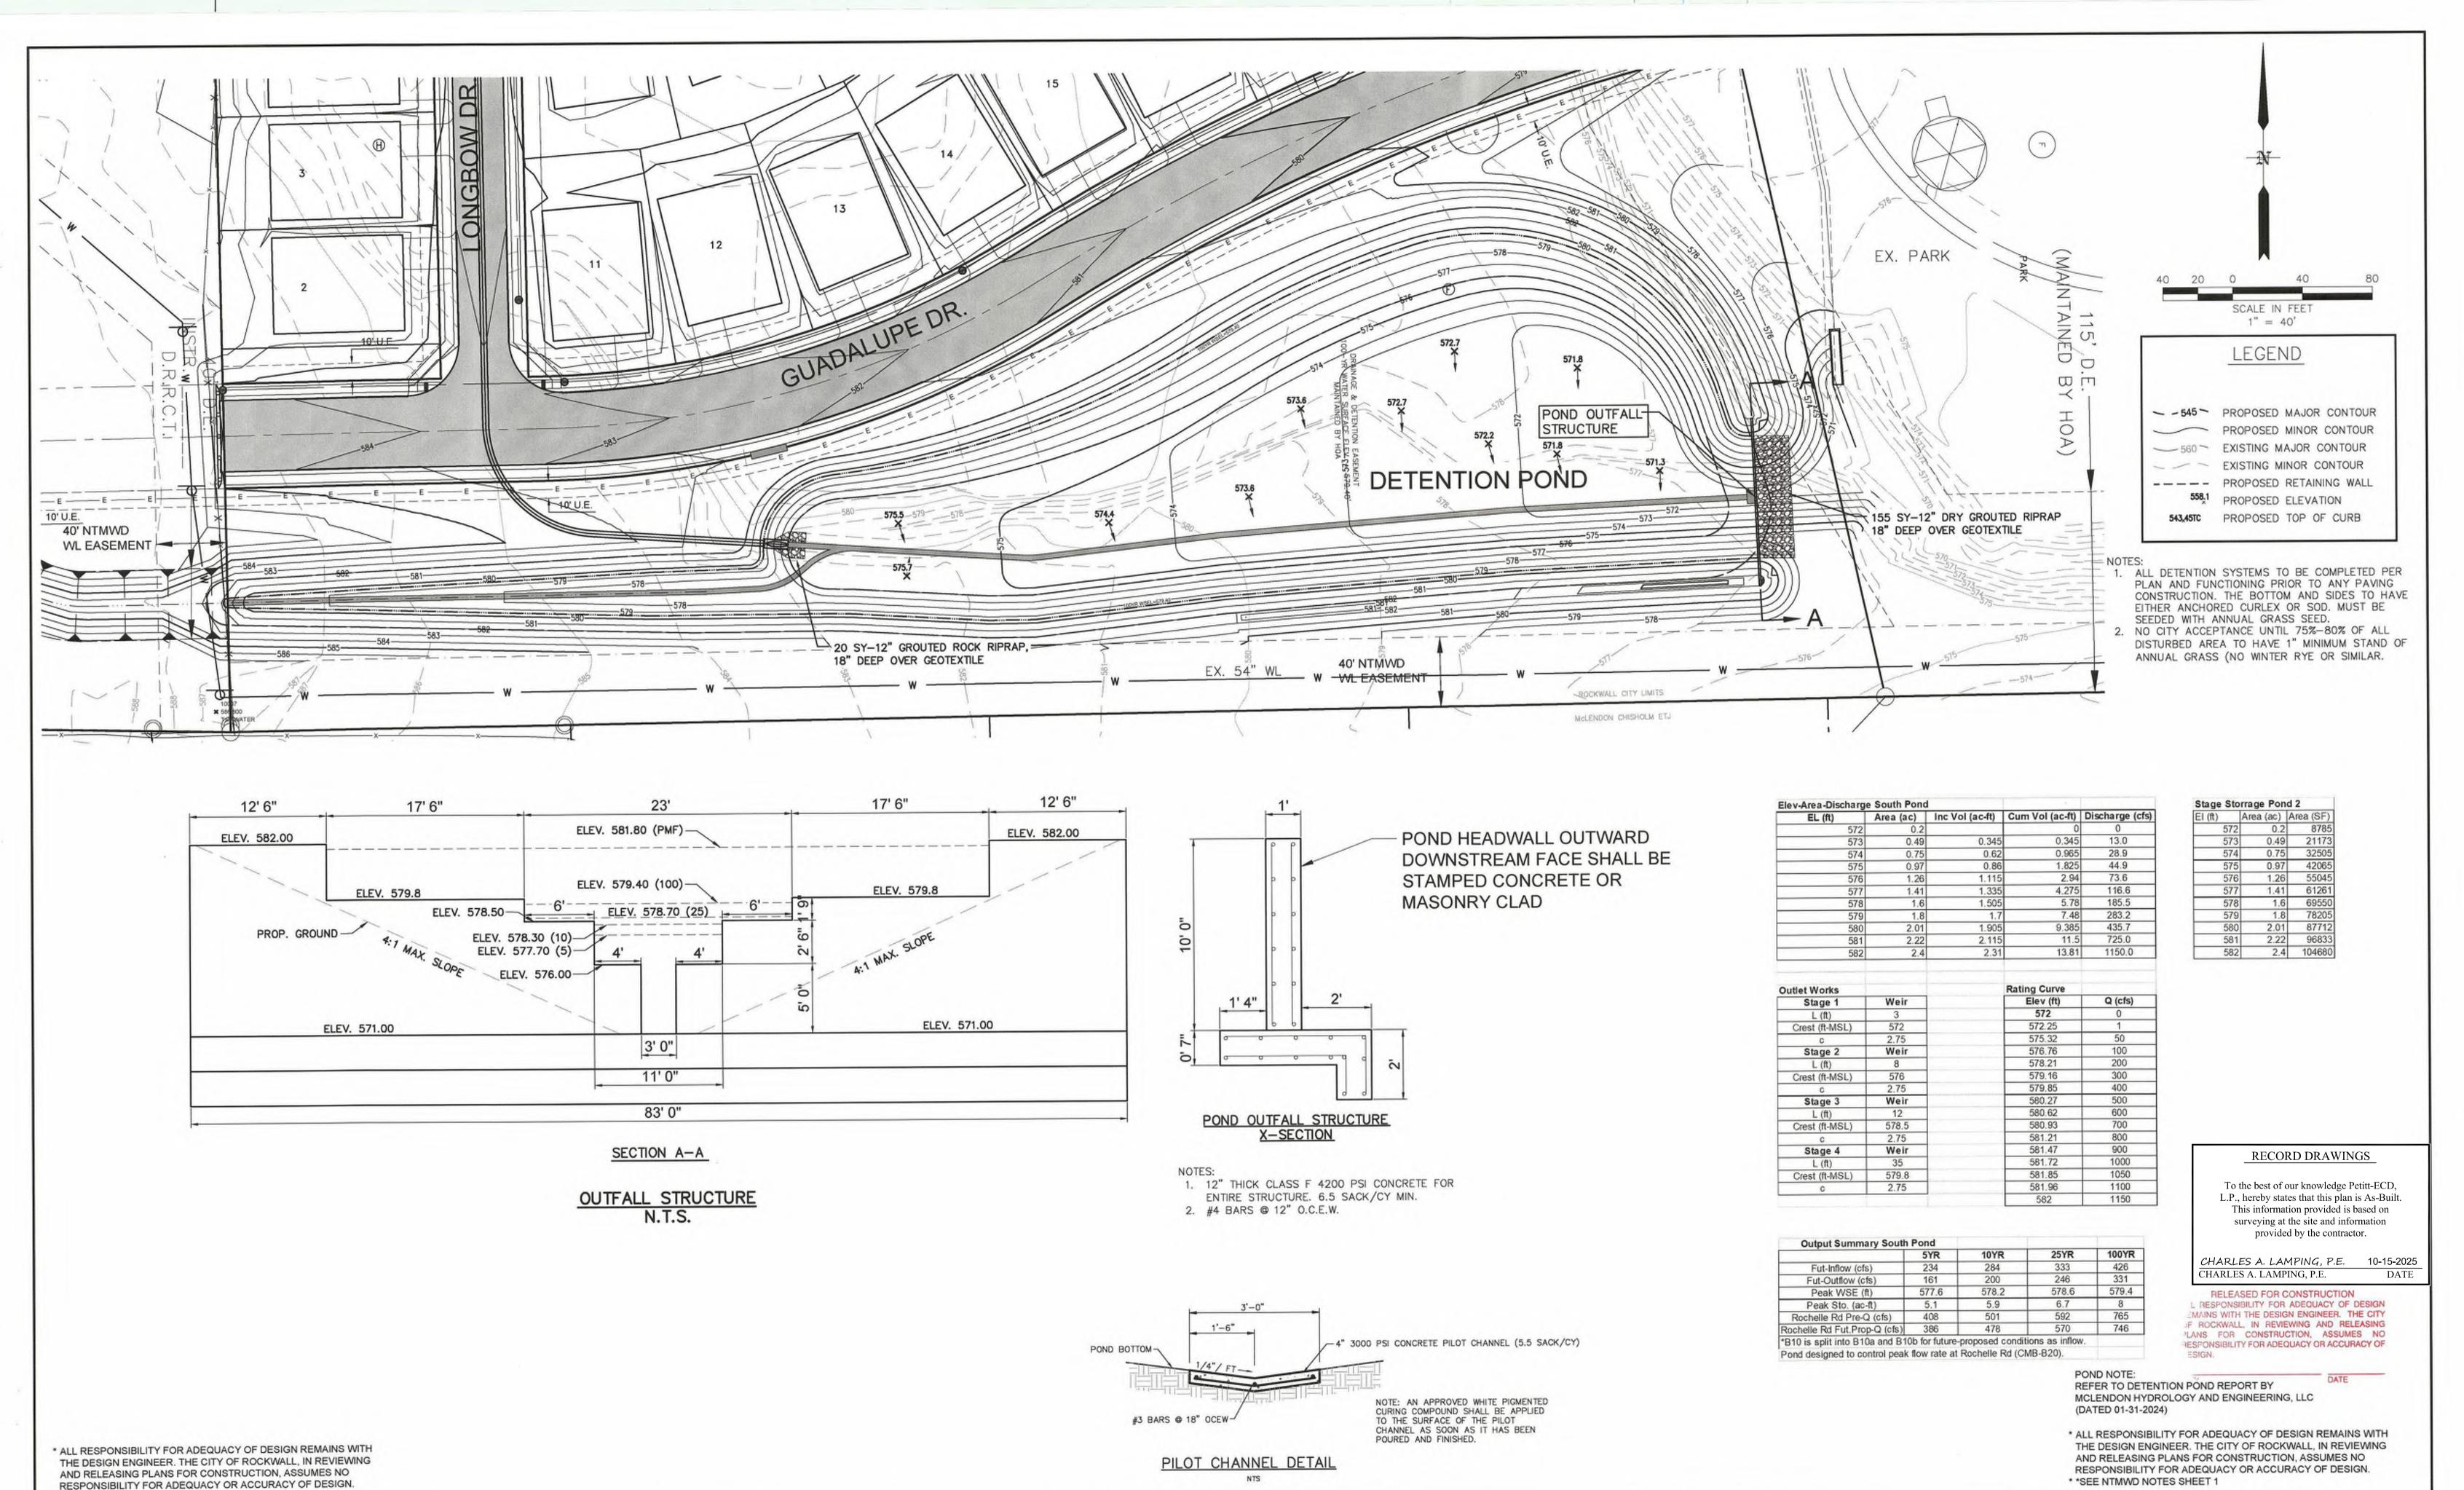

CP 101 - Square cut on headwall west side of Rochelle road & 54' south CAUTION! EXISTING UTILITIES of center of Polar Point Drive Elevation = 559.95 CONTRACTOR SHOULD CALL 1-800-DIG-TESS PRIOR TO BEGINNING ANY CONSTRUCTION ACTIVITIES FOR EXISTING UTILITY LOCATIONS. EXISTING UTILITIES AND UNDERGROUND FACILITIES INDICATED ON THESE PLANS HAVE BEEN LOCATED FROM REFEREINCE INFORMATION. IT IS THE RESPONSIBILITY OF THE CONTRACTOR TO VERIEY BOTH CP 103 - "X" in concrete east side of Rochelle Road, 1834' south of center of Polar Point Dr. Elevation = 564.54' HORIZONTALLY AND VERTICALLY THE LOCATION OF ALL EXISTING UTILITIES AND UNDERGROUND FACILITIES PRIOR TO CONSTRUCTION AND TO TAKE NECESSARY CAUTIONS IN ORDER TO PROTECT ALL FACILITIES ENCOUNTERED. THE CONTRACTOR CP 104 - Capped 5/8" Iron rod east side of Rochelle Road & 1250' south

BENCHMARKS:

of the center of Polar Point Dr. Elevation = 572.70'

of the center of Polar Point Dr. Elevation = 568.75'

CP 105 - Capped 5/8" Iron rod east side of Rochelle Road & 826' south

* SEE "NTMWD NOTES" SHEET 1

SHALL PRESERVE AND PROTECT ALL EXISTING UTILITIES FROM DAMAGE DURING CONSTRUCTION.

PETITT - ECD

CONSTRUCTION ADMINISTRATION TBPELS REGISTRATION ENGINEERING FIRM #001145 - SURVEYING FIRM #10194792 201 WINDCO CIRCLE 1600 N. COLLINS BLVD RICHARDSON, TX 75080

10.10		
DRAWN: RH	DATE:	
CHECKED: CAL	DATE: 8/08/2024	
PROJECT NO.: 06537	· ·	
DWG FILE NAME: 06537-C-DET	POND.DWG	


THIS DOCUMENT IS RELEASED FOR THE PURPOSE OF CONSTRUCTION. THE SEAL APPEARING ON THIS DOCUMENT WAS AUTHORIZED BY CHARLES A. LAMPING, P.E. 88554





DETENTION POND


TERRACINA ESTATES PHASE 2


CITY OF ROCKWALL, ROCKWALL COUNTY, TEXAS

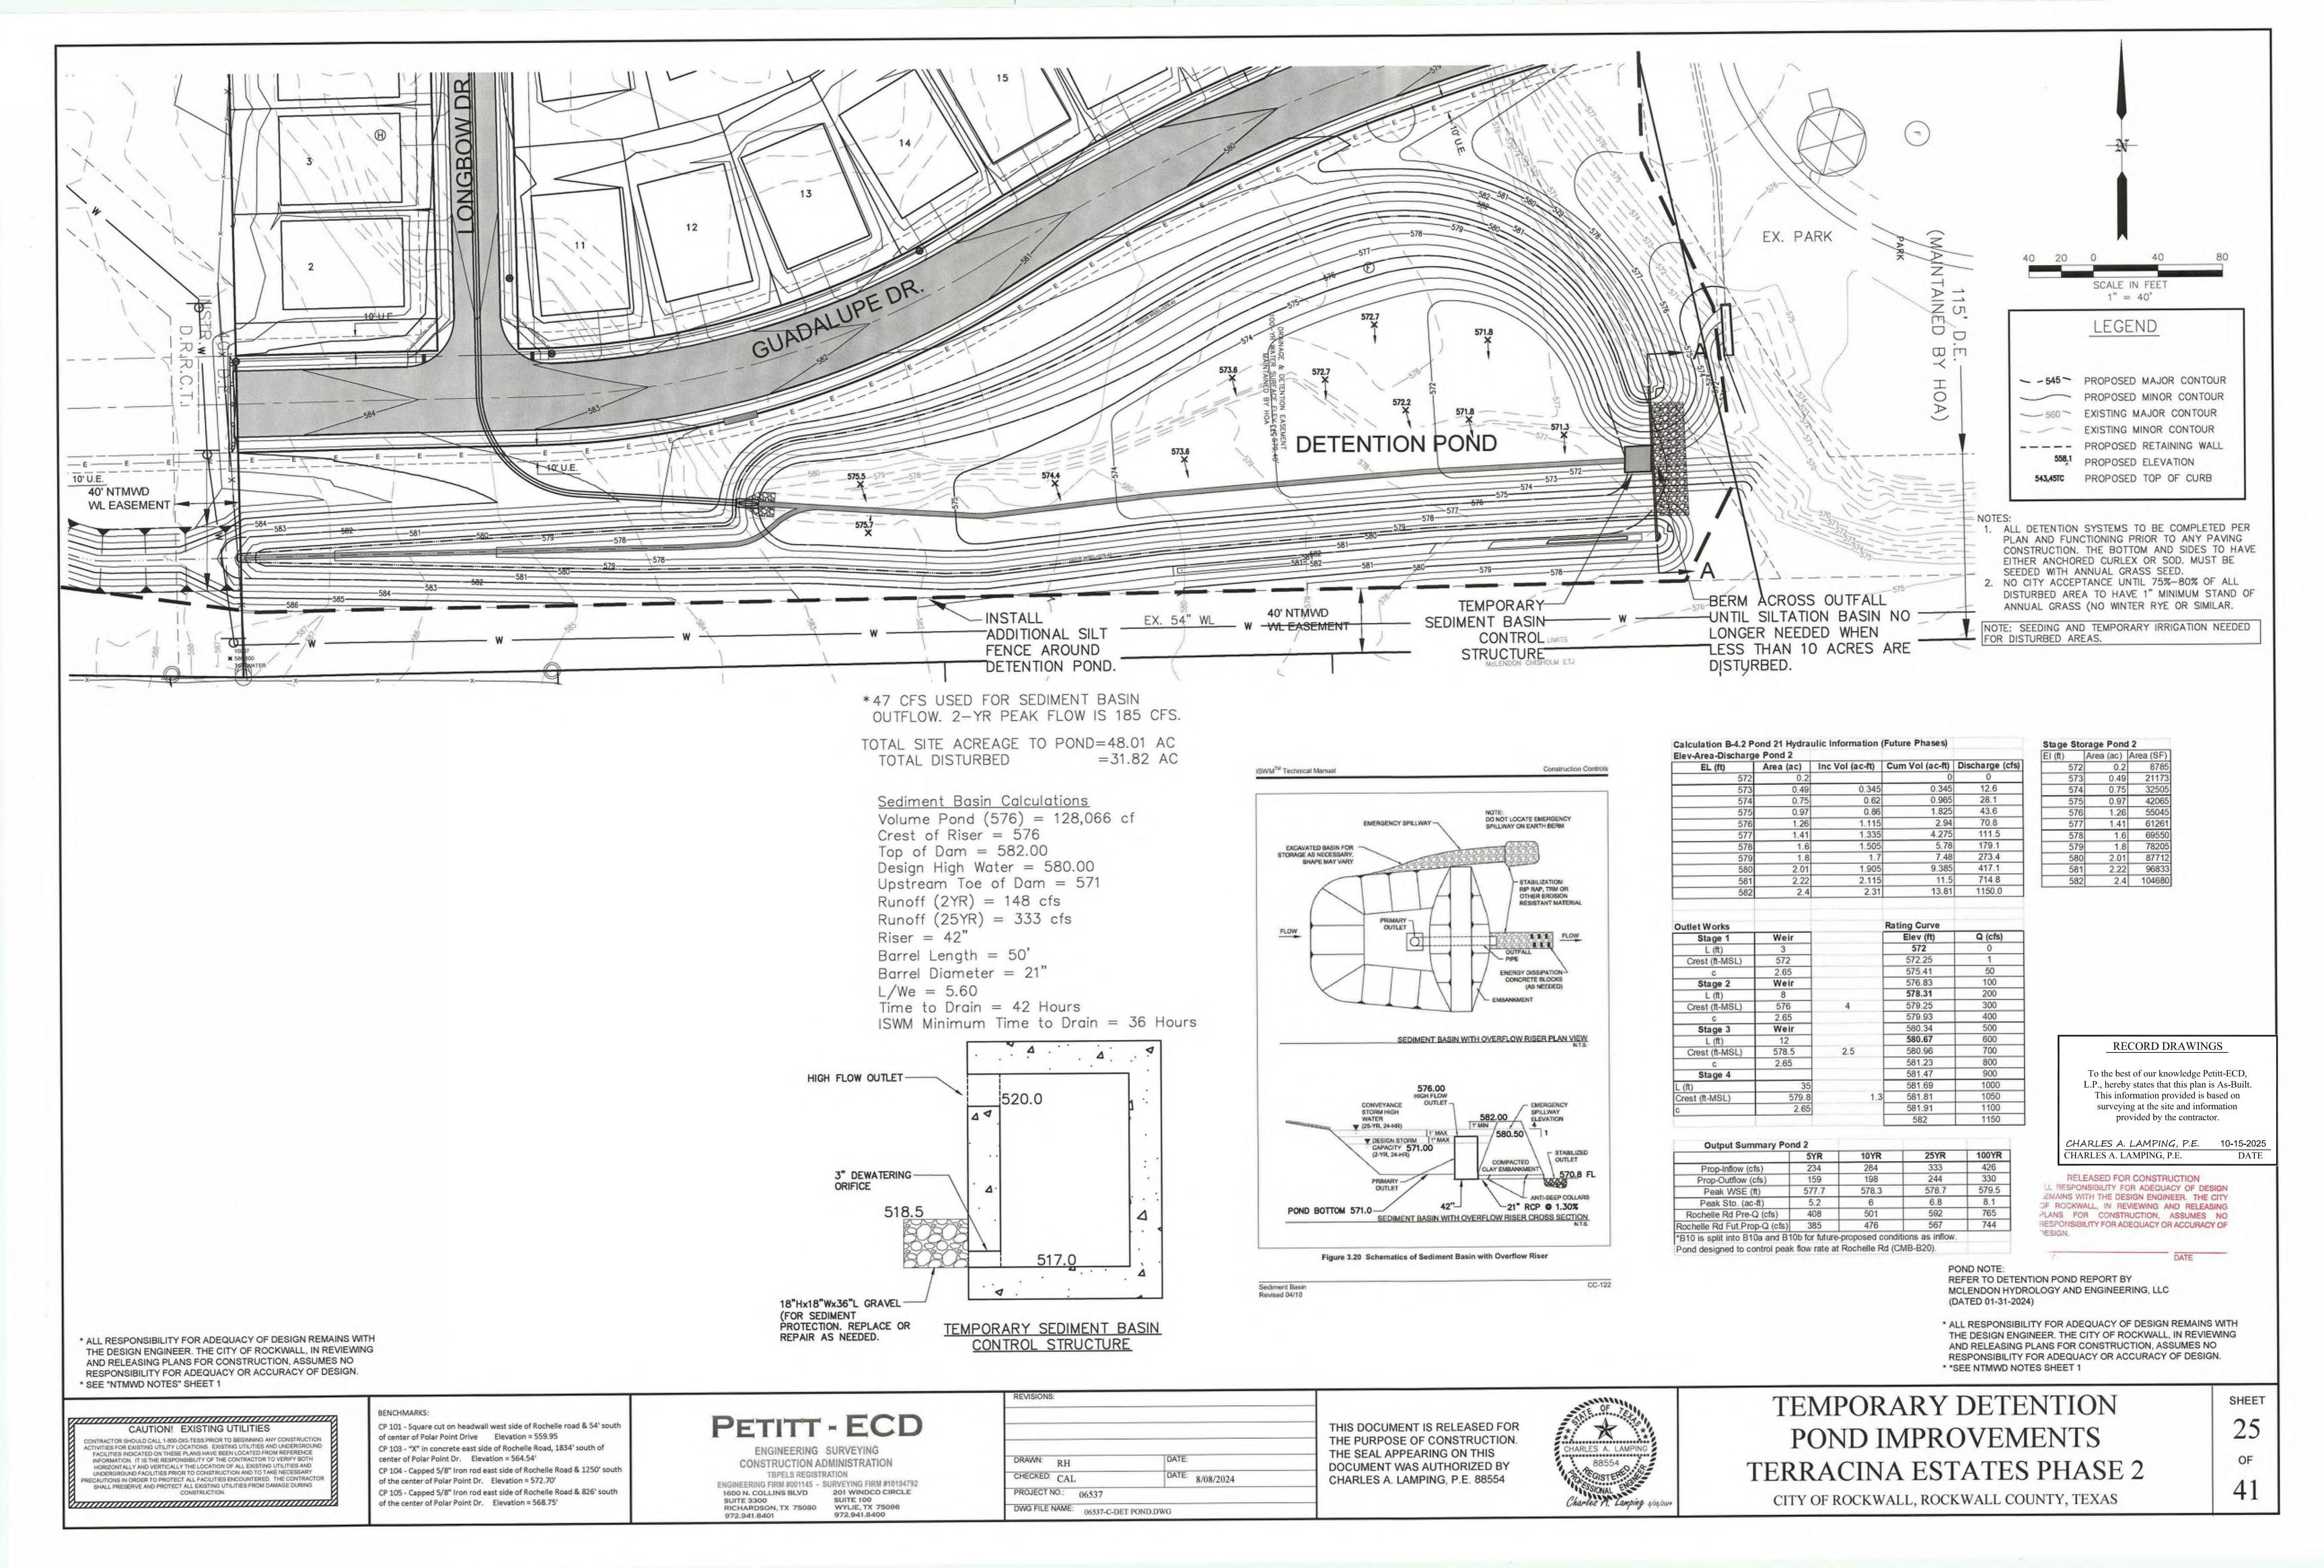


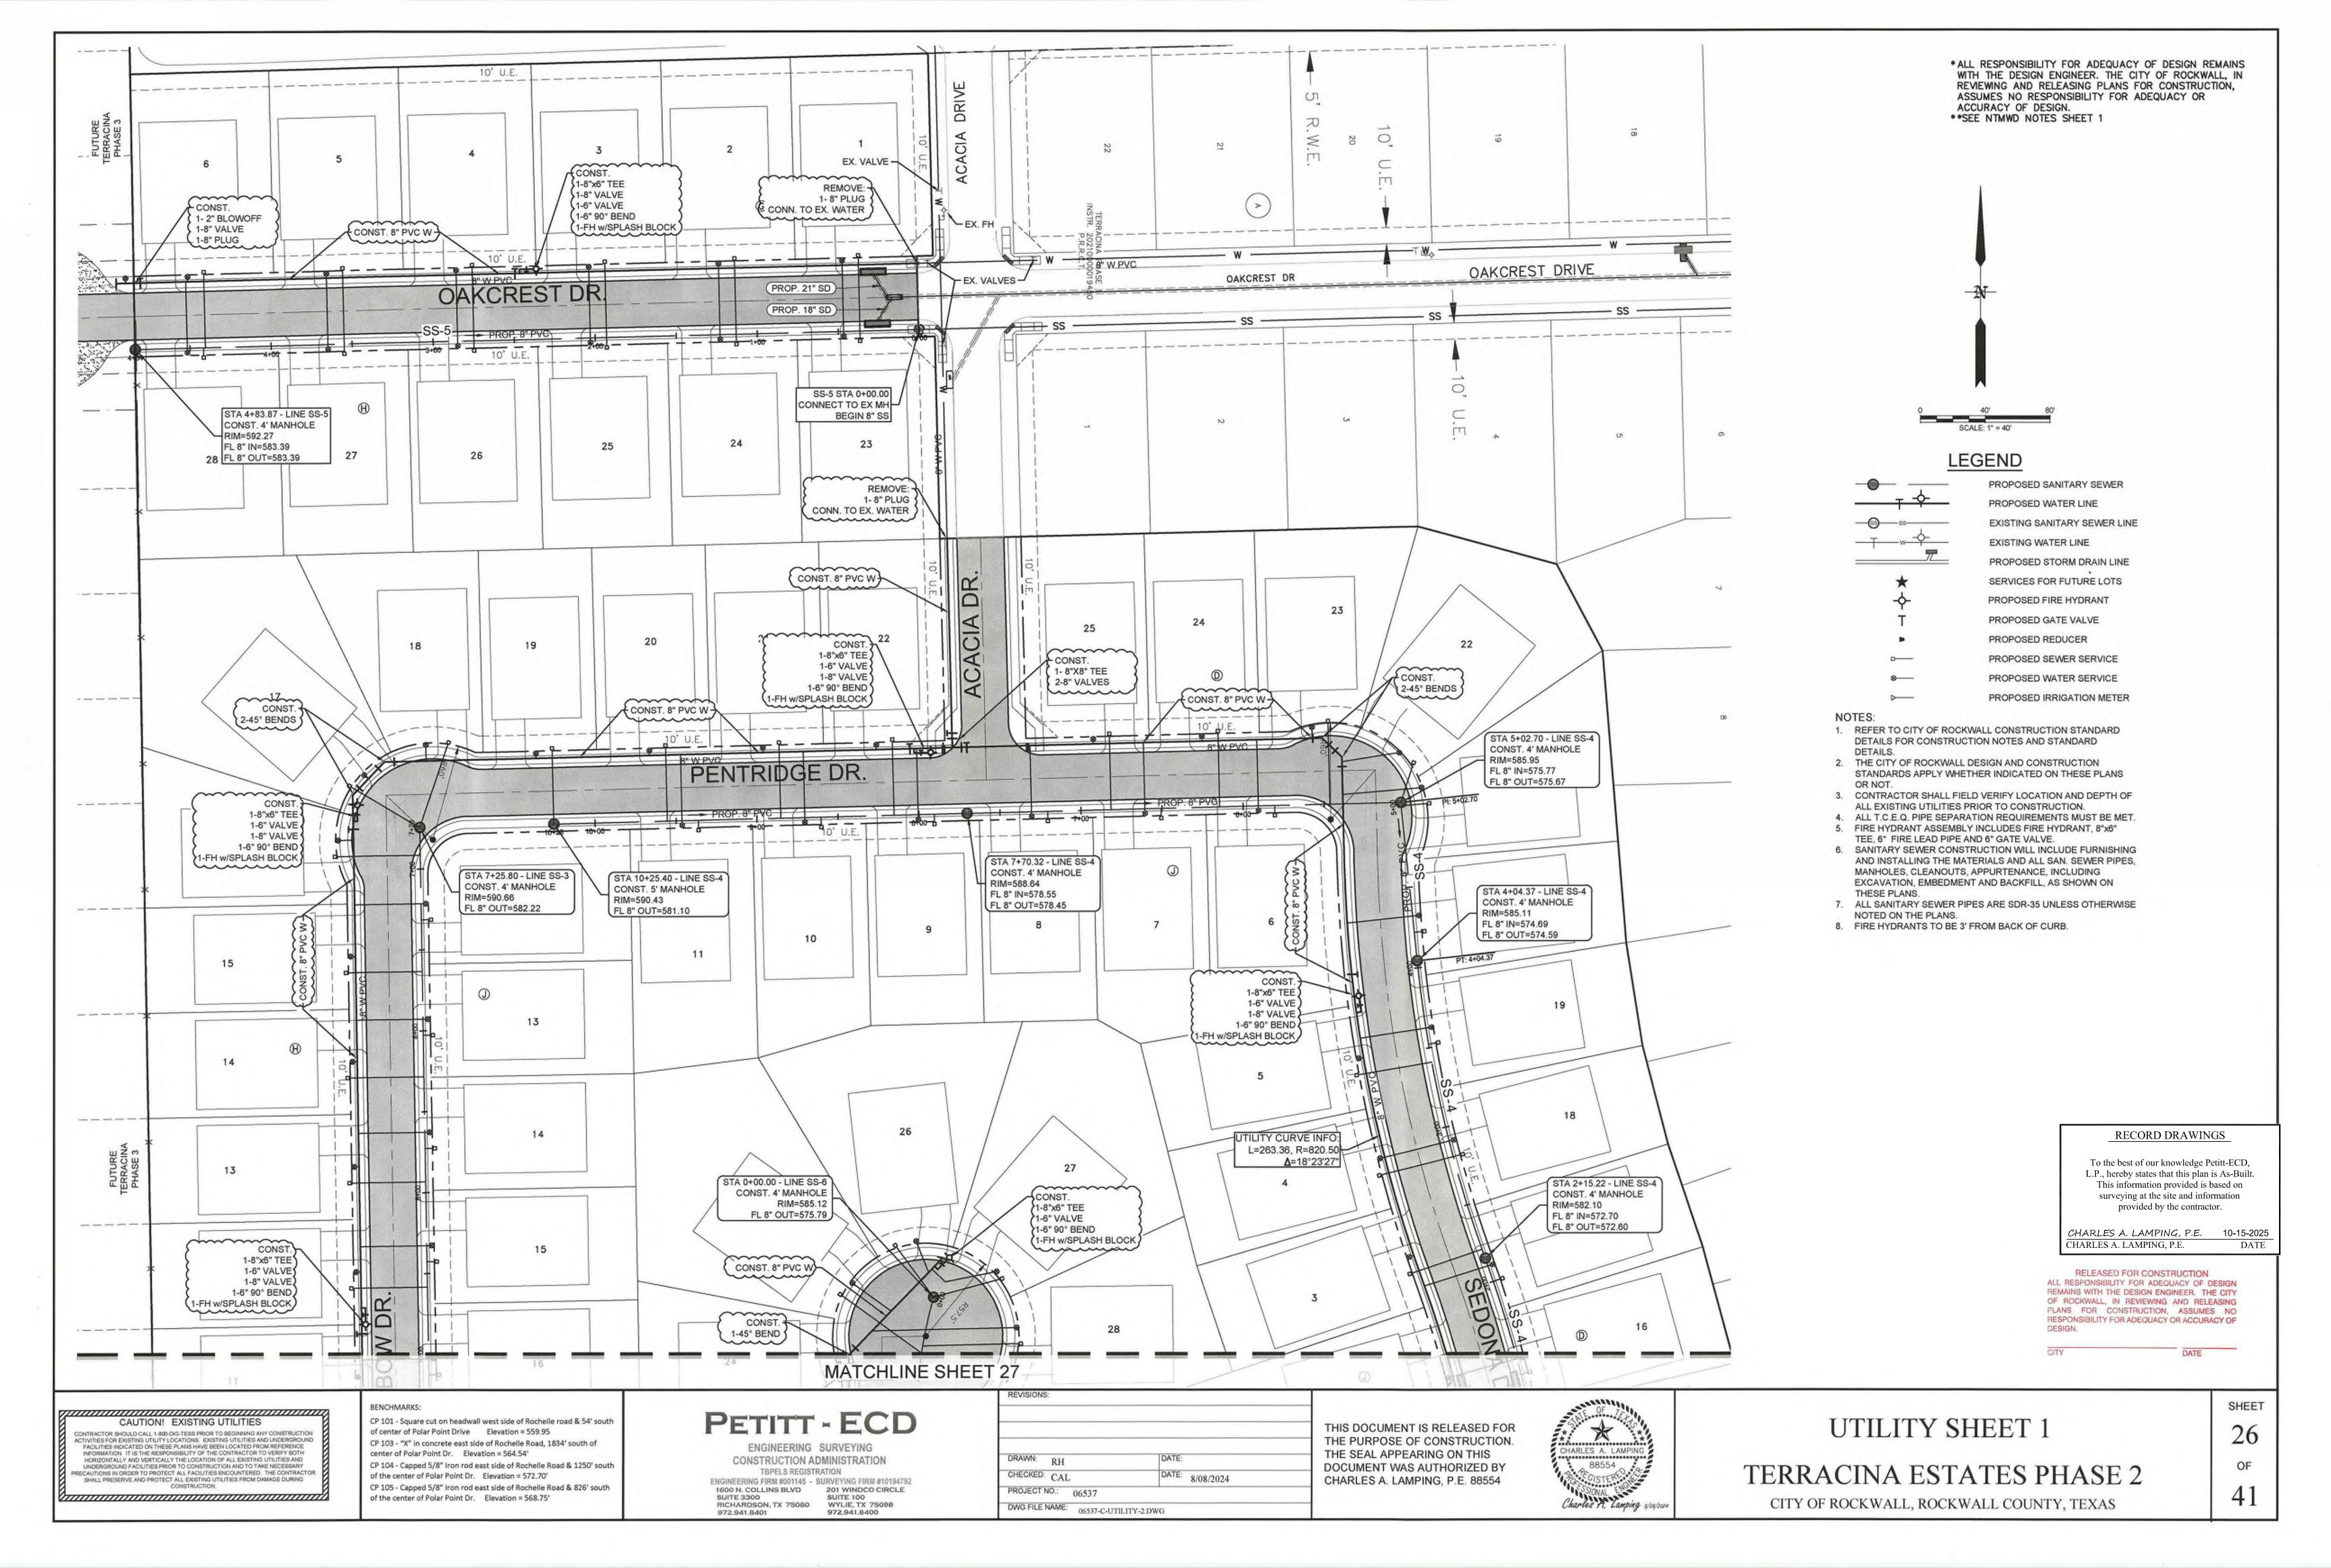


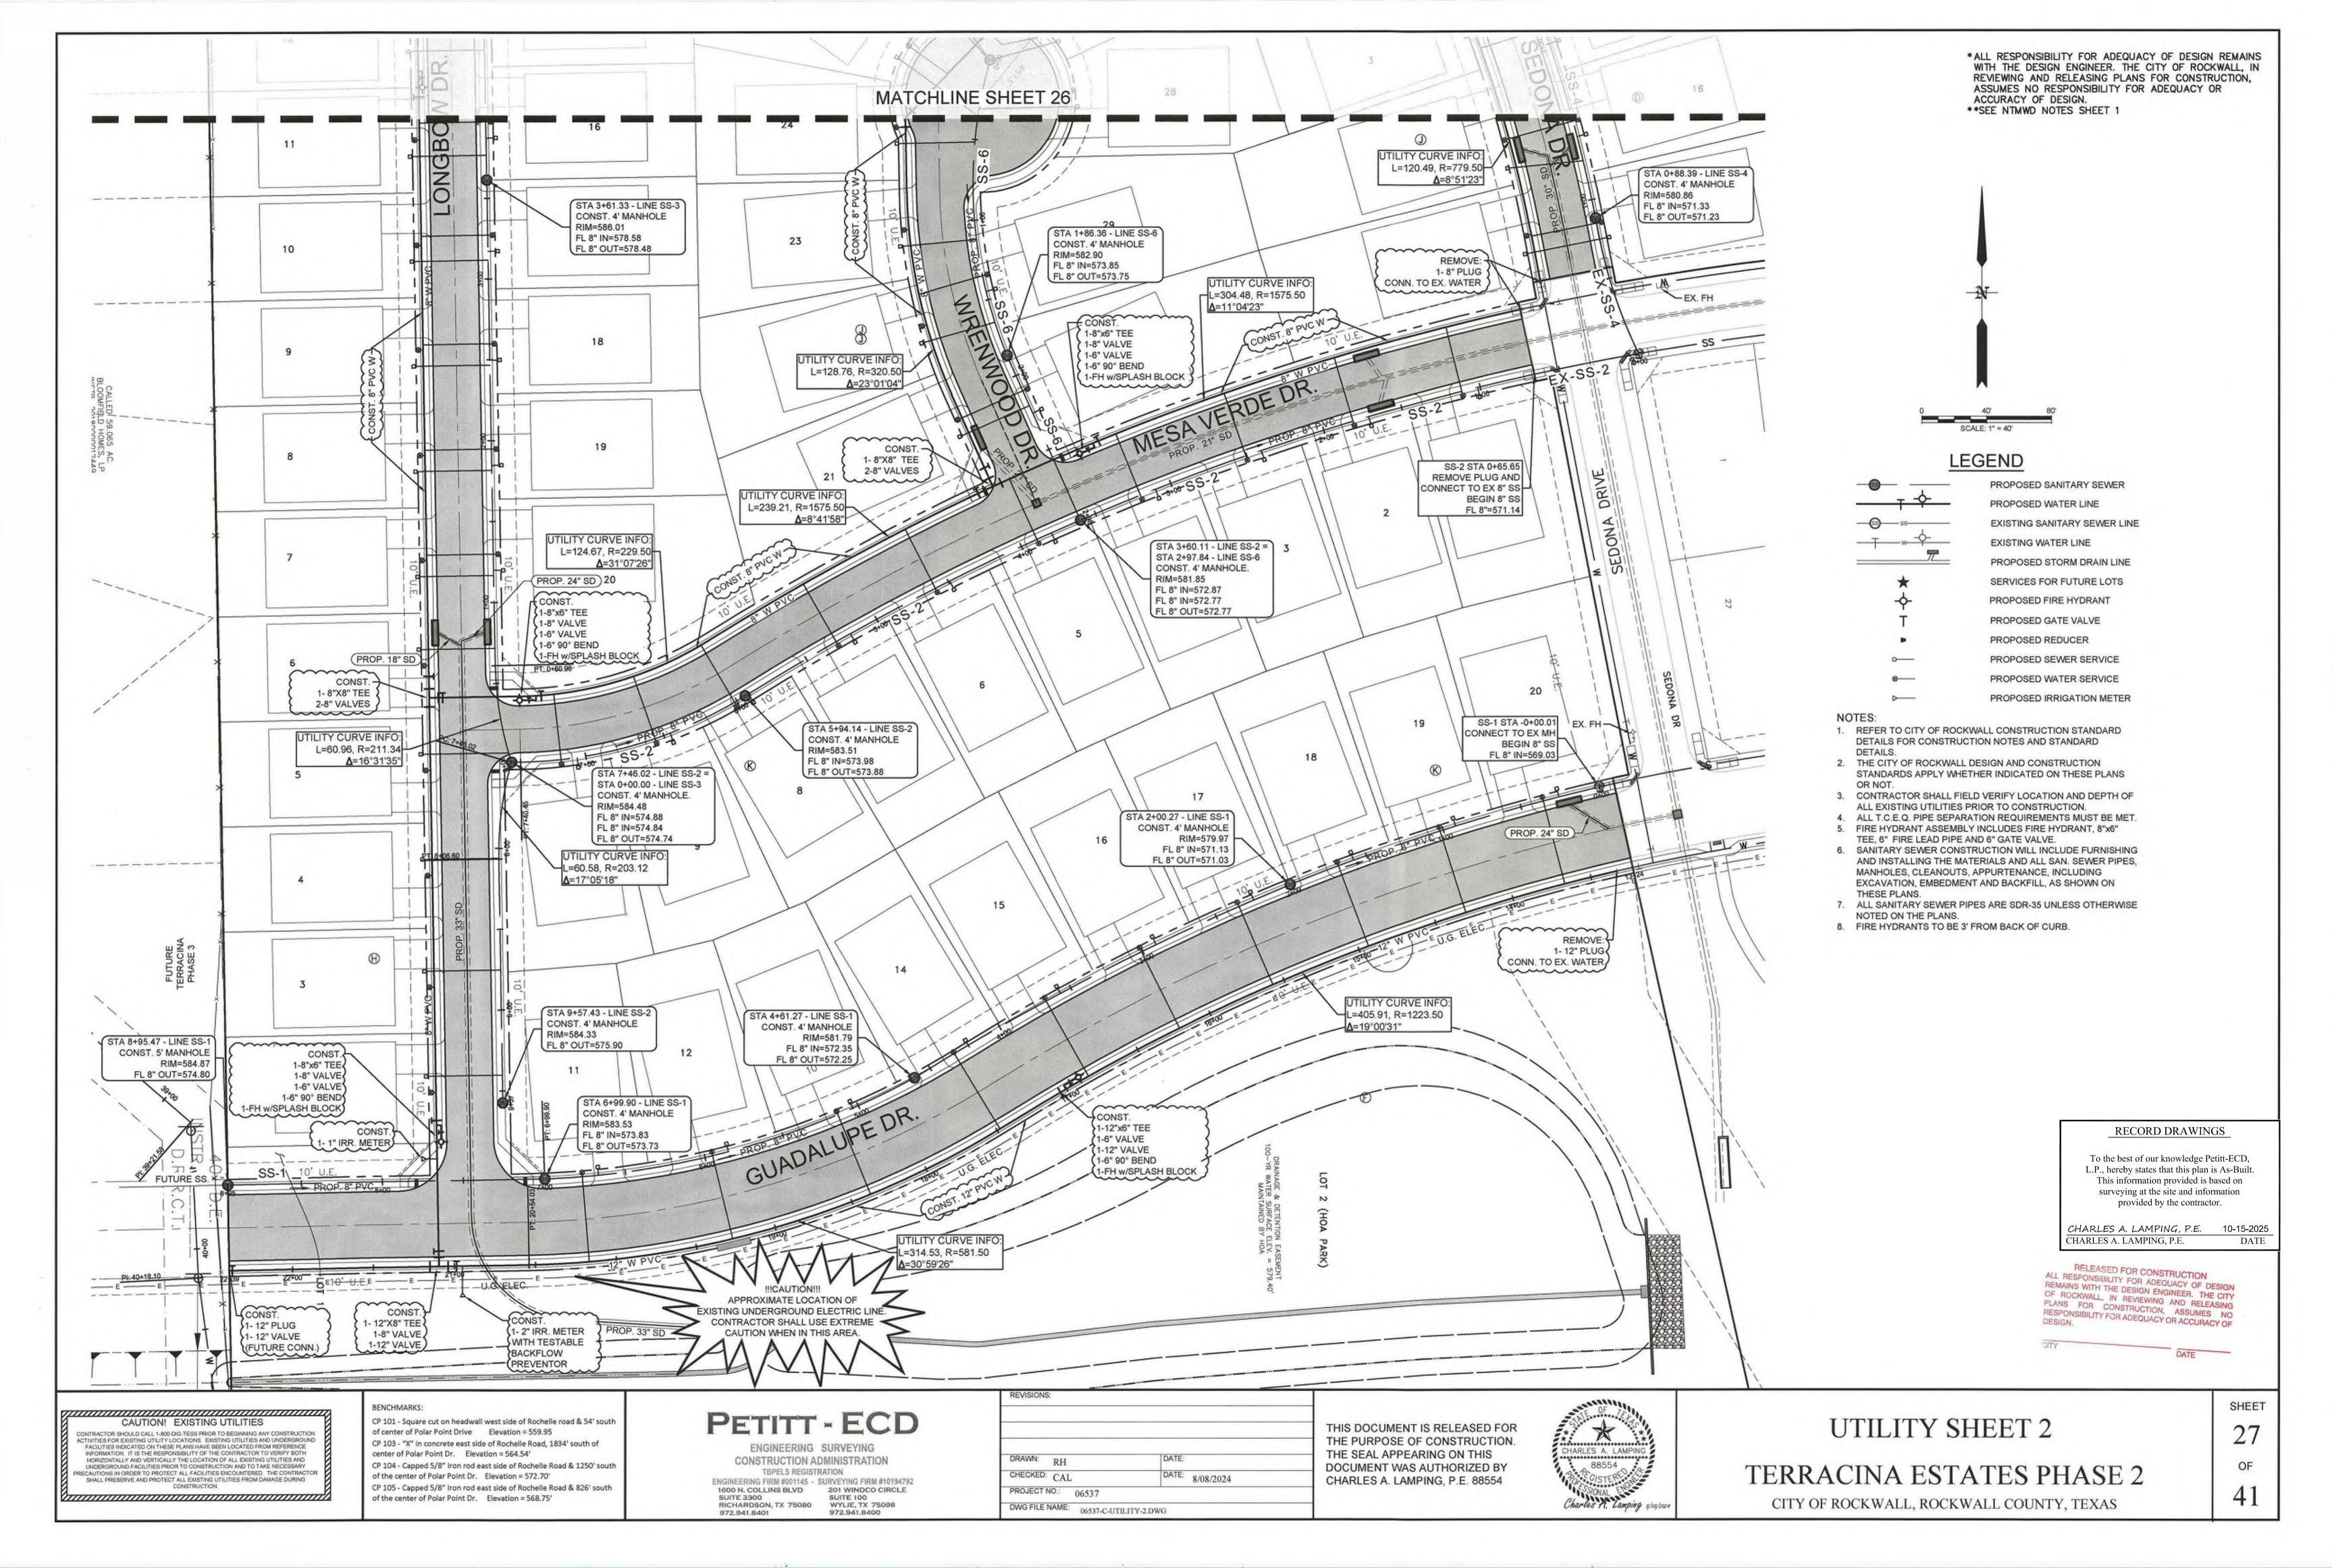


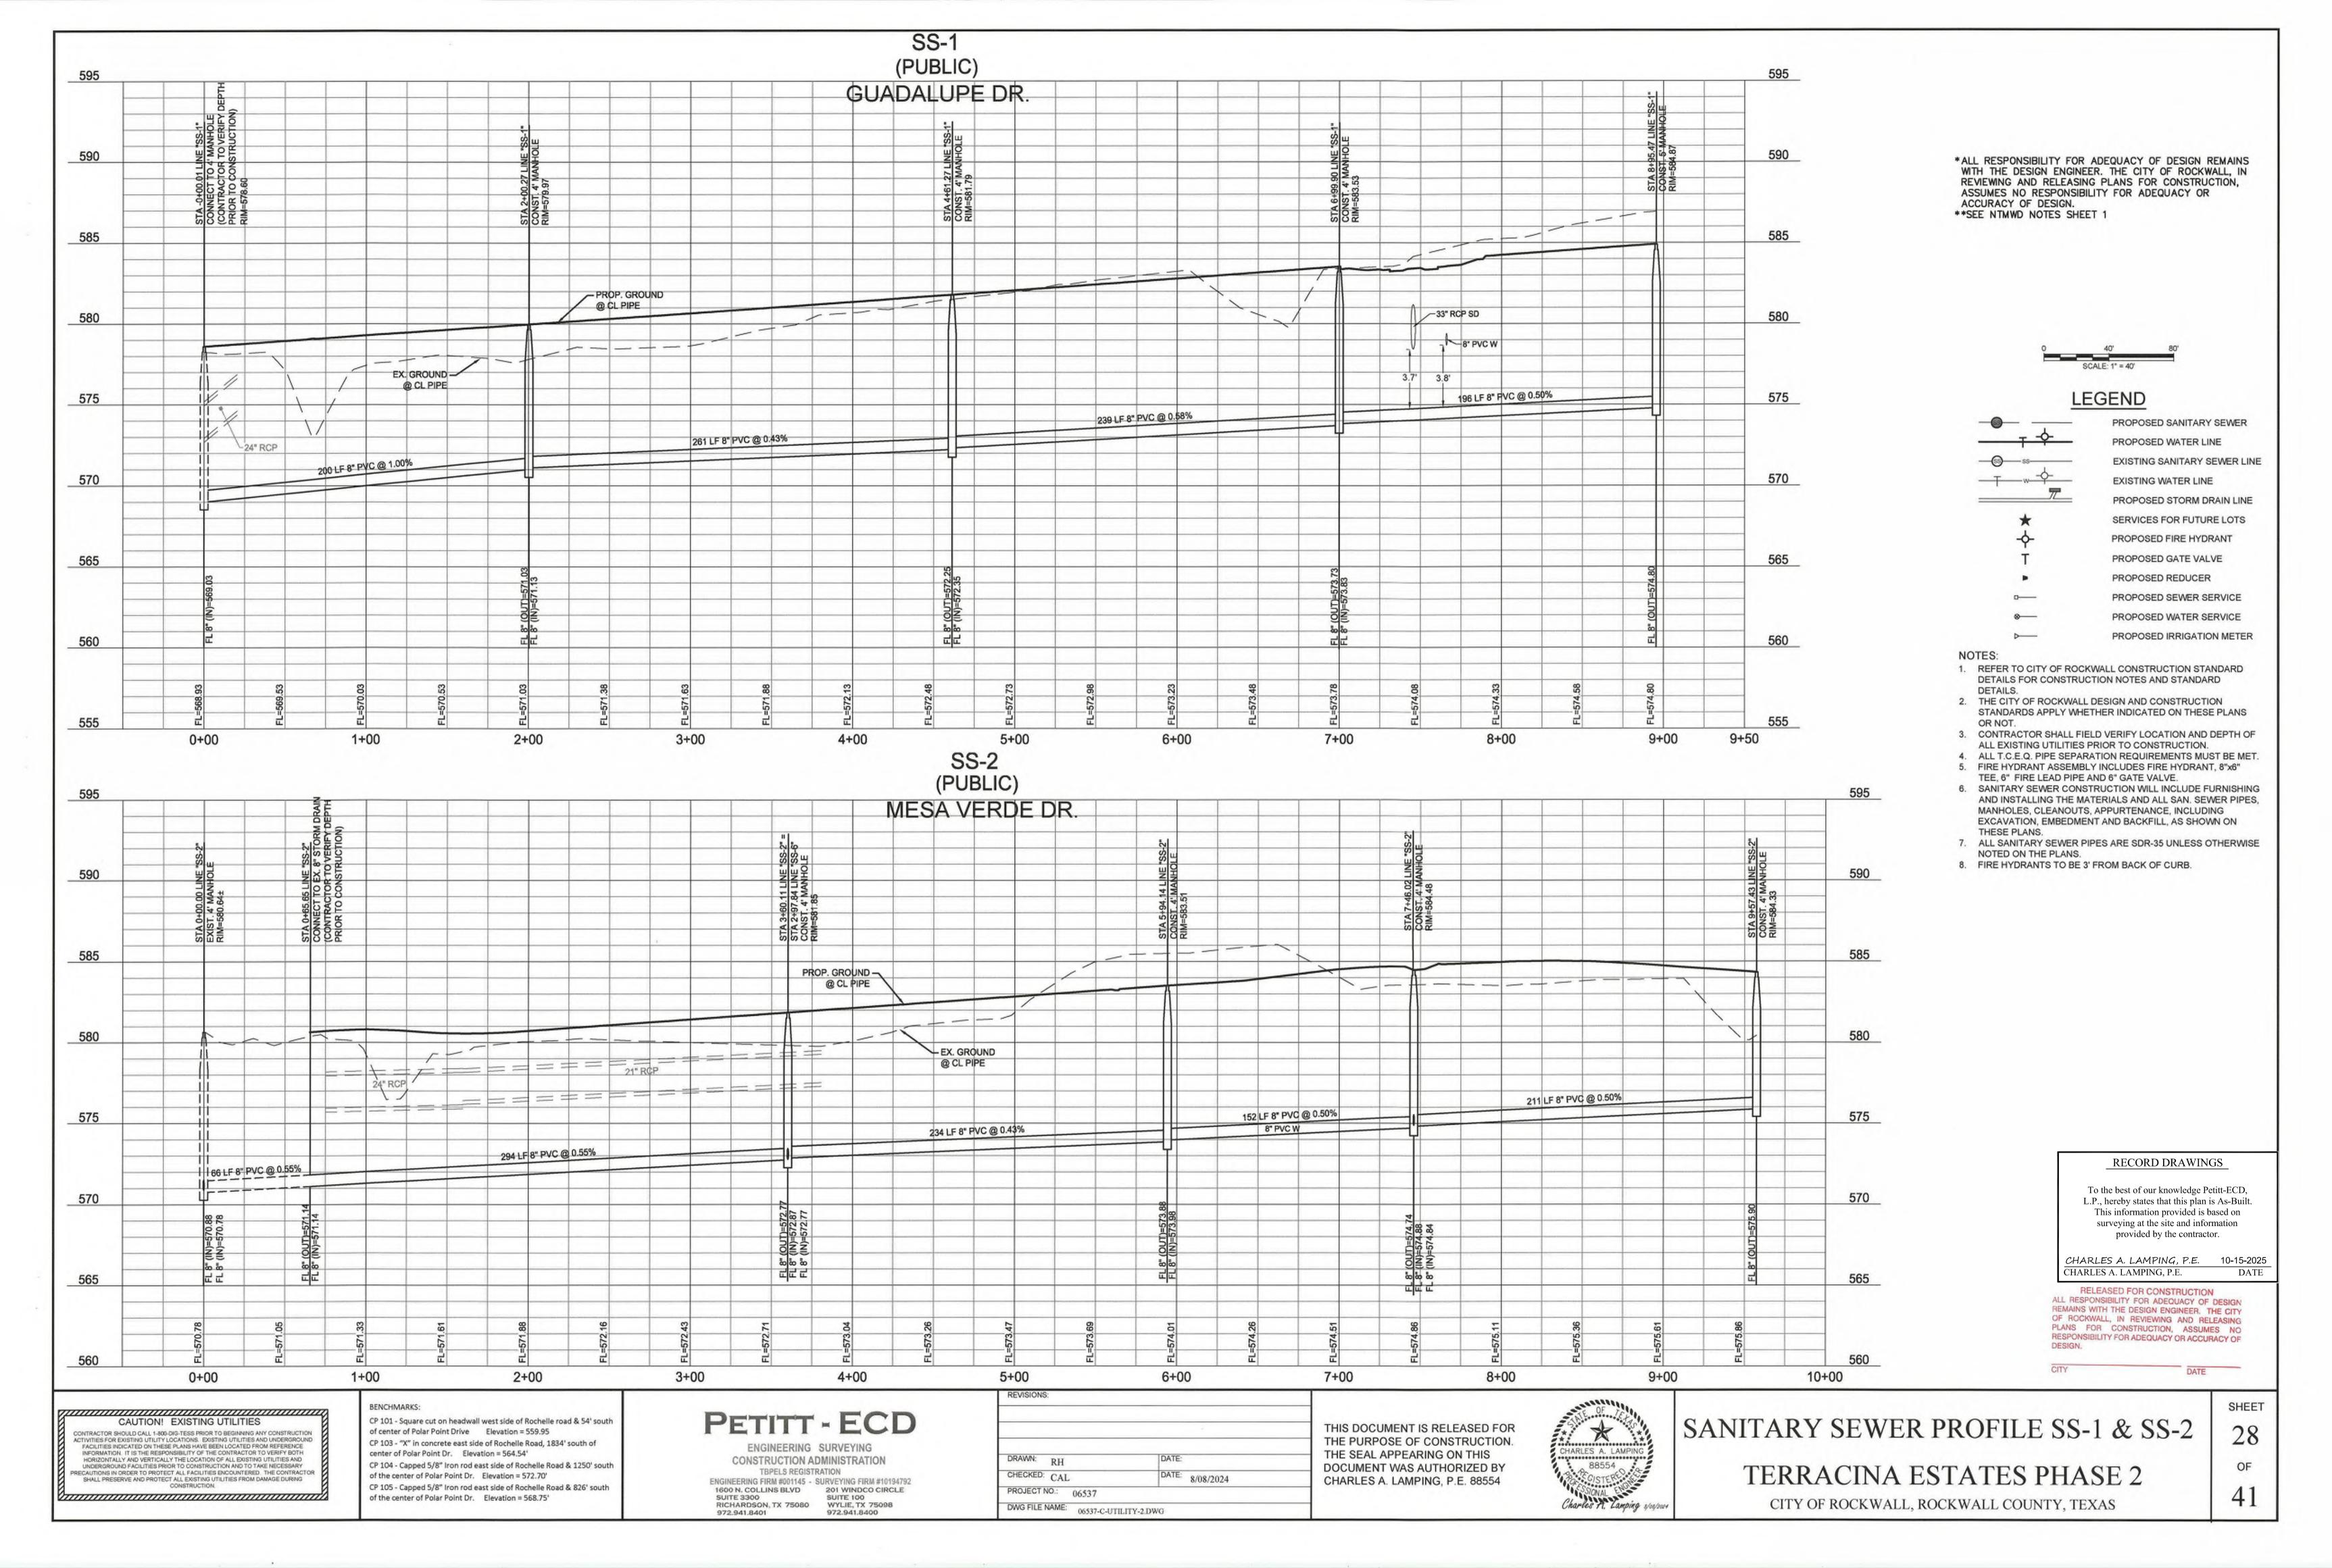

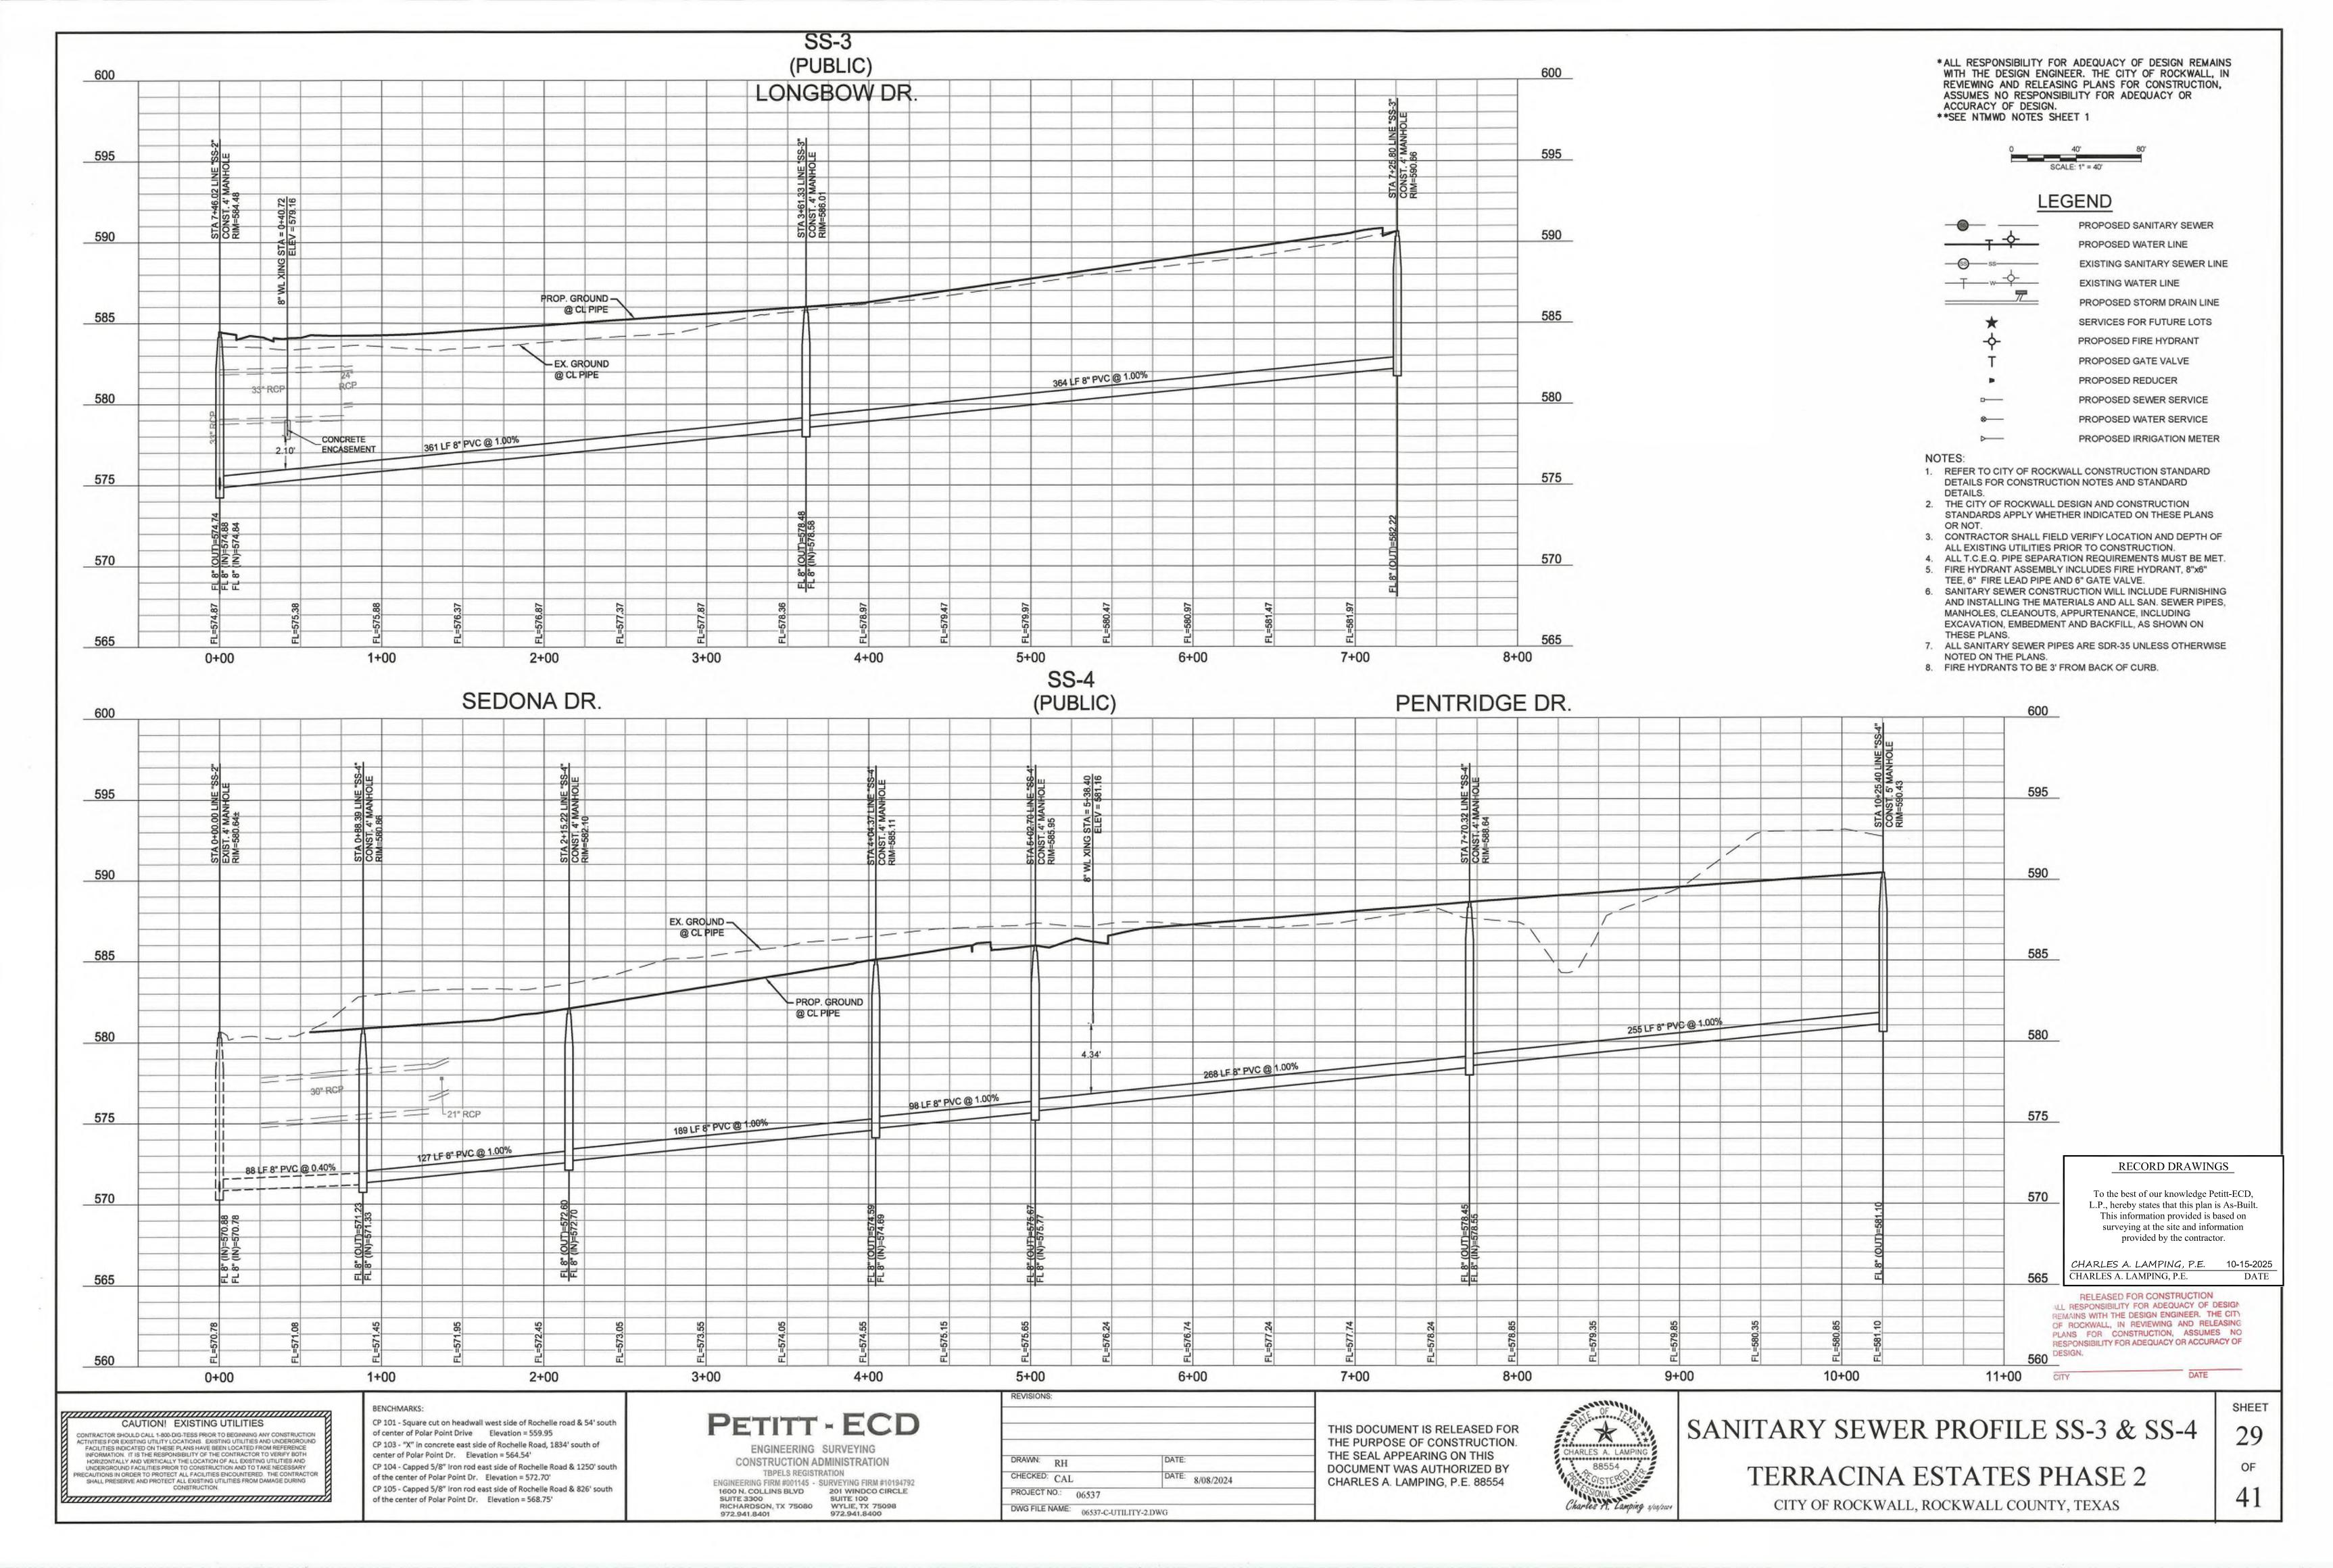


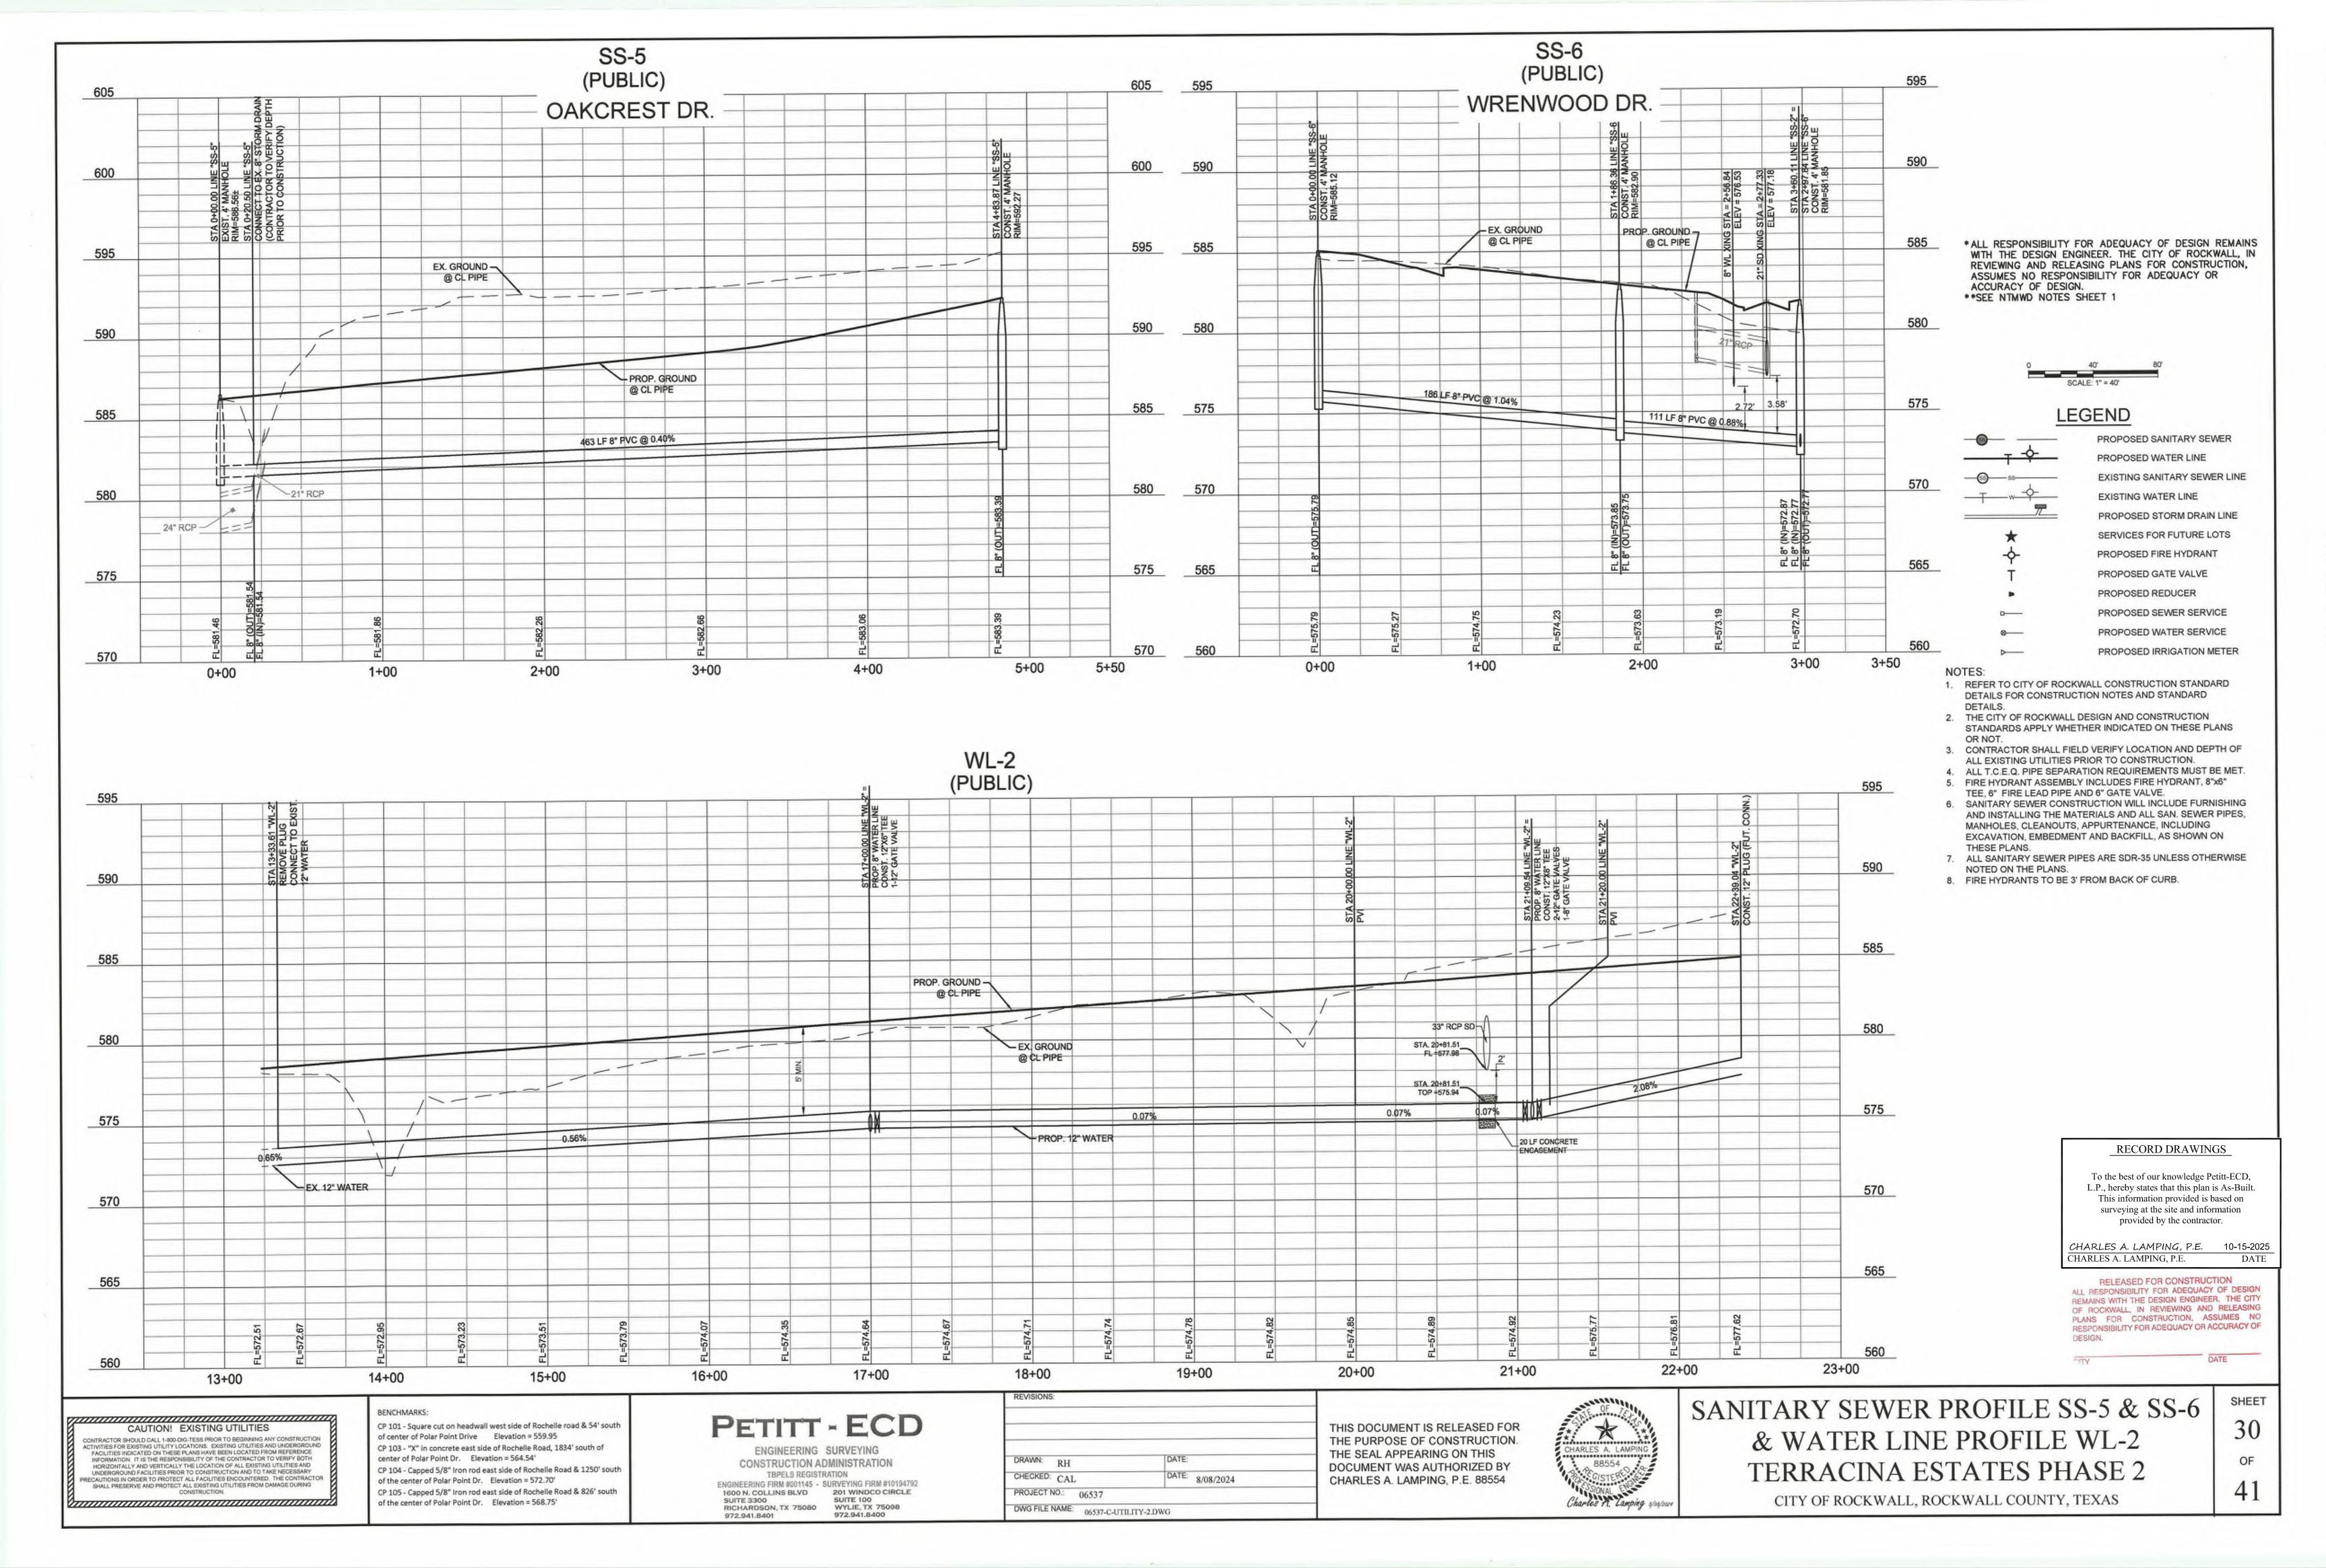

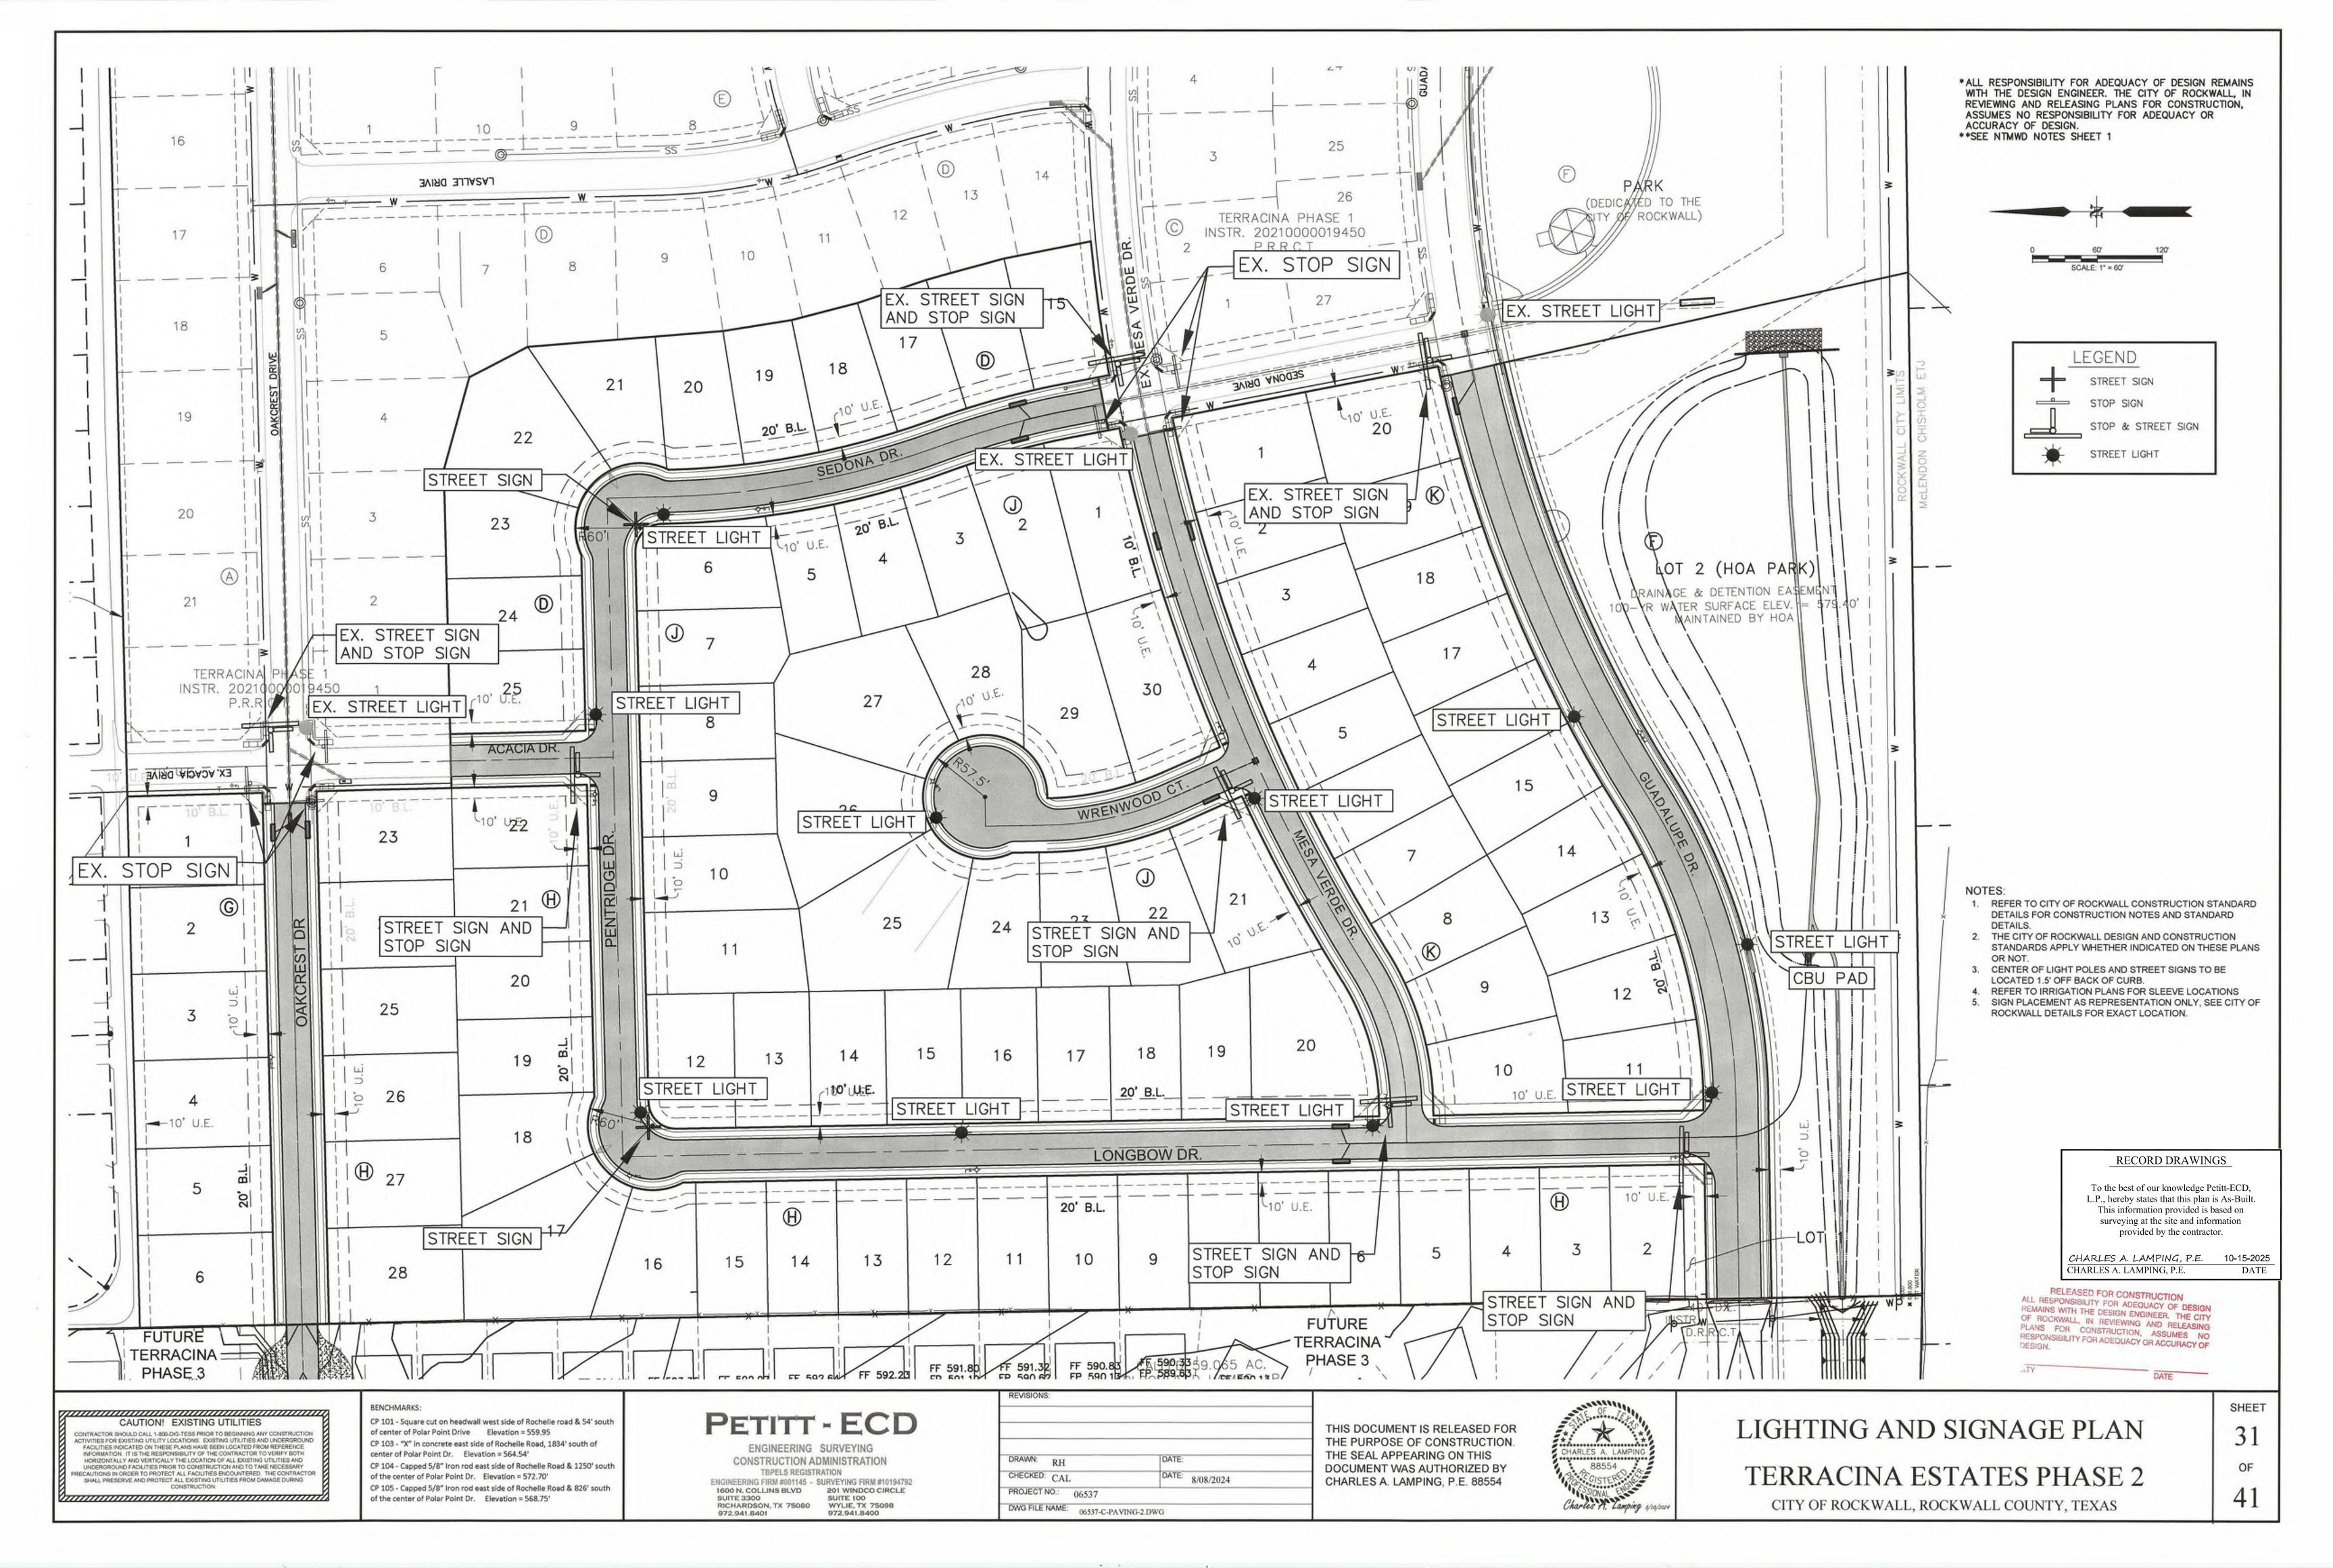


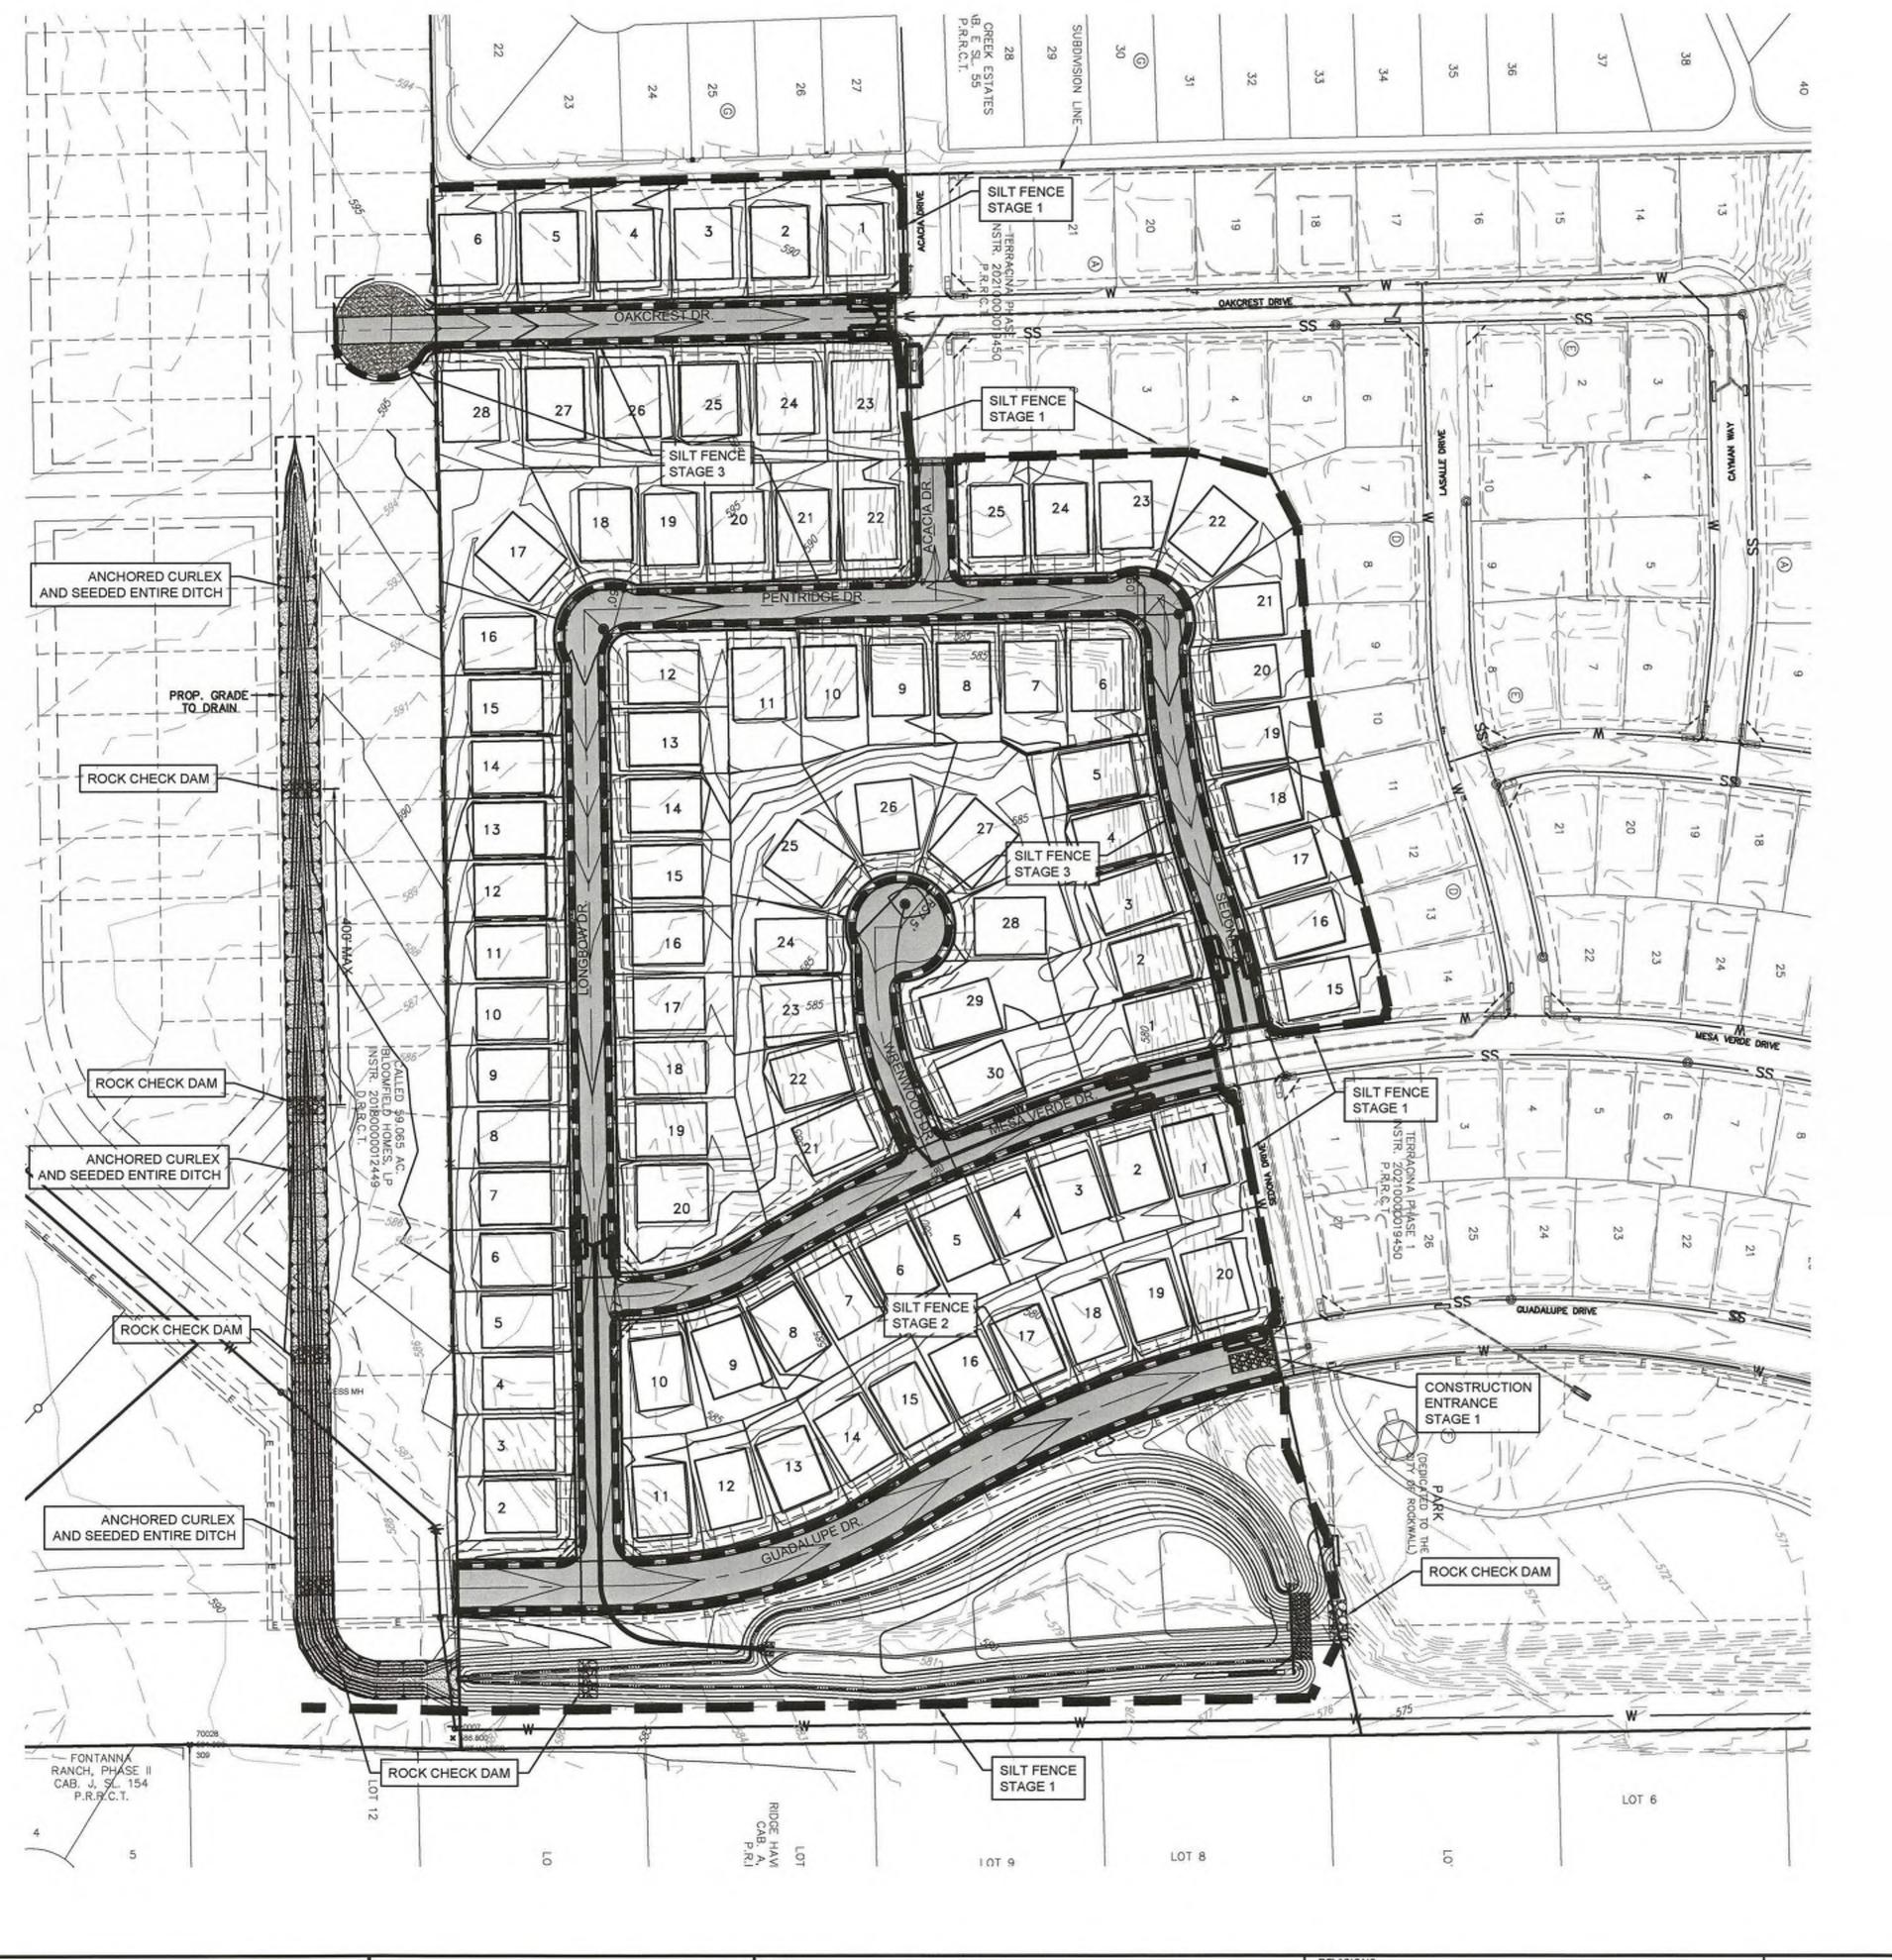

* ALL RESPONSIBILITY FOR ADEQUACY OF DESIGN REMAINS WITH THE DESIGN ENGINEER. THE CITY OF ROCKWALL, IN REVIEWING AND RELEASING PLANS FOR CONSTRUCTION, ASSUMES NO RESPONSIBILITY FOR ADEQUACY OR ACCURACY OF DESIGN. * *SEE NTMWD NOTES SHEET 1

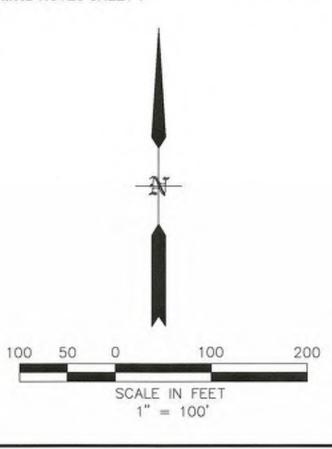

LEGEND - 560 - EXISTING MAJOR CONTOUR EXISTING MINOR CONTOUR SILT FENCE STAGE 1 SILT FENCE STAGE 2 ROCK CHECK DAM STAGE 1 INLET PROTECTION STAGE 2

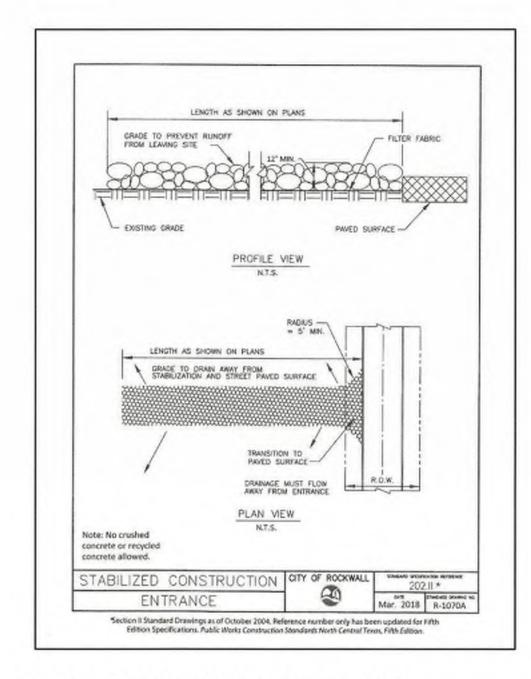

STAGE ONE (PRIOR TO START OF ROUGH GRADING)

1. SILT FENCE TO BE INSTALLED AS SHOWN ON PLAN OR AS REQUIRED.

- . INSTALL ROCK CHECK DAMS AT EXISTING OUTFALLS.
- 3. INSTALL ROCK CHECK DAMS AS SHOWN AT COMPLETION OF ROUGH GRADING IN THE AREA.

STAGE 2 (AFTER UTILITY CONSTRUCTION AND PRIOR TO PAVING CONSTRUCTION)

1. SILT FENCE SHALL BE PLACED AROUND TOP OF INLETS UNTIL TOPPED OUT, PREVENT EROSION MATERIAL FROM ENTERING STORM SEWER SYSTEM.

2. DETENTION POND AND OUTFALL TO BE COMPLETED AND VEGETATED BEFORE STAGE 3 (AFTER PAVING CONSTRUCTION)

1. SILT FENCE SHALL BE PLACED IN ROW ALONG PAVEMENT AS SHOWN WHERE REQUIRED BY SLOPE CONDITIONS.

- 2. ALL PARKWAYS AND DISTURBED AREA IN STREET R.O.W. TO BE SEEDED
- WITH GRASS AND CURLEX (ANCHORED) AS PER CITY STANDARDS. 3. VEGETATION TO BE ESTABLISHED IN ALL OFFSITE DISTURBED AREAS.
- 4. SOD IS REQUIRED IN ROCHELL R.O.W. ON ANY DISTURBED AREAS
- 5. 75%-80% OF ALL DISTURBED AREA TO HAVE A MINIMUM OF 1" STAND OF ANNUAL GRASS (NO RYE OR WEEDS) PRIOR TO CITY ACCEPTANCE.

SITE ACREAGE: 31.33 AC

DISTURBED ACREAGE: 311.82:SAGISBILITY FOR ADEQUACY OF DESIGN REMAINS WITH THE DESIGN ENGINEER. THE CITY OF ROCKWALL, IN REVIEWING AND RELEASING PLANS FOR CONSTRUCTION, ASSUMES NO RESPONSIBILITY FOR ADEQUACY OR ACCURACY OF

ALL RESPONSIBILITY FOR ADEQUACY OF DESIGN REMAINS WITH THE DESIGN ENGINEER. THE CITY OF ROCKWALL, IN REVIEWING AND RELEASING PLANS FOR CONSTRUCTION, ASSUMES NO RESPONSIBILITY FOR ADEQUACY OR ACCURACY OF DESIGN.

SEE "NTMWD NOTES" SHEET 1

CAUTION! EXISTING UTILITIES

CONTRACTOR SHOULD CALL 1-800-DIG-TESS PRIOR TO BEGINNING ANY CONSTRUCTION CTIVITIES FOR EXISTING UTILITY LOCATIONS. EXISTING UTILITIES AND UNDERGROUND FACILITIES INDICATED ON THESE PLANS HAVE BEEN LOCATED FROM REFERENCE INFORMATION. IT IS THE RESPONSIBILITY OF THE CONTRACTOR TO VERIFY BOTH HORIZONTALLY AND VERTICALLY THE LOCATION OF ALL EXISTING UTILITIES AND UNDERGROUND FACILITIES PRIOR TO CONSTRUCTION AND TO TAKE NICEISSARY VICALITY AND AND TO THE PROPERTY OF THE CONTRACTOR. CAUTIONS IN ORDER TO PROTECT ALL FACILITIES ENCOUNTERED. THE CONTRACTOR CONSTRUCTION

BENCHMARKS:

CP 101 - Square cut on headwall west side of Rochelle road & 54' south of center of Polar Point Drive Elevation = 559.95 CP 103 - "X" in concrete east side of Rochelle Road, 1834' south of

center of Polar Point Dr. Elevation = 564.54' CP 104 - Capped 5/8" Iron rod east side of Rochelle Road & 1250' south of the center of Polar Point Dr. Elevation = 572.70' CP 105 - Capped 5/8" Iron rod east side of Rochelle Road & 826' south of the center of Polar Point Dr. Elevation = 568.75'

PETITT - ECD

ENGINEERING SURVEYING CONSTRUCTION ADMINISTRATION TBPELS REGISTRATION ENGINEERING FIRM #001145 - SURVEYING FIRM #10194792 1600 N. COLLINS BLVD 201 WINDCO CIRCLE SUITE 3300 SUITE 100 RICHARDSON, TX 75080 WYLIE, TX 75098 972.941.8401

DRAWN: RH CHECKED: CAL DATE: 8/08/2024 PROJECT NO.: 06537 DWG FILE NAME: 06537-C-EROSION-2.DWG

THIS DOCUMENT IS RELEASED FOR THE PURPOSE OF CONSTRUCTION. THE SEAL APPEARING ON THIS DOCUMENT WAS AUTHORIZED BY CHARLES A. LAMPING, P.E. 88554



RECORD DRAWINGS

To the best of our knowledge Petitt-ECD,

L.P., hereby states that this plan is As-Built.

This information provided is based on

surveying at the site and information

provided by the contractor.

CHARLES A. LAMPING, P.E. 10-15-2025

DATE


CHARLES A. LAMPING, P.E.

EROSION CONTROL PLAN

TERRACINA ESTATES PHASE 2

CITY OF ROCKWALL, ROCKWALL COUNTY, TEXAS

SHEET OF

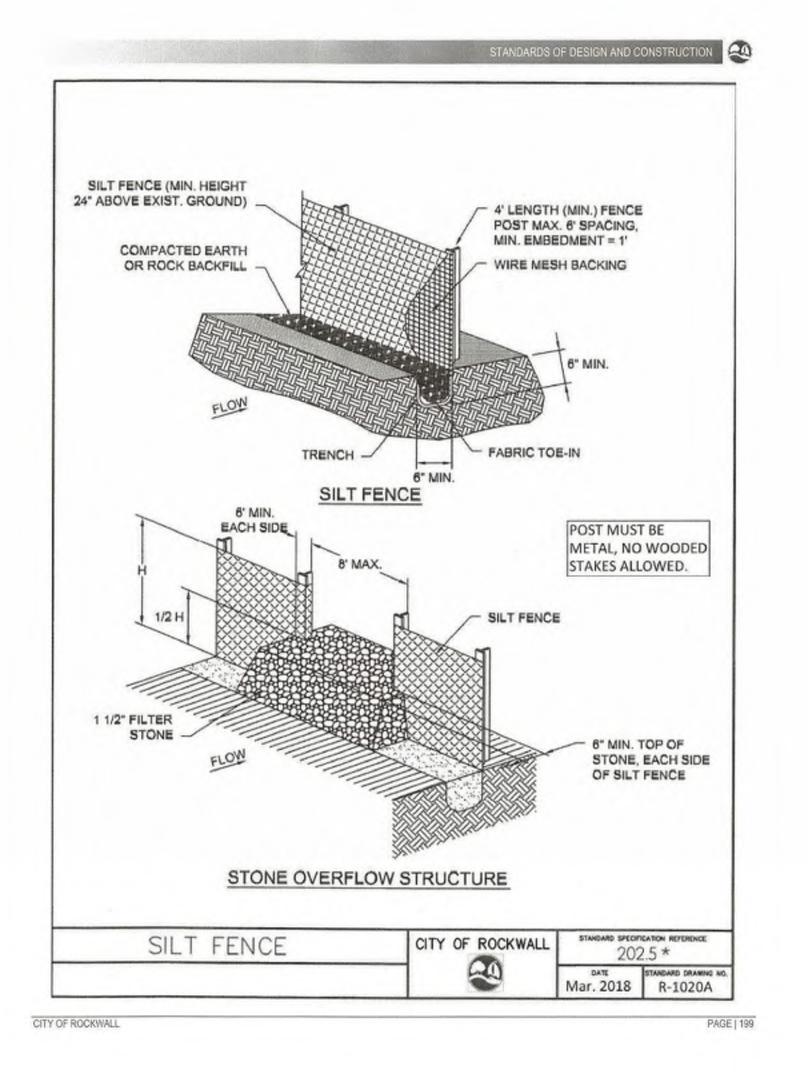

ANDARDS OF DESIGN AND CONSTRUCTION

SILT FENCE GENERAL NOTES:

- 1. POSTS WHICH SUPPORT THE SILT FENCE SHALL BE INSTALLED ON A SLIGHT ANGLE TOWARD THE ANTICIPATED RUNOFF SOURCE. POST MUST BE EMBEDDED A MINIMUM OF ONE FOOT.
- 2. THE TOE OF THE SILT FENCE SHALL BE TRENCHED IN WITH A SPADE OR MECHANICAL TRENCHER, SO THAT THE DOWNSLOPE FACE OF THE TRENCH IS FLAT AND PERPENDICULAR TO THE LINE OF FLOW. WHERE FENCE CANNOT BE TRENCHED IN (e.g. PAVEMENT), WEIGHT FABRIC FLAP WITH ROCK ON UPHILL SIDE TO PREVENT FLOW FROM SEEPING UNDER FENCE.
- 3. THE TRENCH MUST BE A MINIMUM OF 6 INCHES DEEP AND 6 INCHES WIDE TO ALLOW FOR THE SILT FENCE FABRIC TO BE LAID IN THE GROUND AND BACKFILLED WITH COMPACTED MATERIAL.
- 4. SILT FENCE SHOULD BE SECURELY FASTENED TO EACH SUPPORT POST OR TO WIRE BACKING, WHICH IN TURN IS ATTACHED TO THE FENCE POST. THERE SHALL BE A 3 FOOT OVERLAP, SECURELY FASTENED WHERE ENDS OF FABRIC MEET.
- INSPECTION SHALL BE AS SPECIFIED IN THE SWPPP.
 REPAIR OR REPLACEMENT SHALL BE MADE PROMPTLY AS NEEDED.
- SILT FENCE SHALL BE REMOVED WHEN FINAL STABILIZATION
 IS ACHIEVED OR ANOTHER EROSION OR SEDIMENT CONTROL
 DEVICE IS EMPLOYED.
- 7. ACCUMULATED SILT SHALL BE REMOVED WHEN IT REACHES A DEPTH OF HALF THE HEIGHT OF THE FENCE. THE SILT SHALL BE DISPOSED OF AT AN APPROVED SITE AND IN SUCH A MANNER AS TO NOT CONTRIBUTE TO ADDITIONAL SILTATION.
- FILTER STONE SHALL BE WRAPPED IN FILTER FABRIC AND BURIED SIX (6") INCHES MINIMUM.

SILT FENCE	CITY OF ROCKWALL	STANDARD SPECI	псатон регененсе 2.5 *
	80	Mar. 2018	R-1020B

CITY OF ROCKWALL

PAGE | 200

ROCK CHECK DAM GENERAL NOTES:

1. STONE SHALL BE WELL GRADED WITH SIZE RANGE FROM 1½ TO 3½ INCHES IN DIAMETER DEPENDING ON EXPECTED

STANDARDS OF DESIGN AND CONSTRUCTION (20)

2. THE CHECK DAM SHALL BE INSPECTED AS SPECIFIED IN THE SWPPP AND SHALL BE REPLACED WHEN THE STRUCTURE CEASES TO FUNCTION AS INTENDED DUE TO SILT ACCUMULATION AMONG THE ROCKS, WASHOUT, CONSTRUCTION TRAFFIC DAMAGE, ETC.

- WHEN SILT REACHES A DEPTH EQUAL TO ONE—THIRD OF THE HEIGHT OF THE CHECK DAM OR ONE FOOT, WHICHEVER IS LESS, THE SILT SHALL BE REMOVED AND DISPOSED OF PROPERLY.
- 4. WHEN THE SITE HAS ACHIEVED FINAL STABILIZATION OR ANOTHER EROSION OR SEDIMENT CONTROL DEVICE IS EMPLOYED, THE CHECK DAM AND ACCUMULATED SILT SHALL BE REMOVED AND DISPOSED OF IN AN APPROVED MANNER.
- FILTER STONE SHALL BE WRAPPED IN APPROPRIATE SIZED WIRE MESH TO CONTAIN STONE AND BURIED SIX (6") INCHES MINIMUM.

ROCK CHECK DAM

CITY OF ROCKWALL

202.9 *

DATE
Mar. 2018 STANDARD DRAWING NO.
R-1060B

CITY OF ROCKWALL

DACELON

RECORD DRAWINGS

To the best of our knowledge Petitt-ECD, L.P., hereby states that this plan is As-Built. This information provided is based on surveying at the site and information provided by the contractor.

CHARLES A. LAMPING, P.E. 10-15-2025

CHARLES A. LAMPING, P.E. DATE

RELEASED FOR CONSTRUCTION
ALL RESPONSIBILITY FOR ADEQUACY OF DESIGN
REMAINS WITH THE DESIGN ENGINEER. THE CITY
OF ROCKWALL, IN REVIEWING AND RELEASING
PLANS FOR CONSTRUCTION, ASSUMES NO
RESPONSIBILITY FOR ADEQUACY OR ACCURACY OF

DAT

CAUTION! EXISTING UTILITIES

CONSTRUCTION.

CONTRACTOR SHOULD CALL 1-800-DIG-TESS PRIOR TO BEGINNING ANY CONSTRUCTION ACTIVITIES FOR EXISTING UTILITY LOCATIONS. EXISTING UTILITIES AND UNDERGROUND FACILITIES INDICATED ON THESE PLANS HAVE BEEN LOCATED FROM REFEREINCE INFORMATION. IT IS THE RESPONSIBILITY OF THE CONTRACTOR TO VERIEY BOTH HORIZONTALLY AND VERTICALLY THE LOCATION OF ALL EXISTING UTILITIES AND UNDERGROUND FACILITIES PRIOR TO CONSTRUCTION AND TO TAKE INCIDENSARY RECAUTIONS IN ORDER TO PROTECT ALL FACILITIES ENCOUNTERED. THE CONTRACTOR SHALL PRESERVE AND PROTECT ALL EXISTING UTILITIES FROM DAMAGE DURING

BENCHMARKS:

CP 101 - Square cut on headwall west side of Rochelle road & 54' south of center of Polar Point Drive Elevation = 559.95

CP 103 - "X" in concrete east side of Rochelle Road, 1834' south of center of Polar Point Dr. Elevation = 564.54'

CP 104 - Capped 5/8" Iron rod east side of Rochelle Road & 1250' south of the center of Polar Point Dr. Elevation = 572.70'

CP 105 - Capped 5/8" Iron rod east side of Rochelle Road & 826' south

of the center of Polar Point Dr. Elevation = 568.75'

PETITT - ECD

ENGINEERING SURVEYING
CONSTRUCTION ADMINISTRATION
TBPELS REGISTRATION
ENGINEERING FIRM #001145 - SURVEYING FIRM #10194792
1600 N. COLLINS BLVD
SUITE 3300
SUITE 100
RICHARDSON, TX 75080
972.941.8401
972.941.8400

THIS DOCUMENT IS RELEASED FOR THE PURPOSE OF CONSTRUCTION. THE SEAL APPEARING ON THIS DOCUMENT WAS AUTHORIZED BY CHARLES A. LAMPING, P.E. 88554




EROSION CONTROL DETAILS 1


TERRACINA ESTATES PHASE 2


CITY OF ROCKWALL, ROCKWALL COUNTY, TEXAS

0F

SHEET

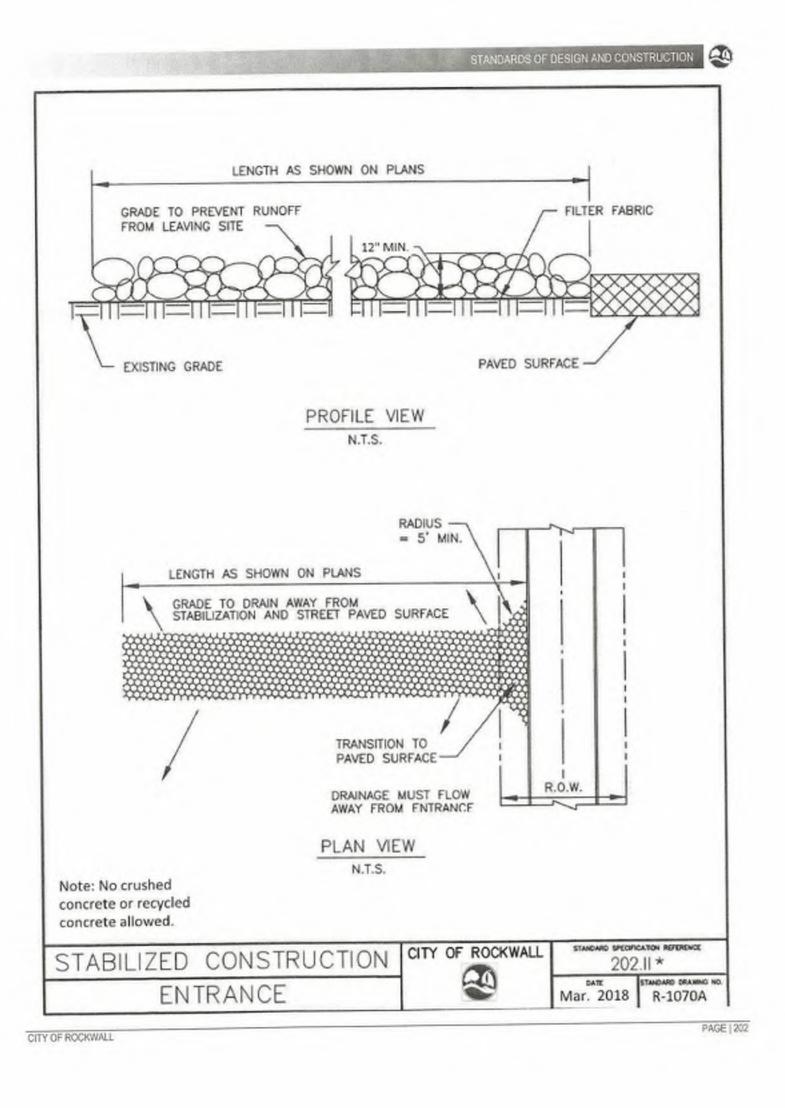

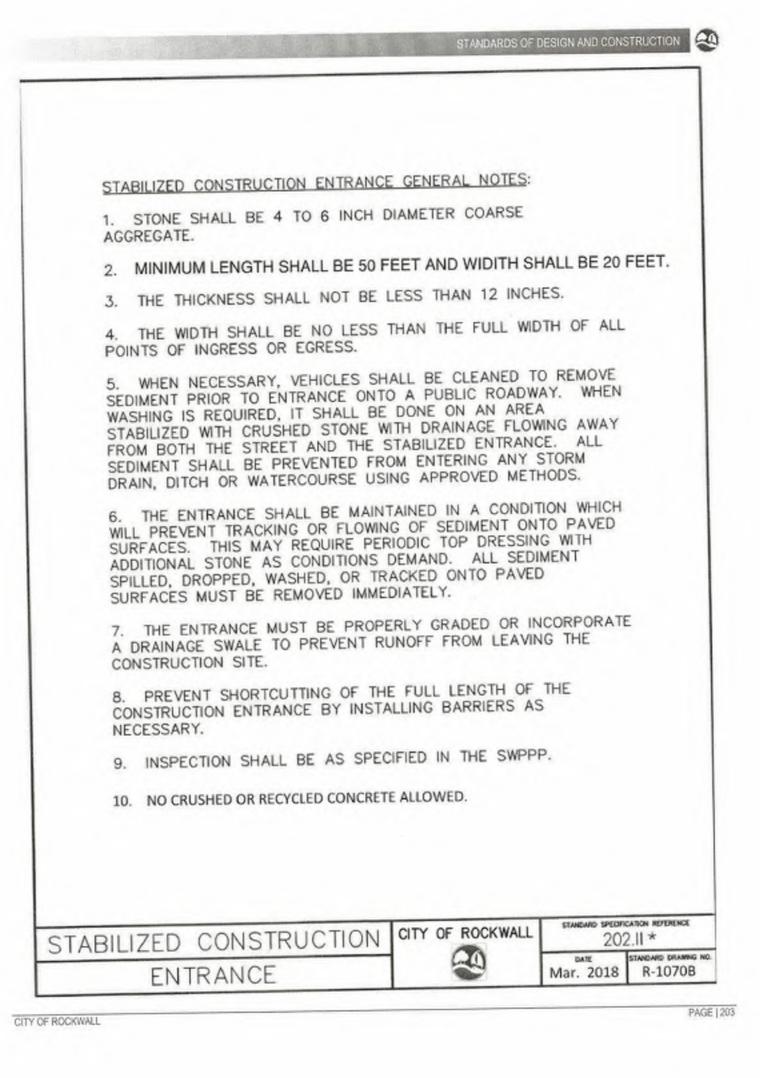

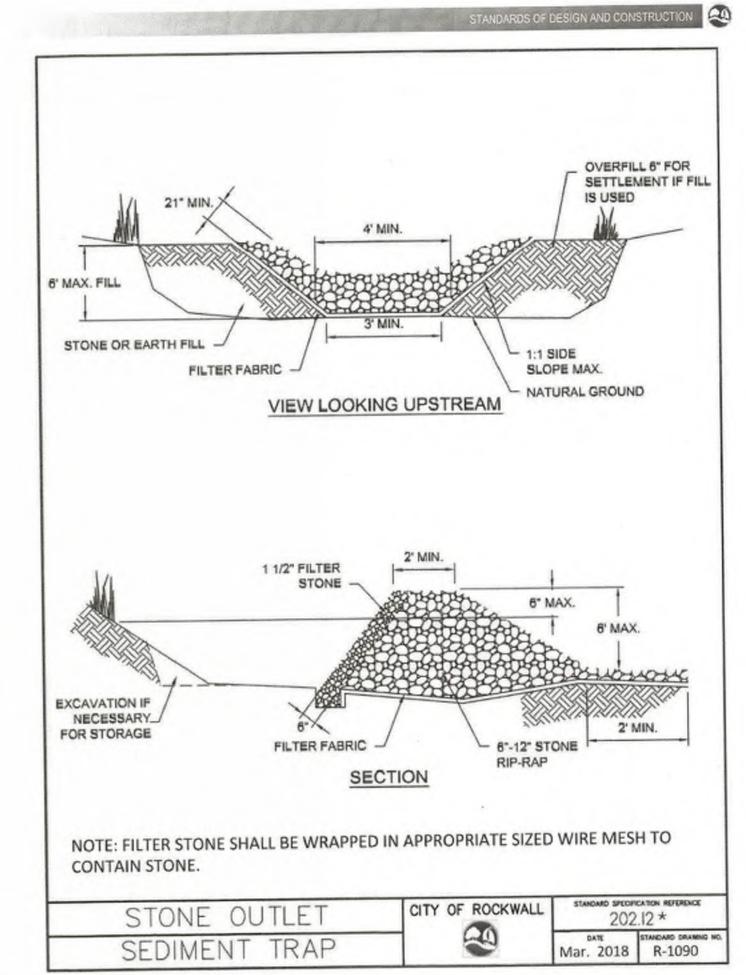

CITY OF ROCKWALL

PAGE | 204

RECORD DRAWINGS

To the best of our knowledge Petitt-ECD, L.P., hereby states that this plan is As-Built. This information provided is based on surveying at the site and information provided by the contractor.

CHARLES A. LAMPING, P.E. 10-15-2025 CHARLES A. LAMPING, P.E.

RELEASED FOR CONSTRUCTION ALL RESPONSIBILITY FOR ADEQUACY OF DESIGN REMAINS WITH THE DESIGN ENGINEER. THE CITY OF ROCKWALL, IN REVIEWING AND RELEASING PLANS FOR CONSTRUCTION, ASSUMES NO RESPONSIBILITY FOR ADEQUACY OR ACCURACY OF

CAUTION! EXISTING UTILITIES

INTRACTOR SHOULD CALL 1-800-DIG-TESS PRIOR TO BEGINNING ANY CONSTRUCTION CONTRACTOR SHOULD CALL 1-800-DIG-TESS PRIOR TO BEGINNING ANY CONSTRUCTION ACTIVITIES FOR EXISTING UTILITY LOCATIONS. EXISTING UTILITIES AND UNDERGROUND FACILITIES INDICATED ON THESE PLANS HAVE BEEN LOCATED FROM REFERENCE INFORMATION. IT IS THE RESPONSIBILITY OF THE CONTRACTOR TO VERIFY BOTH HORIZONTALLY AND VERTICALLY THE LOCATION OF ALL EXISTING UTILITIES AND UNDERGROUND FACILITIES PRIOR TO CONSTRUCTION AND TO TAKE NECESSARY PRECAUTIONS IN ORDER TO PROTECT ALL FACILITIES ENCOUNTERED. THE CONTRACTOR SHALL PRESERVE AND PROTECT ALL EXISTING UTILITIES FROM DAMAGE DURING CONSTRUCTION.

BENCHMARKS: CP 101 - Square cut on headwall west side of Rochelle road & 54' south

of center of Polar Point Drive Elevation = 559.95 CP 103 - "X" in concrete east side of Rochelle Road, 1834' south of center of Polar Point Dr. Elevation = 564.54' CP 104 - Capped 5/8" Iron rod east side of Rochelle Road & 1250' south of the center of Polar Point Dr. Elevation = 572.70' CP 105 - Capped 5/8" Iron rod east side of Rochelle Road & 826' south of the center of Polar Point Dr. Elevation = 568.75

PETITT - ECD

ENGINEERING SURVEYING CONSTRUCTION ADMINISTRATION TBPELS REGISTRATION ENGINEERING FIRM #001145 - SURVEYING FIRM #10194792 1600 N. COLLINS BLVD 201 WINDCO CIRCLE SUITE 3300 SUITE 100
RICHARDSON, TX 75080 WYLIE, TX 75098

972,941,8400

DRAWN: RH DATE: 8/08/2024 CHECKED: CAL PROJECT NO.: 06537 DWG FILE NAME: 06537-C-DETAILS-2.DWG

THIS DOCUMENT IS RELEASED FOR THE PURPOSE OF CONSTRUCTION. THE SEAL APPEARING ON THIS DOCUMENT WAS AUTHORIZED BY CHARLES A. LAMPING, P.E. 88554



EROSION CONTROL DETAILS 2


TERRACINA ESTATES PHASE 2


CITY OF ROCKWALL, ROCKWALL COUNTY, TEXAS


OF 41


DATE


SHEET

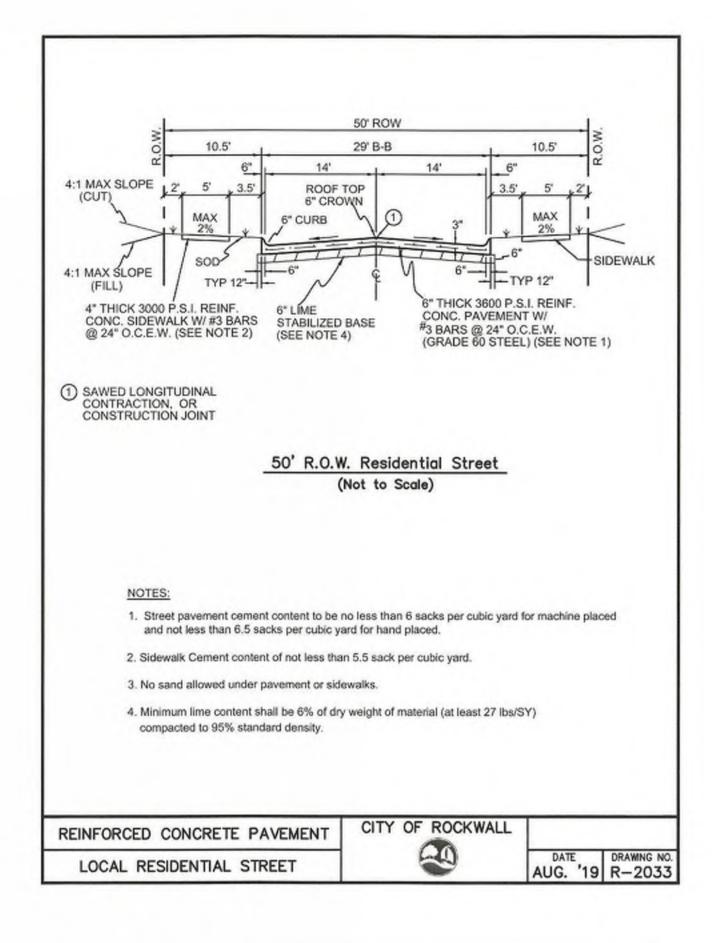


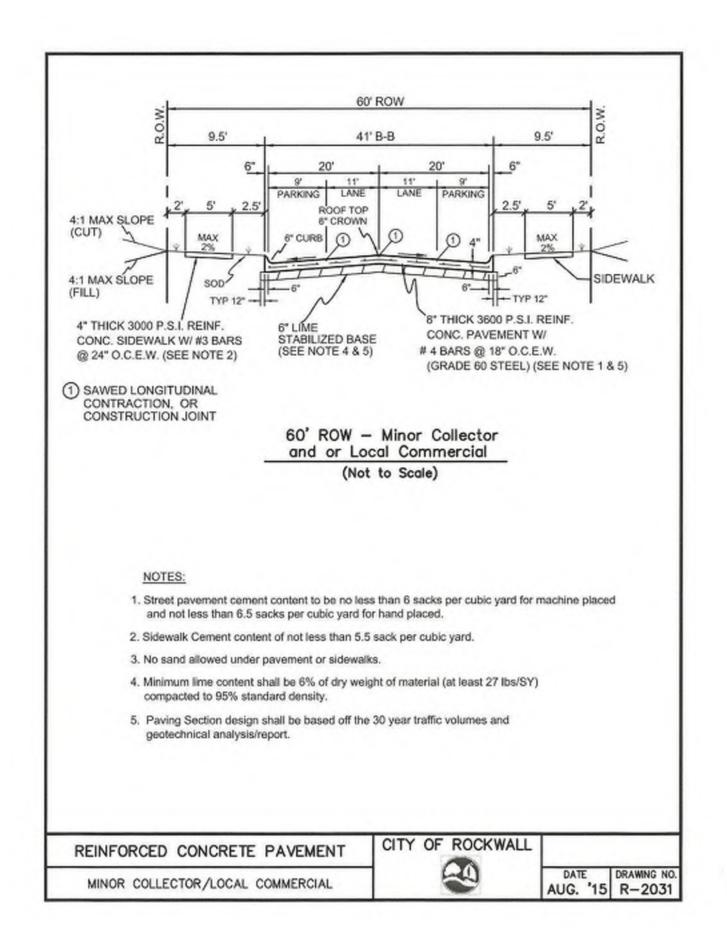


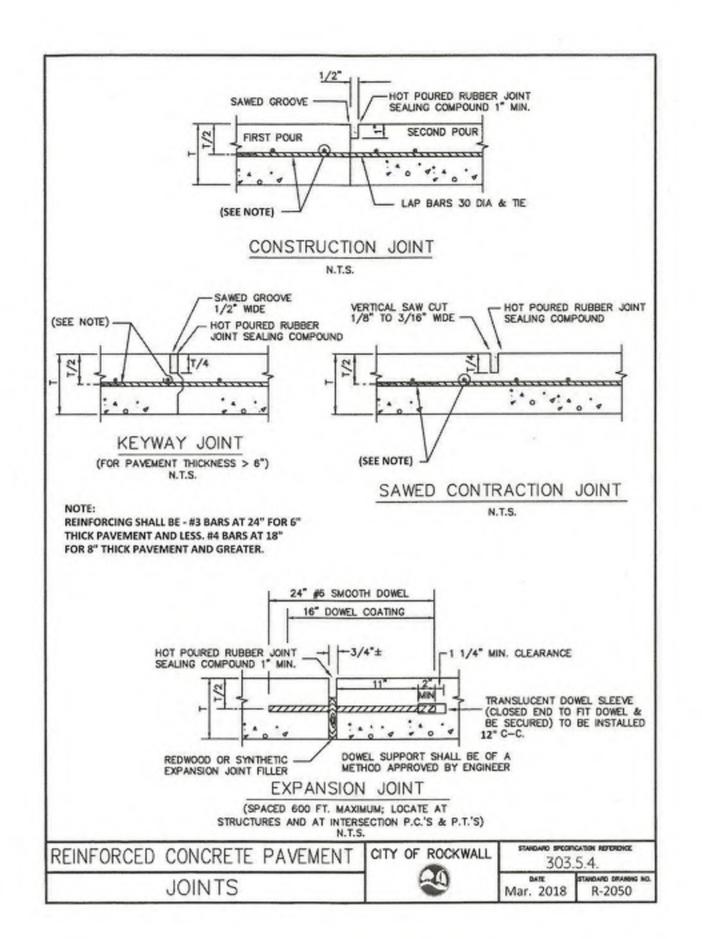


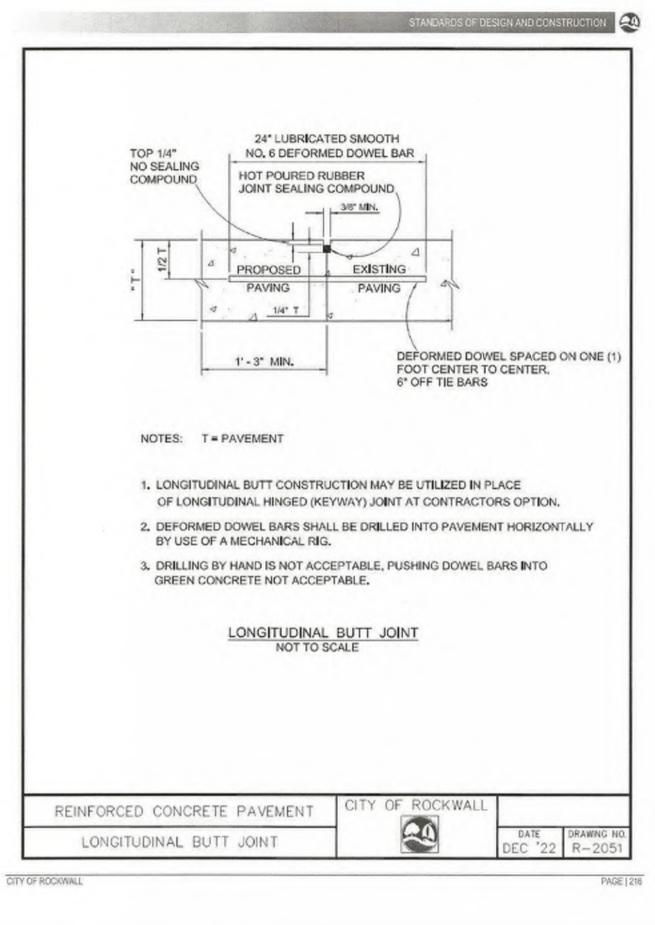

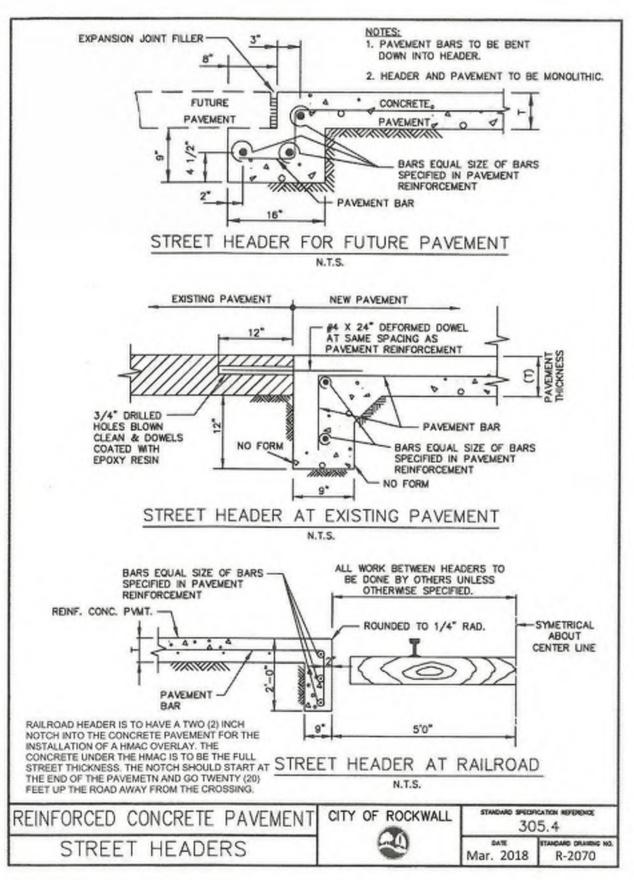

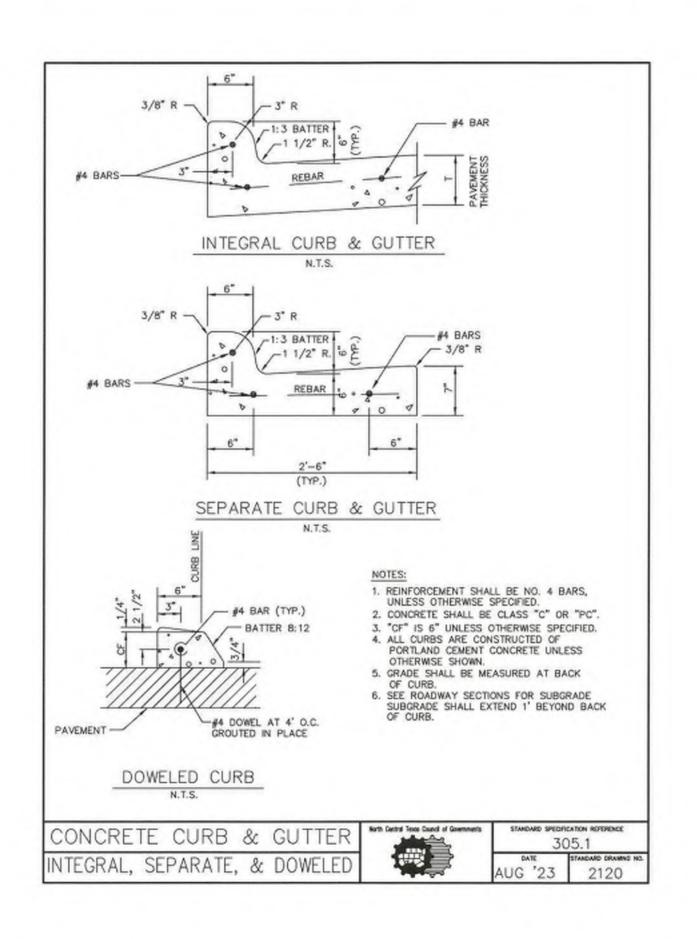

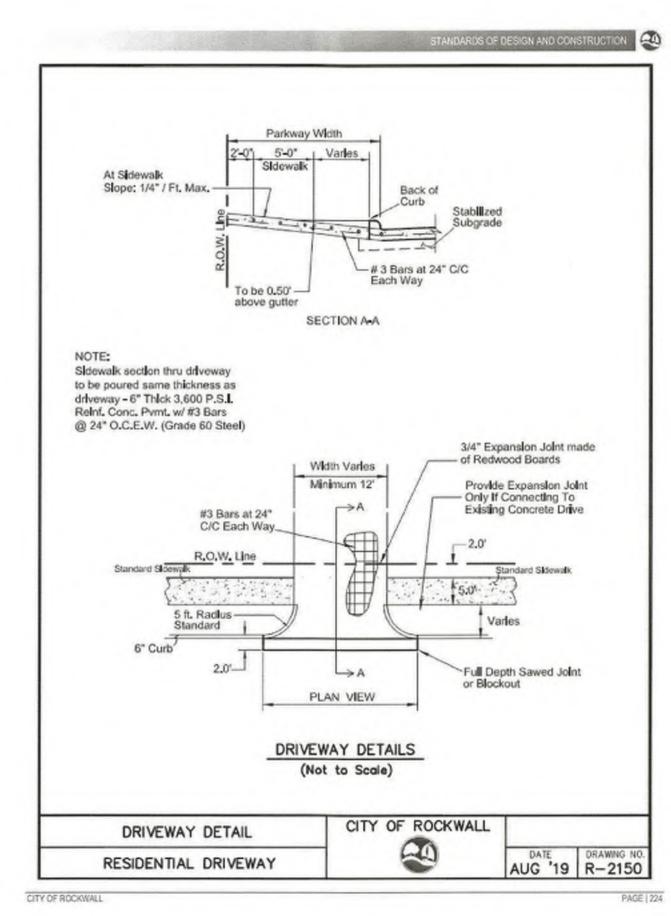

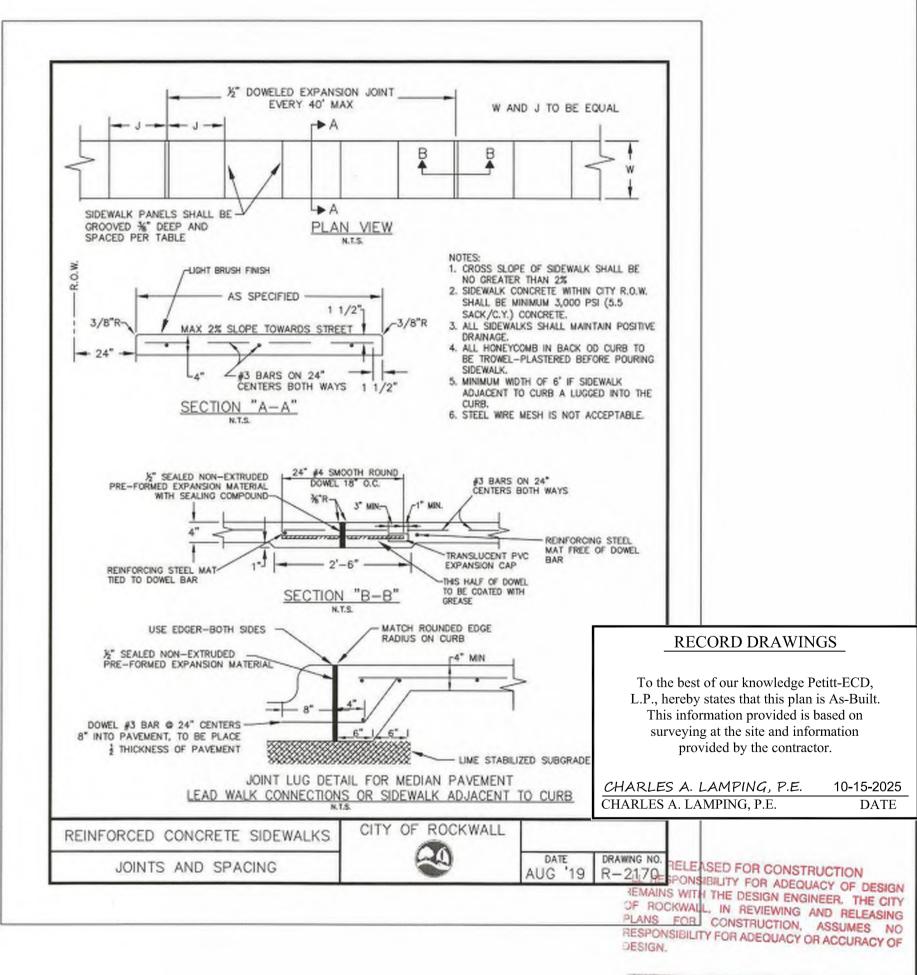



CAUTION! EXISTING UTILITIES

CONTRACTOR SHOULD CALL 1-800-DIG-TESS PRIOR TO BEGINNING ANY CONSTRUCTION ACTIVITIES FOR EXISTING UTILITY LOCATIONS. EXISTING UTILITIES AND UNDERGROUND

FACILITIES INDICATED ON THESE PLANS HAVE BEEN LOCATED FROM REFERENCE INFORMATION. IT IS THE RESPONSIBILITY OF THE CONTRACTOR TO VERIFY BOTH HORIZONTALLY AND VERTICALLY THE LOCATION OF ALL EXISTING UTILITIES AND

UNDERGROUND FACILITIES PRIOR TO CONSTRUCTION AND TO TAKE NECESSARY ECAUTIONS IN ORDER TO PROTECT ALL FACILITIES ENCOUNTERED. THE CONTRACTOR


SHALL PRESERVE AND PROTECT ALL EXISTING UTILITIES FROM DAMAGE DURING CONSTRUCTION.

CP 101 - Square cut on headwall west side of Rochelle road & 54' south of center of Polar Point Drive Elevation = 559.95 CP 103 - "X" in concrete east side of Rochelle Road, 1834' south of center of Polar Point Dr. Elevation = 564.54'

CP 104 - Capped 5/8" Iron rod east side of Rochelle Road & 1250' south of the center of Polar Point Dr. Elevation = 572.70" CP 105 - Capped 5/8" Iron rod east side of Rochelle Road & 826' south 1600 N. COLLINS BLVD of the center of Polar Point Dr. Elevation = 568.75' **SUITE 3300** RICHARDSON, TX 75080

PETITT - ECD

ENGINEERING SURVEYING CONSTRUCTION ADMINISTRATION TBPELS REGISTRATION ENGINEERING FIRM #001145 - SURVEYING FIRM #10194792 201 WINDCO CIRCLE WYLIE, TX 75098 972.941.8401

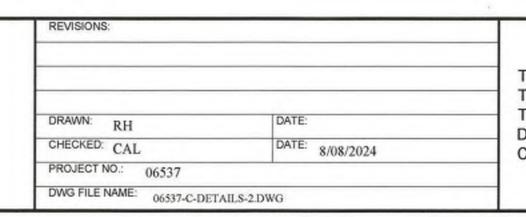

THIS DOCUMENT IS RELEASED FOR THE PURPOSE OF CONSTRUCTION THE SEAL APPEARING ON THIS DOCUMENT WAS AUTHORIZED BY CHARLES A. LAMPING, P.E. 88554




PAVING DETAILS


TERRACINA ESTATES PHASE 2

CITY OF ROCKWALL, ROCKWALL COUNTY, TEXAS

OF

SHEET

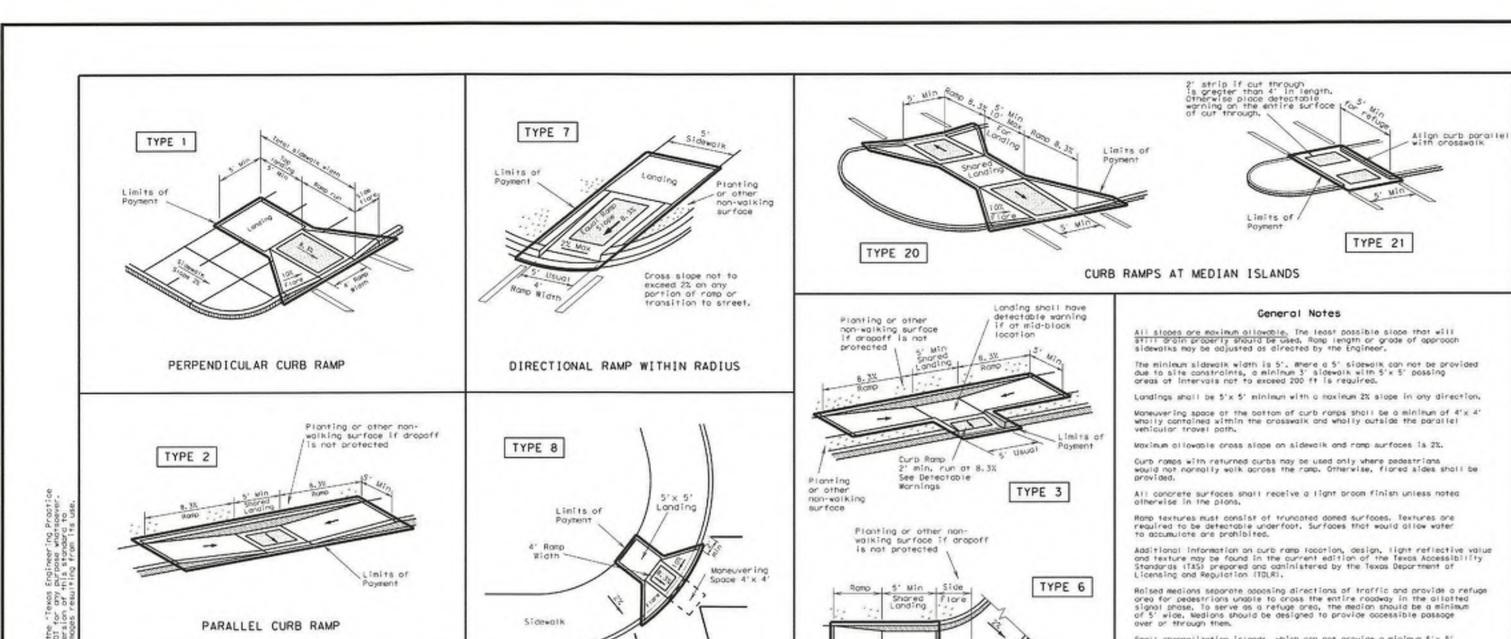

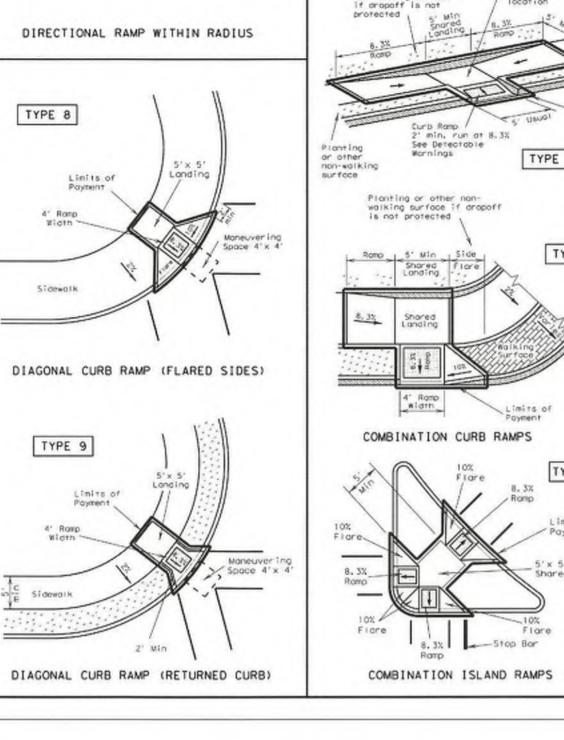



Texas Department of Transportation


Design Division (Roadway)


PEDESTRIAN FACILITIES


PED-02 SHEET 1 OF


CURB RAMPS

COTACOT March 2002 one reserve receive receive as receive a

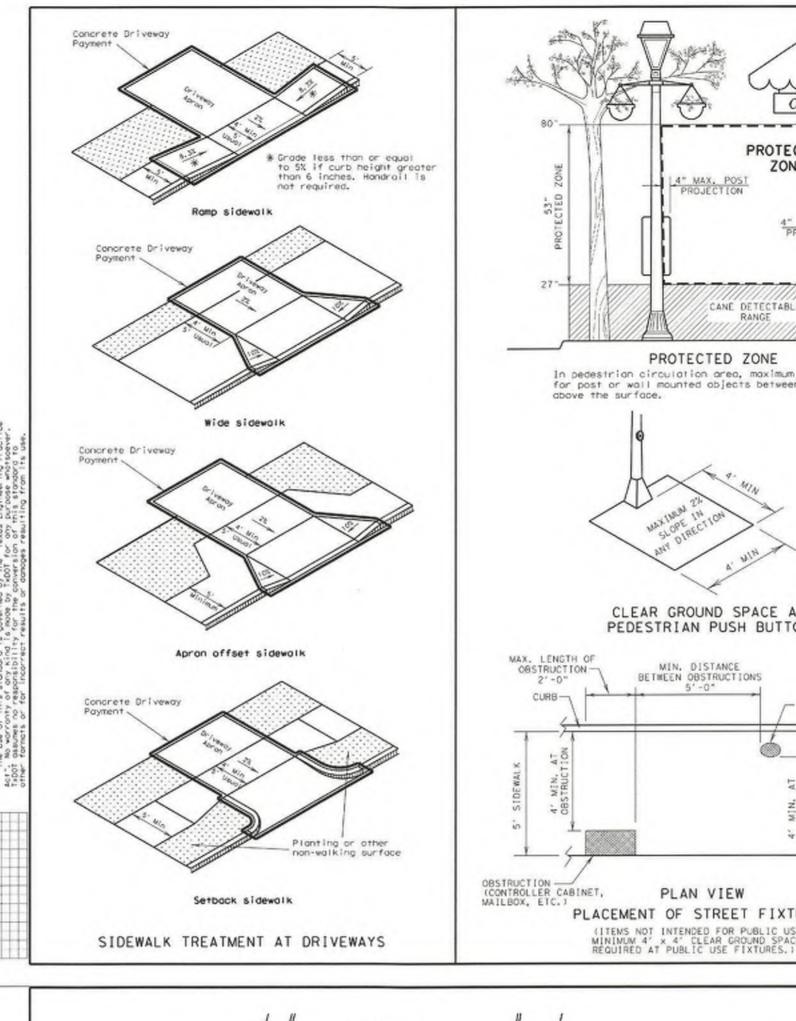

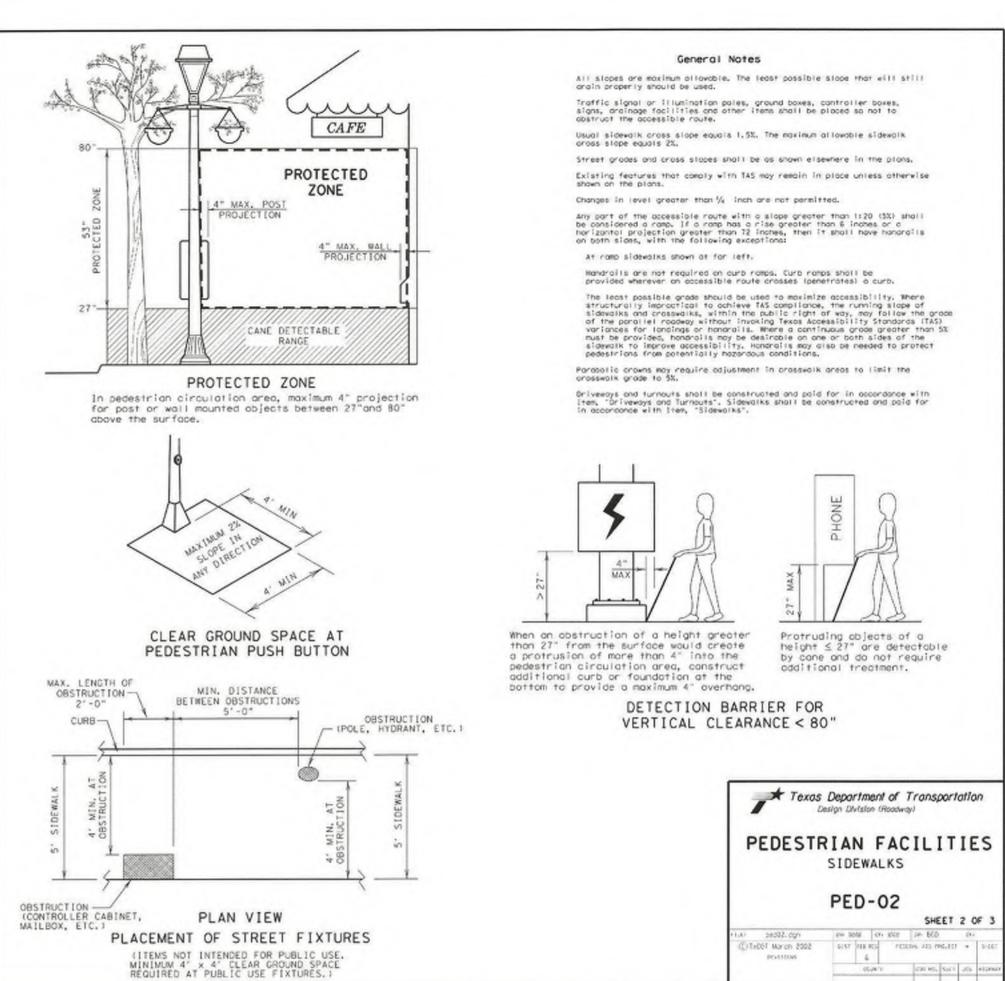

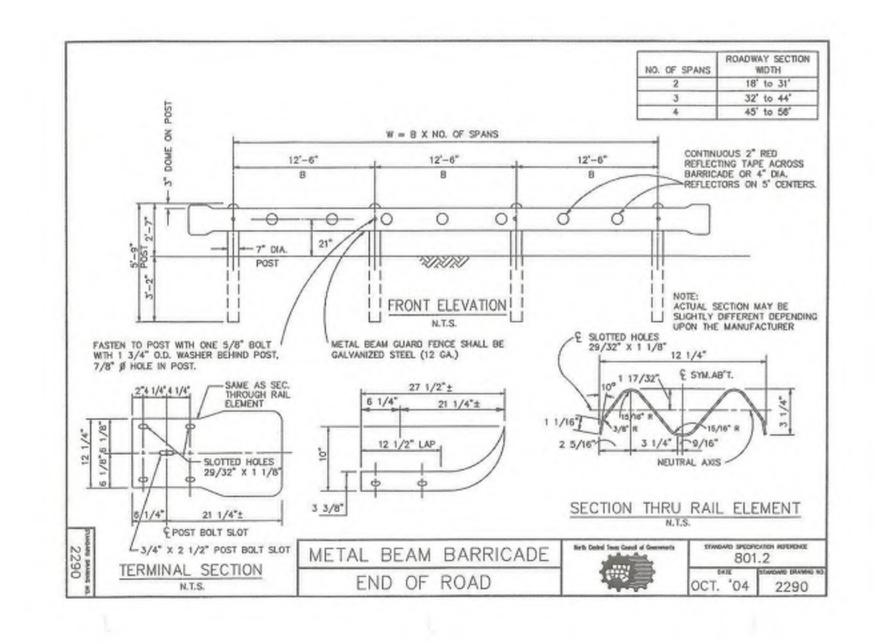

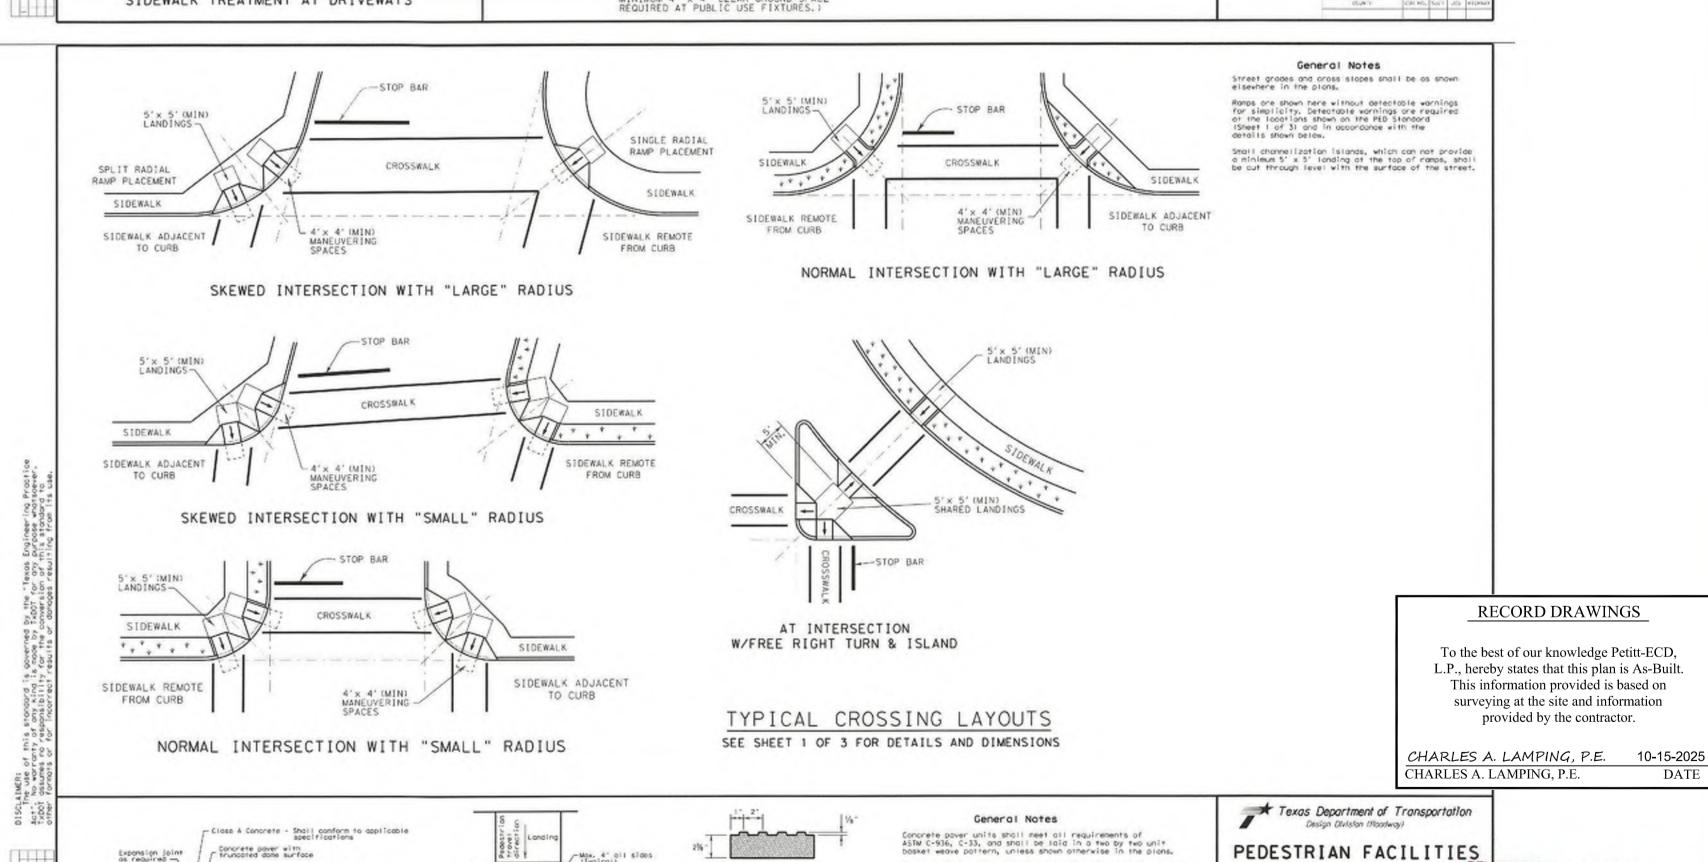

CAUTION! EXISTING UTILITIES

NTRACTOR SHOULD CALL 1-800-DIG-TESS PRIOR TO BEGINNING ANY CONSTRUCTION ACTIVITIES FOR EXISTING UTILITY LOCATIONS. EXISTING UTILITIES AND UNDERGROUN
FACILITIES INDICATED ON THESE PLANS HAVE BEEN LOCATED FROM REFERENCE. INFORMATION. IT IS THE RESPONSIBILITY OF THE CONTRACTOR TO VERIFY BOTH HORIZONTALLY AND VERTICALLY THE LOCATION OF ALL EXISTING UTILITIES AND UNDERGROUND FACILITIES PRIOR TO CONSTRUCTION AND TO TAKE NECESSARY SECAUTIONS IN ORDER TO PROTECT ALL FACILITIES ENCOUNTERED. THE CONTRACTOR SHALL PRESERVE AND PROTECT ALL EXISTING UTILITIES FROM DAMAGE DURING CONSTRUCTION.

TYPE 4

Linits of

DIAGONAL COMBINATION CURB RAMP

Radius and Contained in Crosswalk

Perpendicular to the Tangent of the Curb

BENCHMARKS:

CP 101 - Square cut on headwall west side of Rochelle road & 54' south of center of Polar Point Drive Elevation = 559.95 CP 103 - "X" in concrete east side of Rochelle Road, 1834' south of center of Polar Point Dr. Elevation = 564.54' CP 104 - Capped 5/8" Iron rod east side of Rochelle Road & 1250' south

of the center of Polar Point Dr. Elevation = 572.70'

of the center of Polar Point Dr. Elevation = 568.75'

CP 105 - Capped 5/8" Iron rod east side of Rochelle Road & 826' south

PETITT - ECD

ENGINEERING SURVEYING CONSTRUCTION ADMINISTRATION TBPELS REGISTRATION ENGINEERING FIRM #001145 - SURVEYING FIRM #10194792 201 WINDCO CIRCLE 1600 N. COLLINS BLVD **SUITE 3300** SUITE 100 RICHARDSON, TX 75080 WYLIE, TX 75098 972.941.8400

REVISIONS:	
Million III	
DRAWN: RH	DATE:
CHECKED: CAL	DATE: 8/08/2024
PROJECT NO.: 06537	
DWG FILE NAME: 06537-C-DETAILS	S-2.DWG

Side flore

2" Sand Cushion -

> THIS DOCUMENT IS RELEASED FOR THE PURPOSE OF CONSTRUCTION. THE SEAL APPEARING ON THIS DOCUMENT WAS AUTHORIZED BY CHARLES A. LAMPING, P.E. 88554

Truncated Dome Pattern Curb Ramp

DETECTABLE WARNINGS

Concrete pover with fruncated done surface

Section A-A

1" morter bed - Shall conform to applicable specifications

/ Control joint permissible



Concrete pover with

PAVING DETAILS 2

Domes shall be aligned in the direction of pedestrion travel.

Concrete power units shall have a truncated dame top surface for detectable worning to pecestrians.

Concrete power unit color for the ramp shall be a contrasting color that provides a light reflective value that significantly contrasts with the adjacent surfaces. The color of the concrete power units shall be shown elsewhere in the plans, (Adjacent surfaces include side flores).

Concrete power units shall be sow out only and any out unit shall not be less than 25 percent of a full unit.

TERRACINA ESTATES PHASE 2

CITY OF ROCKWALL, ROCKWALL COUNTY, TEXAS

36 OF

41

SHEET

RECORD DRAWINGS

To the best of our knowledge Petitt-ECD,

L.P., hereby states that this plan is As-Built.

This information provided is based on

surveying at the site and information

provided by the contractor.

SHEERISONS ISH ITY FOR ADEQUACY OR ACCURACY OF


H THE DESIGN ENGINEER. THE CITY LL, IN REVIEWING AND RELEASING


CONSTRUCTION, ASSUMES NO


INTERSECTION LAYOUTS RESPONSIBILITY FOR ADEQUACY OF DESIGN


PLANS FO

DETECTABLE WARNING MAINS WITH

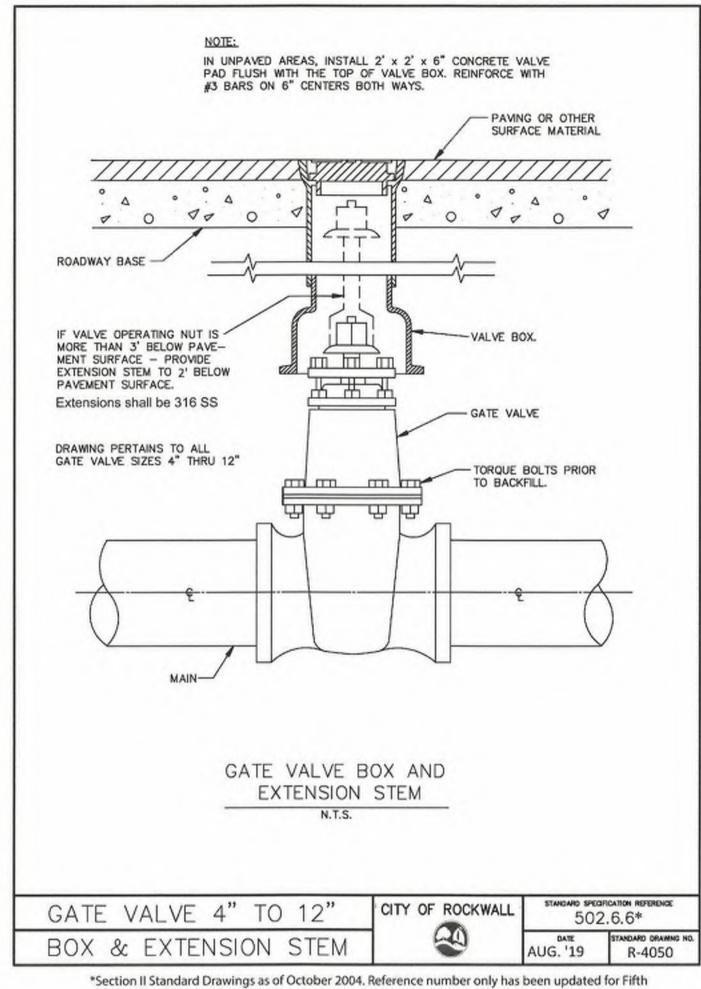

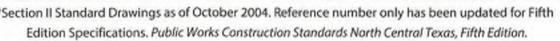

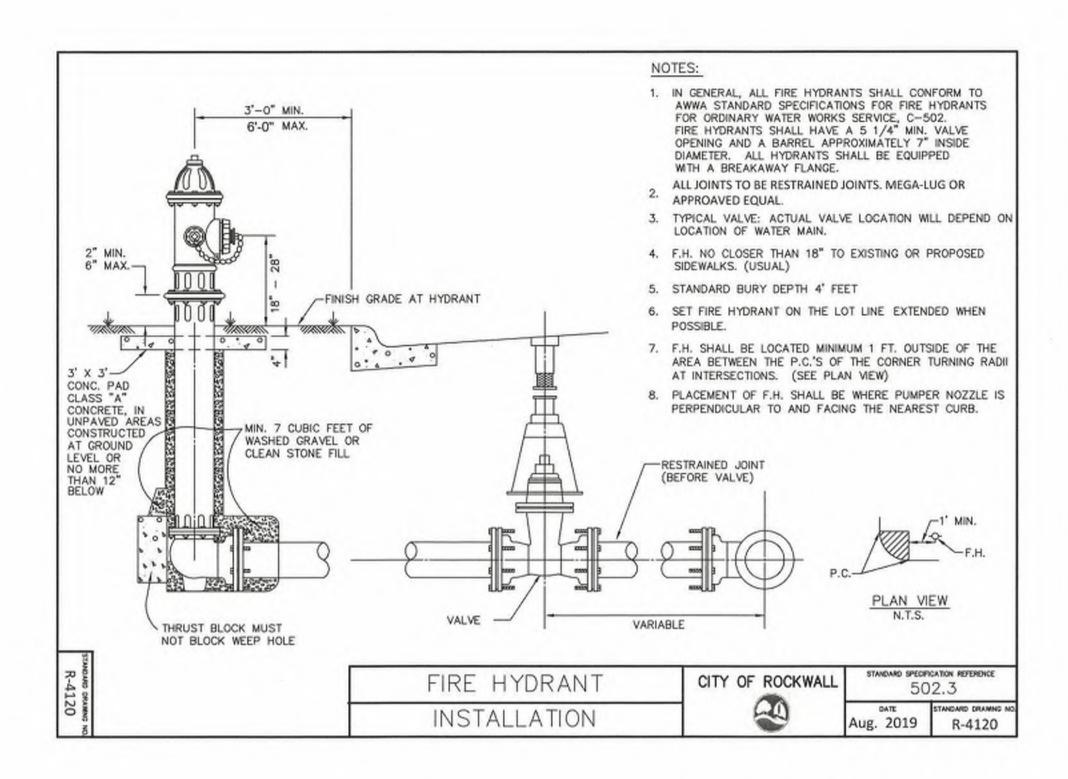

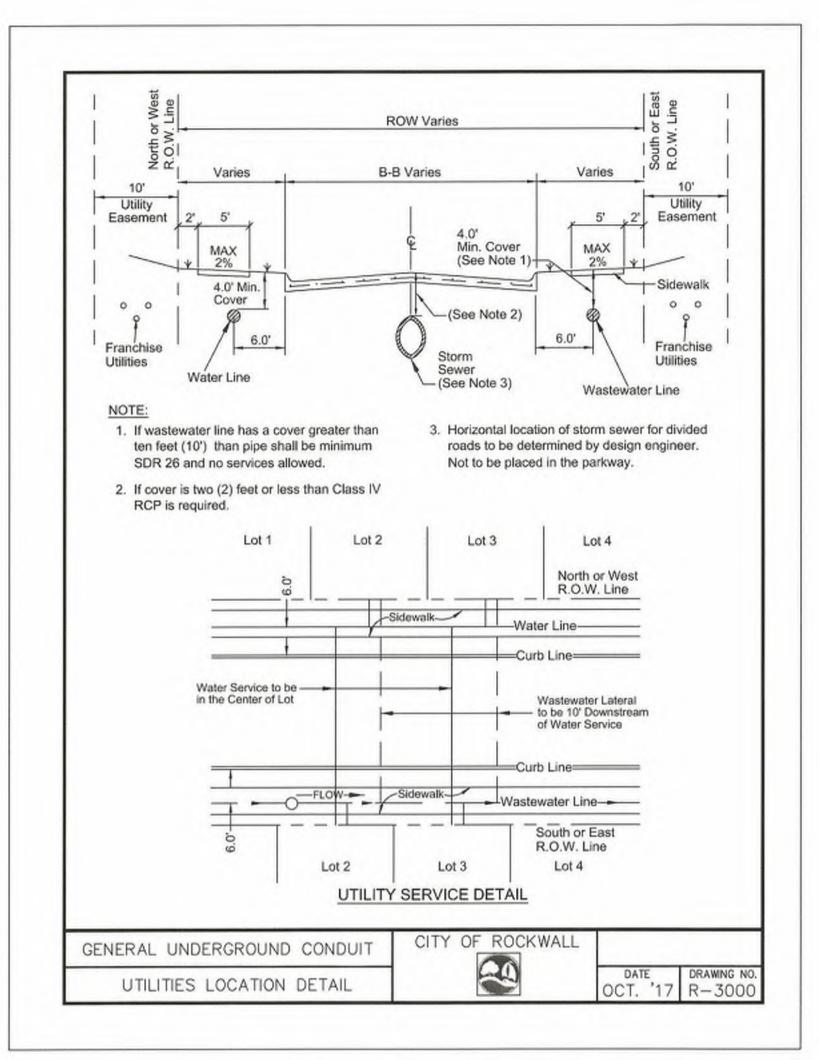

RECORD DRAWINGS

To the best of our knowledge Petitt-ECD, L.P., hereby states that this plan is As-Built. This information provided is based on surveying at the site and information provided by the contractor.

CHARLES A. LAMPING, P.E. 10-15-2025 CHARLES A. LAMPING, P.E.

RELEASED FOR CONSTRUCTION ALL RESPONSIBILITY FOR ADEQUACY OF DESIGN REMAINS WITH THE DESIGN ENGINEER. THE CITY OF ROCKWALL, IN REVIEWING AND RELEASING PLANS FOR CONSTRUCTION, ASSUMES NO RESPONSIBILITY FOR ADEQUACY OR ACCURACY OF

CAUTION! EXISTING UTILITIES CONTRACTOR SHOULD CALL 1-800-DIG-TESS PRIOR TO BEGINNING ANY CONSTRUCTION ACTIVITIES FOR EXISTING UTILITY LOCATIONS. EXISTING UTILITIES AND UNDERGROUND FACILITIES INDICATED ON THESE PLANS HAVE BEEN LOCATED FROM REFERENCE INFORMATION. IT IS THE RESPONSIBILITY OF THE CONTRACTOR TO VERIFY BOTH HORIZONTALLY AND VERTICALLY THE LOCATION OF ALL EXISTING UTILITIES AND UNDERGROUND FACILITIES PRIOR TO CONSTRUCTION AND TO TAKE NECESSARY PRECAUTIONS IN ORDER TO PROTECT ALL FACILITIES ENCOUNTERED. THE CONTRACTOR

SHALL PRESERVE AND PROTECT ALL EXISTING UTILITIES FROM DAMAGE DURING CONSTRUCTION.

BENCHMARKS:

CP 101 - Square cut on headwall west side of Rochelle road & 54' south of center of Polar Point Drive Elevation = 559.95

CP 103 - "X" in concrete east side of Rochelle Road, 1834' south of center of Polar Point Dr. Elevation = 564.54" CP 104 - Capped 5/8" Iron rod east side of Rochelle Road & 1250' south


of the center of Polar Point Dr. Elevation = 572.70' CP 105 - Capped 5/8" Iron rod east side of Rochelle Road & 826' south of the center of Polar Point Dr. Elevation = 568.75'

PETITT - ECD

ENGINEERING SURVEYING CONSTRUCTION ADMINISTRATION TBPELS REGISTRATION ENGINEERING FIRM #001145 - SURVEYING FIRM #10194792 1600 N. COLLINS BLVD 201 WINDCO CIRCLE **SUITE 3300** SUITE 100 RICHARDSON, TX 75080 WYLIE, TX 75098

DRAWN: RH	DATE:
CHECKED: CAL	DATE: 8/08/2024
PROJECT NO.: 06537	

THIS DOCUMENT IS RELEASED FOR THE PURPOSE OF CONSTRUCTION. THE SEAL APPEARING ON THIS DOCUMENT WAS AUTHORIZED BY CHARLES A. LAMPING, P.E. 88554

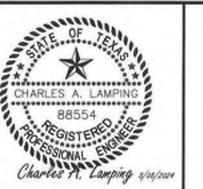



WATER DETAILS 1


TERRACINA ESTATES PHASE 2 CITY OF ROCKWALL, ROCKWALL COUNTY, TEXAS


OF


SHEET

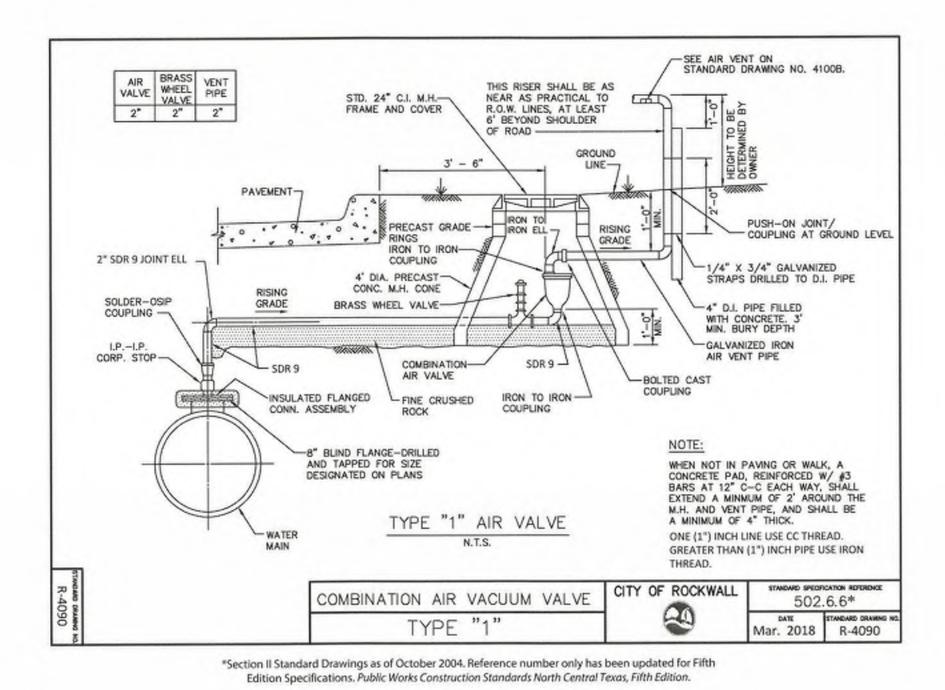


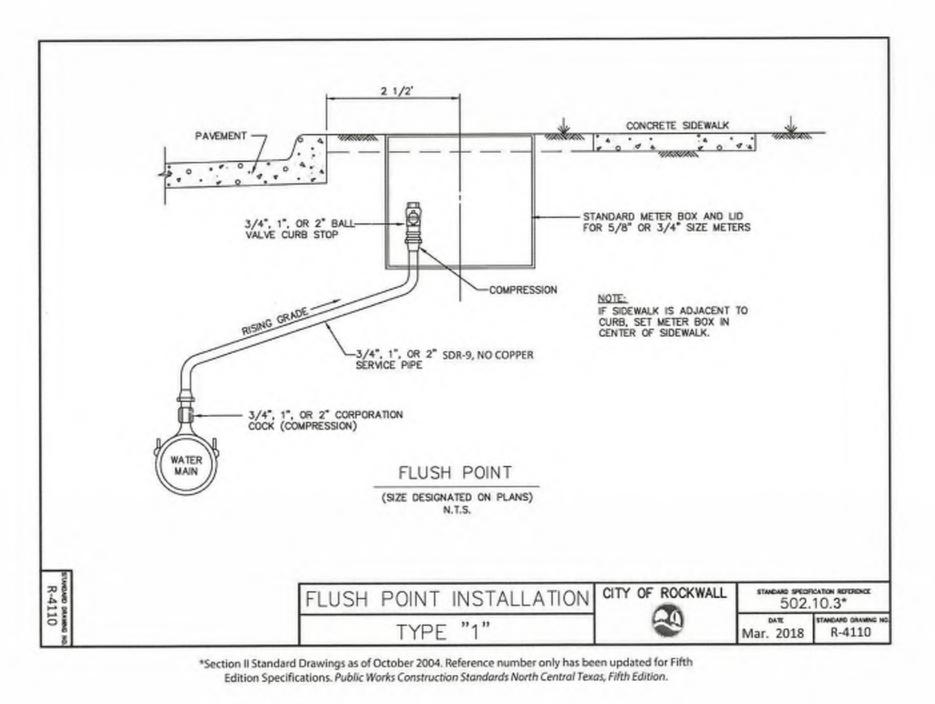


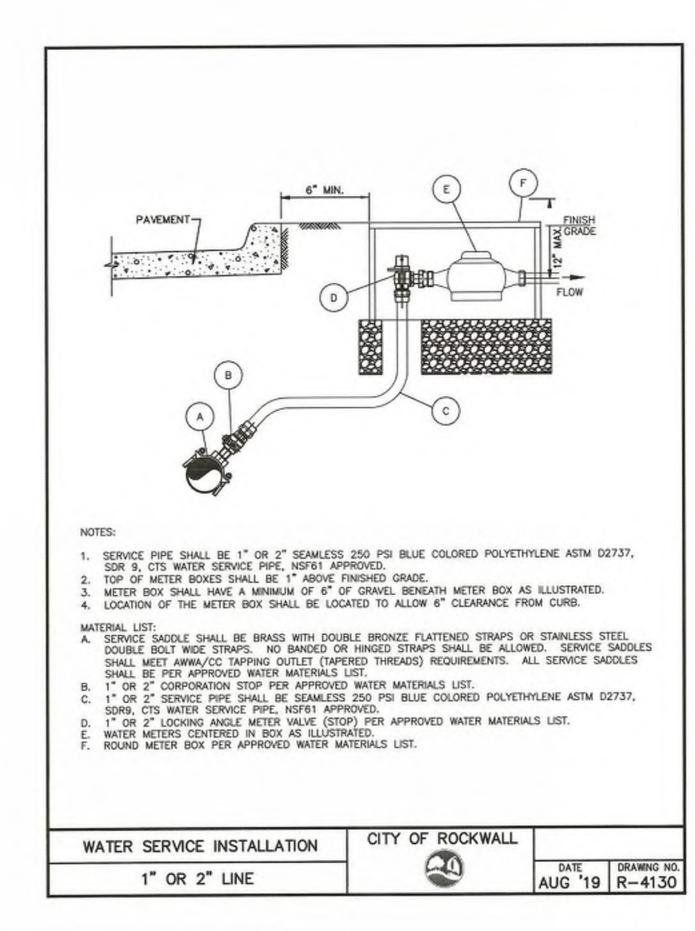


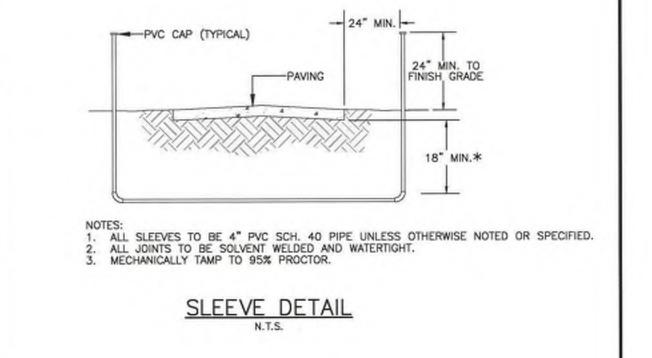

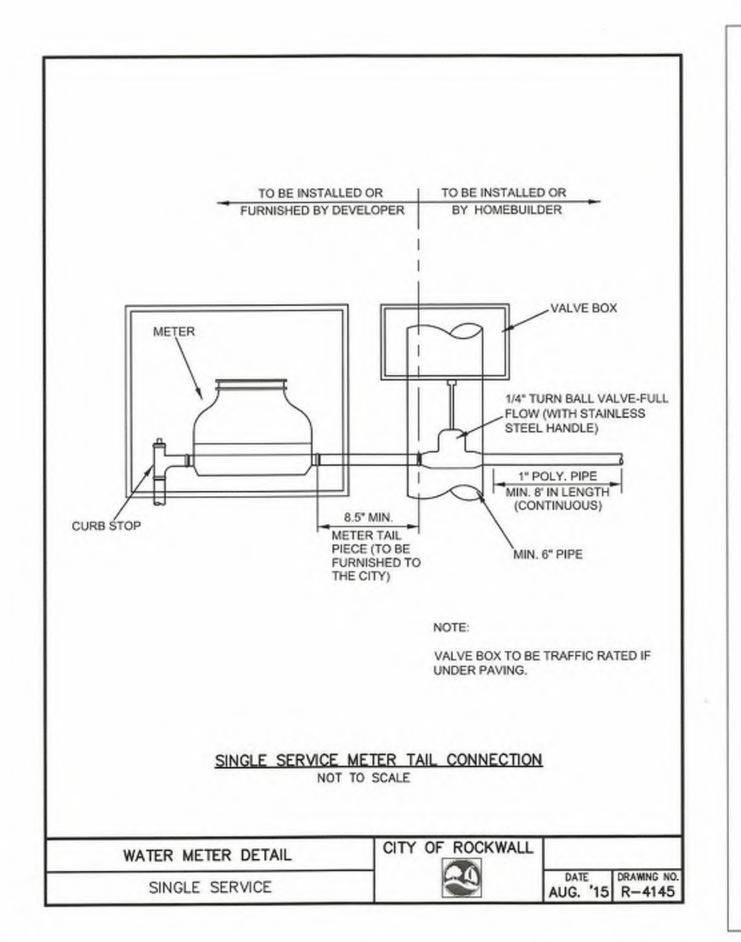

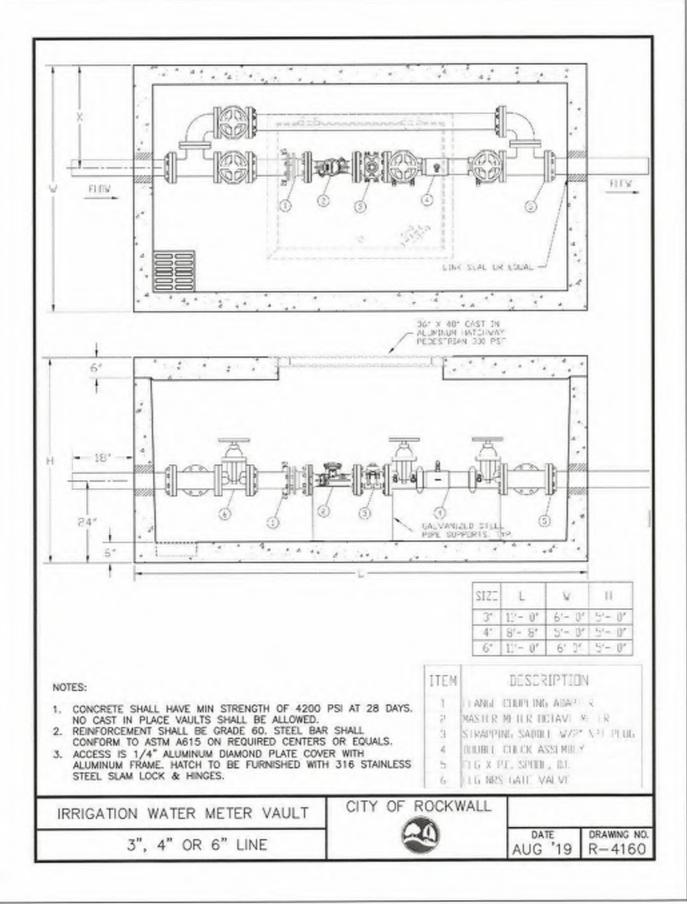

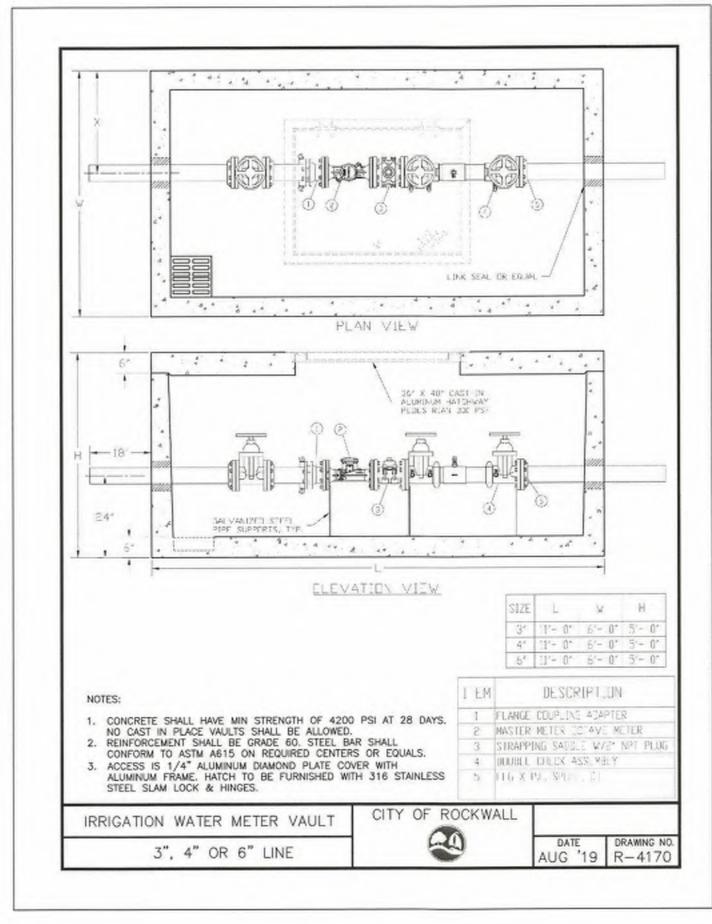

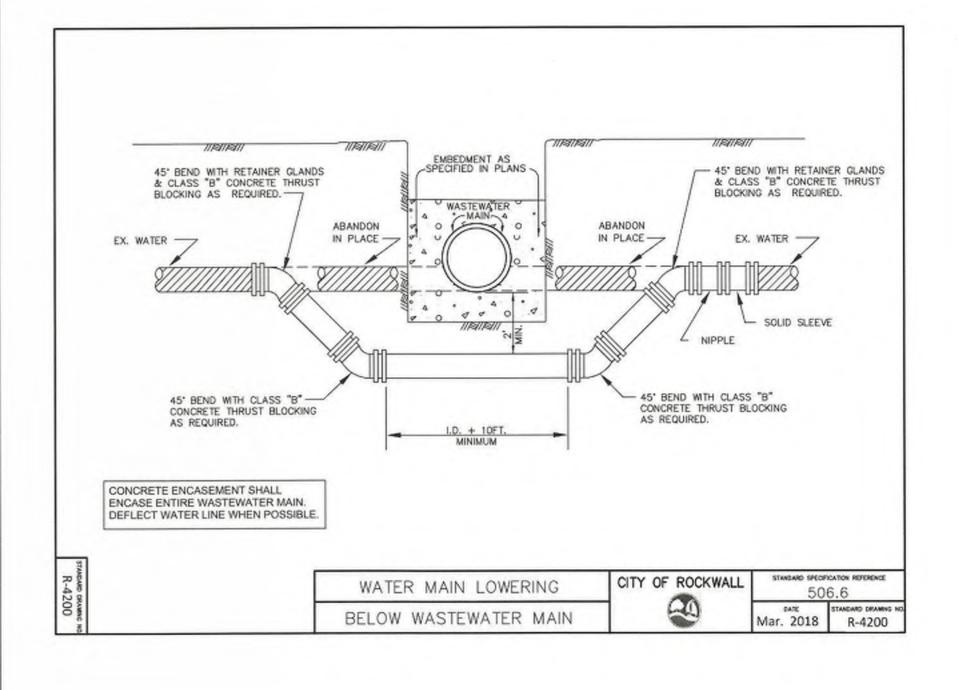

RECORD DRAWINGS

To the best of our knowledge Petitt-ECD,
L.P., hereby states that this plan is As-Built.
This information provided is based on surveying at the site and information provided by the contractor.

CHARLES A. LAMPING, P.E. 10-15-2025
CHARLES A. LAMPING, P.E. DATE

RELEASED FOR CONSTRUCTION
ULL RESPONSIBILITY FOR ADEQUACY OF DESIGN.
REMAINS WITH THE DESIGN ENGINEER. THE CITY OF ROCKWALL, IN REVIEWING AND RELEASING PLANS FOR CONSTRUCTION, ASSUMES NO RESPONSIBILITY FOR ADEQUACY OF ACCURACY OF DESIGN.

CITY

DATE

CAUTION! EXISTING UTILITIES

CONTRACTOR SHOULD CALL 1-800-DIG-TESS PRIOR TO BEGINNING ANY CONSTRUCTION ACTIVITIES FOR EXISTING UTILITY LOCATIONS. EXISTING UTILITIES AND UNDERGROUND FACILITIES INDICATED ON THESE PLANS HAVE BEEN LOCATED FROM REFERENCE INFORMATION. IT IS THE RESPONSIBILITY OF THE CONTRACTOR TO VERIFY BOTH HORIZONTALLY AND VERTICALLY THE LOCATION OF ALL EXISTING UTILITIES AND UNDERGROUND FACILITIES PRIOR TO CONSTRUCTION AND TO TAKE NECESSARY PRECAUTIONS IN ORDER TO PROTECT ALL FACILITIES ENCOUNTERED. THE CONTRACTOR SHALL PRESERVE AND PROTECT ALL EXISTING UTILITIES FROM DAMAGE DURING CONSTRUCTION.

BENCHMARKS:

CP 101 - Square cut on headwall west side of Rochelle road & 54' south of center of Polar Point Drive Elevation = 559.95

CP 103 - "X" in concrete east side of Rochelle Road, 1834' south of center of Polar Point Dr. Elevation = 564.54'

CP 104 - Capped 5/8" Iron rod east side of Rochelle Road & 1250' south of the center of Polar Point Dr. Elevation = 572.70'

CP 105 - Capped 5/8" Iron rod east side of Rochelle Road & 826' south of the center of Polar Point Dr. Elevation = 568.75'

PETITT - ECD

ENGINEERING SURVEYING
CONSTRUCTION ADMINISTRATION
TBPELS REGISTRATION
ENGINEERING FIRM #001145 - SURVEYING FIRM #10194792
1600 N. COLLINS BLVD 201 WINDCO CIRCLE
SUITE 3300 SUITE 100
RICHARDSON, TX 75080 WYLIE, TX 75098

972.941.8400

972.941.8401

	2-9-2
DRAWN: RH	DATE:
CHECKED: CAL	DATE: 8/08/2024
PROJECT NO.: 06537	

REVISIONS:

THIS DOCUMENT IS RELEASED FOR THE PURPOSE OF CONSTRUCTION. THE SEAL APPEARING ON THIS DOCUMENT WAS AUTHORIZED BY CHARLES A. LAMPING, P.E. 88554




WATER DETAILS 2

TERRACINA ESTATES PHASE 2


CITY OF ROCKWALL, ROCKWALL COUNTY, TEXAS


38 OF


41

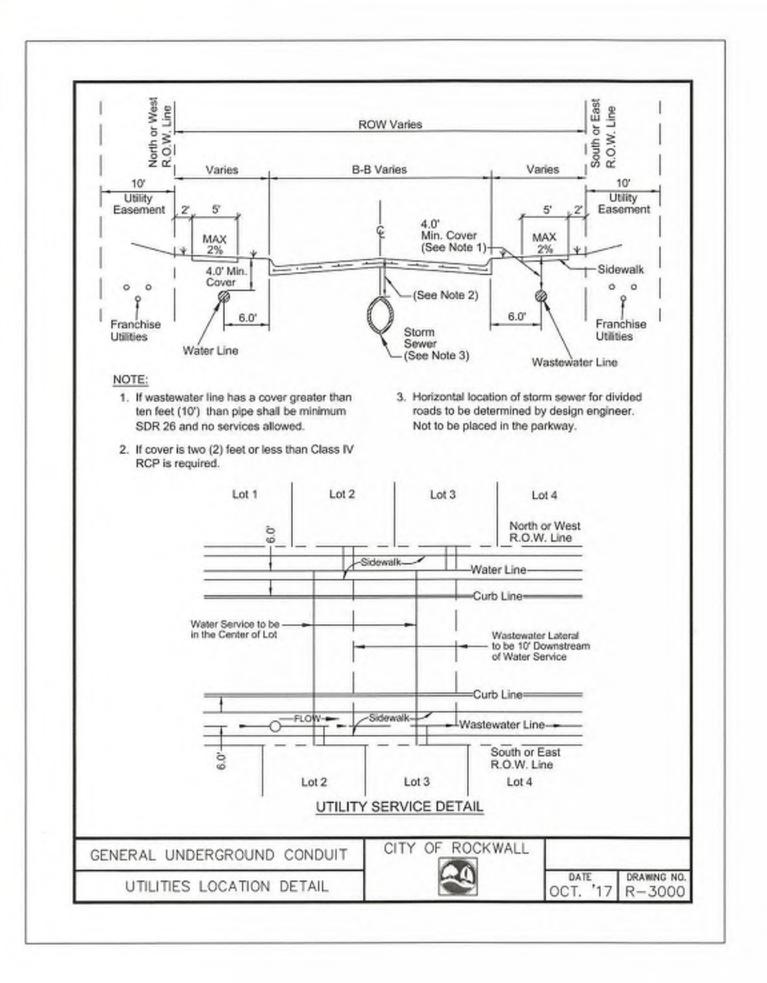



PLAN N.T.S.

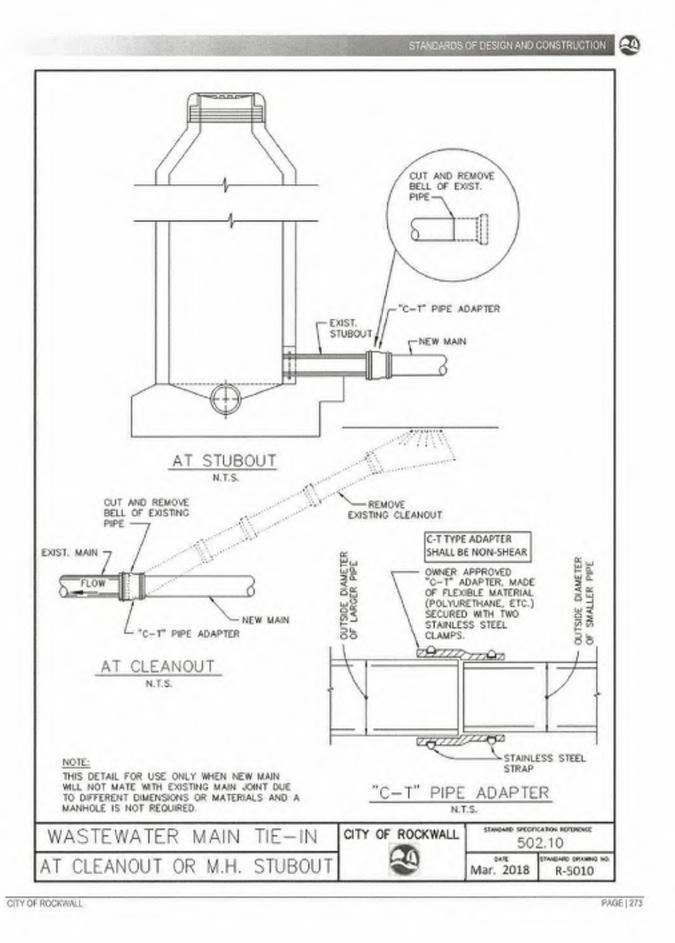


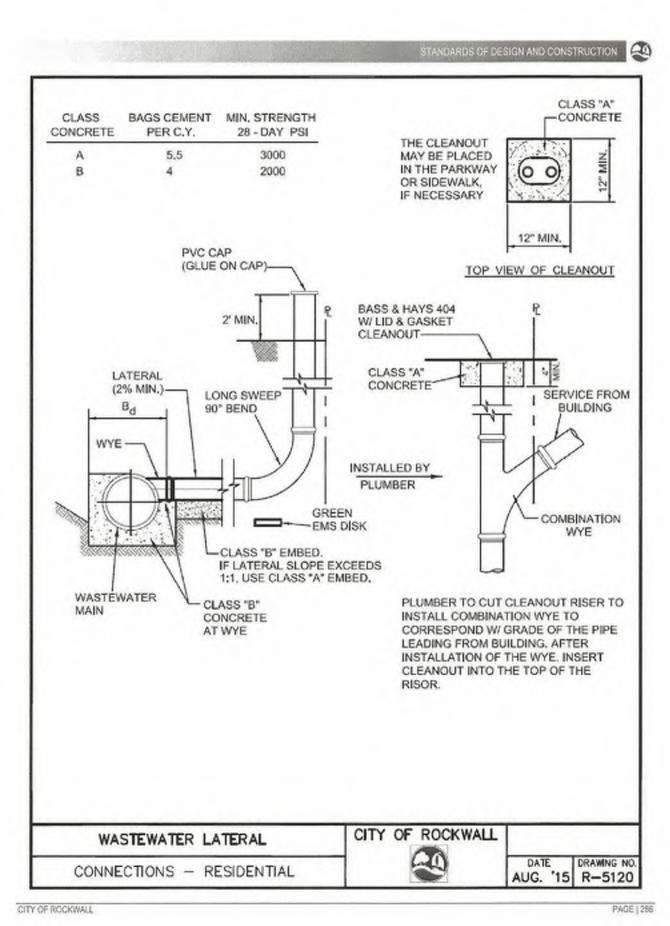

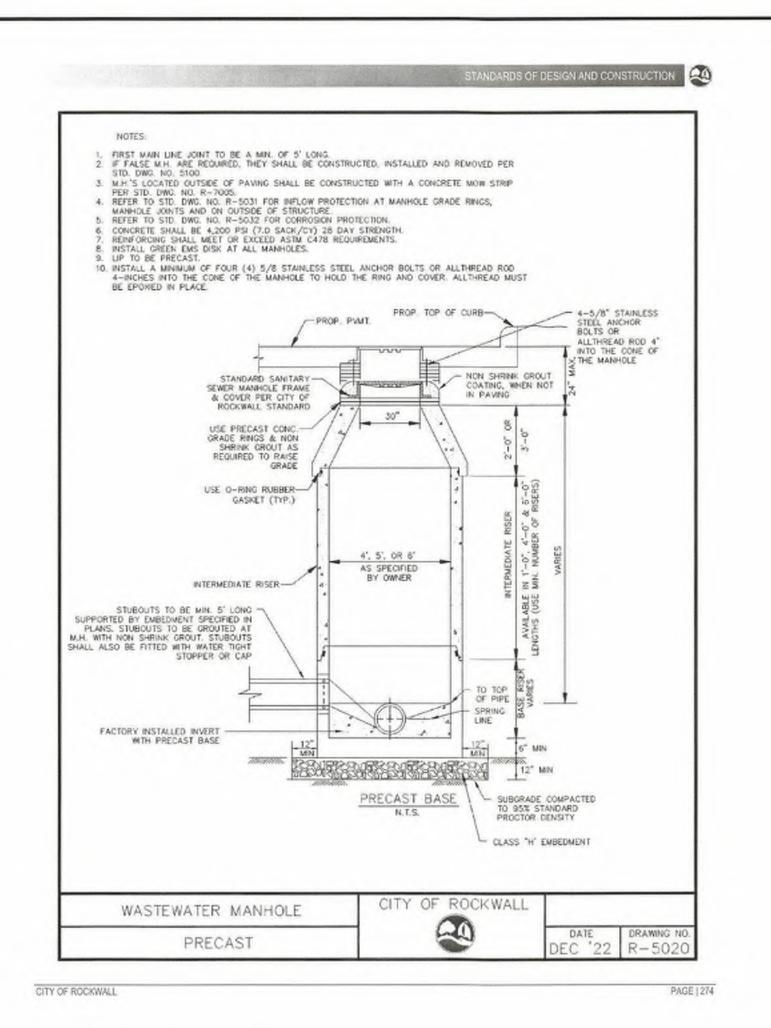

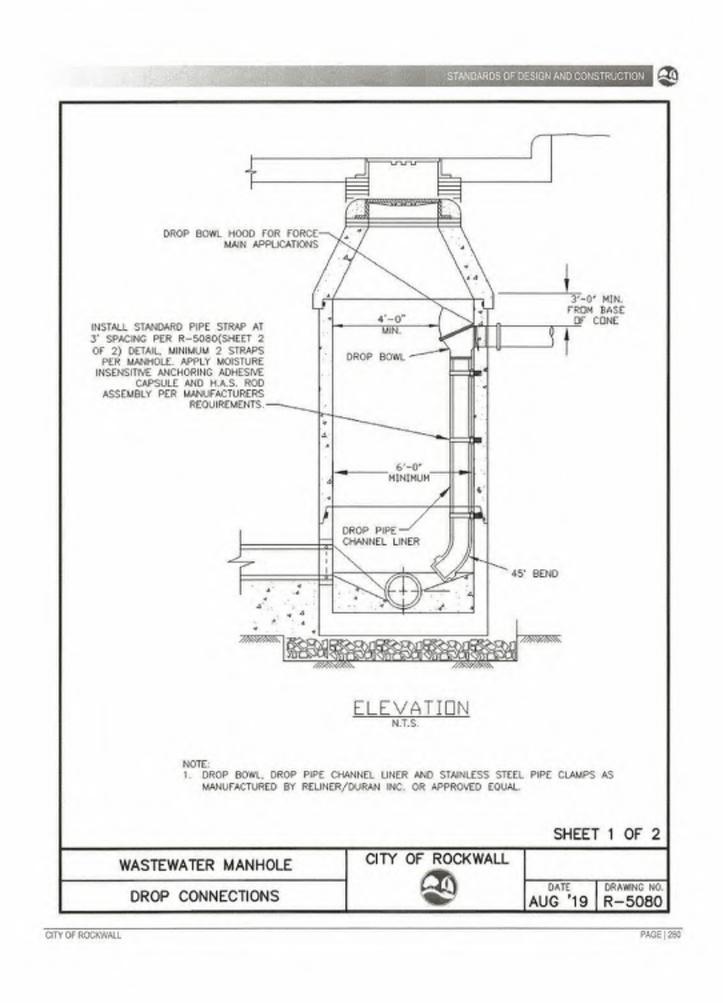

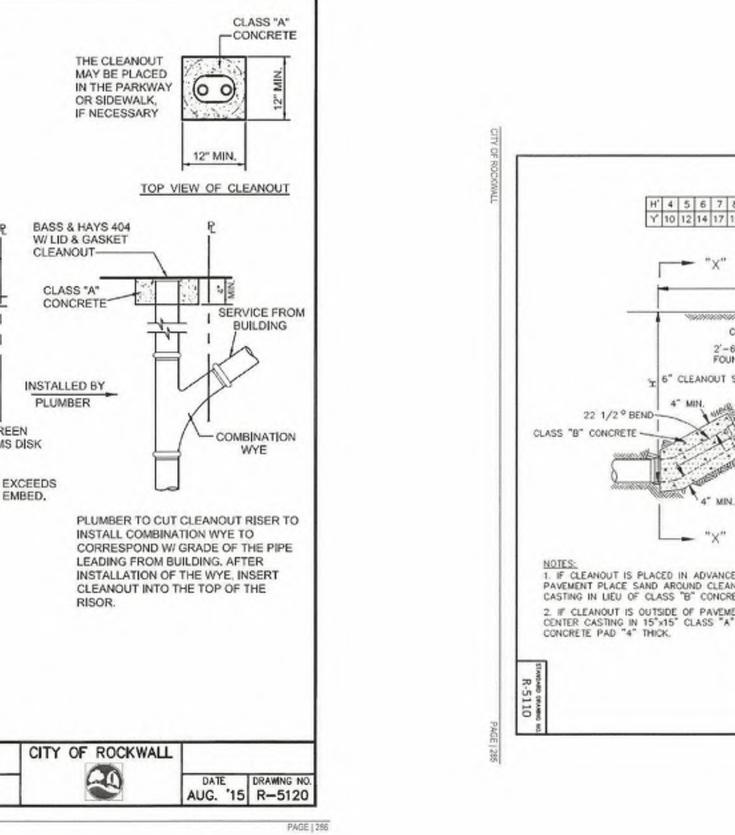

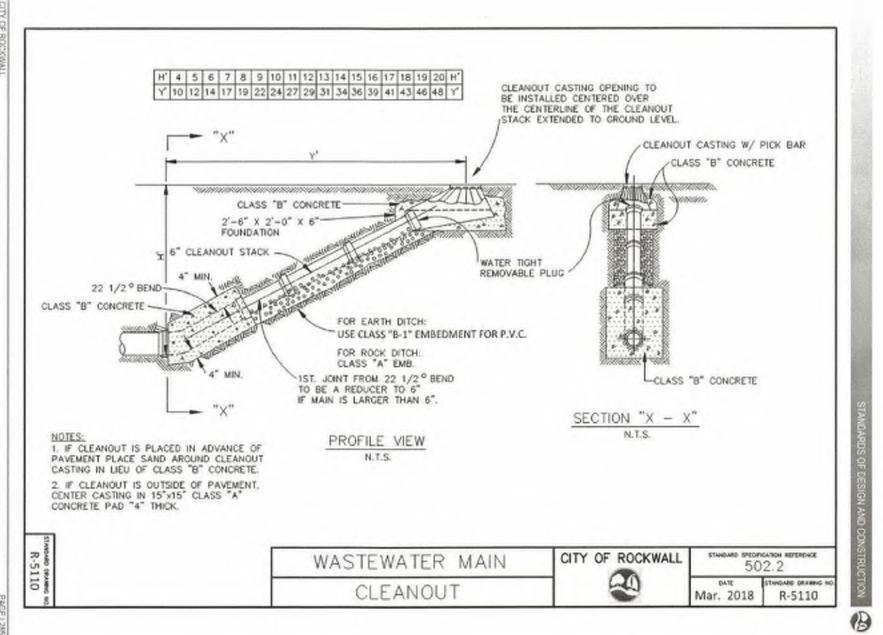

RECORD DRAWINGS

To the best of our knowledge Petitt-ECD, L.P., hereby states that this plan is As-Built. This information provided is based on surveying at the site and information provided by the contractor.

CHARLES A. LAMPING, P.E. 10-15-2025 CHARLES A. LAMPING, P.E. DATE

RELEASED FOR CONSTRUCTION
ALL RESPONSIBILITY FOR ADEQUACY OF DESIGN
REMAINS WITH THE DESIGN ENGINEER. THE CITY
OF ROCKWALL, IN REVIEWING AND RELEASING
PLANS FOR CONSTRUCTION, ASSUMES NO
RESPONSIBILITY FOR ADEQUACY OR ACCURACY OF
DESIGN.

CAUTION! EXISTING UTILITIES

NOTE: REFER TO MANHOLE STANDARD DRAWINGS FOR ADDITIONAL DETAIL OF M.H.

CONTRACTOR SHOULD CALL 1-800-DIG-TESS PRIOR TO BEGINNING ANY CONSTRUCTION ACTIVITIES FOR EXISTING UTILITY LOCATIONS. EXISTING UTILITIES AND UNDERGROUND FACILITIES INDICATED ON THESE PLANS HAVE BEEN LOCATED FROM REFERENCE INFORMATION. IT IS THE RESPONSIBILITY OF THE CONTRACTOR TO VERIFY BOTH HORIZONTALLY AND VERTICALLY THE LOCATION OF ALL EXISTING UTILITIES AND UNDERGROUND FACILITIES PRIOR TO CONSTRUCTION AND TO TAKE NECESSARY PRECAUTIONS IN ORDER TO PROTECT ALL FACILITIES ENCOUNTERED. THEIR CONTRACTOR SHALL PRESERVE AND PROTECT ALL EXISTING UTILITIES FROM DAMAGE DURING

CONSTRUCTION.

WASTEWATER MANHOLE

INVERT DETAIL

BENCHMARKS:

BOTTOM TO SLOPE AS SHOWN.

d = PIPE DIAMETER

CP 101 - Square cut on headwall west side of Rochelle road & 54' south of center of Polar Point Drive Elevation = 559.95
CP 103 - "X" in concrete east side of Rochelle Road, 1834' south of

502.1

AUG 23

center of Polar Point Dr. Elevation = 564.54'

CP 104 - Capped 5/8" Iron rod east side of Rochelle Road & 1250' south of the center of Polar Point Dr. Elevation = 572.70'

CP 105 - Capped 5/8" Iron rod east side of Rochelle Road & 826' south


of the center of Polar Point Dr. Elevation = 568.75'

PETITT - ECD

ENGINEERING SURVEYING
CONSTRUCTION ADMINISTRATION
TBPELS REGISTRATION
ENGINEERING FIRM #001145 - SURVEYING FIRM #10194792
1600 N. COLLINS BLVD
SUITE 3300
SUITE 100
RICHARDSON, TX 75080
972,941,8401
972,941,8400

REVISIONS:	
DRAWN: RH	DATE:
CHECKED: CAL	DATE: 8/08/2024
PROJECT NO.: 06537	
DWG FILE NAME: 06537-C-DETAILS-2.DV	WG

THIS DOCUMENT IS RELEASED FOR THE PURPOSE OF CONSTRUCTION. THE SEAL APPEARING ON THIS DOCUMENT WAS AUTHORIZED BY CHARLES A. LAMPING, P.E. 88554

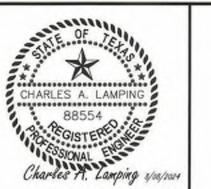


SANITARY DETAILS


TERRACINA ESTATES PHASE 2


CITY OF ROCKWALL, ROCKWALL COUNTY, TEXAS


39 OF


41

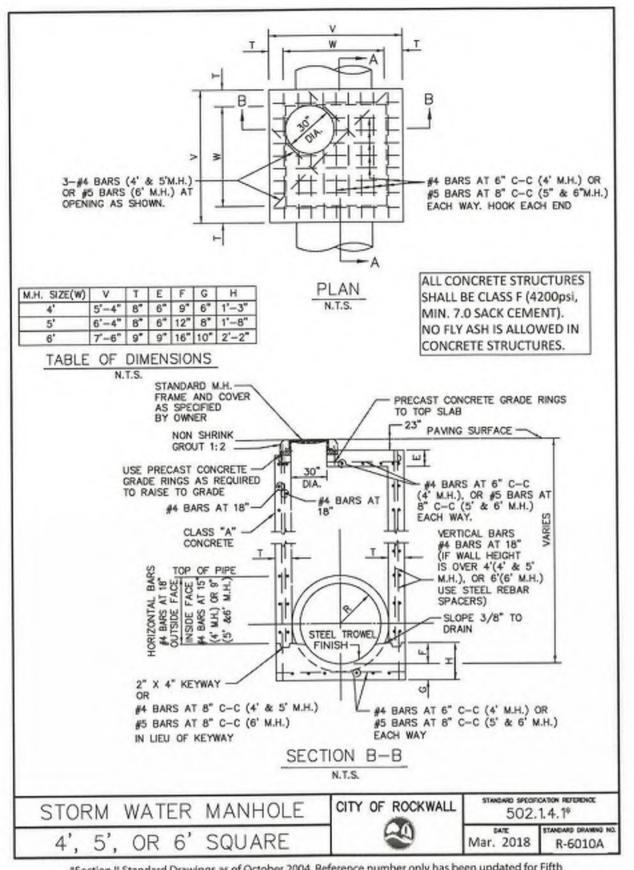


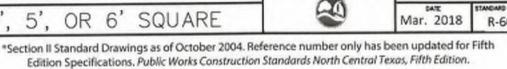


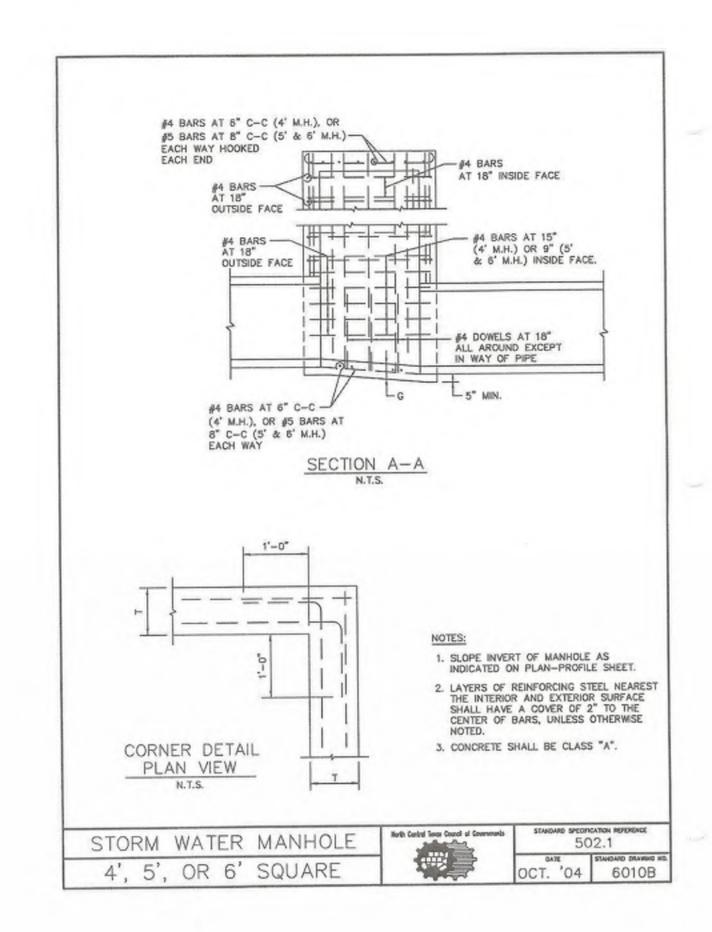


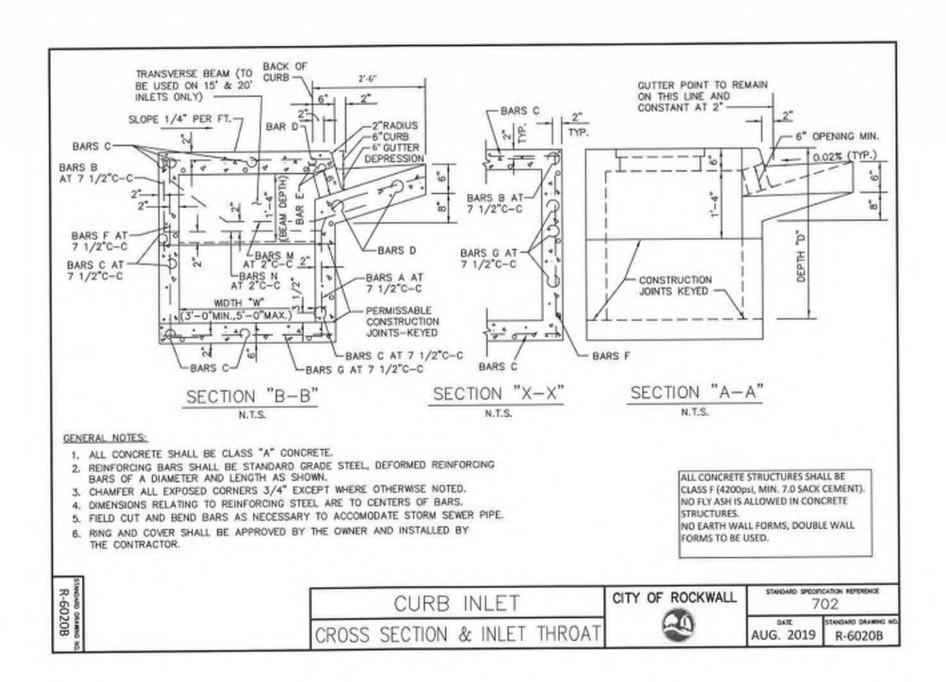

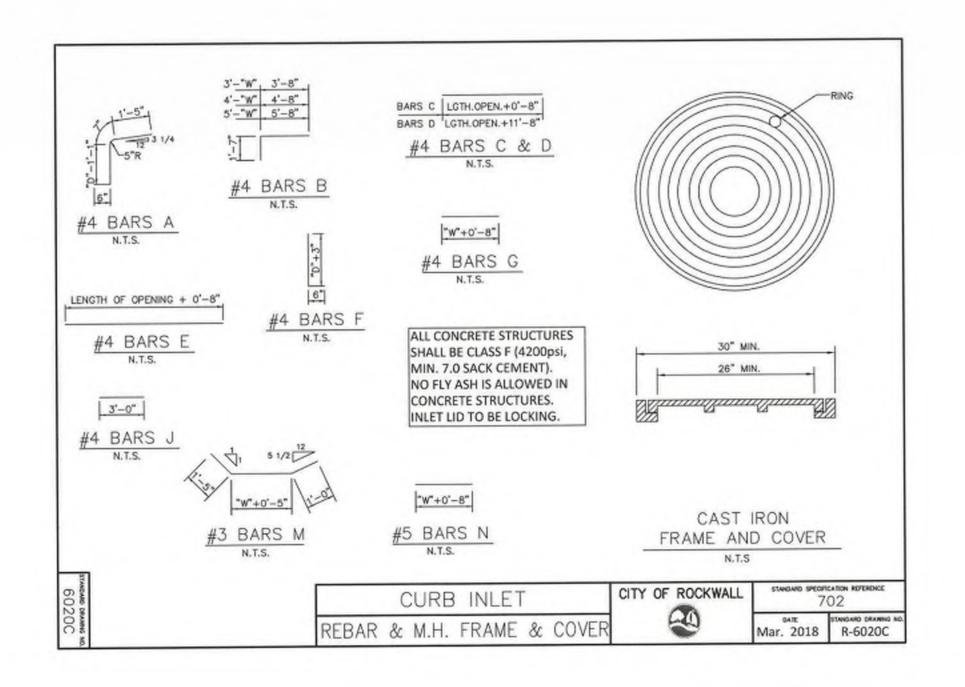

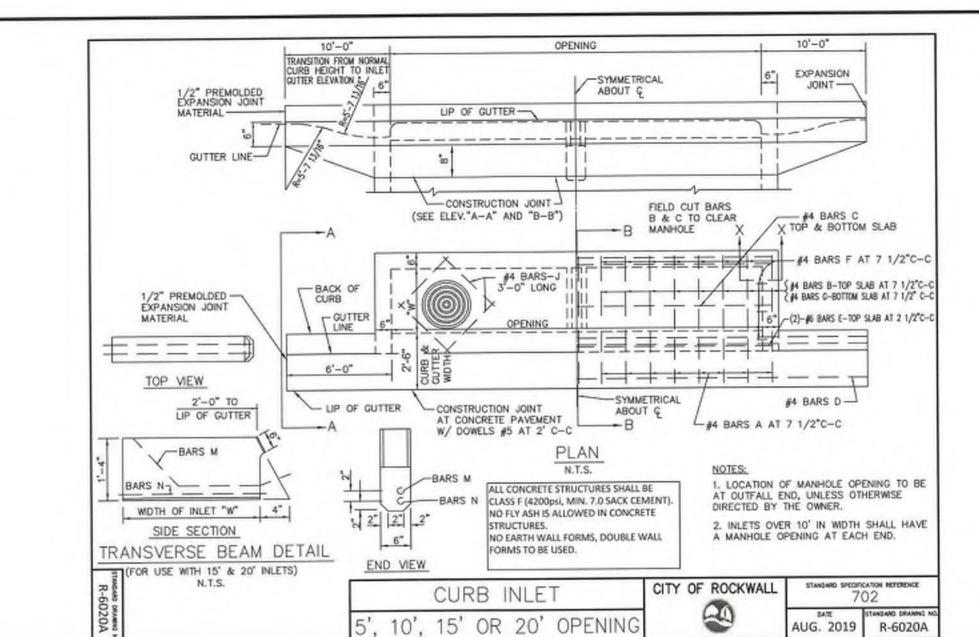

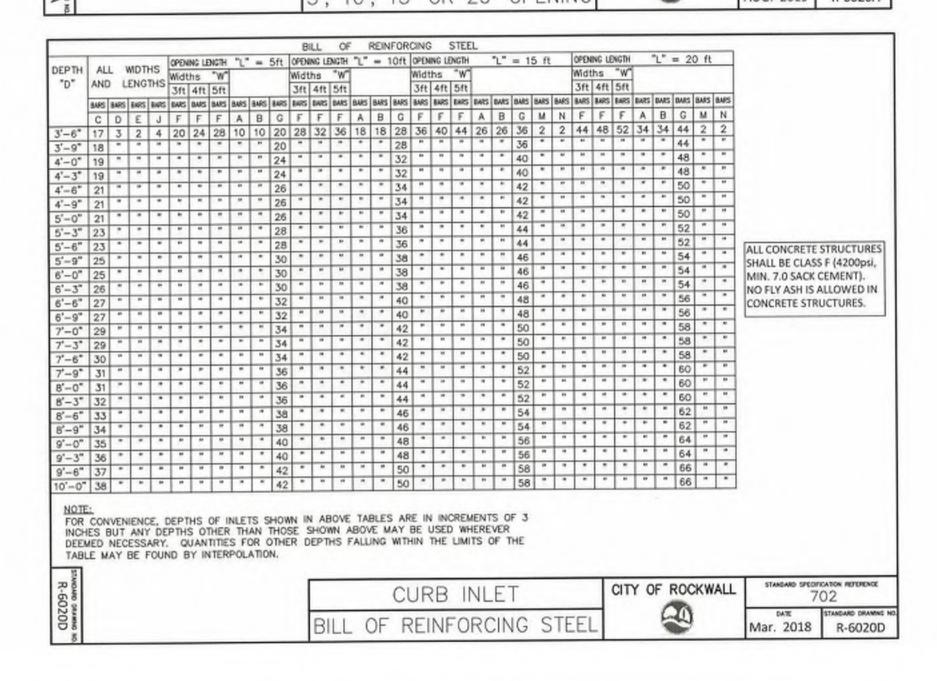

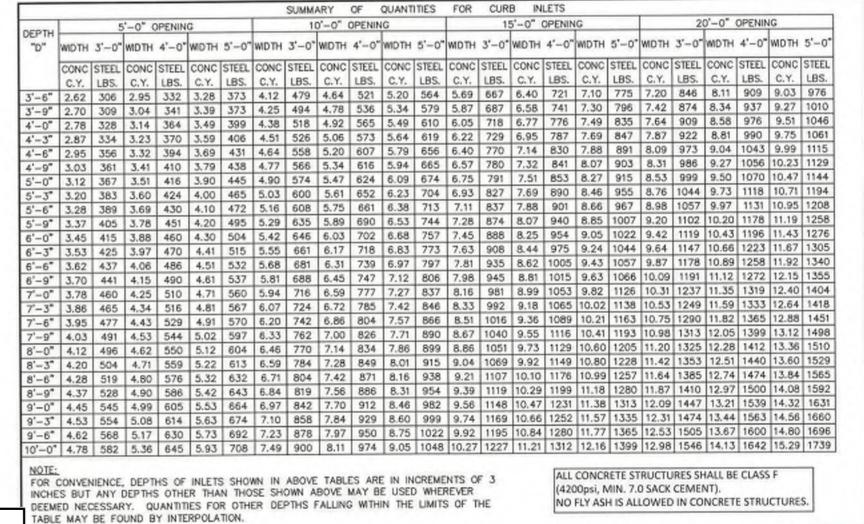

CURB INLET

RECORD DRAWINGS

To the best of our knowledge Petitt-ECD,

NOTES FOR ALL STORM DETAILS THIS

 ALL CONCRETE FOR STRUCTURES SHALL BE CLASS F (4200 PSI,

MINIMUM 7.0 SACK CEMENT). NO FLY ASH ALLOWED IN CONCRETE

FOR STRUCTURES.

SHEET:

L.P., hereby states that this plan is As-Built. This information provided is based on surveying at the site and information provided by the contractor.

CHARLES A. LAMPING, P.E. 10-15-2025 CHARLES A. LAMPING, P.E. DATE

CITY OF ROCKWALL SUMMARY OF QUANTIT

FOR CONSTRUCTION FOR ADEQUACY OF DESI DESIGN ENGINEER. THE CI

REVIEWING AND RELEASIN Mar. 2018ANSR-6020E CONSTRUCTION, ASSUMES 1 SIBILITY FOR ADEQUACY OR ACCURACY

CAUTION! EXISTING UTILITIES ONTRACTOR SHOULD CALL 1-800-DIG-TESS PRIOR TO BEGINNING ANY CONSTRUCTION CTIVITIES FOR EXISTING UTILITY LOCATIONS. EXISTING UTILITIES AND UNDERGROUND FACILITIES INDICATED ON THESE PLANS HAVE BILLIN LOCATED FROM REFERENCE INFORMATION. IT IS THE RESPONSIBILITY OF THE CONTRACTOR TO VERIFY BOTH HORIZONTALLY AND VERTICALLY THE LOCATION OF ALL EXISTING UTILITIES AND INDERGROUND FACILITIES PRIOR TO CONSTRUCTION AND TO TAKE NECESSARY CAUTIONS IN ORDER TO PROTECT ALL FACILITIES ENCOUNTERED. THE CONTRACTOR

SHALL PRESERVE AND PROTECT ALL EXISTING UTILITIES FROM DAMAGE DURING

CONSTRUCTION

BENCHMARKS: CP 101 - Square cut on headwall west side of Rochelle road & 54' south of center of Polar Point Drive Elevation = 559.95 CP 103 - "X" in concrete east side of Rochelle Road, 1834' south of center of Polar Point Dr. Elevation = 564.54'

CP 104 - Capped 5/8" Iron rod east side of Rochelle Road & 1250' south of the center of Polar Point Dr. Elevation = 572.70' CP 105 - Capped 5/8" Iron rod east side of Rochelle Road & 826' south

of the center of Polar Point Dr. Elevation = 568.75'

PETITT - ECD ENGINEERING SURVEYING

CONSTRUCTION ADMINISTRATION TBPELS REGISTRATION ENGINEERING FIRM #001145 - SURVEYING FIRM #10194792 201 WINDCO CIRCLE 1600 N. COLLINS BLVD SUITE 3300 SUITE 100
RICHARDSON, TX 75080 WYLIE, TX 75098 972,941,8400 972.941.8401

DRAWN: RH CHECKED: CAL DATE: 8/08/2024 PROJECT NO.: 06537 DWG FILE NAME: 06537-C-DETAILS-2.DWG

THIS DOCUMENT IS RELEASED FOR THE PURPOSE OF CONSTRUCTION. THE SEAL APPEARING ON THIS DOCUMENT WAS AUTHORIZED BY CHARLES A. LAMPING, P.E. 88554




STORM DETAILS 1


TERRACINA ESTATES PHASE 2


CITY OF ROCKWALL, ROCKWALL COUNTY, TEXAS


OF


SHEET

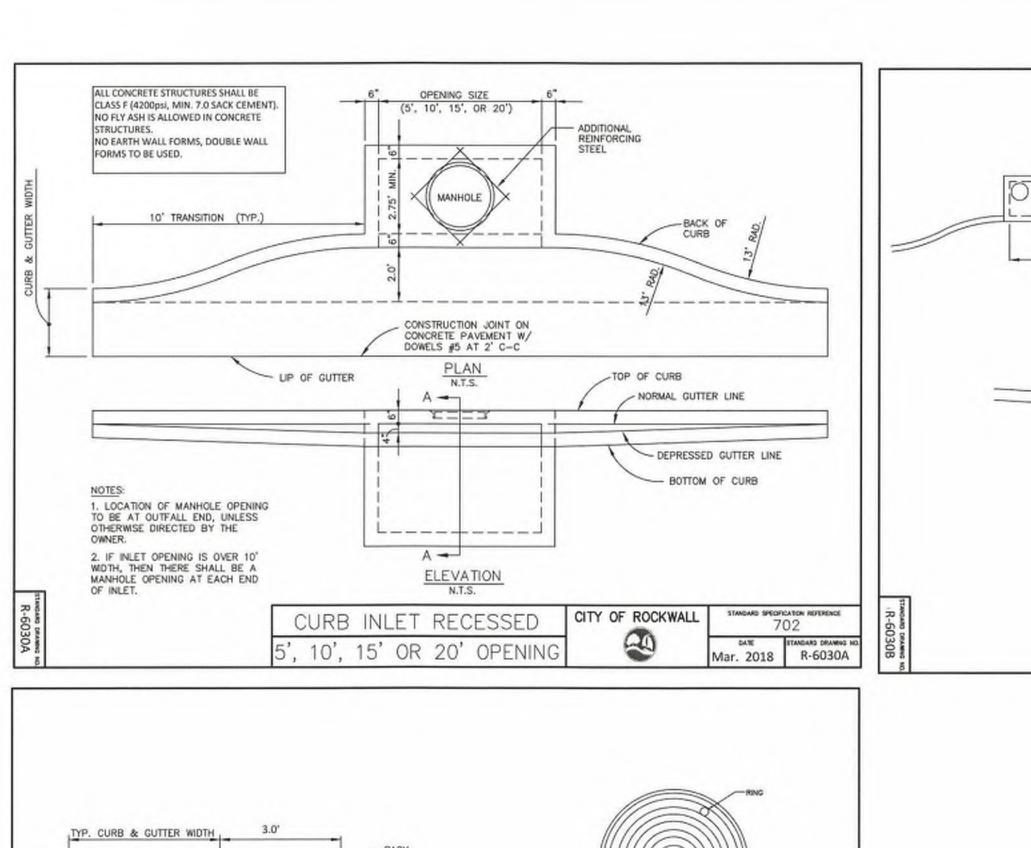


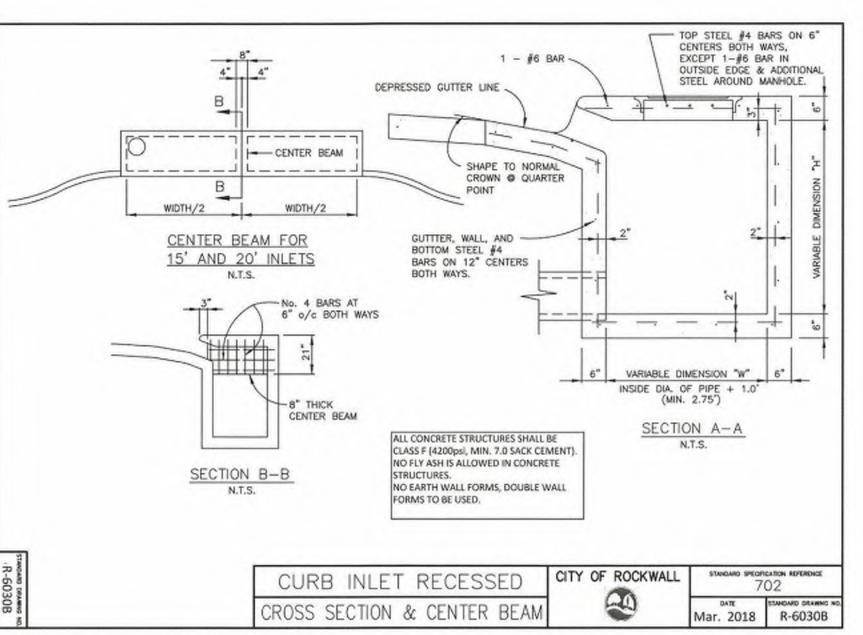


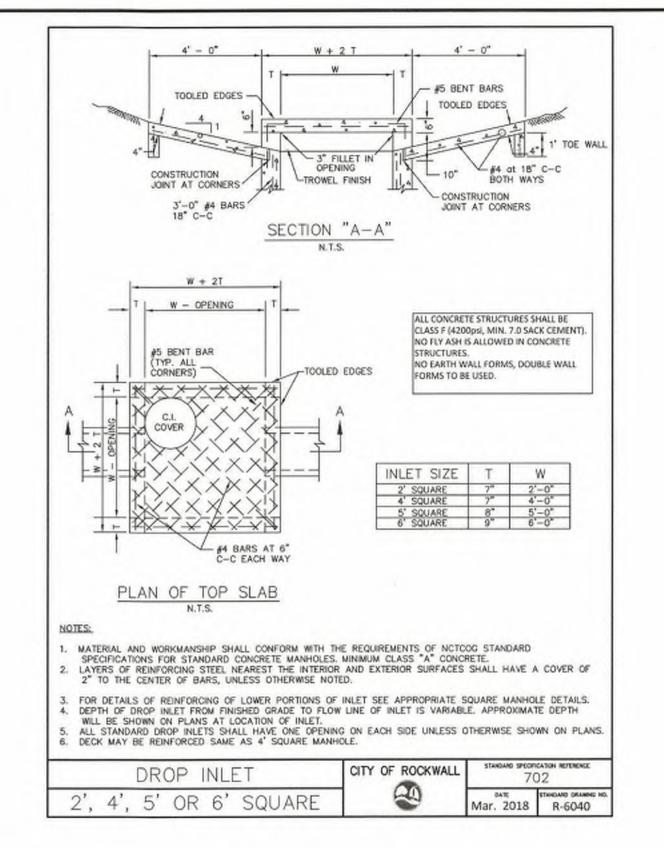

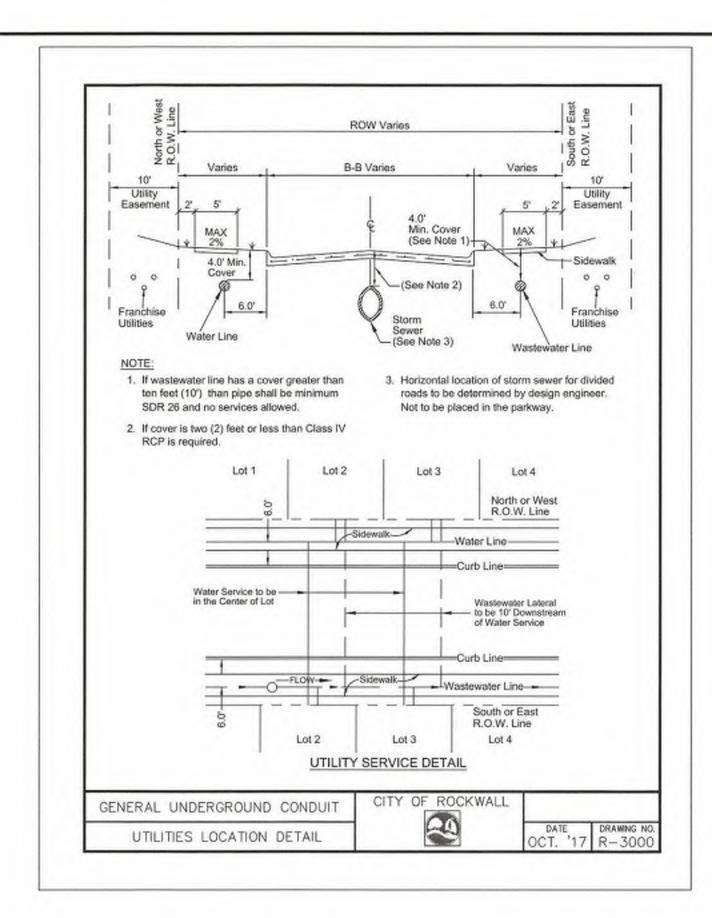

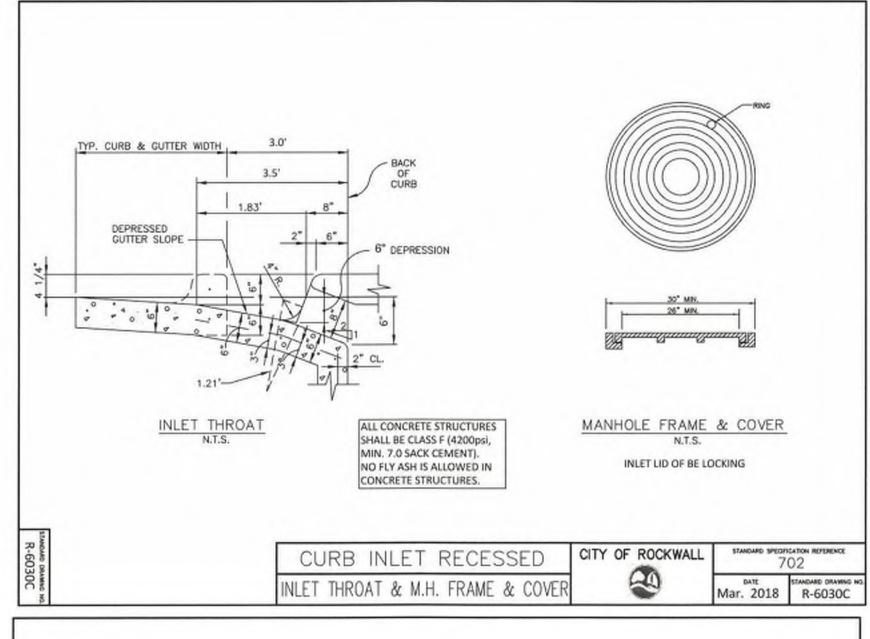

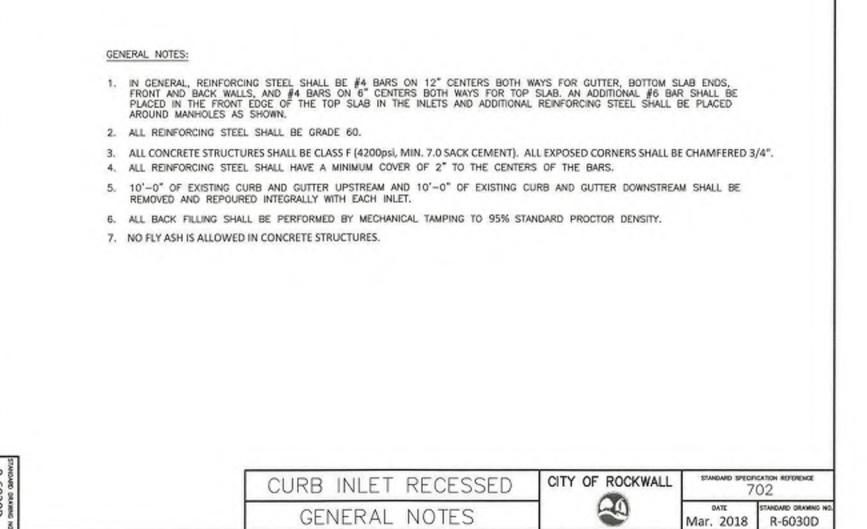

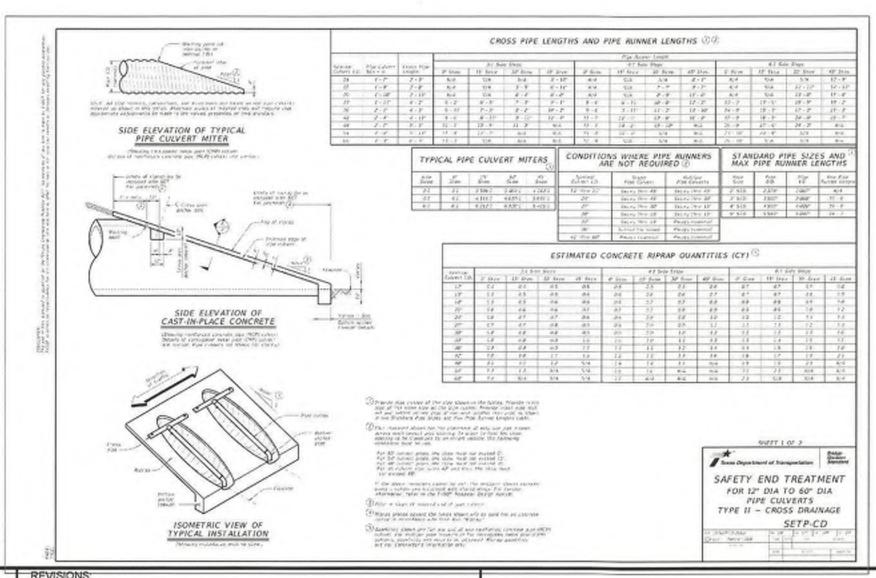

RECORD DRAWINGS To the best of our knowledge Petitt-ECD,

L.P., hereby states that this plan is As-Built. This information provided is based on surveying at the site and information provided by the contractor.

CHARLES A. LAMPING, P.E. 10-15-2025 CHARLES A. LAMPING, P.E. DATE

RELEASED FOR CONSTRUCTION ALL RESPONSIBILITY FOR ADEQUACY OF DESIGN REMAINS WITH THE DESIGN ENGINEER. THE CITY OF ROCKWALL, IN REVIEWING AND RELEASING PLANS FOR CONSTRUCTION, ASSUMES NO RESPONSIBILITY FOR ADEQUACY OR ACCURACY OF DESIGN.

CAUTION! EXISTING UTILITIES

CONTRACTOR SHOULD CALL 1-800-DIG-TESS PRIOR TO BEGINNING ANY CONSTRUCTION ACTIVITIES FOR EXISTING UTILITY LOCATIONS. EXISTING UTILITIES AND UNDERGROUND FACILITIES INDICATED ON THESE PLANS HAVE BEEN LOCATED FROM REFERENCE. INFORMATION. IT IS THE RESPONSIBILITY OF THE CONTRACTOR TO VERIFY BOTH HORIZONTALLY AND VERTICALLY THE LOCATION OF ALL EXISTING UTILITIES AND UNDERGROUND FACILITIES PRIOR TO CONSTRUCTION AND TO TAKE NECESSARY ECAUTIONS IN ORDER TO PROTECT ALL FACILITIES ENCOUNTERED. THE CONTRACTOR SHALL PRESERVE AND PROTECT ALL EXISTING UTILITIES FROM DAMAGE DURING CONSTRUCTION.

BENCHMARKS:

GENERAL NOTES

CP 101 - Square cut on headwall west side of Rochelle road & 54' south of center of Polar Point Drive Elevation = 559.95 CP 103 - "X" in concrete east side of Rochelle Road, 1834' south of center of Polar Point Dr. Elevation = 564.54' CP 104 - Capped 5/8" Iron rod east side of Rochelle Road & 1250' south of the center of Polar Point Dr. Elevation = 572.70'

CP 105 - Capped 5/8" Iron rod east side of Rochelle Road & 826' south

of the center of Polar Point Dr. Elevation = 568.75'

PETITT - ECD

ENGINEERING SURVEYING CONSTRUCTION ADMINISTRATION TBPELS REGISTRATION ENGINEERING FIRM #001145 - SURVEYING FIRM #10194792 1600 N. COLLINS BLVD 201 WINDCO CIRCLE **SUITE 3300** RICHARDSON, TX 75080 WYLIE, TX 75098 972.941.8401 972.941.8400

DRAWN: RH CHECKED: CAL 8/08/2024 PROJECT NO.: 06537 DWG FILE NAME: 06537-C-DETAILS-2.DWG

THIS DOCUMENT IS RELEASED FOR THE PURPOSE OF CONSTRUCTION. THE SEAL APPEARING ON THIS DOCUMENT WAS AUTHORIZED BY CHARLES A. LAMPING, P.E. 88554



STORM DETAILS 2

CITY OF ROCKWALL, ROCKWALL COUNTY, TEXAS

TERRACINA ESTATES PHASE 2

OF

SHEET

41



JOHNSON VOLK
CONSULTING
TBPELS: Engineering Firm No. 11962 / Land Surveying Firm No. 16
704 Central Parkway East | Suite 1200 | Plano, TX 75074 | 972.201.3100

TERRACINA ESTATES
PHASE TWO
CITY OF ROCKWALL
ROCKWALL COUNTY, TEXAS

LANDSCAPE PLAN



July 3, 2024


SCALE:

1" = 80'

One Inch

JVC No DPI006A

OVERALL

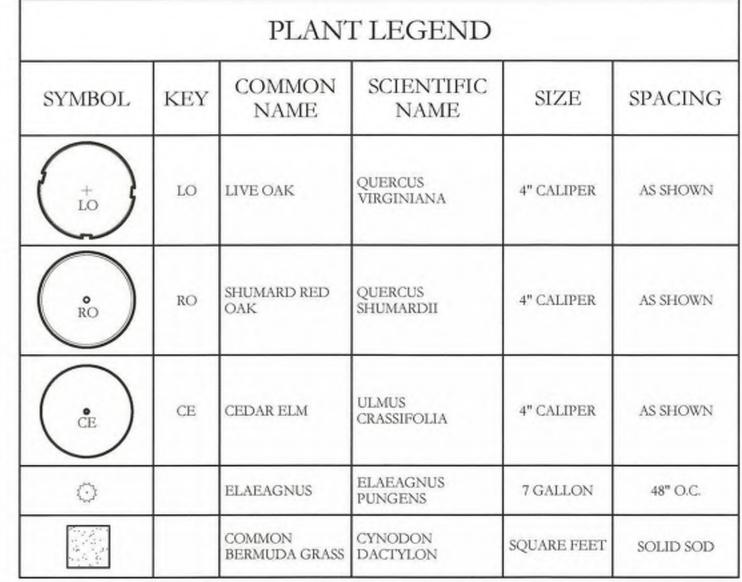

HARDSCAPE LEGEND

6'-0". HT. ORNAMENTAL METAL FENCE. REFER TO DETAIL 1/L5.

NOTE: REFER TO CIVIL PLANS FOR SIDEWALK ALIGNMENT, LOCATIONS, BARRIER FREE RAMP LOCATIONS AND ALL COINCIDING CONSTRUCTION DETAILS.

APPROVED:

I hereby certify that the above and foregoing site plan for a development in the City of Rockwall, Texas, was approved by the Planning & Zoning Commission of the City of Rockwall on the day of , .

WITNESS OUR HANDS, this

Planning & Zoning Commission, Chairman

Director of Planning and Zoning

SCALE 1" = 20"



SCALE:

1" = 80'

One Inch

L1 of 5


JVC No DPI006A


N

ALL
TEXAS
TEXAS

FFERING

SCREENING AND OVERALL LAY

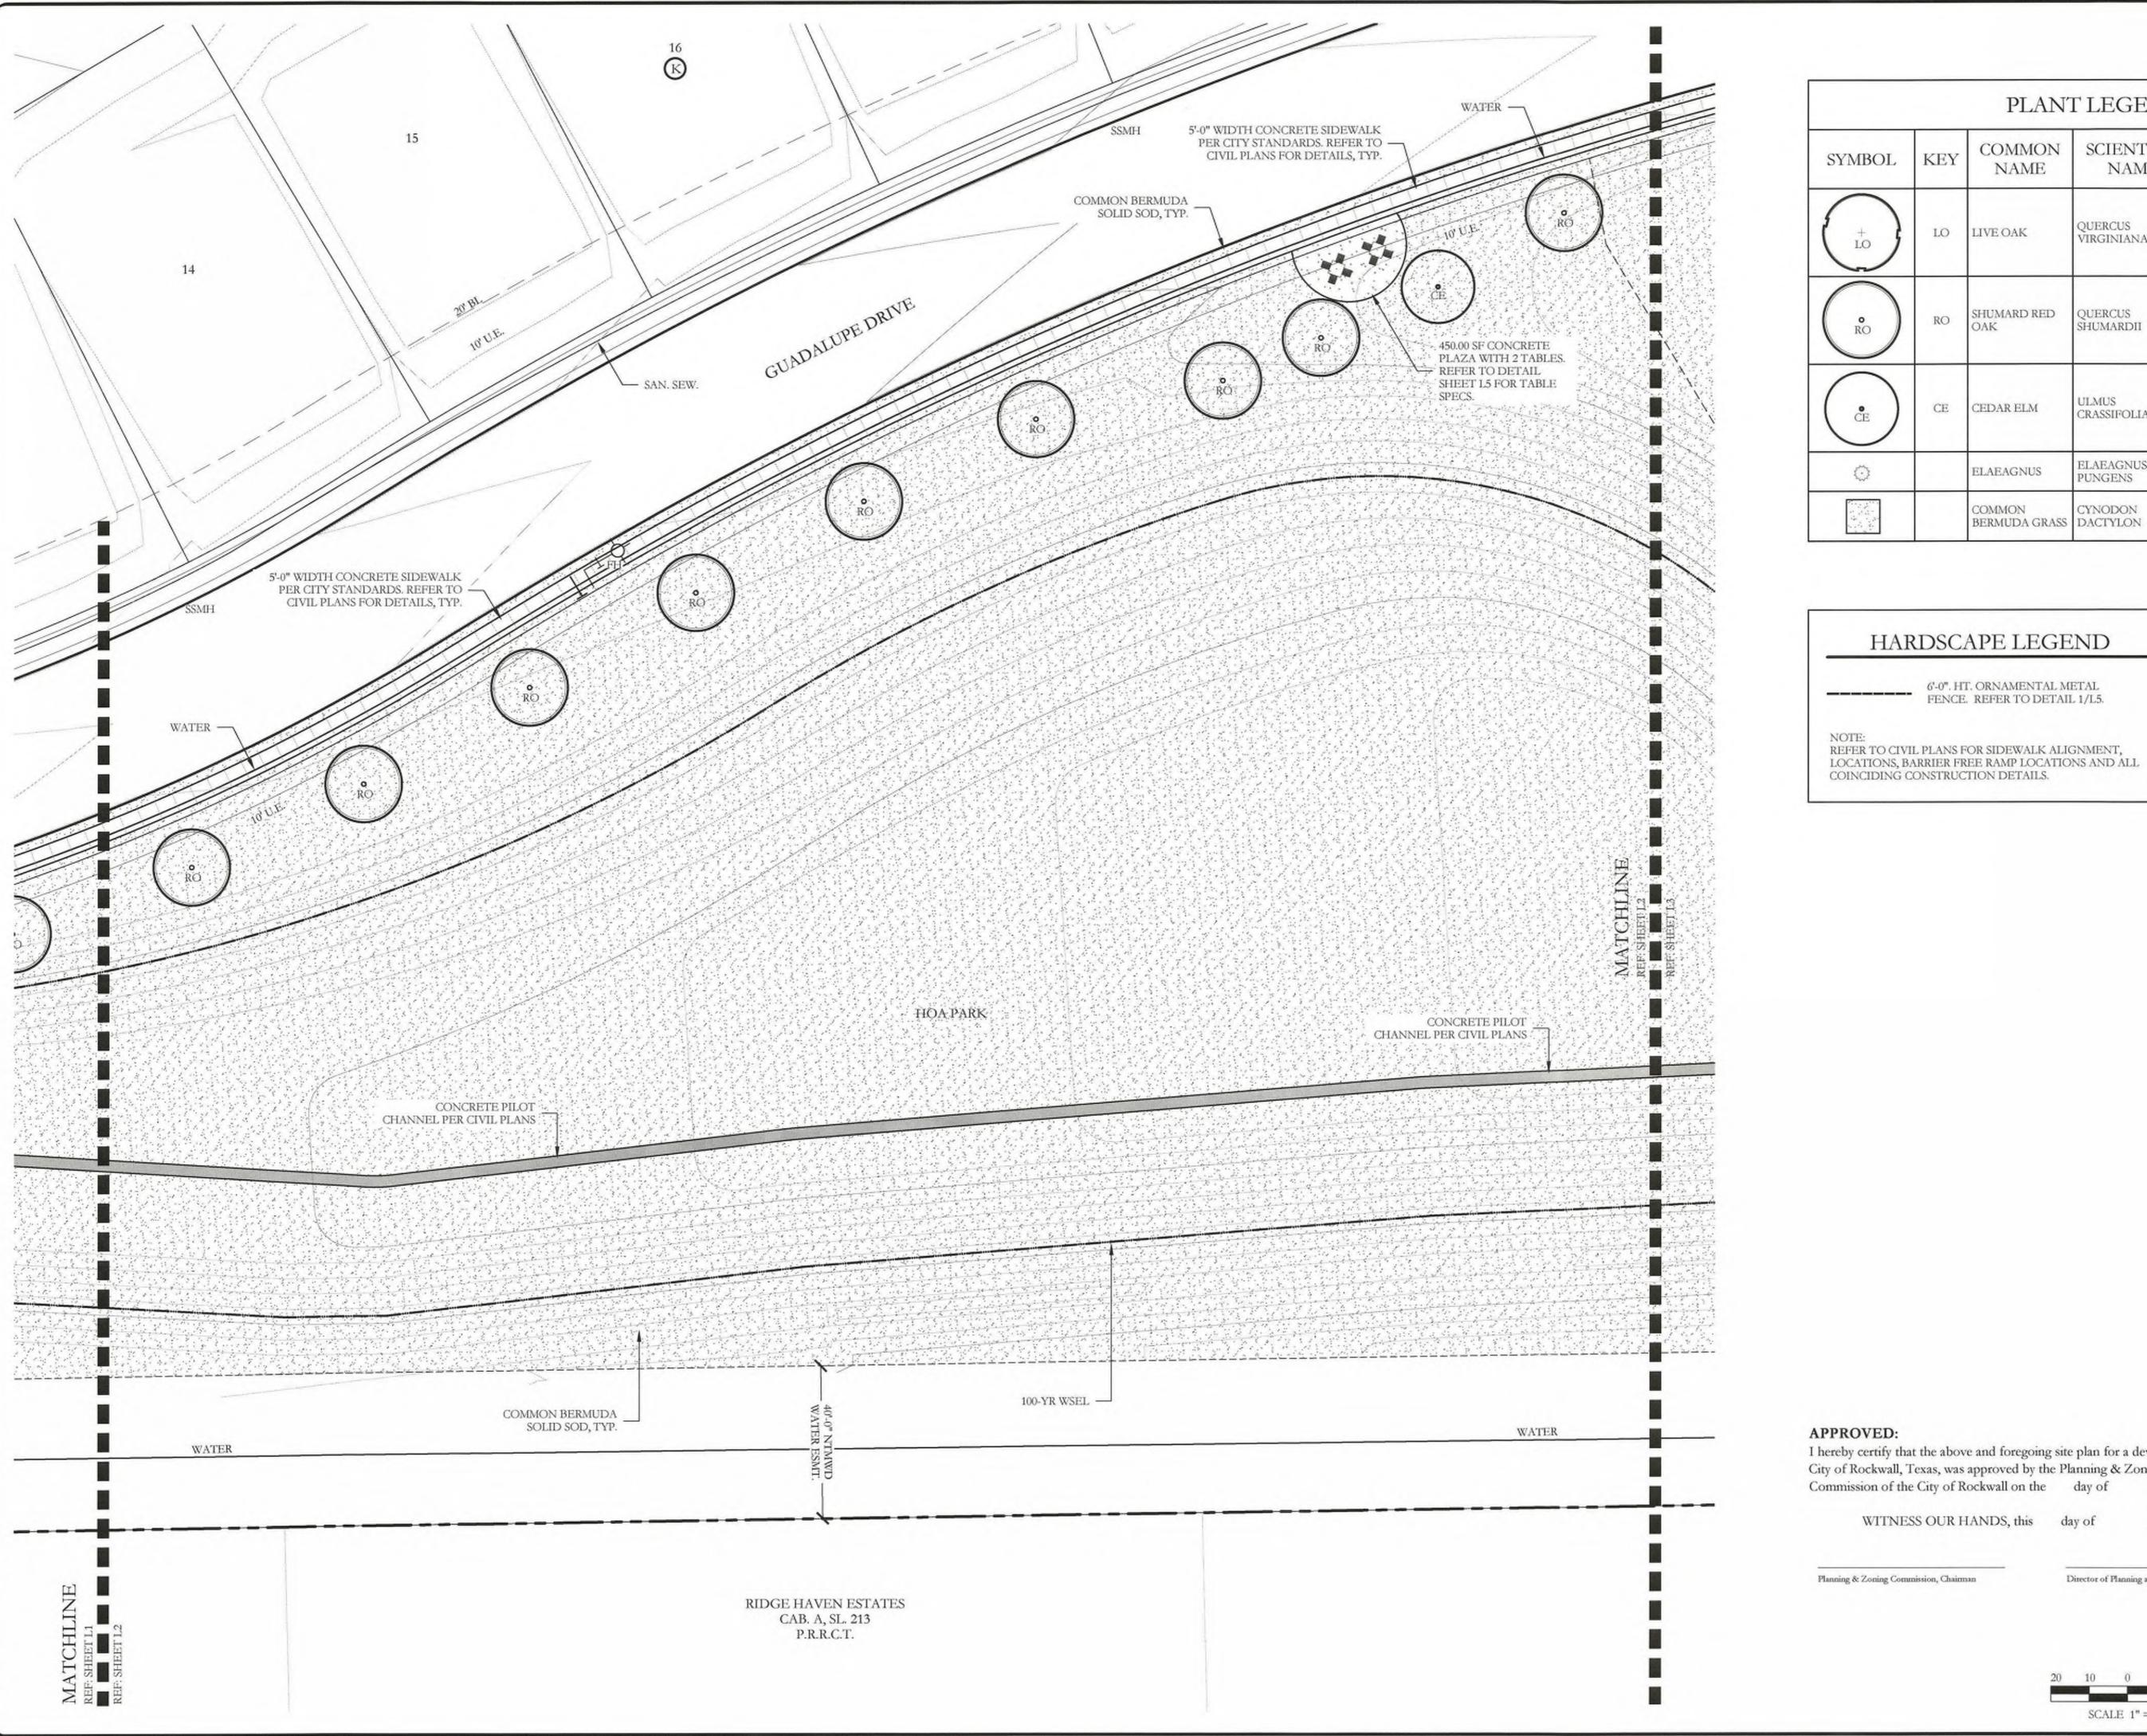

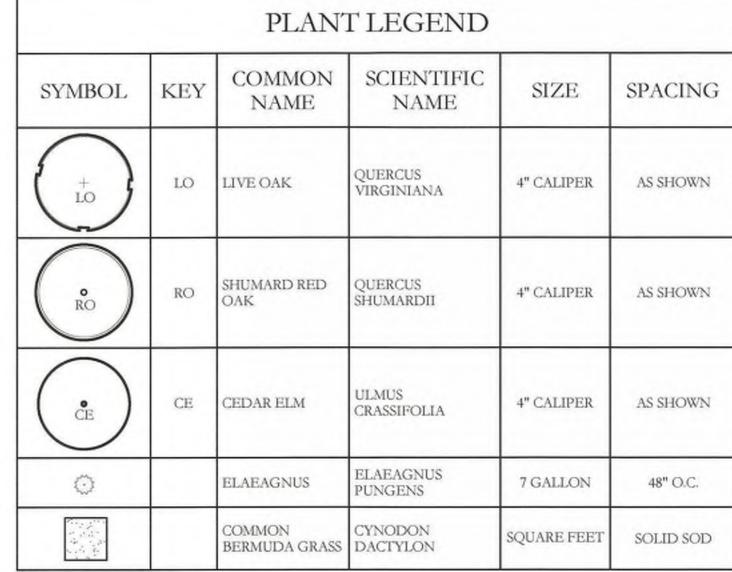

HARDSCAPE LEGEND

6'-0". HT. ORNAMENTAL METAL FENCE. REFER TO DETAIL 1/L5.

APPROVED:

I hereby certify that the above and foregoing site plan for a development in the City of Rockwall, Texas, was approved by the Planning & Zoning Commission of the City of Rockwall on the day of

WITNESS OUR HANDS, this

Planning & Zoning Commission, Chairman


Director of Planning and Zoning



SCALE 1" = 20'

L2 of $\underline{5}$

JVC No DPI006A

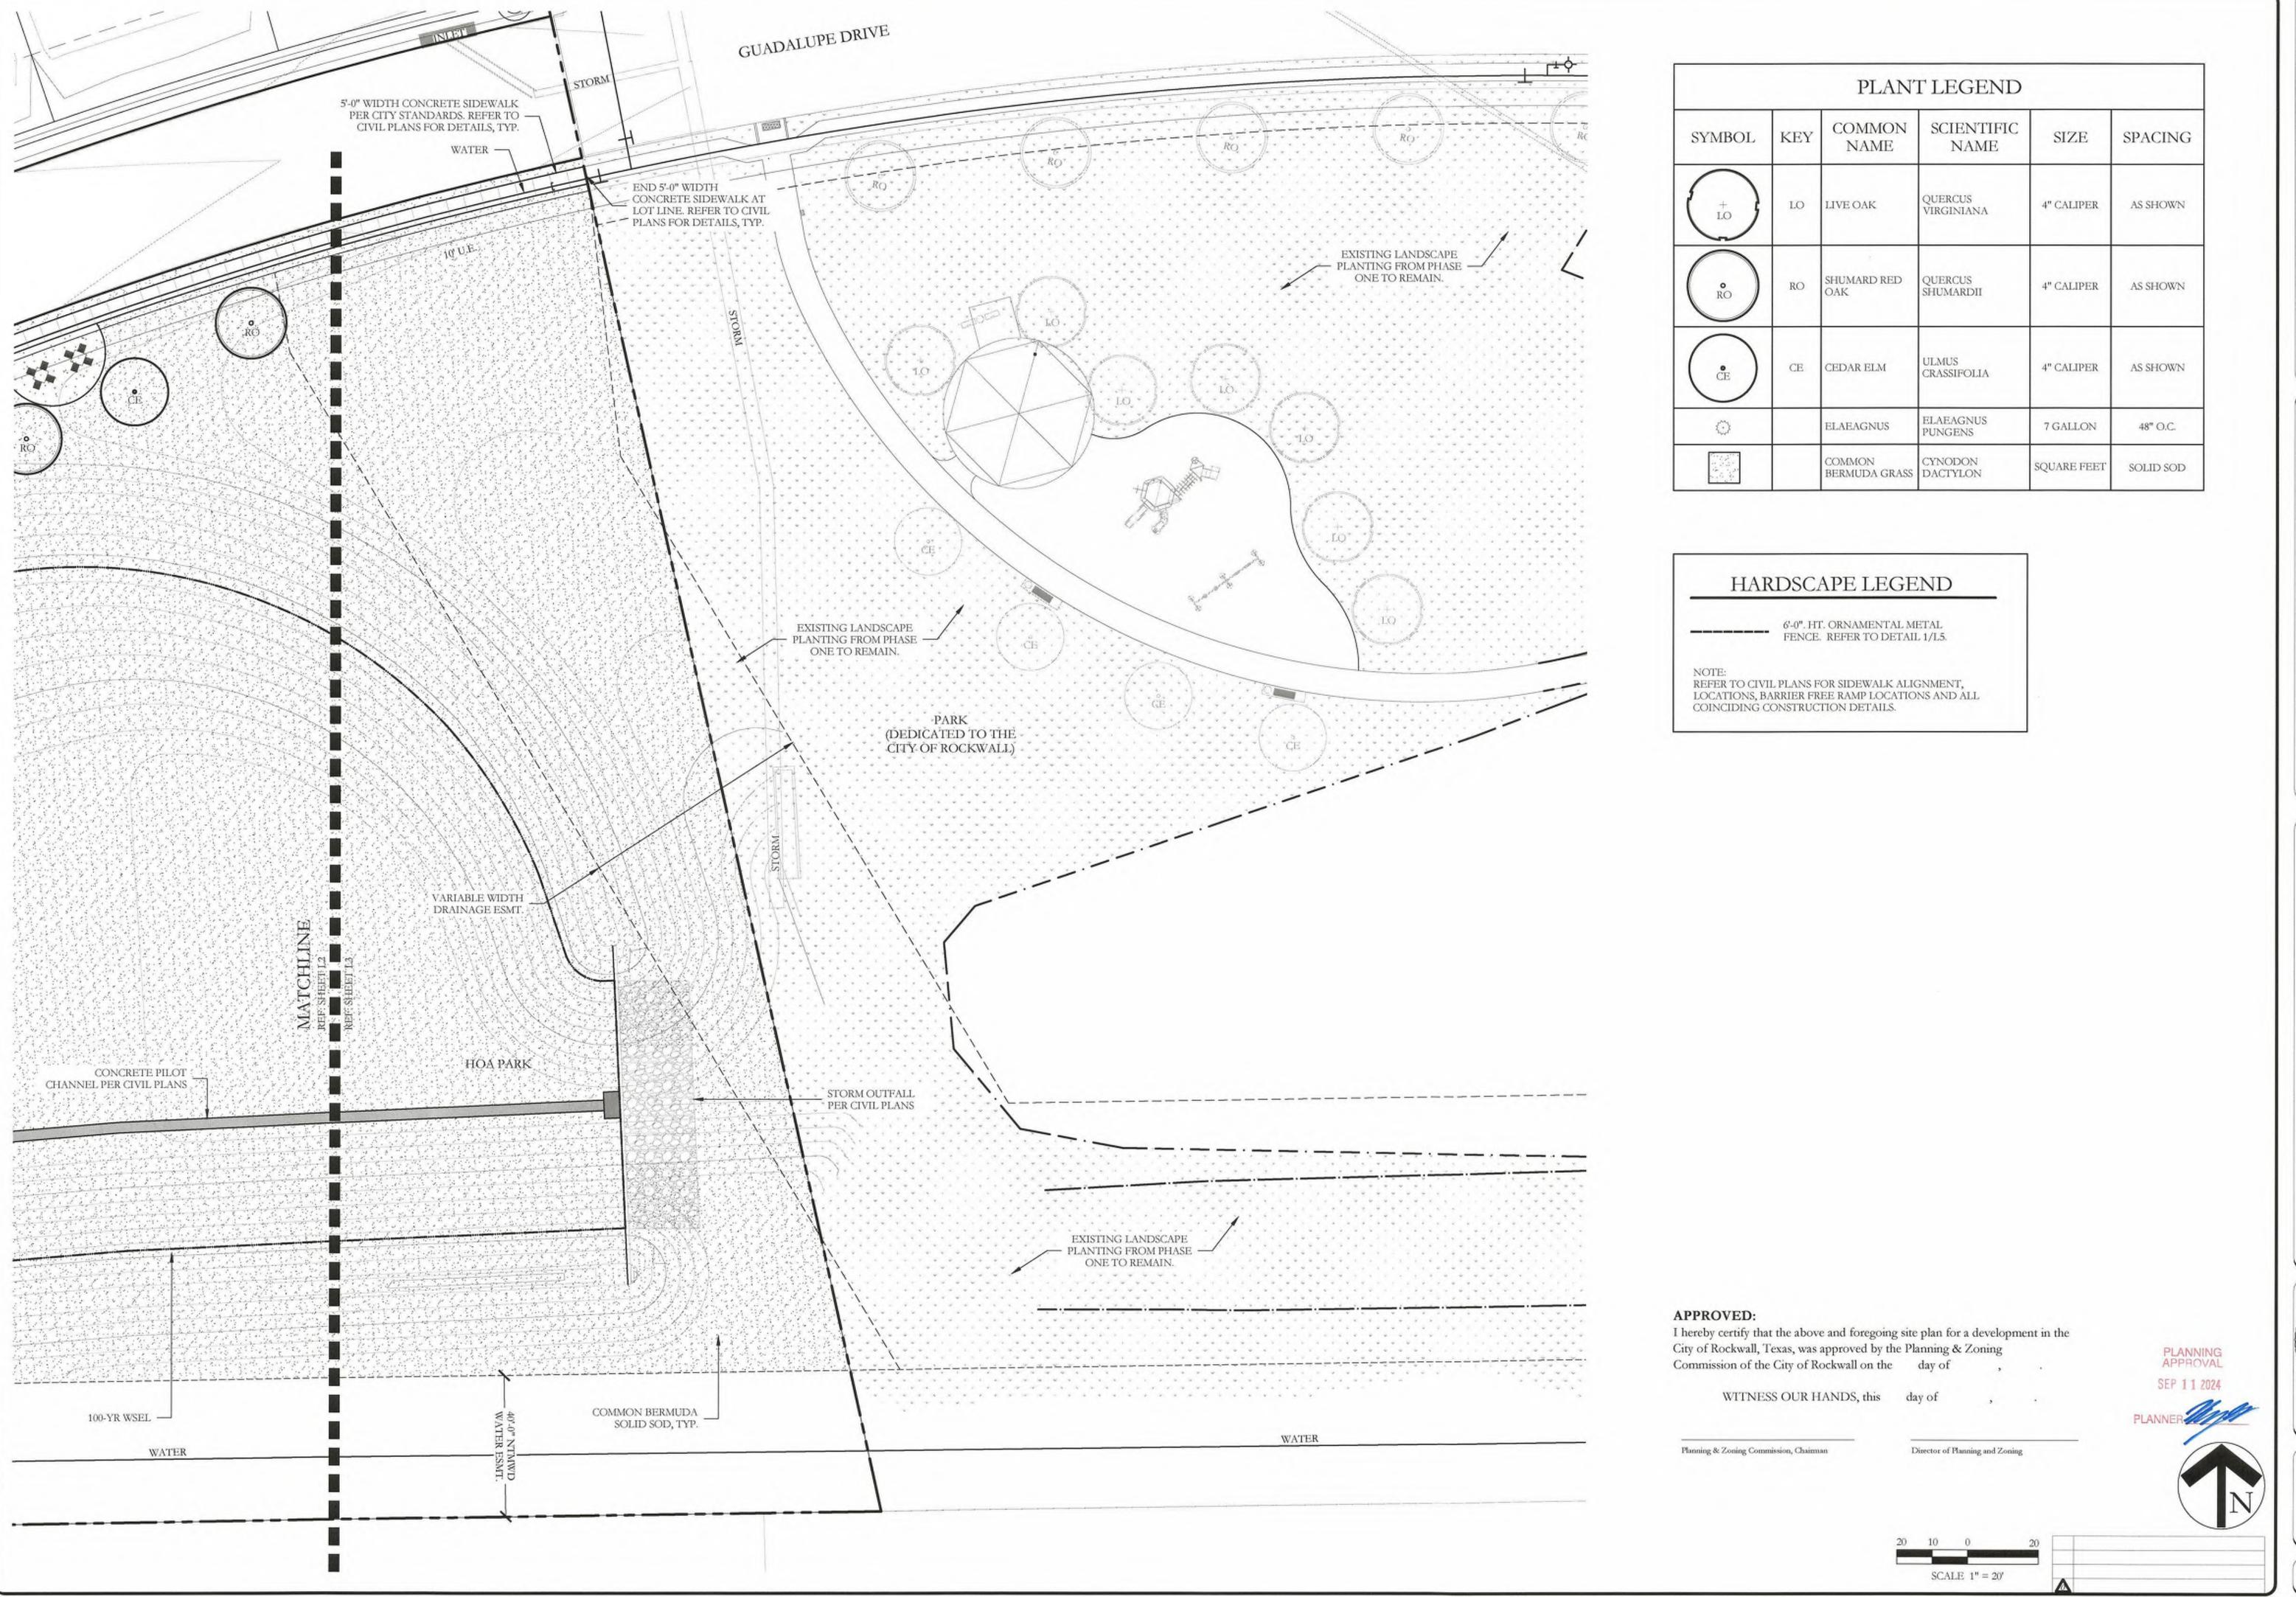

REENING AND B

July 3, 2024

SCALE:

1" = 80'

One Inch

JVC No DPI006A

L3 of 5

J

STATE OF THE PARTY.

SCALE: REFER TO DETAILS One Inch

JVC No DPI006A L4 of 5

GENERAL LANDSCAPE NOTES INSPECTIONS: 1. NO EXCAVATION SHALL OCCUR IN CITY R.O.W. WITHOUT A R.O.W. PERMIT-CONTACT THE PUBLIC

WORKS DEPARTMENT. 2. THE CONTRACTOR SHALL MARK ALL WATER LINES, SEWER LINES, AND TREE LOCATIONS PRIOR TO CALLING FOR ROW INSPECTION AND PERMIT.

3. THE LANDSCAPE INSTALLATION SHALL COMPLY WITH APPROVED LANDSCAPE DRAWINGS PRIOR TO FINAL ACCEPTANCE BY THE CITY AND ISSUANCE OF A CERTIFICATE OF OCCUPANCY.

4. WATER METERS, CLEANOUTS AND OTHER APPURTENANCES, SHALL BE ACCESSIBLE, ADJUSTED TO GRADE, CLEARLY MARKED WITH FLAGGING AND COMPLIANT WITH PUBLIC WORKS DEPARTMENT STANDARDS PRIOR TO CALLING FOR FINAL LANDSCAPE AND ROW INSPECTIONS.

LANDSCAPE STANDARDS:

REMARKS

NURSERY GROWN; FULL HEAD; MINIMUM BRANCHING

NURSERY GROWN; FULL HEAD; MINIMUM BRANCHING

NURSERY GROWN; FULL HEAD; MINIMUM BRANCHING

HEIGHT AT 6'-0"; MINIMUM 10'-0" OVERALL HEIGHT.

HEIGHT AT 6'-0"; MINIMUM 10'-0" OVERALL HEIGHT.

HEIGHT AT 6'-0"; MINIMUM 10'-0" OVERALL HEIGHT.

MINIMUM 100% COVERAGE ALL AREAS SHOWN

CONTAINER GROWN; FULL PLANT.

1. PLANTINGS AND LANDSCAPE ELEMENTS SHALL COMPLY WITH THE CITY'S ENGINEERING DESIGN STANDARDS, PUBLIC R.O.W. VISIBILITY REQUIREMENTS.

 UNLESS OTHERWISE SPECIFIED, TREES SHALL BE PLANTED NO LESS THAN 4' FROM CURBS, SIDEWALKS, UTILITY LINES, SCREENING WALLS AND OTHER STRUCTURES. THE CITY HAS FINAL APPROVAL FOR ALL

3. A MINIMUM THREE FEET (3') RADIUS AROUND A FIRE HYDRANT MUST REMAIN CLEAR OF LANDSCAPE PURSUANT TO THE FIRE CODE

4. STREET TREES, WHERE REQUIRED, SHALL BE (10) MINIMUM FROM THE EDGE OF A STORM SEWER CURB INLET BOX AND THE EDGE OF THE ROOT BALL SHALL BE (4') MINIMUM FROM THE WATER METER. 5. THE AMERICAN STANDARD FOR NURSERY STOCK (ANSI Z60.1-2004) SPECIFICATIONS SHALL GOVERN

PLANT QUALIFICATIONS, GRADES, AND STANDARDS. 6. TREE PLANTING SHALL COMPLY WITH DETAILS HEREIN AND THE INTERNATIONAL SOCIETY OF ARBORICULTURE (ISA) STANDARDS.

7. A 2-3" LAYER OF MULCH SHALL BE PROVIDED AROUND THE BASE OF THE PLANTED TREE. THE MULCH SHALL BE PULLED BACK 4" FROM THE TRUNK OF THE TREE.

8. TREE PITS SHALL BE TESTED FOR WATER PERCOLATION. IF WATER DOES NOT DRAIN OUT OF TREE PIT WITHIN 24-HOURS, THE TREE SHALL BE MOVED OR DRAINAGE SHALL BE PROVIDED. 9. ALL BEDS TO HAVE 3" OF COMPOSTED SOIL, LIVING EARTH TECHNOLOGY, OR APPROVED EQUAL

TILLED AND TURNED TO A DEPTH OF 8" MINIMUM. ALL PLANT BEDS SHALL BE TOP-DRESSED WITH A MINIMUM OF 3 INCHES OF HARDWOOD MULCH. 11. NATIVE SITE TOPSOIL IS TO BE PROTECTED FROM EROSION OR STOCKPILED. NATIVE SITE TOPSOIL SHALL BE LABORATORY TESTED BY AND ACCREDITED LABORATORY AND AMENDED PER SAID

IRRIGATION STANDARDS:

LABORATORY'S RECOMMENDATIONS.

. ANY CHANGES TO THESE APPROVED IRRIGATION DRAWINGS SHALL BE AUTHORIZED BY THE CITY. 2. CONTACT DEVELOPMENT SERVICES FOR AN IRRIGATION PERMIT PRIOR TO INSTALLING THE IRRIGATION SYSTEM.

IRRIGATION OVER-SPRAY ON STREETS AND WALKS IS PROHIBITED.

4. MAINLINES, VALVES, OR CONTROL WIRES SHALL NOT BE LOCATED IN THE CITY'S ROW. 5. ET IRRIGATION CONTROLLERS SHALL BE PROGRAMMED AND ADJUSTED TO NOT EXCEED THE

LANDSCAPE WATER ALLOWANCE (LWA) PRIOR TO APPROVAL OF LANDSCAPE INSTALLATION. VALVES SHALL BE LOCATED A MINIMUM OF (3) AWAY FROM STORM SEWERS, AND SANITARY SEWER LINES AND 5 FEET FROM CITY FIRE HYDRANTS AND WATER VALVES. 7. THE BORE DEPTH UNDER STREETS, DRIVE AISLES, AND FIRE LANES SHALL PROVIDE (2') OF CLEARANCE

8. IRRIGATION HEADS THAT RUN PARALLEL AND NEAR PUBLIC WATER AND SANITARY SEWER LINES;

SHALL BE FED FROM STUBBED LATERALS OR BULL-BEADS. A MINIMUM FIVE FOOT (5') SEPARATION IS REQUIRED BETWEEN IRRIGATION MAIN LINES AND LATERALS THAT RUN PARALLEL TO PUBLIC WATER AND SANITARY SEWER LINES.

9. NO VALVES, BACKFLOW PREVENTION ASSEMBLIES, QUICK COUPLERS ETC. SHALL BE LOCATED CLOSER THAN 10' FROM THE CURB AT STREET OR DRIVE INTERSECTION.

MAINTENANCE STANDARDS:

THE OWNER SHALL BE RESPONSIBLE FOR THE ESTABLISHMENT, MAINTENANCE, AND VIGOR OF PLANT MATERIAL IN ACCORDANCE WITH THE DESIGN INTENT AND AS APPROPRIATE FOR THE SEASON OF

LANDSCAPE AND OPEN AREAS SHALL BE FREE OF TRASH, LITTER AND WEEDS.

3. NO PLANT MATERIAL SHALL BE ALLOWED TO ENCROACH ON R.O.W., SIDEWALKS OR EASEMENTS TO THE EXTENT THAT VISION OR ROUTE OF TRAVEL FOR VEHICULAR, PEDESTRIAN, OR BICYCLE TRAFFIC IS IMPEDED.

4. TREE MAINTENANCE SHALL BE IN ACCORDANCE WITH THE STANDARDS OF THE INTERNATIONAL

SOCIETY OF ARBORICULTURE. 5. TREE STAKING MATERIALS, IF USED, SHALL BE REMOVED AFTER (1) GROWING SEASON, NO MORE THAN (1) YEAR AFTER INSTALLATION (STEEL TREE STAKES, WIRES, AND HOSES ARE PROHIBITED).

TREE PROTECTION NOTES:

 CONTACT DEVELOPMENT SERVICES FOR A TREE REMOVAL PERMIT PRIOR TO REMOVAL OR TRANSPLANTING OF ANY TREES.

2. ALL TREES WHICH ARE TO REMAIN ON SITE SHALL BE PROTECTED WITH A (4') TALL BRIGHTLY

COLORED PLASTIC FENCE, OR SILT FENCE, PLACED AT THE DRIP LINE OF THE TREES. 3. PRIOR TO THE PRE-CONSTRUCTION MEETING OR OBTAINING A GRADING PERMIT, ALL TREE

MARKINGS AND PROTECTIVE FENCING SHALL BE INSTALLED BY THE OWNER AND BE INSPECTED BY DEVELOPMENT SERVICES. 4. NO EQUIPMENT SHALL BE CLEANED, OR HARMFUL LIQUIDS DEPOSITED WITHIN THE LIMITS OF THE

ROOT ZONE OF TREES WHICH REMAIN ON SITE. 5. NO SIGNS, WIRES, OR OTHER ATTACHMENTS SHALL BE ATTACHED TO ANY TREE TO REMAIN ON SITE

6. VEHICULAR AND CONSTRUCTION EQUIPMENT SHALL NOT PARK OR DRIVE WITHIN THE LIMITS OF THE 7. GRADE CHANGES IN EXCESS OF 3 INCHES (CUT OR FILL) SHALL NOT BE ALLOWED WITHIN A ROOT ZONE, UNLESS ADEQUATE TREE PRESERVATION METHODS ARE APPROVED BY THE CITY.

8. NO TRENCHING SHALL BE ALLOWED WITHIN THE DRIP-LINE OF A TREE, UNLESS APPROVED BY THE

9. ALL REMOVED TREES SHALL BE CHIPPED AND USED FOR MULCH ON SITE OR HAULED OFF-SITE. 10. ALL TREE MAINTENANCE TECHNIQUES SHALL BE IN CONFORMANCE WITH INDUSTRY IDENTIFIED STANDARDS. IMPROPER OR MALICIOUS PRUNING TECHNIQUES ARE STRICTLY PROHIBITED.

SPACING AS SHOWN ON PLANT LIST REMOVE ALL LABELS AND TAGS -TOP OF ROOTBALL SHALL BE 1-2" HIGHER THAN -FINISH GRADE WHEN PLANTED TOP OF MULCH SHALL BE MULCH LAYER AS SPECIFIED -1/2" BELOW SIDEWALK - CONCRETE SIDEWALK PLANTING MIX AS PLANTING MIX AS SPECIFIED SPECIFIED UNDISTURBED NATIVE REMOVE CONTAINER AND PRUNE ANY CIRCLING ROOT 1/2 ROOTBALL DIAMETER -

1/2 SPACING AS SHOWN ON PLANT LIST

_ ROOT

TYPICAL TREE PLANTING

BALL

2X ROOT BALL

DO NOT CUT

CENTRAL LEADER

TRUNK FLARE SHALL

TOP OF ROOTBALL AT THE SURFACE

REMAIN VISIBLE

FINISH GRADE .

TRIANGULAR SPACING SQUARE SPACING

NOT TO SCALE

TRIANGULAR SPACING IS PREFERRED. USE SQUARE SPACING ONLY IN SMALL RECTILINEAR AREAS. "D" EQUALS THE SPACING DISTANCE AS SPECIFIED ON THE PLANT LEGEND.

PLANT LIST

SCIENTIFIC NAME

QUERCUS VIRGINIANA

QUERCUS SHUMARDII

ULMUS CRASSIFOLIA

ELAEAGNUS PUNGENS

CYNODON DACTYLON

TAPER PLANTING BED DOWN

TO BELOW TOP OF EDGING

MULCH LAYER AS SPECIFIED

" BENDA BOARD EDGING AS SPECIFIED

PLANTING SIDE OF EDGE

TYPICAL BED EDGING DETAIL

DECK SCREWS FOR ATTACHMENT, LOCATE ON

PLASTIC EDGING STAKES @ 3'-0" O.C. MAX. WITH PLATED

SIZE

4" CALIPER

4" CALIPER

4" CALIPER

7 GALLON

FEET

PLANTING MIX

NOT TO SCALE

COMMON NAME

COMMON BERMUDA GRASS

LIVE OAK

CEDAR ELM

ELAEAGNUS

MAX. 1" DOWN

FINISH

GRADE

SHUMARD RED OAK

QUANTITY

176,265

LO

RO

BLACK, 1/2" WIDE

HALF OF ROOT BALL

REMOVE BURLAP FROM TOP

— MULCH LAYER AS SPECIFIED

— 4" EARTHEN WATERING RING

STAKE. POSITION TO

MINIMUM 2"x2"x36" WOOD

SECURELY STABILIZE TREE.

— PLANTING MIX AS SPECIFIED

UNDISTURBED NATIVE SOIL

PROVIDE (3) TOTAL ON EACH

NYLON TAPE

SPACING

AS SHOWN

AS SHOWN

AS SHOWN

48" O.C.

SOLID SOD

APPROVED: I hereby certify that the above and foregoing site plan for a development in the City of Rockwall, Texas, was approved by the Planning & Zoning Commission of the City of Rockwall on the

PLANNING

APPROVAL

WITNESS OUR HANDS, this

Planning & Zoning Commission, Chairman Director of Planning and Zoning

NOT TO SCALE

TYPICAL SHRUB AND GROUNDCOVER PLANTING PLAN/SECTION

CONCRETE SIDEWALK


SPACING AS SHOWN


ON PLANT LIST

SCALE: REFER TO DETAILS One Inch JVC No DPI006A

L5 of 5

— 3" X 3" TUBULAR SQUARE STEEL POST W/ CAP, TYP. - 1-1/2" X 1-1/2" TUBE RAILS - 8'-0" TYP POST SPACING -AT TOP, AND BOTTOM 3" X 3" TUBULAR SQUARE -STEEL POST W/ CAP, TYP. 3/4" SQ. TUBULAR STEEL PICKETS @ 4" O.C. TYP BEVEL TOP OF FOOTING SHALL -BE CROWNED 1" ABOVE GRADE FINAL GRADE PER CIVIL PLANS -3,000 PSI CONCRETE FOOTING -6'-0" HT. ORNAMENTAL METAL FENCE ELEVATION

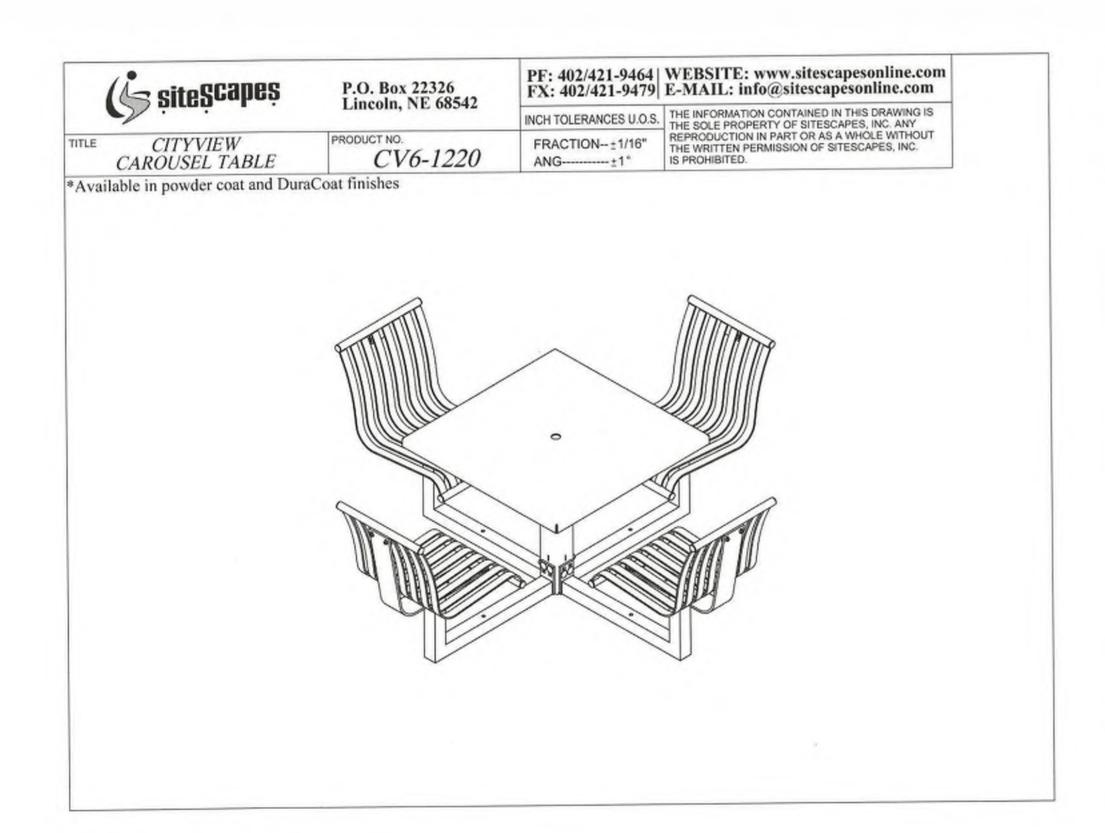

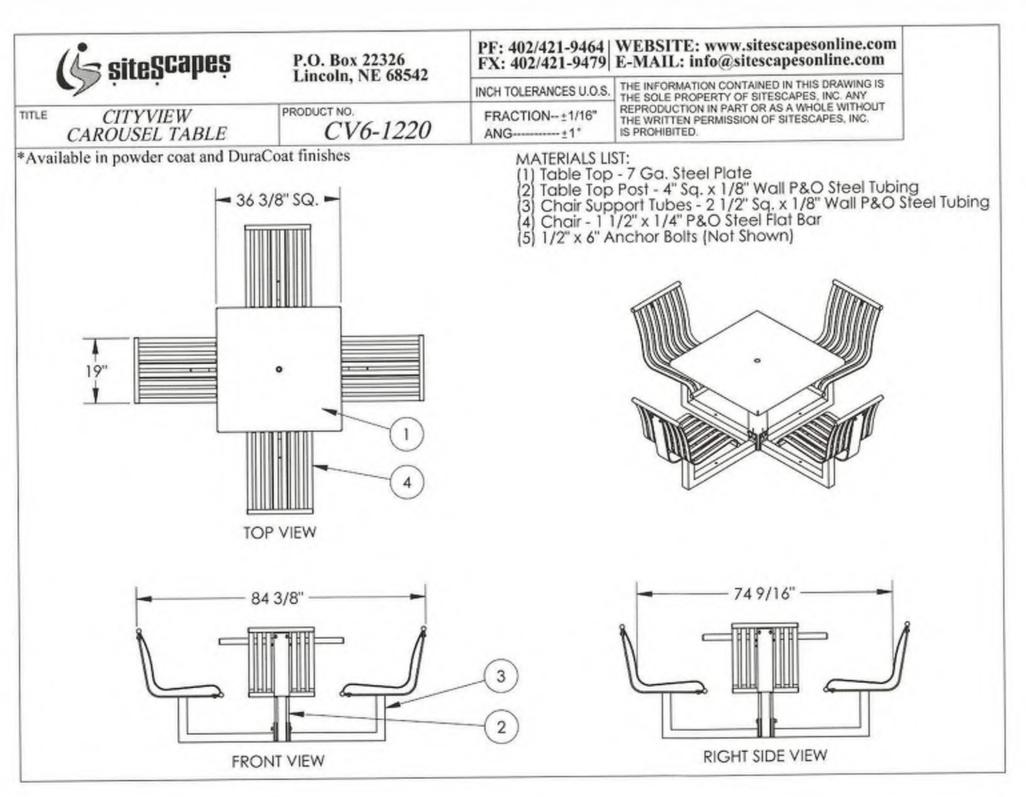

TYPICAL METAL POST FOOTING

WALL LAYOUT NOTES

ORNAMENTAL METAL FENCE NOTES

UNDERGROUND UTILITIES, PIPES, AND STRUCTURES EITHER SHOWN OR NOT SHOWN ON THE PLANS. THE CONTRACTOR WILL BE RESPONSIBLE FOR ANY COST INCURRED DUE TO

DAMAGE OR REPLACEMENT OF SAID UTILITIES AND STRUCTURES CAUSED BY HIS FORCES.

OF ALL DENTS, SPURS, AND SHARP EDGES AND SHALL BE INSTALLED LEVEL, PLUMB, AND

2. ALL CONCRETE USED IN FOOTING AND PIERS SHALL HAVE A MINIMUM COMPRESSIVE

THE CONTRACTOR IS RESPONSIBLE FOR ALL REQUIRED PERMITS AND CITY INSPECTIONS. 4. ALL ORNAMENTAL METAL TUBES, POSTS, RAILS AND PICKETS SHALL BE FLUSH AND FREE

 ALL METAL SURFACES SHALL BE PRIMED AND PAINTED WITH TWO COATS OF RUSTPROOF PAINT, COLOR TO BE FLAT BLACK. CONTRACTOR TO SUBMIT SAMPLES AS REQUIRED.

MANUFACTURING GATES AND FENCE. GATE LOCKING MECHANISM SHALL BE SELECTED

THE CONTRACTOR IS RESPONSIBLE FOR MAKING HIMSELF FAMILIAR WITH ALL

PROVIDE CONTINUOUS WELDS ALONG ALL EDGES OF FENCE MEMBERS.

8. CONTRACTOR IS RESPONSIBLE FOR VERIFYING ALL DIMENSIONS BEFORE

9. ALL ORNAMENTAL METAL FENCE MEMBERS ARE TO BE TUBULAR MEMBERS IN

ACCORDANCE WITH ASTM 513 HOT ROLLED STRUCTURAL STEEL 50,000 PSI TENSILE

11. CONTRACTOR TO PROVIDE SHOP DRAWINGS FOR ALL FENCE GATES AND OPENERS. SHOP DRAWINGS SHALL INCLUDE ALL PRODUCT CUT SHEETS AS WELL AS INSTALLATION AND

MANUFACTURING DETAILS. CONTRACTOR TO BE RESPONSIBLE FOR STRUCTURAL DESIGN

13. POSTS SHALL BE PLACED AT A MINIMUM DISTANCE OF 6'-0" O.C AND A MAXIMUM DISTANCE

RESPONSIBLE FOR ENSURING COMPLIANCE INCLUDING NECESSARY UPSIZING OF POSTS, PICKETS AND HORIZONTAL BARS AND INCREASING THE HEIGHT OF THE FENCE AS IT

APPEARS IN THIS DETAIL AT NO ADDITIONAL COST TO THE OWNER FOR MATERIALS

14. FENCE SHALL MEET LOCAL CODES AND REQUIREMENTS. CONTRACTOR SHALL BE

STRENGTH OF 3000 PSI @ 28 DAYS.

STRENGTH, 60,000 PSI YIELD STRENGTH.

10. FENCE MEMBER SIZES TO BE AS FOLLOWS:

12. CONCRETE FOOTING FOR POSTS SHALL BE 3X POST WIDTH.

 10.1. PICKETS, 3/4" SQUARE 16 GA. 10.2. RAILS, 1-1/2" X 1/2" SQUARE 16 GA.

10.3. POSTS, 3" SQUARE 11 GA.

AND/OR LABOR.

GRIND SMOOTH ALL WELDS.

SQUARE.

THE CONTRACTOR IS RESPONSIBLE FOR MAKING HIMSELF FAMILIAR WITH ALL UNDERGROUND UTILITIES, PIPE AND STRUCTURES WHETHER OR NOT SHOWN ON THE PLANS. THE CONTRACTOR SHALL BE RESPONSIBLE FOR LOCATION OF ALL UNDERGROUND UTILITIES AND WILL BE RESPONSIBLE FOR COSTS INCURRED DUE TO DAMAGE OR REPLACEMENT OF SAID UTILITIES OR STRUCTURES CAUSED BY HIS FORCES.

DO NOT WILLFULLY PROCEED WITH CONSTRUCTION, AS DESIGNED, WHEN IT IS OBVIOUS THAT UNKNOWN OBSTRUCTIONS OR CONFLICTS EXIST THAT MAY NOT HAVE BEEN KNOWN DURING DESIGN. SUCH CONDITIONS SHALL BE BROUGHT IMMEDIATELY TO THE ATTENTION OF THE LANDSCAPE ARCHITECT. THE CONTRACTOR SHALL ASSUME FULL RESPONSIBILITY FOR ALL NECESSARY REVISIONS DUE TO FAILURE TO GIVE SUCH NOTIFICATION.

3. THE CONTRACTOR SHALL BE RESPONSIBLE FOR THE LAYOUT OF THE PROPOSED WALLS AND COLUMNS. THE OWNER'S ENGINEER SHALL STAKE THE LOCATIONS OF THE PROPERTY, R.O.W. LINES AND EASEMENTS.

4. THE CONTRACTOR SHALL STAKE ALL OF THE FENCE AND COLUMN LOCATIONS FOR REVIEW BY THE OWNER'S REPRESENTATIVE PRIOR TO BEGINNING CONSTRUCTION. THE OWNER'S REPRESENTATIVE MAY MAKE MINOR ALTERATIONS TO THE LAYOUT AFTER STAKING AND BEFORE CONSTRUCTION AT NO ADDITIONAL COST TO THE OWNER.

5. ALL "STEPS" IN THE WALL MADE NECESSARY BY GRADE CHANGES OR EXISTING SLOPE SHALL OCCUR ONLY AT MINOR OR MAJOR COLUMNS. THE MINIMUM "STEP" AT A COLUMN SHALL BE 3" AND THE MAXIMUM "STEP" AT A COLUMN SHALL BE 6".

6. ALL ELECTRICAL WORK SHALL BE PERFORMED BY A LICENSED ELECTRICIAN AND SHALL BE PERFORMED IN ACCORDANCE WITH ALL APPLICABLE CODES AND REQUIREMENTS.

7. THE ELECTRICAL WORK SHALL INCLUDE ALL NECESSARY CONDUITS, WIRE, FITTINGS, FIXTURES TRENCHING AND OTHE MISCELLANEOUS ITEMS NECESSARY TO COMPLETE THE WORK. 8. THE CONTRACTOR SHALL BE RESPONSIBLE FOR ALL NECESSARY PERMITS AND

SITE TO PRE-CONSTRUCTION CONDITION.

CITY ACCEPTANCE. THE CONTRACTOR SHALL BE RESPONSIBLE FOR GRADING AS NEEDED FOR FENCE AND COLUMN INSTALLATION. THE CONTRACTOR SHALL RETURN THE

SEP 1 1 2024

APPROVED:

I hereby certify that the above and foregoing site plan for a development in the City of Rockwall, Texas, was approved by the Planning & Zoning Commission of the City of Rockwall on the

WITNESS OUR HANDS, this


Director of Planning and Zoning

Planning & Zoning Commission, Chairman

PICNIC TABLE



	Point Number	Inches	Туре	Removed	
	223	12	EASTERN RED CEDAR	YES	
	227	12	EASTERN RED CEDAR		
	229	12	EASTERN RED CEDAR		
	231	14	EASTERN RED CEDAR	YES	
_	233	14	EASTERN RED CEDAR		
	235	16	EASTERN RED CEDAR	YES	
	237	12	EASTERN RED CEDAR	YES	
	239	48	EASTERN RED CEDAR	YES	
	241	19	EASTERN RED CEDAR		
	243	12	EASTERN RED CEDAR	YES	
	245	20	EASTERN RED CEDAR	YES	
	247	12	EASTERN RED CEDAR	YES	
-	249	12	EASTERN RED CEDAR	YES	-
	251	36	EASTERN RED CEDAR	YES	
	253	14	EASTERN RED CEDAR	YES	
	255	14	EASTERN RED CEDAR	YES	
	257	12	EASTERN RED CEDAR		
	259	12	EASTERN RED CEDAR	YES	
	261	14	EASTERN RED CEDAR	YES	
	263	12	EASTERN RED CEDAR	YES	
	265	18	EASTERN RED CEDAR	YES	
-	267	12	EASTERN RED CEDAR	YES	
	269	18	EASTERN RED CEDAR	YES	
	271	18	EASTERN RED CEDAR EASTERN RED CEDAR	YES	
	273	18	EASTERN RED CEDAR	YES	
	452 454	18	EASTERN RED CEDAR	YES	
	454	12	EASTERN RED CEDAR	YES	
	460	16	EASTERN RED CEDAR	YES	
		11	EASTERN RED CEDAR	YES	
	462			YES	
	464	12	EASTERN RED CEDAR EASTERN RED CEDAR	YES	
	466 468	12	EASTERN RED CEDAR	YES	
		20	EASTERN RED CEDAR	YES	
	470 472	12	EASTERN RED CEDAR	YES	
	474	16	EASTERN RED CEDAR	YES	
	474	12	EASTERN RED CEDAR	YES	
	478	20	EASTERN RED CEDAR	YES	
	480	20	EASTERN RED CEDAR	YES	
	482	12	EASTERN RED CEDAR	YES	
	484	12	EASTERN RED CEDAR	YES	
	486	18	EASTERN RED CEDAR	YES	
	488	18	EASTERN RED CEDAR	YES	
	488	16	EASTERN RED CEDAR	YES	
	490	20	EASTERN RED CEDAR	YES	
	494	12	EASTERN RED CEDAR	YES	
	494	12	EASTERN RED CEDAR	YES	
	496	12	EASTERN RED CEDAR	YES	
	500	12	EASTERN RED CEDAR	YES	
	500	20	EASTERN RED CEDAR	YES	
	502	18		YES	
			EASTERN RED CEDAR	YES	
1	506	12	EASTERN RED CEDAR EASTERN RED CEDAR	YES	
	508	12			
	510	12	EASTERN RED CEDAR	YES	
	512	16	EASTERN RED CEDAR	YES	
-	514	26 Troos/In	EASTERN RED CEDAR	YES	
	and boat of the said	Trees/In.	Mitigation	Total	Laches
	es (total trees)	53	4	212	Inches
tured tree	1	110	2	220	Inches
al Mitigatio	on (inches)			432	Inches Required
	Maria		I and the	Tatel I . I	
posed Plan		Count		Total Inche	1
the second second second second second	es (inches)	26	4	104	
trees *		94	4	376	* 1 tree/lot
iper inches	planted			480	Inches Provided
			Balance	-48	

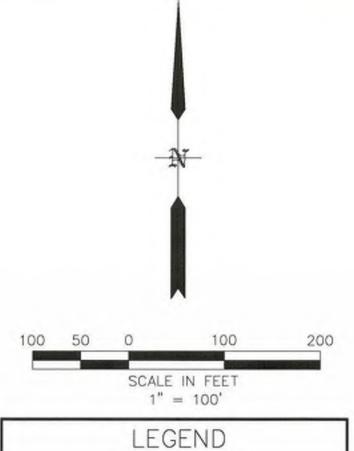

EXISTING TREE TO BE REMOVED EXISTING TREE TO REMAIN

RECORD DRAWINGS

To the best of our knowledge Petitt-ECD, L.P., hereby states that this plan is As-Built. This information provided is based on surveying at the site and information provided by the contractor.

CHARLES A. LAMPING, P.E. 10-15-2025 CHARLES A. LAMPING, P.E.

PLANNING APPROVAL

CAUTION! EXISTING UTILITIES

CONTRACTOR SHOULD CALL 1-600-DIG-TESS PRIOR TO BILIGINNING ANY CONSTRUCTION ACTIVITIES FOR EXISTING UTILITY LOCATIONS. EXISTING UTILITIES AND UNDERGROUND FACILITIES INDICATED ON THESE PLANS HAVE BEEN LOCATED FROM REFERENCE INFORMATION. IT IS THE RESPONSIBILITY OF THE CONTRACTOR TO VERIFY BOTH HORIZONTALLY AND VERTICALLY THE LOCATION OF ALL EXISTING UTILITIES AND UNDERGROUND FACILITIES PRIOR TO CONSTRUCTION AND TO TAKE NECESSARY PRECAUTIONS IN ORDER TO PROTECT ALL EXISTING UTILITIES FROM DAMAGE DURING CONSTRUCTION.

CP 101 - Square cut on headwall west side of Rochelle road & 54' south of center of Polar Point Drive Elevation = 559.95 CP 103 - "X" in concrete east side of Rochelle Road, 1834' south of center of Polar Point Dr. Elevation = 564.54'

CP 104 - Capped 5/8" Iron rod east side of Rochelle Road & 1250' south of the center of Polar Point Dr. Elevation = 572.70' CP 105 - Capped 5/8" Iron rod east side of Rochelle Road & 826' south of the center of Polar Point Dr. Elevation = 568.75

PETITT - ECD

ENGINEERING SURVEYING CONSTRUCTION ADMINISTRATION TBPELS REGISTRATION ENGINEERING FIRM #001145 - SURVEYING FIRM #10194792 1600 N. COLLINS BLVD 201 WINDCO CIRCLE SUITE 3300 SUITE 100 RICHARDSON, TX 75080 WYLIE, TX 75098 972.941.8401 972.941.8400

DRAWN: RH	DATE:	
CHECKED: CAL	DATE: 6/04/2024	
PROJECT NO.: 06537		

THIS DOCUMENT IS RELEASED FOR THE PURPOSE OF INTERIM REVIEW UNDER THE AUTHORITY OF CHARLES A. LAMPING, P.E. (88554) ON 6/04/2024. IT IS NOT TO BE USED FOR CONSTRUCTION, BIDDING, OR PERMITTING.

TREE PLAN

TERRACINA ESTATES PHASE 2

CITY OF ROCKWALL, ROCKWALL COUNTY, TEXAS