

ENGINEERING CONCEPTS AND DESIGN


CONSTRUCTION PLANS FOR

TIMBER CREEK LIFT STATION EXPANSION

CITY OF ROCKWALL, TEXAS

OWNER
 CITY OF ROCKWALL, TEXAS
 385 S. GOLIAD STREET
 ROCKWALL, TEXAS

ENGINEER
 PERKINS ENGINEERING CONSULTANTS, INC.
 6001 INTERSTATE 20 WEST, SUITE 219
 ARLINGTON, TEXAS 76017

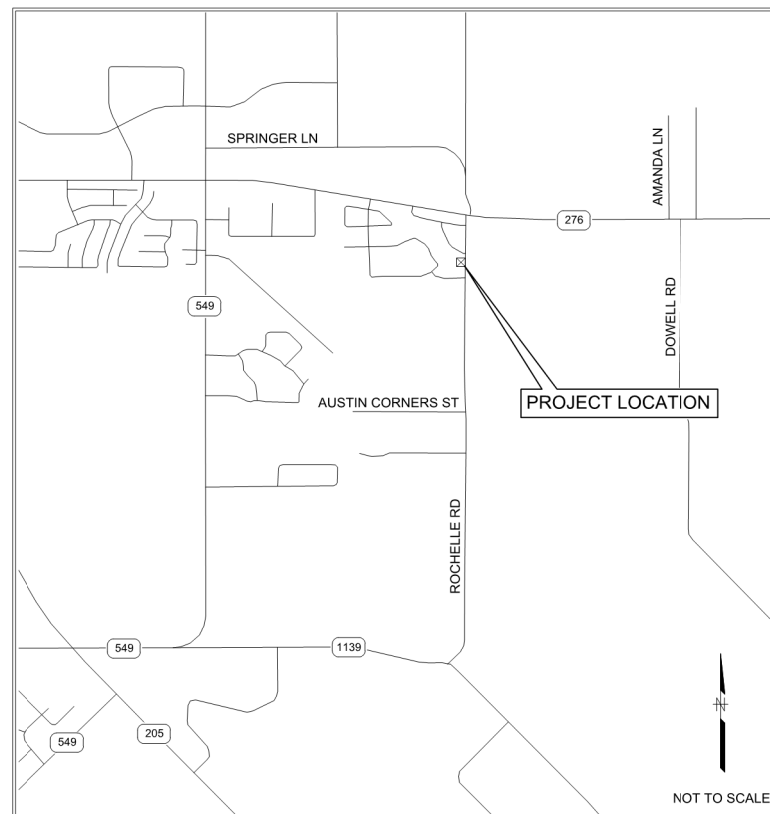


SHEET INDEX

G-01	GENERAL NOTES
G-02	CITY OF ROCKWALL GENERAL CONSTRUCTION NOTES
LS-01	EXISTING SITE PLAN
LS-02	PROPOSED SITE PLAN AND WET WELL SECTION
LS-03	GRADING PLAN
LS-04	DETAILS I
LS-05	DETAILS II
S-01	RETAINING WALL
S-02	GENERATOR PAD
S-03	EROSION CONTROL DETAILS
E-01	ELECTRICAL LEGEND
E-02	ELECTRICAL GENERAL NOTES
E-03	ELECTRICAL SITE PLAN
E-04	ELECTRICAL ONE LINE DIAGRAM
E-05	CONTROL LOGIC
E-06	ELECTRICAL DETAILS
E-07	ELECTRICAL DETAILS



NOVEMBER 2019

RECORD DRAWING
 TO THE BEST OF OUR KNOWLEDGE
 PERKINS ENGINEERING CONSULTANTS, INC.
 HEREBY STATES THAT THIS PLAN IS AS-BUILT.
 THIS INFORMATION PROVIDED IS BASED ON
 SURVEYING AT THE SITE AND INFORMATION
 PROVIDED BY THE CONTRACTOR.
 Justin A. Angel
 JUSTIN A. ANGEL, P.E.
 TEXAS NO. 129386
 10/20/2022
 DATE

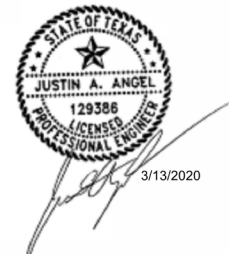

GENERAL NOTES

GENERAL

1. BUILDING CODE: INTERNATIONAL BUILDING CODE IN THE CITY OF ROCKWALL TEXAS LATEST ADDITION.
2. DESIGN LIVE LOADS:
3. A. TYPICAL 150 PSI
4. ANY BACKGROUND DRAWINGS SHOWING ON THE STRUCTURAL PLANS ARE FOR REFERENCE ONLY. SEE CIVIL, MECHANICAL, ELECTRICAL, PLUMBING, AND OTHER DRAWINGS FOR ENTRY REQUIREMENTS OF NON-STRUCTURAL ELEMENTS
5. SECTIONS AND DETAILS INDICATED AS TYPICAL SECTIONS AND TYPICAL DETAILS SHALL BE USED AT ALL LOCATIONS WHERE CONDITIONS ARE SIMILAR TO THOSE DESCRIBED IN THE DETAILS.
6. FIELD VERIFY ALL EXISTING DIMENSIONS AND CONDITIONS PRIOR TO START OF SHOP DRAWINGS OR CONSTRUCTION WHERE INDICATED ON DRAWINGS, SUBMIT RECORD OF FIELD CONDITIONS TO ENGINEER.
7. EXISTING CONDITIONS REQUIRING MODIFICATIONS TO DOCUMENTS FOR PROPOSED CONSTRUCTION SHALL BE IMMEDIATELY SUBMITTED TO ENGINEER.
8. REVIEW OF SUBMITTAL INFORMATION SHALL BE FOR GENERAL REQUIREMENTS OF PROJECT; AND SHALL NOT INCLUDE CHECKING OF DETAIL DIMENSIONS OR DETAILED QUANTITIES, NO REVIEW OF THE CONTRACTORS SAFETY MEASURES IN, ON, OR NEAR THE WORKSITE, OR MEANS AND METHODS OF DOING WORK.
9. CONTRACTOR SHALL CHECK ALL SHOP DRAWING SUBMITTALS FOR COMPLIANCE WITH CONTRACT DOCUMENTS.
10. CONTRACTOR SHALL INDICATE CHECKING AND APPROVAL OF SHOP DRAWINGS BY FIXING HIS SHOP DRAWINGS STAMPED WITH THE DATE OF APPROVAL AND NAME A PERSON APPROVING SHOP DRAWINGS.
11. CONSTRUCTION SCHEDULE SHALL ALLOW TWO WEEKS FOR SHOP DRAWING REVIEW AND RETURN BY THE STRUCTURAL ENGINEER. REVIEW BY THE DESIGN TEAM SHALL BE FOR GENERAL COMPLIANCE AND IN COMPLIANCE WITH THE CONTRACT DOCUMENTS.
12. CONTRACTOR SHALL BE RESPONSIBLE FOR ALL QUANTITIES, DIMENSIONS, CONSTRUCTION MEANS, METHODS, AND JOB SITE SAFETY.
13. ACTIONS TAKEN ON THE SHOP DRAWINGS SHALL NOT RELIEVE THE CONTRACTOR FROM RESPONSIBILITY OF COMPLIANCE WITH CONTRACT DOCUMENTS.
14. CONTRACTOR SHALL PROTECT SITE WITH TEMPORARY FENCING. TEMPORARY FENCING SHALL REMAIN WITHIN THE CITY OF ROCKWALL 100' ROW.
15. ALL ITEMS IN VALVE BOX SHALL BE BLOCKED AND SUPPORTED AS NECESSARY.
16. CONTRACTOR SHALL COAT THE WETWELL WITH RAVEN 405 OR APPROVED EQUIVALENT. SURFACE PREPARATION AS REQUIRED BY THE MANUFACTURER

17. FILL COMPACTION:

- A. CLAY SOILS WITH A PLASTICITY INDEX BELOW 25 SHOULD BE COMPACTED TO A DRY DENSITY OF AT LEAST 95% OF STANDARD PROCTOR MAXIMUM DRY DENSITY (ASTM D 698) AND WITHIN THE RANGE OF 1% BELOW TO 3% ABOVE THE MATERIAL'S OPTIMUM MOISTURE CONTENT.
 - B. CLAY SOILS WITH A PLASTICITY INDEX EQUAL TO OR GREATER THAN 25 SHOULD BE COMPACTED TO A DRY DENSITY BETWEEN 95% AND 98% OF STANDARD PROCTOR MAXIMUM DRY DENSITY (ASTM D 698). THE COMPACTED MOISTURE CONTENT OF THE CLAYS DURING PLACEMENT SHOULD BE WITHIN THE RANGE OF 2 TO 6% POINTS ABOVE OPTIMUM.
 - C. CLAY MATERIAL USED AS FILL SHOULD BE PROCESSED SUCH THAT THE LARGEST PARTICLE OR CLOD IS LESS THAN 6 INCHES PRIOR TO COMPACTION.
 - D. IN CASES WHERE EITHER MASS FILLS OR UTILITY LINES ARE MORE THAN 10 FT DEEP, THE FILL/BACKFILL BELOW 10 FT SHOULD BE COMPACTED TO AT LEAST 98% OF STANDARD PROCTOR MAXIMUM DRY DENSITY (ASTM D-698) AND WITHIN 2% OF THE MATERIAL'S OPTIMUM MOISTURE CONTENT. THE PORTION OF THE FILL/BACKFILL SHALLower THAN 10 FT SHOULD BE COMPACTED AS OUTLINED ABOVE.
 - E. COMPACTION SHOULD BE ACCOMPLISHED BY PLACING FILL IN ABOUT 8-INCH THICK LOOSE LIFTS AND COMPACTING EACH LIFT TO AT LEAST THE SPECIFIED MINIMUM DRY DENSITY. FIELD DENSITY AND MOISTURE CONTENT TESTS SHOULD BE PERFORMED ON EACH LIFT.
18. CHECK VALVES SHALL BE AMERICAN (ACIPCO) SERIES 600 WITH LEVER AND COUNTERWEIGHT.
19. PIPE SUPPORTS SHALL BE STANDON MODEL S89 OR EQUAL FLANGED PIPE SUPPORT, OR SHALL BE PER FLANGED PIPE SUPPORT DETAIL.
20. ALL BOLTS, NUTS, WASHERS, ANCHOR BOLTS, FASTENERS, AND RELIEF STRAIN GRIPS SHALL BE 316SS. ANCHOR BOLT SYSTEMS SHALL BE EPOXY OR ADHESIVE TYPE BY HILTI, OR APPROVED EQUAL.
21. ALL DIP WITHIN THE WET WELL AND VALVE VAULT SHALL BE COATED WITH 2 EA. LAYERS OF 6 MIL. OFT DEVOE BAR-RUST 233H HIGH PERFORMANCE EPOXY, OR APPROVED EQUAL. DIP SHALL BE EPOXY LINED.

BYPASS PUMPING

1. CONTRACTOR SHALL ADHERE TO THE FOLLOWING FOR BYPASS PUMPING:
 - A. SCHEDULE MEETING WITH OWNER TO REVIEW SEWER SHUTDOWN PRIOR TO REPLACING OR REHABILITATING ANY FACILITIES.
 - B. OWNER RESERVES THE RIGHT TO DELAY SCHEDULE DUE TO WEATHER CONDITIONS, OR OTHER UNEXPECTED EMERGENCY WITHIN THE SEWER SYSTEM.
 - C. REVIEW BYPASS PUMPING ARRANGEMENT OR LAYOUT IN THE FIELD WITH OWNER PRIOR TO BEGINNING OPERATIONS. FACILITATE PRELIMINARY BYPASS PUMPING RUN WITH OWNER STAFF PRESENT TO AFFIRM THE OPERATION IS SATISFACTORY TO THE OWNER.
 - D. CONTRACTOR WILL BE LIABLE FOR CLEAN-UPS, FINES, AND ANY OTHER PROBLEMS THAT MAY OCCUR.
 - E. PROVIDE ADEQUATE CAPACITY AND SIZE TO HANDLE EXISTING FLOWS PLUS ADDITIONAL FLOW THAT MAY OCCUR DURING PERIODS OF A RAINSTORM. ESTIMATE PEAK AMOUNTS OF FLOW TO BE BYPASSED AND PROVIDE BYPASS FLOW CAPACITY OF AT LEAST 125 PERCENT OF PEAK FLOW ESTIMATE. PEAK FLOW ESTIMATE IS EQUAL TO 924 GPM.
 - F. OPERATE AND MAINTAIN FLOW CONTROL SYSTEM 24 HOURS PER DAY, 7 DAYS PER WEEK INCLUDING HOLIDAYS, AS REQUIRED TO CONTROL FLOW.

CITY OF ROCKWALL

GENERAL

1. DEVELOPER/ENGINEER MUST ENSURE THAT ALL DESIGN AND CONSTRUCTION IS IN ACCORDANCE WITH ALL FEDERAL, STATE, AND LOCAL REGULATIONS AND MUST PROVIDE CERTIFICATION ON FINAL PLANS. A COPY OF ALL DETERMINATIONS, PERMITS, AND APPROVALS RECEIVED FROM FEDERAL, STATE, AND LOCAL AGENCIES MUST BE PROVIDED. ENGINEERING DESIGN AND PLANS SUBMITTED TO THE ENGINEERING DIVISION BY THE DEVELOPER/DESIGN ENGINEER SHALL BE IN CONFORMANCE WITH THE ADOPTED STANDARDS OF DESIGN AND CONSTRUCTION THAT ARE IN AFFECT WHEN THE 1ST SUBMITTAL IS RECEIVED BY THE ENGINEERING DIVISION.
2. CONTRACTOR SHALL CONFORM TO THE REQUIREMENTS IN THE LATEST EDITION OF THE CITY OF ROCKWALL GENERAL NOTES PUBLISHED TO THE CITY WEBSITE WWW.ROCKWALL.COM
3. INSPECTION OF CONSTRUCTION AND VERIFICATION OF COMPLIANCE TO THE PLANS AND SPECIFICATIONS SHALL BE CONDUCTED BY THE CITY OF ROCKWALL STAFF UNDER THE DIRECTION OF THE CITY ENGINEER.
4. ALL FRANCHISE AND PUBLIC UTILITIES WITHIN A RESIDENTIAL DEVELOPMENT SHALL BE PLACED UNDERGROUND.
5. THE DEVELOPER SHALL BE RESPONSIBLE FOR SUBMITTAL OF INFORMATION NEEDED TO DESIGN PRIVATE UTILITIES FOR THE DEVELOPMENT.
6. THE FINAL ENGINEERING DRAWINGS SHALL CONFORM TO THE ESTABLISHED "ENGINEERING DRAWINGS REQUIREMENTS" AND THE STANDARDS OF DESIGN AND CONSTRUCTION.
7. FINAL ACCEPTANCE SHALL OCCUR WHEN ALL THE ITEMS ON THE CHECKLIST FOR FINAL ACCEPTANCE HAVE BEEN COMPLETED AND SIGNED-OFF BY THE CITY. AFTER IMPROVEMENTS HAVE BEEN CONSTRUCTED, THE DEVELOPER SHALL BE RESPONSIBLE FOR PROVIDING TO THE CITY "AS BUILT" OR "RECORD DRAWINGS". THE DESIGN ENGINEER SHALL FURNISH A DIGITAL FILE OF THE PROJECT FORMATTED IN AUTO CAD 14 OR 2000 FORMAT OR NEWER AND ADOBE ACROBAT (.PDF) FORMAT WITH A CD-ROM. THE DISK SHALL INCLUDE A FULL SET OF PLANS ALONG WITH ANY LANDSCAPING, WALL PLANS, AND DETAILS SHEETS.

WASTEWATER SYSTEM

1. THE DESIGN AND CONSTRUCTION OF THE WASTEWATER SYSTEM TO SERVE THE DEVELOPMENT SHALL BE IN ACCORDANCE WITH GOOD ENGINEERING PRINCIPLES, THE STANDARDS OF DESIGN, THE STANDARD SPECIFICATIONS FOR CONSTRUCTION, THE STANDARD DETAILS, AND THE REQUIREMENTS OF THE TEXAS COMMISSION ON ENVIRONMENTAL QUALITY (TCEQ). NO CONSTRUCTION SHALL COMMENCE PRIOR TO THE APPROVAL OF THE PLANS AND SPECIFICATIONS BY THE CITY OF ROCKWALL. ALL WASTEWATER MAINS AND LIFT STATIONS SHALL BE SIZED AND LOCATED TO CONFORM TO THE PROJECTED FLOWS IN ACCORDANCE WITH THE LATEST WASTEWATER MASTER PLAN.
2. THE WASTEWATER LINES SHALL BE SIZED TO MEET THE PEAK-DAY DRY WEATHER FLOW PLUS AN APPROPRIATE ALLOWANCE FOR INFILTRATION OF STORM WATER. THE MINIMUM WASTEWATER MAIN SIZE (OTHER THAN SERVICE LINES) FOR ALL DEVELOPMENTS SHALL BE EIGHT INCHES (8") IN DIAMETER. THE DESIGN CRITERIA AND CALCULATION SHALL BE SUBMITTED TO THE CITY WITH THE PLANS AND SPECIFICATIONS.

BAR IS ONE INCH IN LENGTH ON ORIGINAL DRAWING. CHECK SCALE AND ADJUST ACCORDINGLY.

ONE INCH

RECORD DRAWING

TO THE BEST OF OUR KNOWLEDGE PERKINS ENGINEERING CONSULTANTS, INC., HEREBY STATES THAT THIS PLAN IS AS-BUILT. THIS INFORMATION PROVIDED IS BASED ON SURVEYING AT THE SITE AND INFORMATION PROVIDED BY THE CONTRACTOR.

10/20/2022
DATE

JUSTIN A. ANGEL, P.E.
TEXAS NO. 129386



NO.	DATE	DESCRIPTION	BY

GENERAL NOTES

ENGINEERING CONCEPTS AND DESIGN

TIMBER CREEK LIFT STATION
EXPANSION


Date:	MARCH 2020
Designed:	JAA
Drawn:	SRG
Reviewed:	MAP
PEC Proj. No.:	ECO 18-004
of	

SHEET NO.
G-01


PRINTED: 9/29/2022 9:49 AM C:\Users\MaryAnn_Gutierrez\Dropbox (PEC)\ACAD (PEC)\ACAD (PEC)\Creek US (GIS Only)\CAD (G-01) GENERAL NOTES.dwg SAVED: 9/29/2022 9:32 AM USER: S. Gutierrez

PRINTED: 9/29/2022 9:58 AM C:\Users\MaryAnn_Gutierrez\Dropbox (PEC)\ACAD\PECO\ECOD 18-004 Timber Creek LS\GIS Only\CAD\LS-03 Grading Plan.dwg SAVED: 9/29/2022 9:32 AM USER: S. Gutierrez

BAR IS ONE INCH IN LENGTH ON ORIGINAL DRAWING. CHECK SCALE AND ADJUST ACCORDINGLY.
ONE INCH

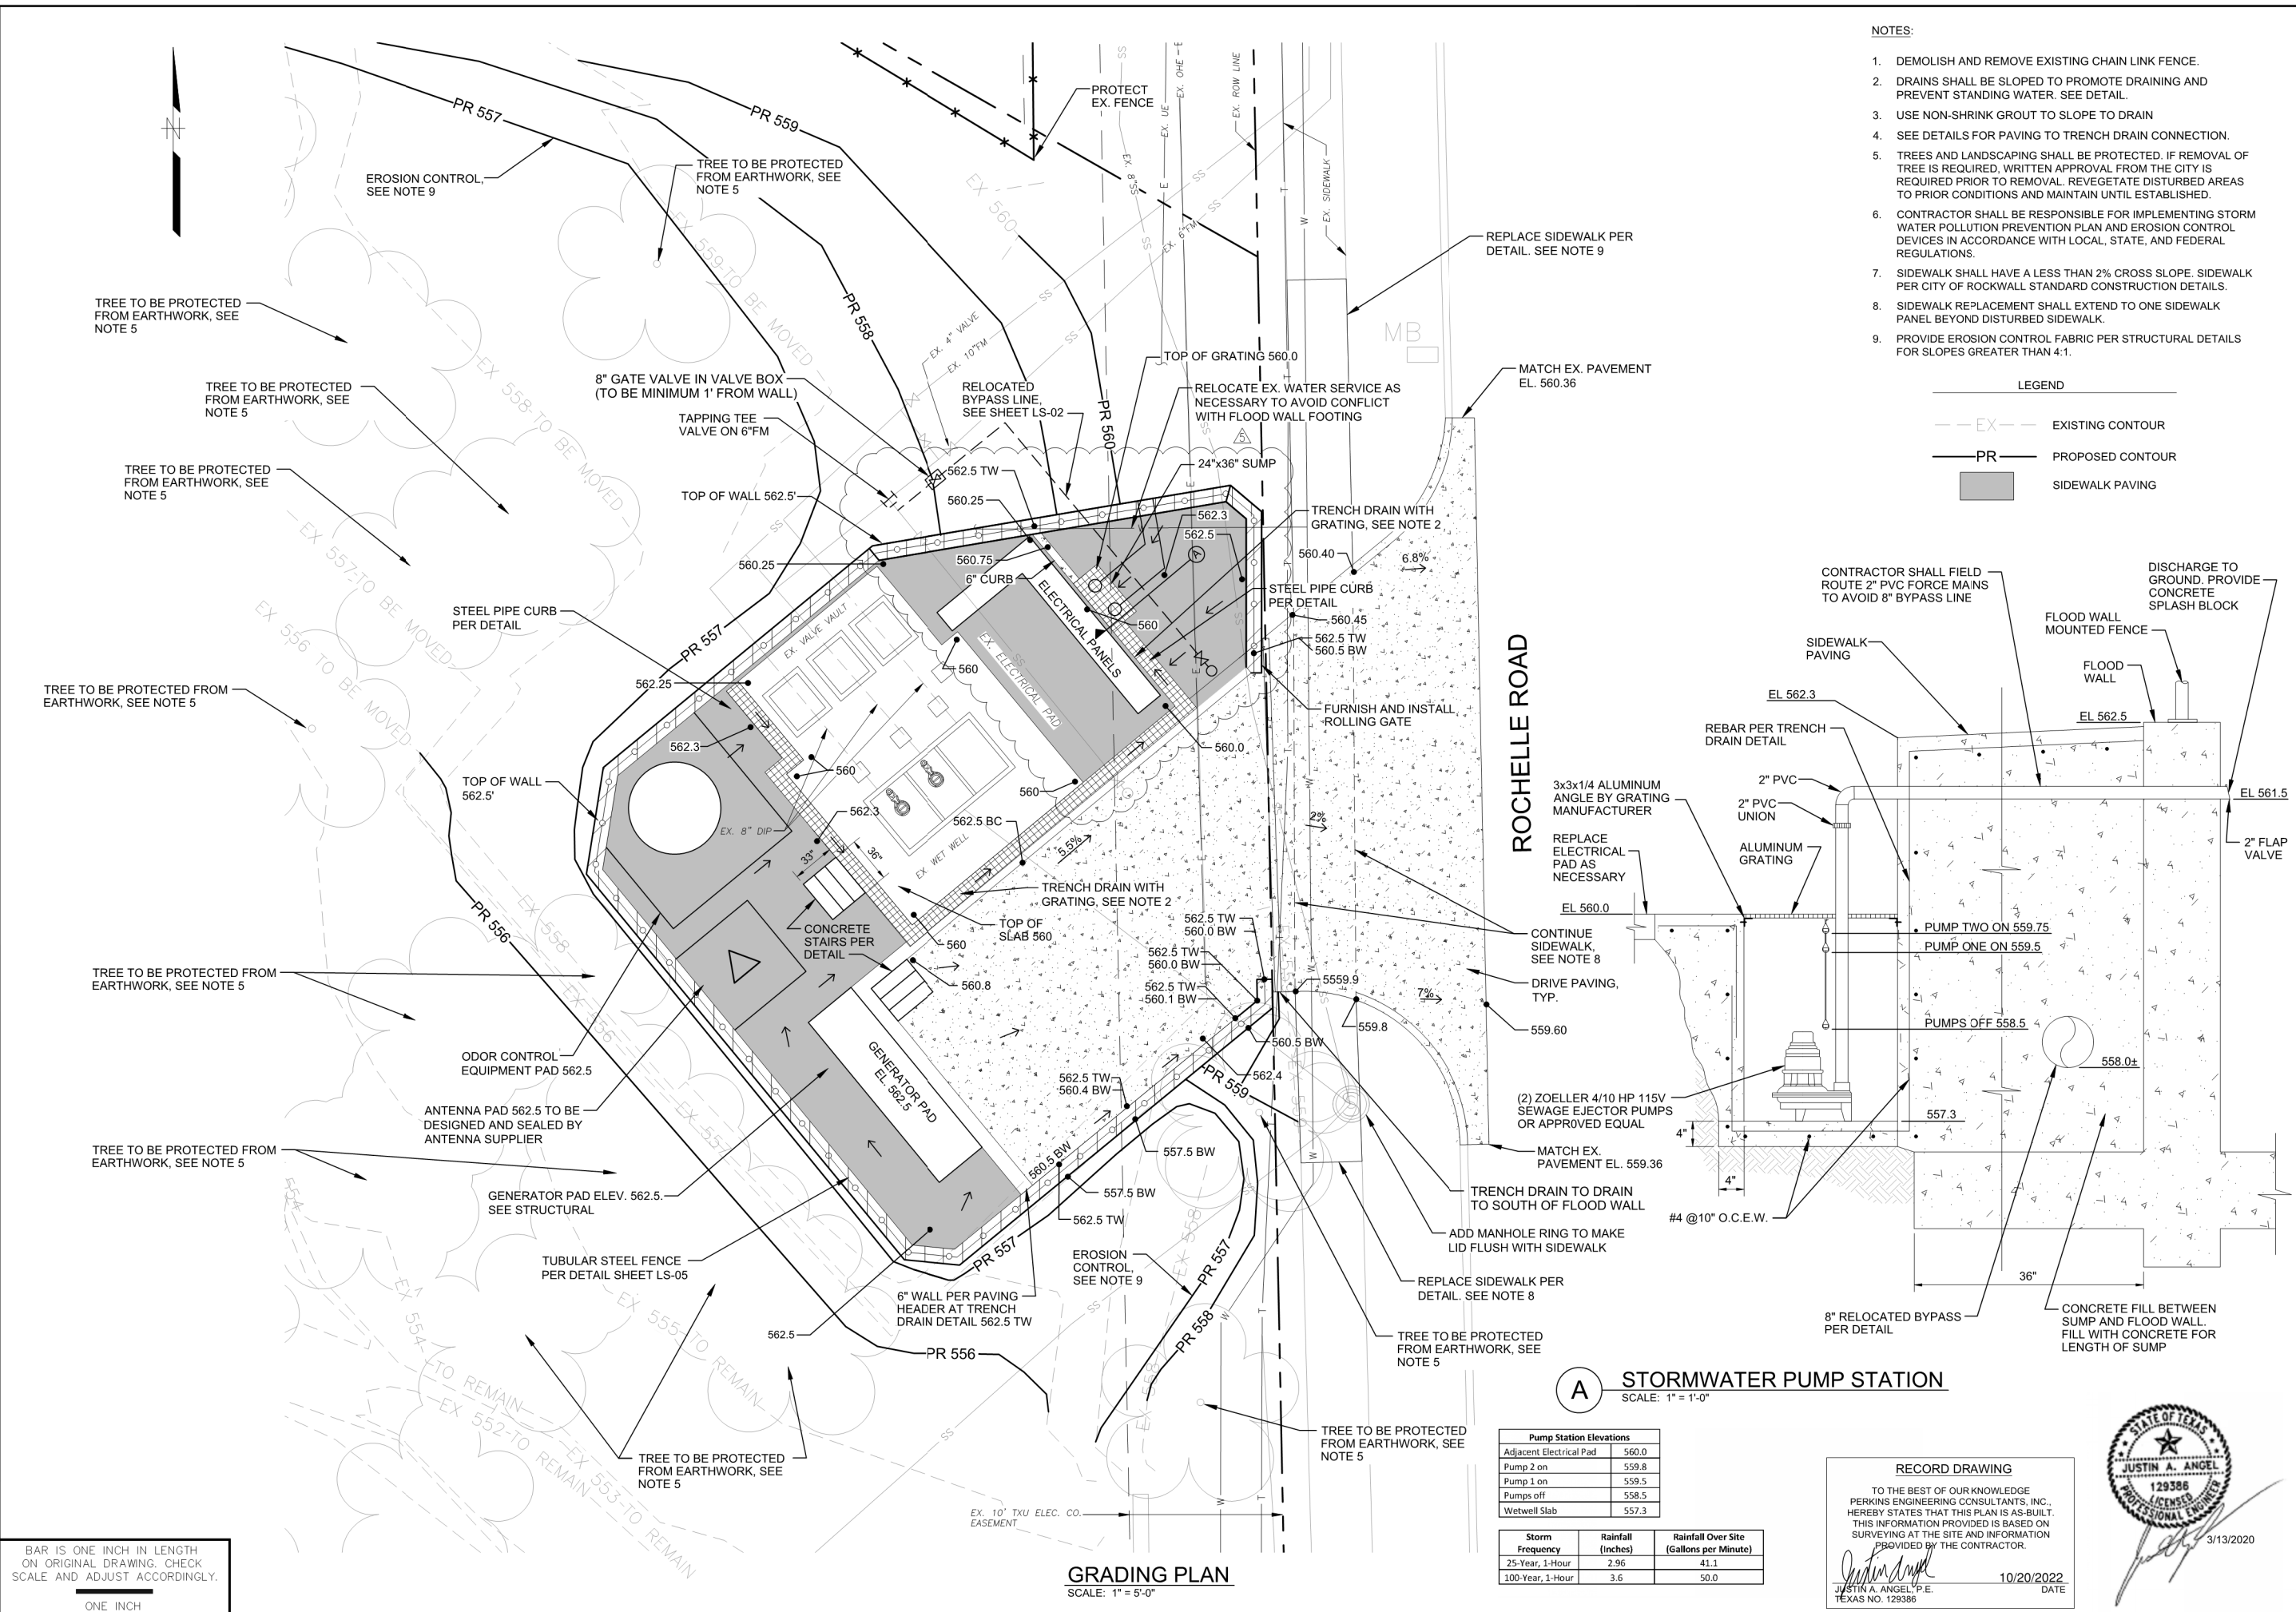

- NOTES:**
- DEMOLISH AND REMOVE EXISTING CHAIN LINK FENCE.
 - DRAINS SHALL BE SLOPED TO PROMOTE DRAINING AND PREVENT STANDING WATER. SEE DETAIL.
 - USE NON-SHRINK GROUT TO SLOPE TO DRAIN
 - SEE DETAILS FOR PAVING TO TRENCH DRAIN CONNECTION.
 - TREES AND LANDSCAPING SHALL BE PROTECTED. IF REMOVAL OF TREE IS REQUIRED, WRITTEN APPROVAL FROM THE CITY IS REQUIRED PRIOR TO REMOVAL. REVEGETATE DISTURBED AREAS TO PRIOR CONDITIONS AND MAINTAIN UNTIL ESTABLISHED.
 - CONTRACTOR SHALL BE RESPONSIBLE FOR IMPLEMENTING STORM WATER POLLUTION PREVENTION PLAN AND EROSION CONTROL DEVICES IN ACCORDANCE WITH LOCAL, STATE, AND FEDERAL REGULATIONS.
 - SIDEWALK SHALL HAVE A LESS THAN 2% CROSS SLOPE. SIDEWALK PER CITY OF ROCKWALL STANDARD CONSTRUCTION DETAILS.
 - SIDEWALK REPLACEMENT SHALL EXTEND TO ONE SIDEWALK PANEL BEYOND DISTURBED SIDEWALK.
 - PROVIDE EROSION CONTROL FABRIC PER STRUCTURAL DETAILS FOR SLOPES GREATER THAN 4:1.

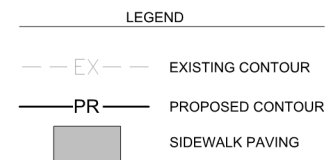


ROCHELLE ROAD

A STORMWATER PUMP STATION
SCALE: 1" = 1'-0"

Storm Frequency	Rainfall (inches)	Rainfall Over Site (Gallons per Minute)
25-Year, 1-Hour	2.96	41.1
100-Year, 1-Hour	3.6	50.0

RECORD DRAWING
TO THE BEST OF OUR KNOWLEDGE PERKINS ENGINEERING CONSULTANTS, INC., HEREBY STATES THAT THIS PLAN IS AS-BUILT. THIS INFORMATION PROVIDED IS BASED ON SURVEYING AT THE SITE AND INFORMATION PROVIDED BY THE CONTRACTOR.

DATE: 10/20/2022
JUSTIN A. ANGEL, P.E.
TEXAS NO. 129386

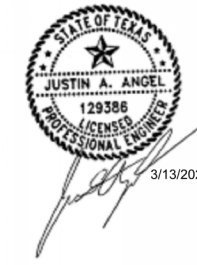

PERKINS ENGINEERING CONSULTANTS, INC.
TBPE REGISTRATION NO. F-8699

NO.	DATE	DESCRIPTION
1	3/5/21	REVISED SHEET
2	9/23/21	REVISED SHEET
3	4/01/22	REVISED SHEET
4	4/19/22	REVISED SHEET
5	4/30/22	RELOCATION OF FLOODWALL

GRADING PLAN


ENGINEERING CONCEPTS AND DESIGN

TIMBER CREEK LIFT STATION EXPANSION

Date: MARCH 2020
Designed: JAA
Drawn: SRG
Reviewed: MAP
PEC Proj. No.: ECD 18-004
of SED.


SHEET NO. LS-03

PRINTED: 9/29/2022 9:59 AM C:\Users\MaryAnn_Gutierrez\Dropbox (PEC)\ACAD_PECO\ECOD 18-004 Timber Creek LS\GIS Only\CAD\LS-X DETAILS 1-2.dwg SAVED: 9/29/2022 9:33 AM USER: S. Gutierrez

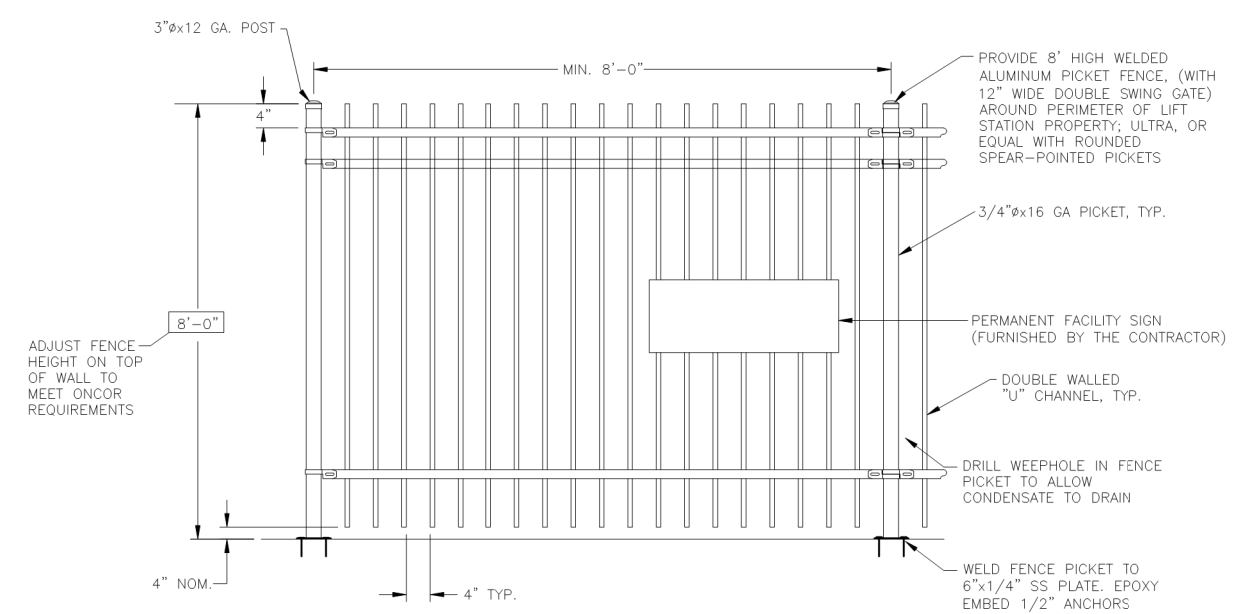


- NOTES:**
1. PROVIDE LOCK ASSEMBLY TO SECURE GATE WITH A PADLOCK.
 2. 8 FT ALUMINUM PICKET FENCE USING 6005 T5 ALLOY POWDER COATED BLACK WITH A MINIMUM CURE FILM THICKNESS OF 2.0.
 3. FENCE SHALL CONFORM WITH CITY OF ROCKWALL STANDARDS OF DESIGN AND CONSTRUCTION SECTION 5.4.4.2 COLOR BLACK WITH SATIN FINISH.

TUBULAR STEEL FENCE DETAIL
NOT TO SCALE

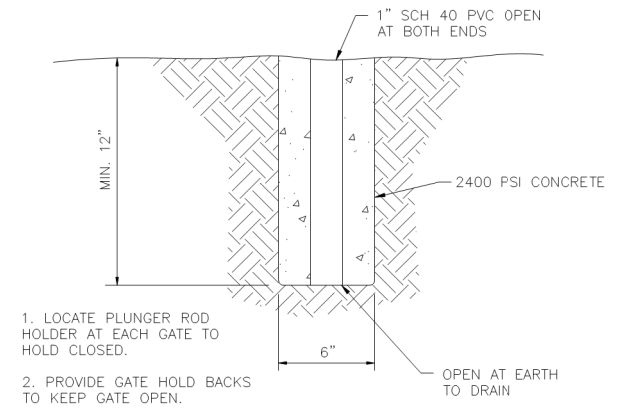

GATE PLUNGER ROD HOLDER
NOT TO SCALE

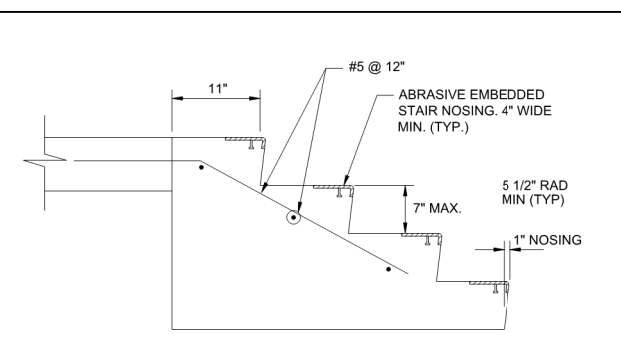


CONCRETE STEPS
NOT TO SCALE

ADJUSTABLE PIPE SADDLE SUPPORT SCHEDULE
DIMENSIONS IN INCHES


SIZE OF SUPPORTED PIPE	PIPE "A"	PIPE "B"	"C"	"D"	
				MINIMUM	MAXIMUM
2 1/2	2 1/2	1 1/2	9	8	13
3	2 1/2	1 1/2	9	8 1/2	13 1/2
3 1/2	2 1/2	1 1/2	9	8 1/2	13 1/2
4	3	2 1/2	9	9 1/2	14
6	3	2 1/2	9	10 1/2	15 1/2
8	3	2 1/2	9	11 1/2	16 1/2
10	3	2 1/2	9	13 1/2	18 1/2
12	3	2 1/2	9	15	19 1/2
14	4	3	11	16 1/2	20 1/2
16	4	3	11	17 1/2	22 1/2
18	6	3 1/2	13 1/2	19 1/2	24
20	6	3 1/2	13 1/2	21	25 1/2
24	6	4	13 1/2	23 1/2	28 1/2
30	6	4	13 1/2	27	31 1/2
32	6	4	13 1/2	28 1/2	32 1/2
36	6	4	13 1/2	30 1/2	34 1/2

* USE 2 1/2" SUPPORTS FOR PIPES LESS THAN 2 1/2" Ø

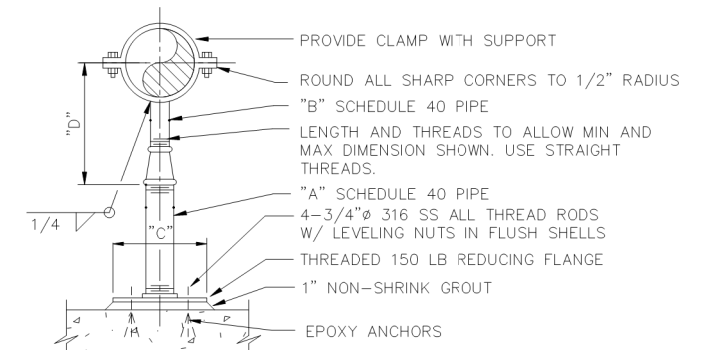


- NOTE:**
1. ALL METALS SHALL BE HOT DIPPED GALVANIZED EXCEPT FOR HARDWARE AND ANCHORS, WHICH SHALL BE 316SS.


GALVANIZED 316 SS ADJUSTABLE PIPE SADDLE SUPPORT
NOT TO SCALE

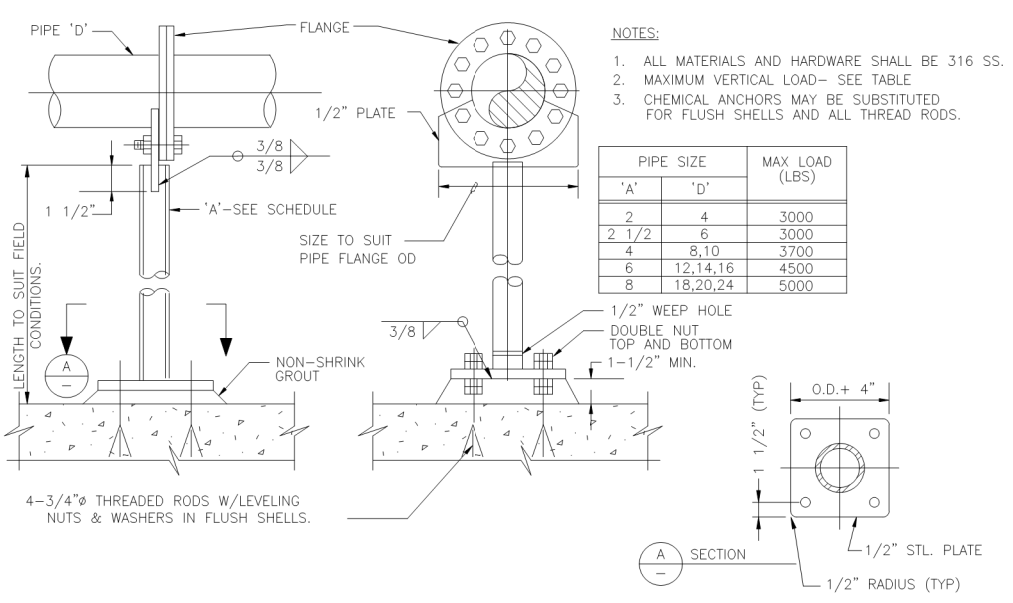


FLANGED PIPE SUPPORT
NOT TO SCALE

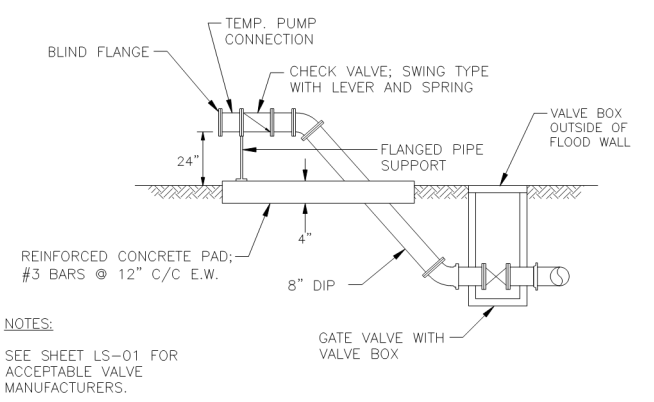

BYPASS PUMPING DETAIL
NOT TO SCALE

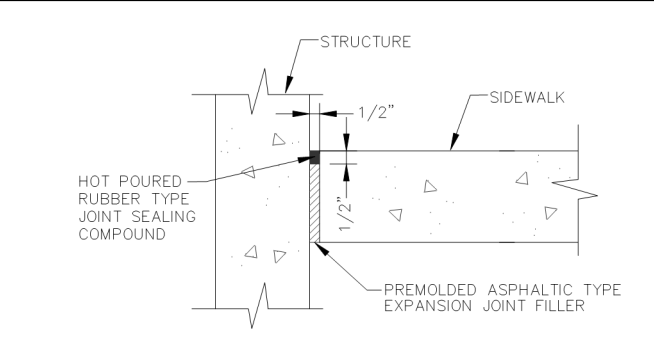

ISOLATION JOINT AT STRUCTURE
NOT TO SCALE

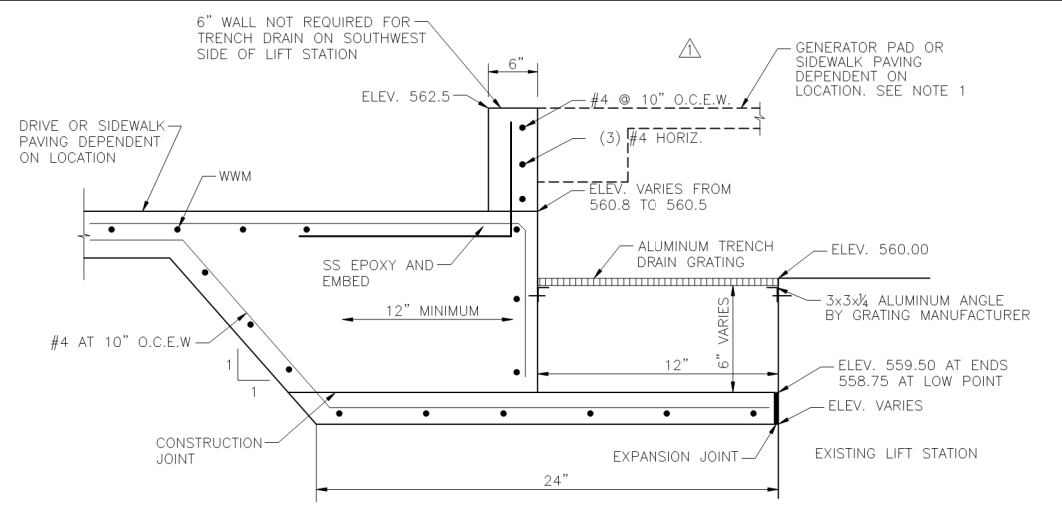

PAVING HEADER AT TRENCH DRAIN
NOT TO SCALE


- NOTES:**
1. WHERE APPLICABLE, GENERATOR PAD AND SIDEWALK PAVING SHALL BE LOCATED ON THE SAME SIDE OF HEADER AS TRENCH DRAIN SHOWN.
 2. 6" WALL REQUIRED FOR TRENCH DRAIN FACING DRIVE AND GENERATOR ONLY.

RECORD DRAWING

TO THE BEST OF OUR KNOWLEDGE PERKINS ENGINEERING CONSULTANTS, INC., HEREBY STATES THAT THIS PLAN IS AS-BUILT. THIS INFORMATION PROVIDED IS BASED ON SURVEYING AT THE SITE AND INFORMATION PROVIDED BY THE CONTRACTOR.

Justin A. Angel, P.E.
TEXAS NO. 129386

10/20/2022 DATE

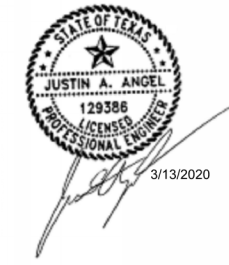

NO.	DATE	DESCRIPTION
1	4/30/21	RELOCATION OF FLOODWALL

DETAILS I


ENGINEERING CONCEPTS AND DESIGN
TIMBER CREEK LIFT STATION EXPANSION

Date:	MARCH 2020
Designed:	JAA
Drawn:	SRG
Reviewed:	MAP
PEC Proj. No.:	ECO 18-004
of	


BAR IS ONE INCH IN LENGTH ON ORIGINAL DRAWING. CHECK SCALE AND ADJUST ACCORDINGLY.







PRINTED: 9/29/2022 10:01 AM C:\Users\Mayo\OneDrive\Documents\Projects\Timber Creek\LS-05\DETAILS\1-2.dwg SAVED: 9/29/2022 9:33 AM USER: S. Gutierrez

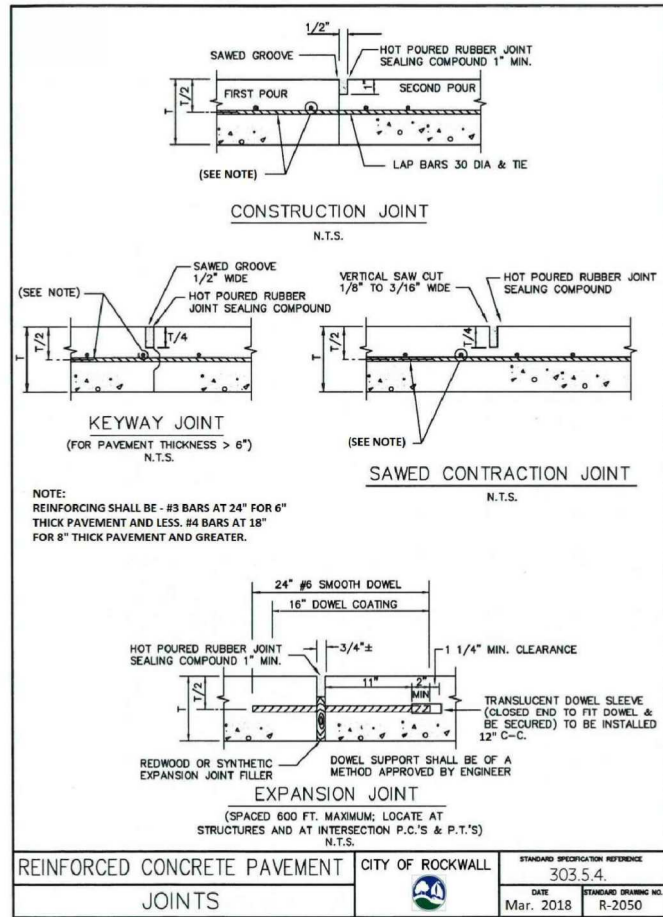

REINFORCED CONCRETE PAVEMENT	CITY OF ROCKWALL	STANDARD SPECIFICATION REFERENCE 303.5.4
JOINTS		DATE: Mar. 2018 STANDARD DRAWING NO.: R-2050

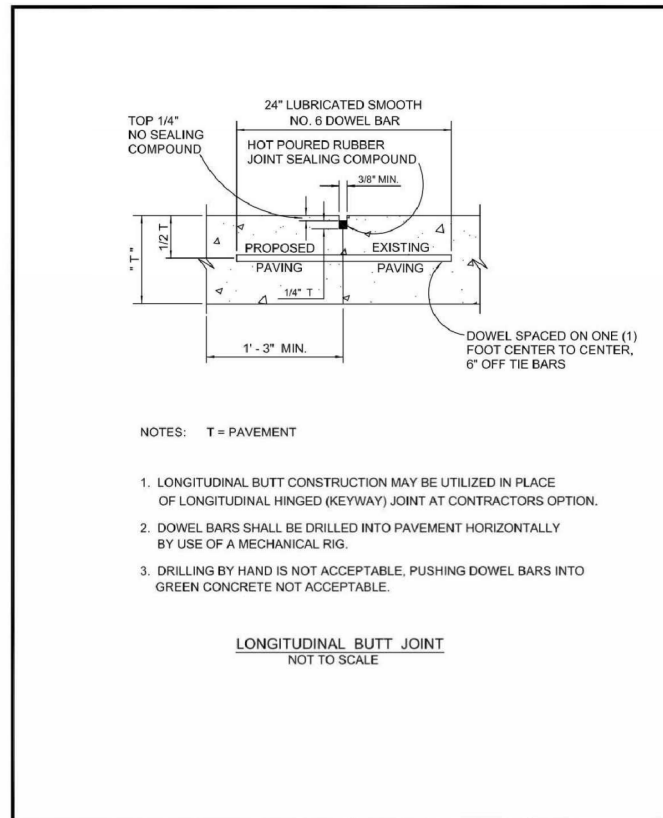

REINFORCED CONCRETE PAVEMENT	CITY OF ROCKWALL	DATE: OCT. '17 DRAWING NO.: R-2051
LONGITUDINAL BUTT JOINT		

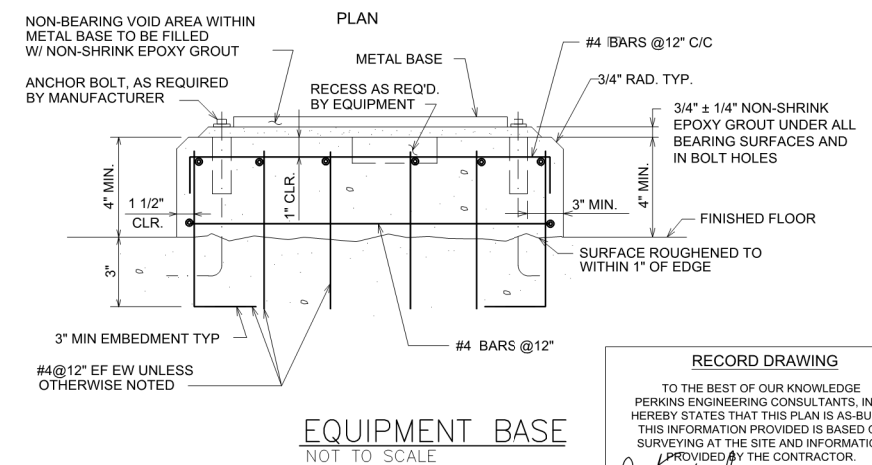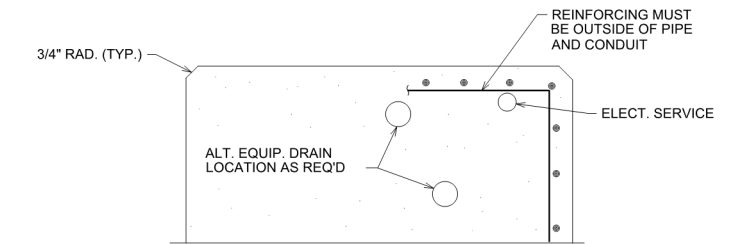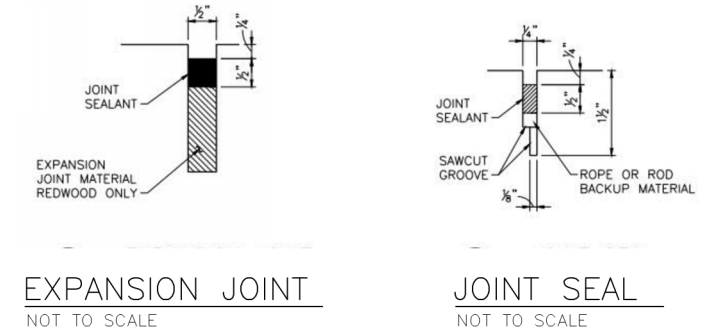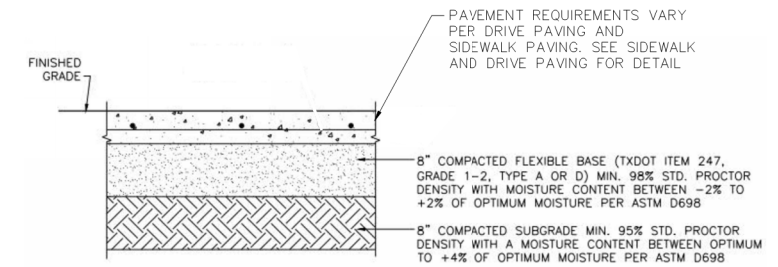


RECORD DRAWING


TO THE BEST OF OUR KNOWLEDGE PERKINS ENGINEERING CONSULTANTS, INC. HEREBY STATES THAT THIS PLAN IS AS-BUILT. THIS INFORMATION PROVIDED IS BASED ON SURVEYING AT THE SITE AND INFORMATION PROVIDED BY THE CONTRACTOR.

Justin A. Angel
JUSTIN A. ANGEL, P.E.
TEXAS NO. 129386

DATE: 10/20/2022

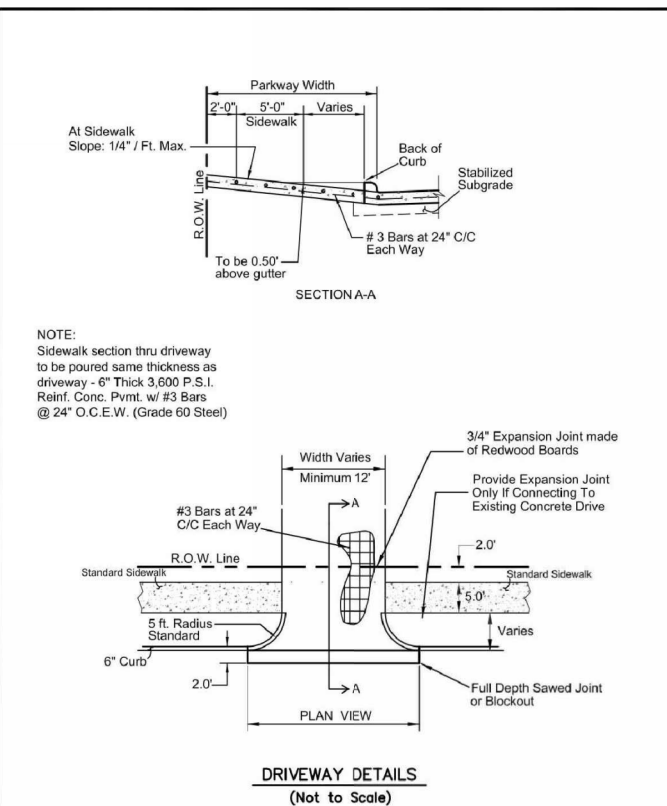

DRIVEWAY DETAIL	CITY OF ROCKWALL	DATE: AUG '19 DRAWING NO.: R-2150
RESIDENTIAL DRIVEWAY		

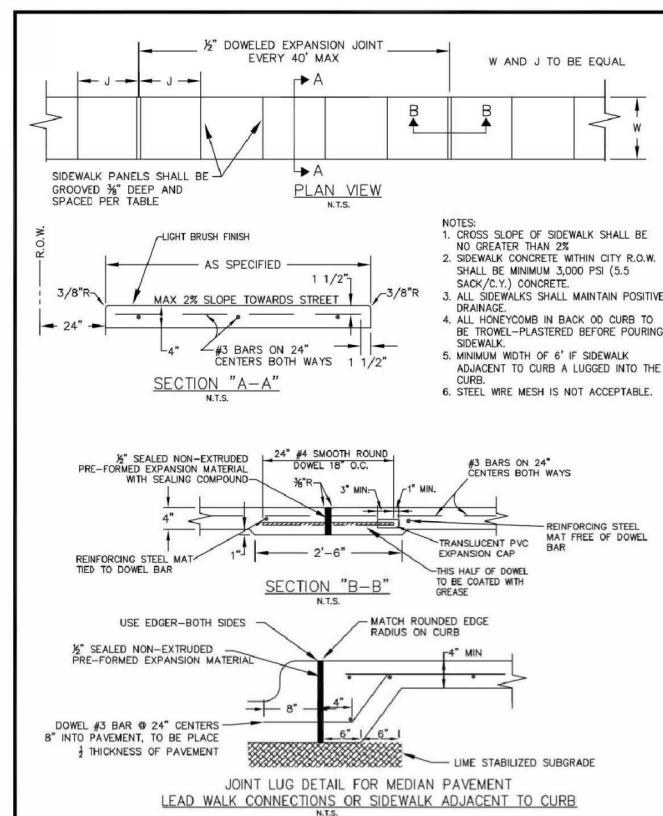

REINFORCED CONCRETE SIDEWALKS	CITY OF ROCKWALL	DATE: AUG '19 DRAWING NO.: R-2170
JOINTS AND SPACING		

PERKINS ENGINEERING CONSULTANTS, INC.
 TBPE REGISTRATION NO. F-8699

DETAILS II

ENGINEERING CONCEPTS AND DESIGN

TIMBER CREEK LIFT STATION EXPANSION

SHEET NO. LS-05

NO.	DATE	DESCRIPTION

Date: MARCH 2020
 Designed: JAA
 Drawn: SRG
 Reviewed: MAP
 PEC Proj. No.: ECD 18-004
 of
 SED.

BAR IS ONE INCH IN LENGTH ON ORIGINAL DRAWING. CHECK SCALE AND ADJUST ACCORDINGLY.


ONE INCH

RETAINING WALL INFORMATION TABLE:


WALL TABLE:

HEIGHT (H)	"A"	"B"	"C"	"D"	"E"	"F"	"G"
2'-0" - 3'-0"	2'-0"	1'-0"	1'-6"	1'-0"	1'-0"	#4 @12"	#4 @12"
3'-0" - 5'-0"	2'-6"	1'-0"	3'-0"	1'-4"	1'-6"	#4 @10"	#4 @12"
5'-0" - 6'-0"	3'-0"	1'-0"	3'-6"	1'-4"	1'-6"	#5 @12"	#4 @12"
6'-0" - 7'-0"	4'-0"	1'-0"	3'-6"	1'-4"	2'-0"	#5 @8"	#4 @12"
7'-0" - 8'-0"	5'-0"	1'-0"	3'-6"	1'-4"	2'-0"	#5 @8"	#4 @12"


1. RETAINING WALL:
 -MINIMUM SAFETY FACTOR:
 BEARING - 2 S.F.
 SLIDING - 1.5 S.F.
 OVERTURNING - 2 S.F.
 -CONTROL JOINT SPACING:
 MAX. - 16' O.C.
 MIN. - 8' O.C.

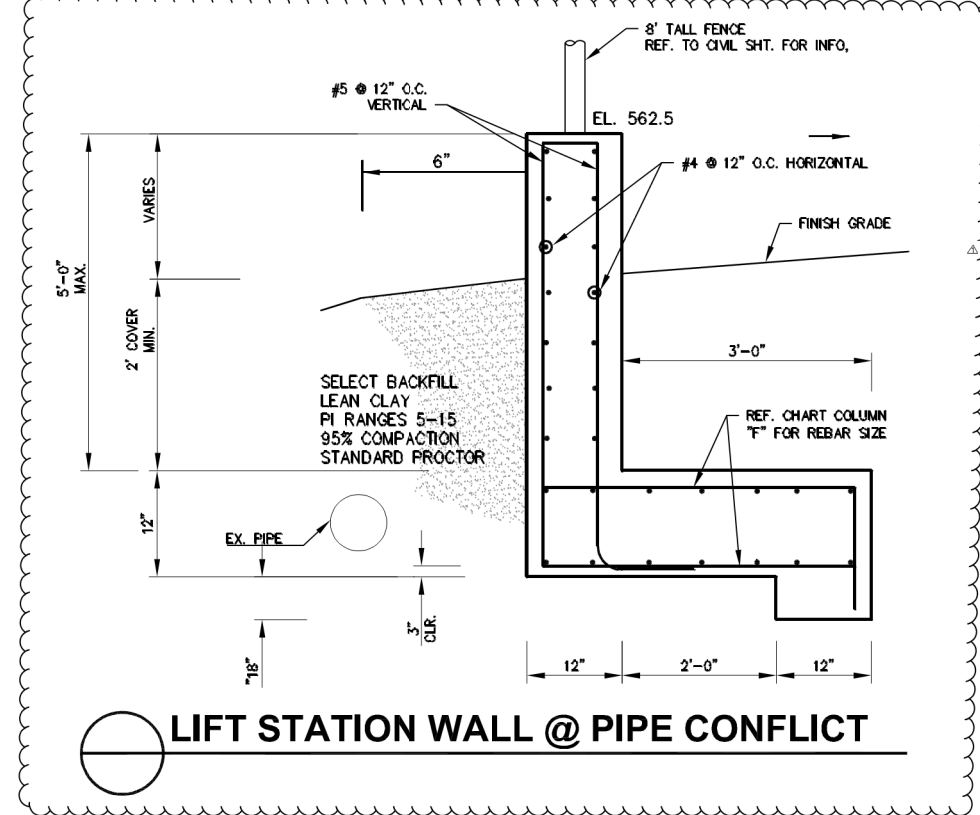


LIFT STATION WALL @ PIPE CONFLICT

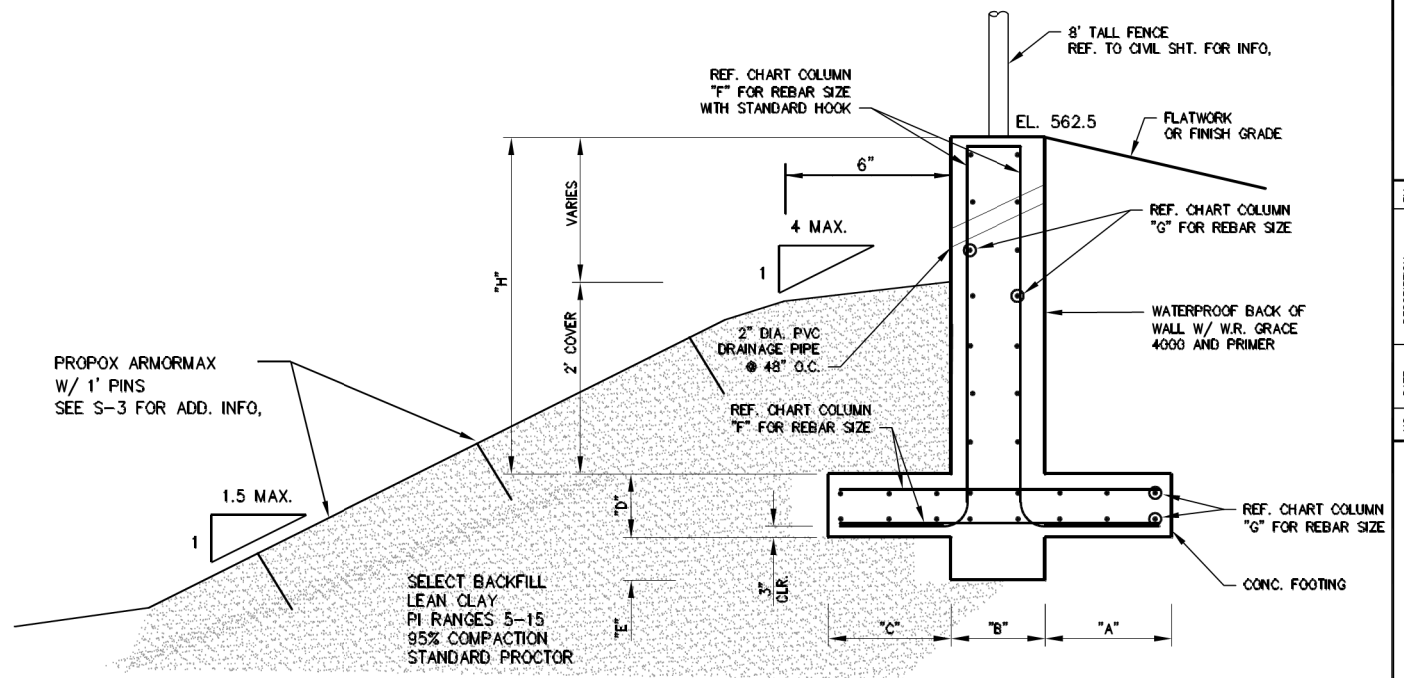


LIFT STATION WALL TYPICAL

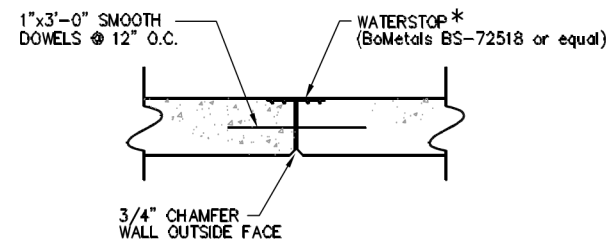

WALL CONTRACTION JOINT (C.J.)

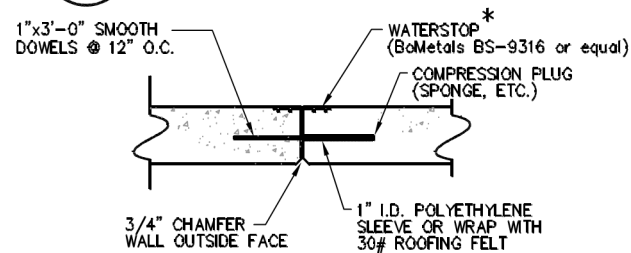


WALL EXPANSION JOINT (E.J.)

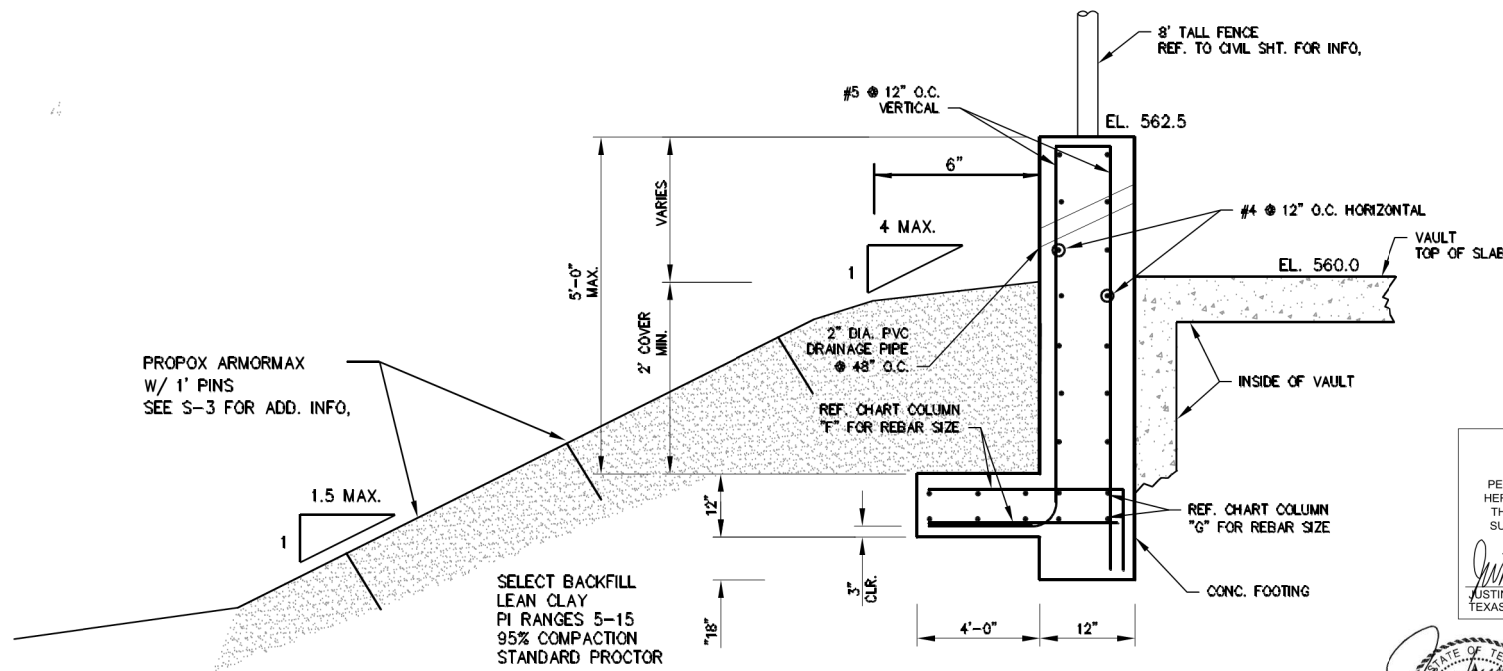

LIFT STATION WALL AGAINST VALVE VAULT

RECORD DRAWING
 TO THE BEST OF OUR KNOWLEDGE
 PERKINS ENGINEERING CONSULTANTS, INC.
 HEREBY STATES THAT THIS PLAN IS AS-BUILT.
 THIS INFORMATION PROVIDED IS BASED ON
 SURVEYING AT THE SITE AND INFORMATION
 PROVIDED BY THE CONTRACTOR.
 Justin A. Angel
 JUSTIN A. ANGEL, P.E.
 TEXAS NO. 129386
 10/20/2022
 DATE

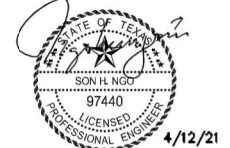


JAKAN ENGINEERING, PLLC
 Texas Registered
 Engineering Firm F-13414




Date:	NOVEMBER 2019
Designed:	
Drawn:	
Reviewed:	
PEC Proj. No.:	ECO 18-004
of	


BAR IS ONE INCH IN LENGTH
 ON ORIGINAL DRAWING. CHECK
 SCALE AND ADJUST ACCORDINGLY.
 ONE INCH

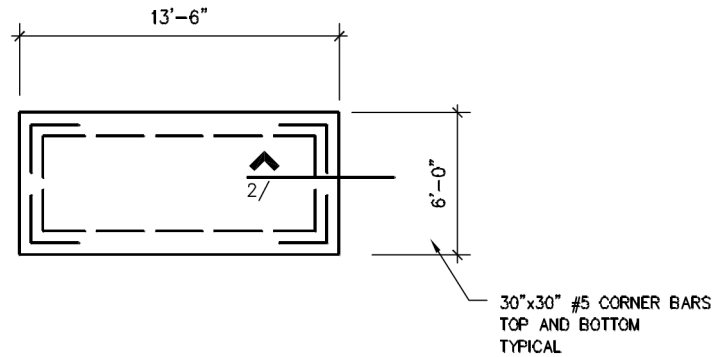


1
S2.0 **GENERATOR PAD FOUNDATION PLAN**

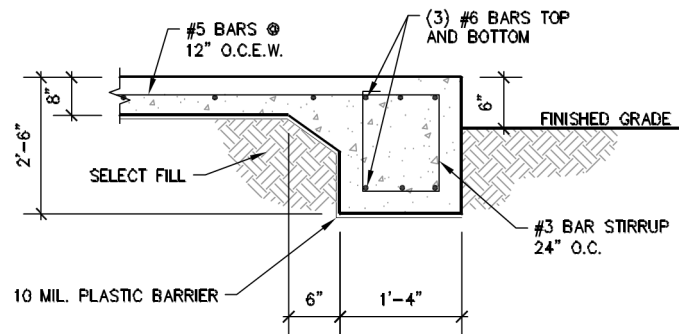

2
S2.0 **GENERATOR PAD EDGE BEAM**

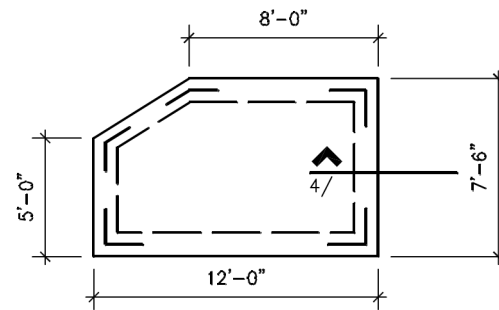

3
S2.0 **ODOR PAD FOUNDATION PLAN**

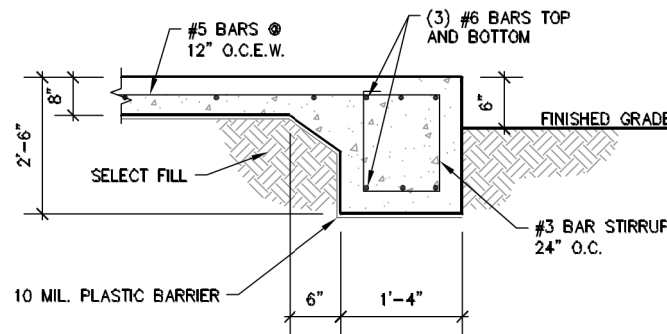

4
S2.0 **ODOR PAD EDGE BEAM**

RECORD DRAWING
TO THE BEST OF OUR KNOWLEDGE PERKINS ENGINEERING CONSULTANTS, INC., HEREBY STATES THAT THIS PLAN IS AS-BUILT. THIS INFORMATION PROVIDED IS BASED ON SURVEYING AT THE SITE AND INFORMATION PROVIDED BY THE CONTRACTOR.
Justin A. Angel
JUSTIN A. ANGEL, P.E. DATE 10/20/2022
TEXAS NO. 129386

GENERAL NOTES:

1. Concrete f'c = 3600 psi at 28 days
2. Provide 48" x bar diameter min. lap splice length.
3. All reinforcing steel be grade 60, unless otherwise specified.
4. Provide 2" reinforcement clear cover u.n.o.
5. Refer to sheet E-3 for generator information.



JAKAN ENGINEERING, PLLC
Texas Registered
Engineering Firm F-13414



NO.	DATE	DESCRIPTION	BY	SN
1	4/12/21	ADD ODOR PAD		

GENERATOR PAD PLAN

ENGINEERING CONCEPTS AND DESIGN

TIMBER CREEK LIFT STATION
EXPANSION


Date:	NOVEMBER 2019
Designed:	
Drawn:	
Reviewed:	
PEC Proj. No.	ECO 18-004
SEQ.	of

SHEET NO.
S-20




BAR IS ONE INCH IN LENGTH ON ORIGINAL DRAWING. CHECK SCALE AND ADJUST ACCORDINGLY.


ONE INCH

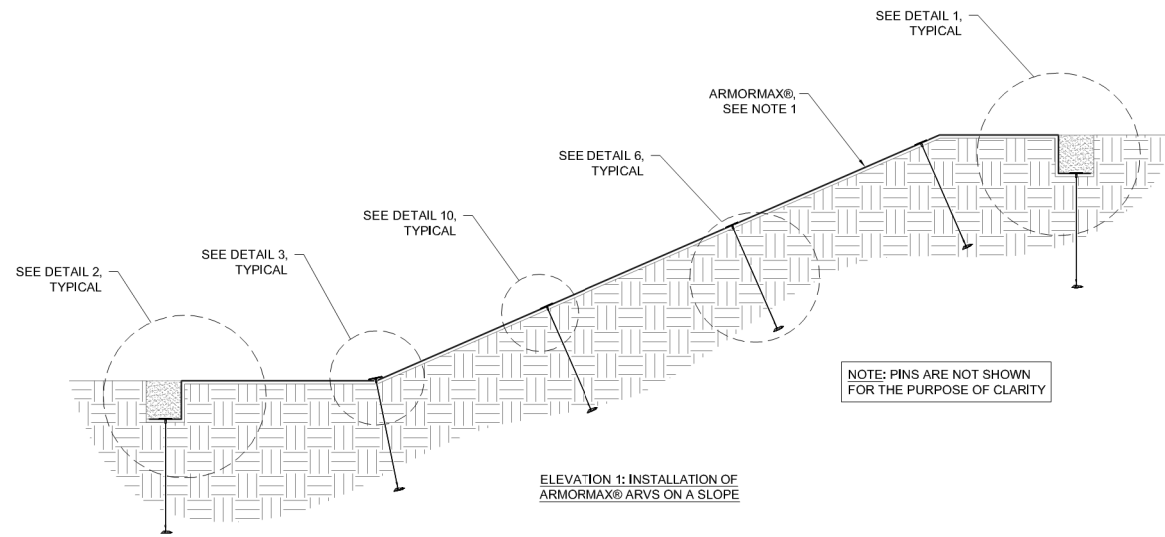


ELEVATION 1: INSTALLATION OF ARMORMAX® ARVS ON A SLOPE

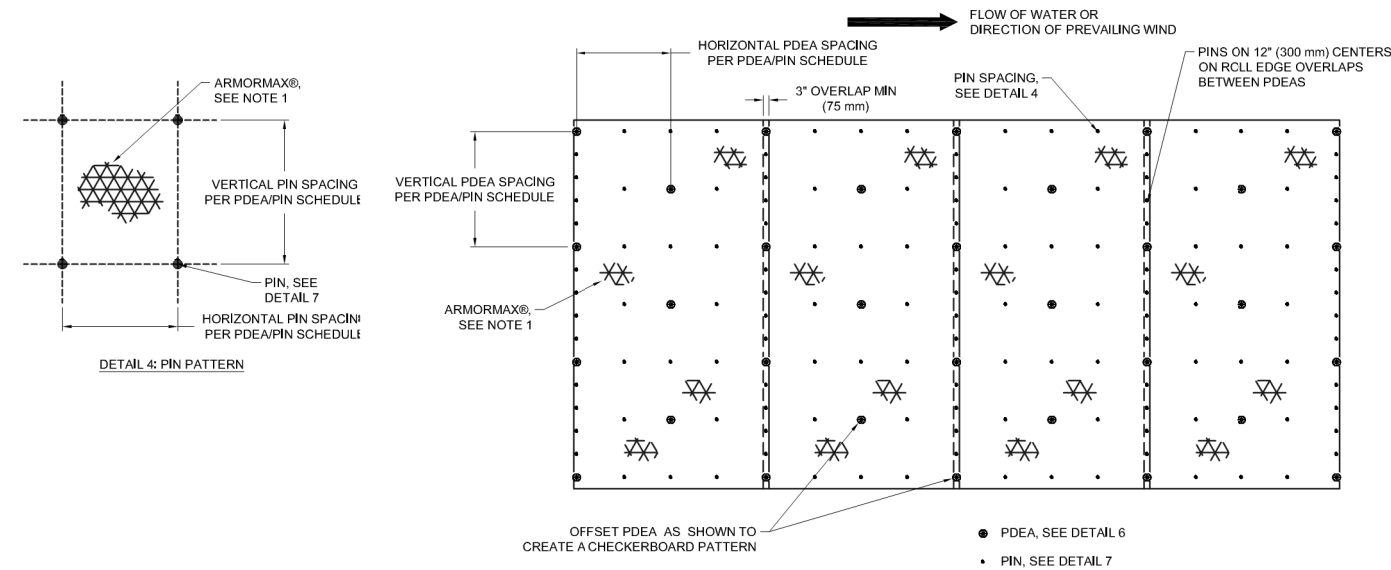


DETAIL 5: PDEA / PIN PATTERN

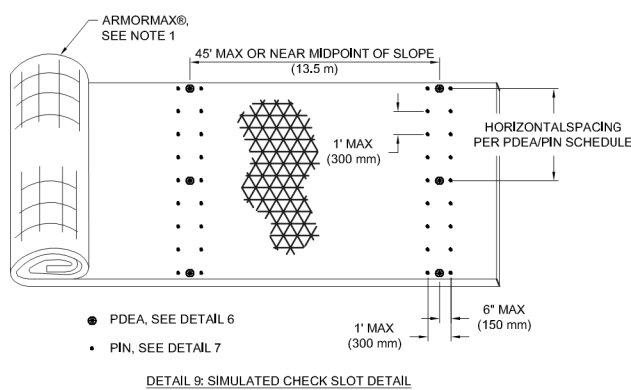


DETAIL 9: SIMULATED CHECK SLOT DETAIL

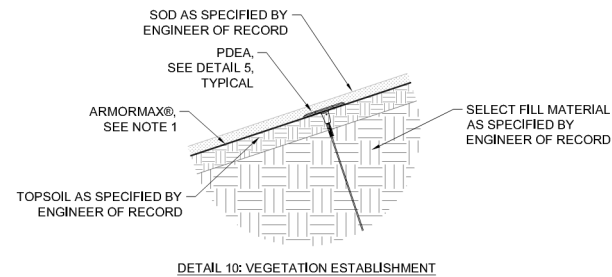


DETAIL 10: VEGETATION ESTABLISHMENT

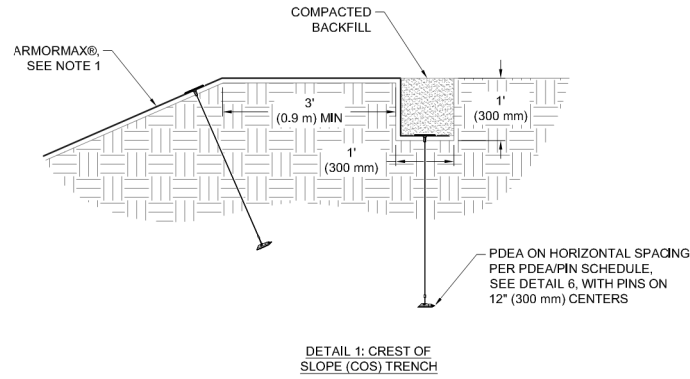


DETAIL 1: CREST OF SLOPE (COS) TRENCH

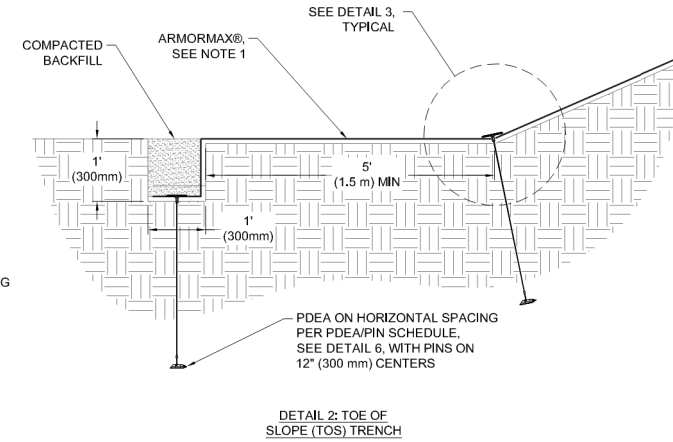


DETAIL 2: TOE OF SLOPE (TOS) TRENCH

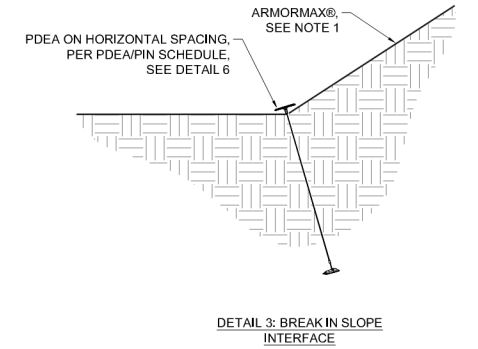


DETAIL 3: BREAK IN SLOPE INTERFACE

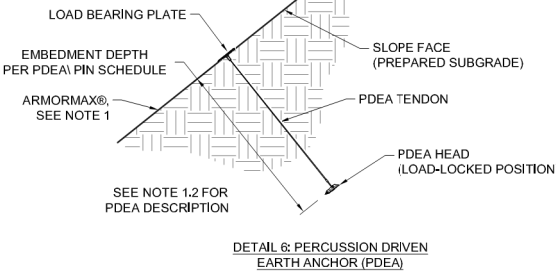

DETAIL 6: PERCUSSION DRIVEN EARTH ANCHOR (PDEA)

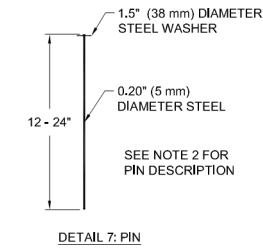

DETAIL 7: PIN

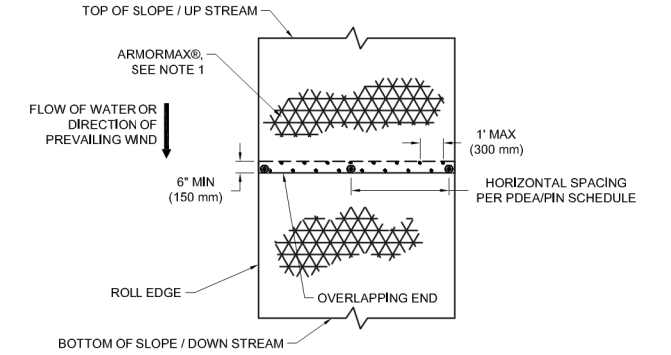

DETAIL 8: OVERLAP AT ROLL END DETAIL


ARMORMAX® ARVS ON A SLOPE FOR EROSION CONTROL (NON-STRUCTURAL APPLICATION) GENERAL INSTALLATION GUIDELINES

GENERAL NOTES

- The ArmorMax® Anchor Reinforced Vegetation System (ARVS) is an engineered solution used for permanent erosion protection or surficial slope stability in vegetated and unvegetated applications. It is composed of two components: Pyramat® High Performance Turf Reinforcement Mat (HPTRM) and Percussion Driven Earth Anchors (PDEAs). ArmorMax is available in green or tan to provide for an aesthetically pleasing solution with proven performance.
- 1.1. Pyramat HPTRM is a three-dimensional, lofty, woven polypropylene geotextile that is available in green or tan which is specially designed for erosion control applications on steep slopes and vegetated waterways. The matrix is composed of polypropylene monofilament yarns featuring X3® technology woven into a uniform configuration of resilient pyramid-like projections. The material exhibits very high interlock and reinforcement capacity with both soil and root systems, demonstrates superior UV resistance, and enhances seedling emergence.
- 1.2. The Type B1 PDEA model is used for permanent erosion protection applications and has a working load of up to 800 lbs. The Type B1 PDEA consists of a die cast aluminum anchor head, zinc-aluminum coated carbon steel cable, a die cast zinc load-locking mechanism with a ceramic roller, and two aluminum ferrules. The bullet nose design of the anchor head allows the PDEA to penetrate HPTRM resulting in minimal installation damage. The Type B1 PDEA is also designed with a recessed cavity so the top of the cable can be cut below the surface being protected.
2. The 12", 18", and 24" Securing Pins are composed of a wire, mushroomed at the top. A washer is then placed on the wire and the wire is crimped or swaged about 3-1/2" below the top so the washer will not slide off. The end of the wire is cut at a 45 degree angle for easy penetration of the soil. These Pins with washers conform to industry standards for erosion control pins with washers.
3. Landlok® S2 Erosion Control Blankets consist of 100% wheat straw mechanically bound and covered on both sides by netting. The straw is homogeneously blended and evenly distributed throughout the blanket. The netting is photodegradable polypropylene with mesh openings of approximately 3/8 in. by 3/8 in. (11 mm by 11 mm). The blanket is sewn on approximately 2 in. (51 mm) centers with photodegradable polypropylene thread. This product is NTPPEP approved for AASHTO standards.

BEFORE INSTALLATION BEGINS

- Coordinate with a Propex Representative: A pre-construction meeting is suggested with the construction team and a representative from Propex. This meeting should be scheduled by the contractor with at least a two week notice.
- Gather the Tools Needed: Tools that you will need to install ArmorMax include a pair of industrial shears to cut Pyramat, tape measure, percussion hammer (sized appropriately for the PDEAs), ground rod driver compatible with the percussion hammer, drive steel compatible with the PDEA, setting tool to set and load-lock the PDEA, and wire cutters to cut the cable tendon of the PDEA. If PDEAs will be load tested during construction, additional testing equipment may be necessary. Consult the "Anchor Load Test Manual" from Propex for further guidance. Available for purchase from Propex are drive steel, setting tools, and wire cutters.
- Determine how to Establish Vegetation: The method of vegetation establishment should be determined prior to the start of installation. Different vegetation establishment methods require different orders of installation. Refer to Establish Vegetation for further guidance.
- Please consult the Propex Website for the most up to date installation guidelines.

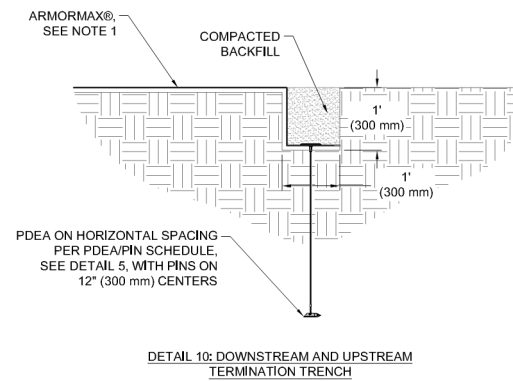

DETAIL 10: DOWNSTREAM AND UPSTREAM TERMINATION TRENCH

PDEA/PIN SCHEDULE		
SECURING DEVICE	PDEA	PIN
HORIZONTAL PDEA SPACING	4' (1.20 m)	2' (0.60 m)
VERTICAL PDEA SPACING	5' (1.50 m)	2.5' (0.75 m)
EMBEDMENT DEPTH	3' (0.90 m)	12" (300 mm)

EROSION CONTROL INSTALLATION DETAILS

Please note that the information presented herein is general information only. It is for conceptual use only and not intended to be used for construction. While every effort has been made to ensure its accuracy, this information should not be used for a specific application without independent professional examination and verification of its suitability, applicability, and accuracy. This engineering drawing is protected by the Copyright Act, 17 U.S.C. §101 et seq. and may be used ONLY with the express written permission of Propex in connection with Propex products. Any copying, distributing, and/or creation of a derivative work without permission of Propex is prohibited and is subject of actual damages, statutory damages and attorney's fees under the Copyright Act.

1 of 1

ARMORMAX® BY PROPEx

ANCHOR REINFORCED VEGETATED SYSTEM (ARVS) ARMORMAX® INSTALLATION DETAILS FOR SLOPES

Date: 06/09/2015 Drawn By: N. Hammarl Scale: NTS *ALL DIMENSIONS ARE TO BE VERIFIED BY ENGINEER OF RECORD

RECORD DRAWING

TO THE BEST OF OUR KNOWLEDGE PERKINS ENGINEERING CONSULTANTS, INC., HEREBY STATES THAT THIS PLAN IS AS-BUILT. THIS INFORMATION PROVIDED IS BASED ON SURVEYING AT THE SITE AND INFORMATION PROVIDED BY THE CONTRACTOR.

Justin A. Angel

JUSTIN A. ANGEL, P.E. TEXAS NO. 129386

10/20/2022 DATE

S-3.0

Propex™ Geotextile Systems

© 2015 Propex Operating Company, LLC

ELECTRICAL SYMBOLS				SWITCHGEAR / MCC SYMBOLS																				
SYMBOL	DESCRIPTION	SYMBOL	DESCRIPTION	SYMBOL	DESCRIPTION	SYMBOL	DESCRIPTION																	
	BRANCH CIRCUIT PANEL BOARD		JUNCTION BOX		FLOW SWITCH		TRANSFORMER DIFFERENTIAL PROTECTIVE RELAY																	
	CONTROL PANEL		THERMOSTAT		LIMIT SWITCH		AMMETER																	
	TELEPHONE TERMINAL BOARD		TELEPHONE/DATA OUTLET		PRESSURE SWITCH		SWITCH BREAKER																	
	TERMINAL BOARD		INSTRUMENT		TEMPERATURE SWITCH OR THERMOSTAT		CONTROL SWITCH																	
	CONDUIT WITH WIRE HOT		GROUND TEST WELL, REFER TO STANDARD DETAIL		VACUUM SWITCH		ELECTRICAL INTERLOCK																	
	CONDUIT WITH WIRE NEUTRAL		COPPERCLAD GROUND ROD		LOCKOUT STOP PUSH-BUTTON		ELAPSED TIME METER																	
	CONDUIT WITH WIRE SWITCH LEG		GROUNDING PAD		NORMALLY OPEN DELAY ON MAKE		KEY INTERLOCK																	
	CONDUIT WITH WIRE GROUND		CIRCUIT BREAKER - THERMAL MAGNETIC 3 POLE UNLESS INDICATED OTHERWISE CONTINUOUS AMP TRIP SETTING INDICATED		NORMALLY CLOSE DELAY ON MAKE		POWER FACTOR METER																	
	CONCEALED CONDUIT OR UG CONDUIT		DRAWOUT AIR CIRCUIT BREAKER LOW VOLTAGE, FRAME SIZE AND TRIP SETTING INDICATED		NORMALLY CLOSE DELAY ON BREAK		RPM METER																	
	EXPOSED CONDUIT		DRAWOUT AIR OR VACUUM CIRCUIT BREAKER, (VCB) MEDIUM VOLTAGE, FRAME SIZE INDICATED		NORMALLY OPEN DELAY ON BREAK		SOLID STATE TRIP																	
	GROUND MAT		LIGHTNING AND SURGE ARRESTOR		MEDIUM VOLTAGE VACUUM INTERRUPTER	ELECTRICAL ABBREVIATIONS																		
	CONDUIT - UP		FUSE, (ONE LINE DIAGRAM OR SCHEMATIC)		CONTACT - NORMALLY OPEN	A	AMPERAGE																	
	CONDUIT - DOWN		CAPACITOR - KVAR INDICATED		CONTACT - NORMALLY CLOSED	AC	ALTERNATING CURRENT																	
	CONDUIT - STUBBED AND CAPPED		GROUND, (ONE LINE DIAGRAM OR SCHEMATIC)		THERMAL OVERLOAD RELAY	ACU	AIR CONDITIONING UNIT																	
	SOUND SYSTEM WIRING RUN		CONTROL POWER TRANSFORMER - VOLTAGES INDICATED		TERMINALS FOR FIELD OR REMOTE WIRING CONNECTIONS. DEVICES LOCATED BETWEEN THESE SYMBOLS ARE LOCATED IN THE FIELD OR REMOTELY.	AIT	ANALYZER INDICATING TRANSMITTER																	
	OVERHEAD ELECTRIC LINES		SHIELDED ISOLATED TRANSFORMER VOLTAGES AND RATING INDICATED		MOTOR OR STARTER ENCLOSURE	AJB	ANALOG JUNCTION BOX																	
	CONDUIT FOR TELEPHONE, 3/4" UNLESS OTHERWISE INDICATED		WINDOW CURRENT TRANSFORMER ENCLOSING ALL CONDUCTORS		SPACE HEATER (ONE LINE DIAGRAM OR SCHEMATIC)	AM	ANMETER																	
	ABANDON CONDUIT & REMOVE CONDUCTORS		CABLE TRAY, LADDER TYPE, WIDTH AS INDICATED		EXPLOSION PROOF	ANN	ANNUNCIATOR																	
	HOME RUN, LP INDICATES PANEL LP, 1,3 INDICATES CIRCUITS 1 & 3.		AUTOMATIC TRANSFER SWITCH		ELAPSED TIME METER	ANSI	AMERICAN NATIONAL STANDARD INSTITUTE																	
	HOME RUN (208/1PH, 480V/1PH OR 3PH), DP INDICATES PANEL DP-1/3 INDICATES (2) POLE BKR, CKTS 1 & 3		ELECTRICAL SERVICE METER		EMERGENCY STOP	ATS	AUTOMATIC TRANSFER SWITCH																	
	HOME RUN (208/1PH, 480V/1PH OR 3PH), DP-1/3/5 INDICATES (3) POLE BKR, CKTS 1, 3, & 5		CONTROL STATION		MOTOR OPERATED	AUTO	AUTOMATIC																	
	CABLE IDENTIFICATION TAG		PUSH-BUTTON SWITCH, MOMENTARY CONTACT, NORMALLY OPEN		LEGEND: MODIFIED OR DEMOLISHED	AUX	AUXILIARY																	
	INST./CONTROL CABLE IDENTIFICATION TAG		PUSH-BUTTON SWITCH, MOMENTARY CONTACT, NORMALLY CLOSED		LEGEND: PROPOSED	B	BELL																	
	NAMEPLATE OR LEGEND PLATE, SEE SCH.		PUSHBUTTON SWITCH, MAINTAINED CONTACTS, WITH MECHANICAL INTERLOCK		LEGEND: EXISTING	BFM	BLOWER FILTER MOTOR																	
	INSTRUMENT TAG NUMBER		SELECTOR SWITCH-MAINTAINED CONTACT. CHART DEFINES OPERATION:			BYZ	WINDOW CURRENT TRANSFORMER																	
	NOTE ON SHEET, NO. AS INDICATED	<table border="1"> <thead> <tr> <th rowspan="2">POLE</th> <th colspan="3">POSITION</th> <th rowspan="2">X = CLOSED CONTACT O = OPEN CONTACT</th> </tr> <tr> <th>LOCAL</th> <th>OFF</th> <th>REMOTE</th> </tr> </thead> <tbody> <tr> <td>1</td> <td>X</td> <td>O</td> <td>O</td> <td></td> </tr> <tr> <td>2</td> <td>O</td> <td>O</td> <td>X</td> <td></td> </tr> </tbody> </table>	POLE	POSITION			X = CLOSED CONTACT O = OPEN CONTACT	LOCAL	OFF	REMOTE	1	X	O	O		2	O	O	X				C,COND	CONDUIT
POLE	POSITION			X = CLOSED CONTACT O = OPEN CONTACT																				
	LOCAL	OFF	REMOTE																					
1	X	O	O																					
2	O	O	X																					
	LUMINAIRE, TYPE AS NOTED		PANELBOARD			CB	CIRCUIT BREAKER																	
	LUMINAIRE, TYPE AS NOTED		NON FUSED DISCONNECT			CC	CONTROL CABLE																	
	LUMINAIRE AND POLE, TYPE AS NOTED		FUSED DISCONNECT			C/C	CENTER TO CENTER																	
	WALL MOUNTED LUMINAIRE, TYPE AS NOTED		LOCAL COMBINATION (IN FIELD) MAGNETIC STARTER WITH THERMAL OVERLOAD			CHH	COMMUNICATIONS HAND HOLE																	
	FLOODLIGHTS AIM IN DIRECTION SHOWN					CJB	CONTROL JUNCTION BOX																	
	EXIT SIGN					CKT	CIRCUIT																	
	EXIT/EMERGENCY COMBO					CS	CONTROL SWITCH																	
	EMERGENCY LIGHTING UNIT					CT	CURRENT TRANSFORMER																	
	LIGHT SWITCH, '3' INDICATES 3-WAY SWITCH					CTRL	CONTROL																	
	MOTORIZED SWITCH					CU	CONDENSING UNIT																	
	MANUFACTURER SUPPLIED PACKAGE INCLUDES LOCAL COMBINATION STARTER, MOTOR AND CONTROL PANEL. NUMBER INDICATES HORSE POWER					DC	DIRECT CURRENT																	
	MOTOR, SQUIRREL CAGE INDUCTION HORSEPOWER INDICATED ON ONE LINE, NUMBER INDICATES HORSEPOWER					DF	DRINKING FOUNTAIN																	
	CONVENIENCE RECEPTACLE-DUPLEX UNLESS SPECIFIED OTHERWISE					DFR	DIFFERENTIAL RELAY																	
	C = CLOCK HANGER					DS	DISCONNECT SWITCH																	
	CR = CORROSION RESISTANT					DTL	DETAIL																	
	EWC = WATER COOLER					EC	EMPTY CONDUIT																	
	TL = TWIST LOCK					EF	EXHAUST FAN																	
	WP = WEATHERPROOF					EHH	ELECTRIC HAND HOLE																	
	GFCI = GROUND FAULT CIRCUIT INTERRUPTER					EXIST.	EXISTING																	
	RECEPTACLE - 240V/1PH OR 208V/1PH					EP	EXPLOSION PROOF																	
	MULTI-OUTLET ASSEMBLY					ETM	ELAPSED TIME METER																	
	RECEPTACLE - 480V/3PH OR 208V/3PH					E-STOP	EMERGENCY STOP																	
						F	FORWARD																	
						FCV	FLOW CONTROL VALVE																	
						FIT	FLOW INDICATING TRANSMITTER																	
						FT	FLOW TRANSMITTER																	
						FLA	FULL LOAD AMPERE																	
						FLUO	FLUORESCENT																	
						FMR	FEEDER MANAGEMENT RELAY																	
						FO	FIBER OPTIC																	
						FQI	FLOW INTEGRATED TOTALIZER																	
						FU	FUSE																	
						FVNR	FULL VOLTAGE NON-REVERSING																	
						FVR	FULL VOLTAGE REVERSING																	
						GALV	GALVANIZED																	
						GEN	GENERATOR																	
						GFCI	GROUND FAULT CIRCUIT INTERRUPTER																	
						G,GND	GROUND																	
						HH	HAND HOLE																	
						HOA	HAND OFF AUTOMATIC																	
						HS	HAND SWITCH																	
						HV	HIGH VOLTAGE																	
						IC	INTERRUPTING CAPACITY																	
						IGV	INLET GUIDE VANE																	
						INCAND	INCANDESCENT																	
						INST	INSTANTANEOUS																	
						INB	INBOARD																	
						JB	JUNCTION BOX																	
						K	KEY INTERLOCK																	
						KS	INTERLOCK KEY SWITCH																	
						KVA	KILOVOLT-AMPERE																	
						KW	KILOWATT																	
						L, LP	LIGHTING PANEL																	
						LA	LIGHTNING ARRESTOR																	
						LC	LIGHTING CONTACTOR																	
						LCP	LOCAL CONTROL PANEL																	
						LE	LEVEL ELEMENT																	
						LIT	LEVEL INDICATING TRANSMITTER																	
						LLO	LOW LEVEL LOCKOUT																	
						LO	LOCKOUT																	
						LPU	LOCAL PROCESSING UNIT																	
						LR	LATCH RELAY																	
						LRC	LOCKED ROTOR CURRENT																	
						LMS	LIMIT SWITCH																	
						LS	LEVEL SWITCH																	
						LSC	LIMIT SWITCH VALVE CLOSE																	
						LSH	LEVEL HIGH SWITCH																	
						LSL	LEVEL LOW SWITCH																	
						LSO	LIMIT SWITCH VALVE OPEN																	
						LTG	LIGHTING																	
						LV	LOW VOLTAGE																	
						MCC	MOTOR CONTROL CENTER																	
						MGB	MASTER GROUND BAR																	
						MJB	MOTOR JUNCTION BOX																	
						MOV	MOTOR OPERATED VALVE																	
						MRP	MOTOR RELAY PROTECTION																	
						MAINT.	MAINTAINED																	
						MCP	MOTOR CIRCUIT PROTECTOR																	
						MCB	MAIN CIRCUIT BREAKER																	
						N	NEUTRAL GROUNDED CONDUCTOR																	
						NA	NON-AUTOMATIC																	
						NC	NORMALLY CLOSED																	
						NF	NON-FUSED																	
						NO	NORMALLY OPEN																	
						OB	OUTBOARD																	
						OC	OVERCURRENT																	
						OHD	OVERHEAD DOOR																	
						OL	OVERLOAD																	
						OPDU	OVERALL POWER DISTRIBUTION UNIT																	
						OV	OVERVOLTAGE																	
						PB	PUSHBUTTON																	
						PB	PULLBOX																	
						PBR	PUMP-BEARING RELAY																	
						PC	PHOTOCELL																	
						PC	PERSONAL COMPUTER																	
						PH	PHASE																	
						PLC	PROGRAMMABLE LOGIC CONTROLLER																	
						PMT	PAD MOUNTED TRANSFORMER																	
						PMGR	PAD MOUNTED SWITCHGEAR																	
						PP	POWER PANEL																	
						PR	PRESETTING RELAY (TIMER)																	
						PSI	POUNDS PER SQUARE INCH																	
						PT	POTENTIAL TRANSFORMER																	
						PTT	PUSH TO TEST																	
						PVC	POLYVINYL CHLORIDE																	
						PWR	POWER																	
						R	RELAY																	
						REV	REVERSE																	
						REQD	REQUIRED																	
						RGS	RIGID GALVANIZED STEEL																	
						RLY	RELAY																	
						RS	RIGID STEEL																	
						RVNR	REDUCED VOLTAGE NON-REVERSING																	
						RVR	REDUCE VOLTAGE REVERSING																	
						RVSS	REDUCE VOLTAGE SOLID STATE																	
						RTD	RESISTANCE TEMP DETECTORS																	
						RTU	REMOTE TERMINAL UNIT																	
						S, SV	SOLENOID VALVE																	
						SC	SHORT CIRCUIT																	
						SCADA	CONTROL AND DATA ACQUISITION																	
						SCU	SPEED CONTROL UNIT SUPPLY																	
						SF	FAN																	
						SPD	SURGE PROTECTIVE DEVICE																	
						SRV	SURGE RELIEF VALVE																	
						SS	STAINLESS STEEL																	
						SW	NETWORK SWITCH																	
						SWG	SWITCHGEAR																	
						SWT	SWITCH																	
						T	THERMOSTAT																	
						TB	TERMINAL BOX																	
						TD	TIME DELAY																	
						TDC	TIME DELAY CLOSING																	
						TDE	TIME DELAY ENERGIZED																	
						TDO	TIME DELAY OPENING																	
						TJB	TERMINAL JUNCTION BOX																	
						TP	TWISTED PAIR																	
						TSP	TWISTED SHIELDED PAIR																	
						TVSS	TRANSIENT VOLTAGE SURGE SUPPRESSOR																	
						UG	UNDERGROUND																	
						UH	UNIT HEATER																	
						UPS	UNINTERRUPTIBLE POWER SUPPLY																	
						UV	UNDERVOLTAGE																	
						V	VOLT																	
						VCR	VALVE CLOSE RELAY																	
						VFD	VARIABLE FREQUENCY DRIVE																	
						VM	VOLTMETER																	
						VP	VAPOR PROOF																	
						VOR	VALVE OPEN RELAY																	
						W	WIRE																	
						WHD	WATT HOUR DEMAND METER																	
						WP	WEATHER PROOF																	
						XFMR	TRANSFORMER																	

PERKINS ENGINEERING CONSULTANTS, INC.
TBPCE REGISTRATION NO. F-8699

ENGINEERING CONCEPTS AND DESIGN

TIMBER CREEK LIFT STATION EXPANSION

DATE: NOVEMBER 2019

DESIGNED: JAA

DRAWN: SRG

PRINTED: 5/14/2021 2:50 PM \\LKC-ES\Projects\PEC1802_Rockwall Lift Station - Timber Creek Drawings\Electrical\2- GENERAL NOTES.dwg SANED: 4/16/2020 4:41 PM USER: LUC

LIFT STATION NOTES:

GENERAL:

- ALL WORK SHALL BE PERFORMED BY A LICENSED ELECTRICIAN IN THE STATE OF TEXAS.
- ALL CONDUITS MUST BE RUN PLUMB AND SHALL NOT HAVE LOOSE CONNECTIONS.
- ALL WIRING SHALL BE XHHW INSULATION WITH STRANDED COPPER CONDUCTORS.
- ALL ABOVE GRADE CONDUIT SHALL BE RIGID ALUMINUM.
- ALL BELOW GRADE CONDUITS SHALL BE RIGID SCHEDULE 80 PVC WITH PVC COATED STEEL ELBOWS. ELBOWS MUST BE LONG SWEEP ELBOWS.
- ENCLOSURES SHALL BE NEMA 4X, 316 STAINLESS STEEL UNLESS SPECIFICALLY NOTED OTHERWISE.
- ELECTRICAL INSTALLATION MUST BE PER NATIONAL ELECTRIC CODE AS AMENDED BY THE AUTHORITY HAVING JURISDICTION.
- PROVIDE FREE STANDING PUMP CONTROL PANEL WITH PHYSICAL SEPERATION OF POWER AND CONTROL SECTIONS.
- THE CONTROL SYSTEM SHALL BE DESIGNED TO OPERATE THE REQUIRED NUMBER OF PUMPS SPECIFIED ON THE DRAWING AT THE POWER CHARACTERISTICS SHOWN ON THE PLANS. THE CONTROL FUNCTION SHALL PROVIDE FOR THE OPERATION OF THE PUMPS IN HAND (MANUAL) AND AUTO (CONTROLLED BY PLC). SEE "24VAC REGULATOR SYSTEM" FOR FURTHER INFORMATION. THE CONTROL SHALL FUNCTION AS DESCRIBED BELOW. THE EQUIPMENT LISTED BELOW IS A GUIDE AND DOES NOT RELIEVE THE SUPPLIER FROM PROVIDING A SYSTEM THAT WILL FUNCTION AS REQUIRED.
- ENCLOSURE: THE ENCLOSURE SHALL BE A NEMA 4X RATED STAINLESS STEEL. THE ENCLOSURE SHALL BE A WALL MOUNT TYPE WITH A MINIMUM DEPTH OF 8" SIZED TO ADEQUATELY HOUSE ALL THE COMPONENTS. THE DOOR GASKET SHALL BE RUBBER COMPOSITION WITH A RETAINER TO ASSURE A POSITIVE WEATHERPROOF SEAL. THE DOOR SHALL OPERATE WITH A SINGLE ACTION HANDLE THAT ACCEPTS A 3/8" SHAFT PADLOCK AND OPENS A MINIMUM OF 180 DEGREES.
- INNER DEAD FRONT DOOR: A POLISHED ALUMINUM DEAD FRONT SHALL BE MOUNTED ON A CONTINUOUS AIRCRAFT TYPE HINGE, CONTAIN CUTOUPS FOR MOUNTED EQUIPMENT, AND PROVIDE PROTECTION OF PERSONNEL FROM LIVE INTERNAL WIRING. CUTOUPS FOR BREAKER HANDLES SHALL BE PROVIDED TO ALLOW OPERATION OF BREAKERS WITHOUT ENTERING THE COMPARTMENT. NO DOOR MOUNTED OPERATING MECHANISMS ALLOWED FOR BREAKER OPERATION. ALL CONTROL SWITCHES, INDICATOR PILOT LIGHTS, ONE GENERAL PURPOSE GFI DUPLEX RECEPTACLE AND OTHER OPERATIONAL DEVICES SHALL BE MOUNTED ON THE EXTERNAL SURFACE OF THE DEAD FRONT. THE DEAD FRONT SHALL OPEN A MINIMUM OF 150 DEGREES TO ALLOW ACCESS TO EQUIPMENT FOR MAINTENANCE. A 3/4" BREAK SHALL BE FORMED AROUND THE PERIMETER OF THE DEAD FRONT TO PROVIDE RIGIDITY.
- BACK PLATE: THE BACK PLATE SHALL BE MANUFACTURED OF 12-GAUGE SHEET STEEL AND BE FINISHED WITH A PRIMER COAT AND TWO (2) COATS OF BAKED ON WHITE ENAMEL. ALL DEVICES SHALL BE PERMANENTLY IDENTIFIED.
- POWER DISTRIBUTION: THE PANEL POWER DISTRIBUTION SHALL INCLUDE ALL NECESSARY COMPONENTS AND BE WIRED WITH STRANDED COPPER CONDUCTORS RATED AT A MINIMUM OF 90 DEGREES C.
- CIRCUIT BREAKERS: ALL CIRCUIT BREAKERS SHALL BE HEAVY-DUTY THERMAL MAGNETIC OR MOTOR CIRCUIT PROTECTORS SIMILAR AND EQUAL TO SQUARE D TYPE FAL. EACH MOTOR BREAKER SHALL BE ADEQUATELY SIZED TO MEET THE PUMP MOTOR OPERATING CHARACTERISTICS AND SHALL HAVE A MINIMUM OF 10,000 AMPS INTERRUPTING CAPACITY FOR 230 VAC AND 14,000 AMPS AT 480 VAC. THE CONTROL CIRCUIT AND THE DUPLEX RECEPTACLES SHALL BE INDIVIDUALLY CONTROLLED BY HEAVY-DUTY BREAKERS. CIRCUIT BREAKERS SHALL BE INDICATING TYPE, PROVIDING "ON-OFF-TRIP" POSITIONS OF THE OPERATING HANDLE. WHEN THE BREAKER IS TRIPPED AUTOMATICALLY, THE HANDLE SHALL ASSUME A MIDDLE POSITION INDICATING "TRIP". THERMAL MAGNETIC BREAKERS SHALL BE QUICK-MADE AND QUICK-BREAK ON BOTH MANUAL AND AUTOMATIC OPERATION AND HAVE INVERSE TIME CHARACTERISTICS SECURED THROUGH THE USE OF BIMETALLIC TRIPPING ELEMENTS SUPPLEMENTED BY A MAGNETIC TRIP. BREAKERS SHALL BE DESIGNED SO THAT AN OVERLOAD ON ONE POLE AUTOMATICALLY TRIPS AND OPENS ALL LEGS. FIELD INSTALLED HANDLED TIES SHALL NOT BE ACCEPTABLE.
- MOTOR STARTERS: MOTOR STARTERS SHALL BE OPEN FRAME, ACROSS THE LINE; NEMA RATED WITH INDIVIDUAL OVERLOAD PROTECTION IN EACH LEG. MOTOR STARTER CONTACT AND COIL SHALL BE REPLACEABLE FROM THE FRONT OF THE STARTER WITHOUT BEING REMOVED FROM ITS MOUNTED POSITION. OVERLOAD HEATERS SHALL BE SOLID STATE MOTOR LOGIC TYPE WITH THE FOLLOWING FEATURES: 3 TO 1 ADJUSTMENT FOR TRIP CURRENT, PHASE LOSS AND UNBALANCE PROTECTION, LED POWER INDICATION, AMBIENT INSENSITIVE AND SELF-POWERED, AND SHALL HAVE AVAILABILITY OF ELECTRICAL REMOTE RESET. OVERLOADS SHALL BE SIZED FOR THE FULL LOAD AMPERAGE DRAW OF THE PUMPS. DEFINITE PURPOSE CONTACTORS, FRACTIONAL SIZE STARTERS AND HORSEPOWER RATED CONTACTORS OR RELAYS SHALL NOT BE ACCEPTABLE.
- TRANSFORMERS: CONTROL TRANSFORMERS SHALL PROVIDE THE 120 VAC AND/OR 24 VAC FOR CONTROL CIRCUITS. TRANSFORMERS SHALL BE FUSED ON THE PRIMARY AND SECONDARY CIRCUITS. THE SECONDARY SHALL BE GROUNDED.
- LIGHTNING-TRANSIENT PROTECTION: A LIGHTNING-TRANSIENT PROTECTOR WITH TELL-TALE WARNING LIGHTS ON EACH PHASE TO INDICATE LOSS OF PROTECTION ON THE INDIVIDUAL PHASES SHALL BE PROVIDED. THE DEVICE SHALL BE SOLID STATE WITH A RESPONSE TIME OF LESS THAN 5 NANoseconds WITHSTANDING SURGE CAPACITY OF 6500 AMPERES. UNIT SHALL BE INSTANT RECOVERY, LONG LIFE AND HAVE NO HOLD-OVER CURRENTS.

- PHASE MONITOR: A LINE VOLTAGE RATED, ADJUSTABLE PHASE MONITOR SHALL BE INSTALLED TO SENSE LOW VOLTAGE, LOSS OF POWER, REVERSED PHASING AND LOSS OF A PHASE. CONTROL CIRCUIT SHALL DE-ENERGIZE UPON SENSING ANY OF THE FAULTS AND SHALL AUTOMATICALLY RESTORE SERVICE UPON RETURN TO NORMAL POWER.
- ALARM SYSTEM: THE ALARM LIGHT SHALL BE A WEATHERPROOF, SHATTERPROOF, RED LIGHT FIXTURE WITH 500 LUMENS MINIMUM TO INDICATE ALARM CONDITIONS. THE ALARM LIGHT SHALL BE TURNED ON BY THE ALARM LEVEL. THE ALARM LIGHT SHALL BE MOUNTED ON THE EXTERIOR OF THE CABINET. THE ALARM HORN SHALL PROVIDE AN AUDIO SIGNAL OF NOT LESS THAN 90 DB AT 10 FEET. AN ALARM SILENCE SWITCH SHALL BE MOUNTED ON THE EXTERIOR OF THE CABINET AND DEACTIVATE THE ALARM HORN; HOWEVER, THE ALARM LIGHT SHALL FLASH UNTIL THE ALARM CONDITION CEASES TO EXIST. AN INPUT SHALL BE PROVIDED TO PLC TO INDICATE HIGH WET WELL CONDITION.
- 24 VAC REGULATOR SYSTEM:
GENERATOR:
1. SYSTEM SHALL BE EQUIPPED WITH AN EMERGENCY GENERATOR WITH AN AUTOMATIC TRANSFER SWITCH CAPABLE OF PROGRAMMABLE TEST DATES AND TIMES. INPUTS SHALL BE PROVIDED TO PLC TO INDICATE GENERATOR RUNNING, GENERATOR ALARM, AND GENERATOR LOW FUEL LEVEL OR A STAND ALONE MANUAL DOUBLE THROW SAFETY SWITCH TO ALLOW HARD WIRING TO A PORTABLE GENERATOR. NO DOOR MOUNTED OPERATING MECHANISMS ALLOWED FOR BREAKER OPERATION IN CONTROL PANEL. ALL CONDUCTOR TERMINATIONS SHALL BE AS RECOMMENDED BY THE DEVICE MANUFACTURER.
2. GENERATOR SHALL HAVE WEATHER PROOF SOUND ATTENUATING ENCLOSURE.
3. PROVIDE ENGINE BLOCK HEATER TO OPERATE ON 208V, SINGLE PHASE AND BATTERY CHARGER OPERATED FROM 120V SINGLE PHASE FOR THE GENERATOR.
4. GENERATOR MUST MEET EPA EMISSIONS REQUIREMENTS FOR STANDBY OPERATION.
5. GENERATOR MUST INCLUDE CIRCUIT BREAKER TO PROTECT THE ALTERNATOR. INSULATION LEVEL TO BE CLASS H.
6. ALTERNATOR SHALL HAVE COPPER WINDINGS AND PROVIDE 480/277V, WYE THREE-PHASE, FOUR-WIRE, 60 HERTZ.
7. MOUNTING FRAME SHALL BE INDEPENDENT OF CONCRETE FOUNDATION FOR SUPPORT.
8. PROVIDE VOLTAGE REGULATION FOR THE GENERATOR SET.
9. ENGINE SHALL RUN ON #2 DIESEL FUEL.
10. MUFFLER/SILENCER SHALL BE CRITICALLY RATED.
11. FUEL TANK SHALL BE DOUBLE WALLED COMPLIANT WITH EPA, AND SHALL INCLUDE A LOW FUEL LEVEL ALARM THAT WILL BE SENT TO SCADA. FUEL TANK WILL BE INTEGRAL TO THE GENERATOR.
SCADA:
1. CONTRACTOR MAY USE EXISTING ANTENNA FOR NEW TRANSMITTER
2. PLC SHALL BE MODICON M340.
3. EQUIPMENT FOR SCADA SHALL BE RLC CONTROLS PART# UM2-D32M-M6A CONSISTING OF A PLC, RADIO, ANTENNA, ETC. TO OPERATE THE SYSTEM. CONTROL CABINET COMPONENTS SHALL BE INSTALLED WHEN THE PANEL IS BUILT. ENGINEER SHALL CONTACT THE PUMP DEPARTMENT AT 972-771-7730 FOR CURRENT REQUIREMENTS FOR SCADA SYSTEM AND CONTACT FOR CITY'S CURRENT SCADA SUPPLIER. CONTACT PHONE NUMBER FOR RLC IS 972-542-7375 PROGRAMMING SHALL BE INCLUDED IN PURCHASE PRICE OF THE ABOVE PART BY RLC CONTROLS, USING SCHNEIDER ELECTRIC UNITY PLC PROGRAMMING SOFTWARE. CHECK WITH RLC CONTROLS TO VERIFY ALL NEEDED INPUTS AND OUTPUTS FOR PLC PROGRAMING.
4. THE CONTROL SYSTEM SHALL PROVIDE FOR BOTH AUTOMATIC AND MANUAL CONTROL AND ALTERNATION OF THE PUMPS TO MAINTAIN A PUMPED DOWN CONDITION OF THE WET WELL.
5. WET WELL LEVELS SHALL BE SENSED BY A PRESSURE TRANSDUCER. FLOAT REGULATORS SHALL BE INSTALLED AS BACK UP FOR HIGH AND LOW LEVELS ONLY. THE TRANSDUCER SHALL SENSE THE "OFF", "LEAD", "LAG", AND "HIGH" LEVELS AS GIVEN ON THE PLANS. AS THE LEVEL IN THE WET WELL RAISES THE LEAD PUMP, AS DETERMINED BY THE ALTERNATOR, SHALL START AND PUMP THE STATION TO THE "OFF" POSITION. IN THE EVENT THE INCOMING FLOW EXCEEDS THE CAPACITY OF THE LEAD PUMP, THE LAG PUMP SHALL START AND BOTH PUMPS SHALL RUN TO THE OFF LEVEL. IF THE WET WELL LEVEL CONTINUES TO RISE, HIGH WELL ALARM FUNCTIONS SHALL BE ACTIVATED. THE ALTERNATOR SHALL SWITCH WHEN THE OFF LEVEL IS REACHED. ALL INPUTS AND OUTPUTS SHALL BE WIRED TO A TERMINAL STRIP AT BOTTOM OF CABINET.
ANCILLARY EQUIPMENT:
1. HOA SWITCHES: A THREE POSITION HOA SWITCH SHALL BE PROVIDED ON THE INNER DEAD FRONT FOR EACH PUMP. INPUTS SHALL BE PROVIDED TO PLC TO INDICATE POSITION OF HOA.
2. RUN INDICATORS: A RUN PILOT INDICATOR SHALL BE PROVIDED ON THE INNER DEAD FRONT. ALL INDICATOR LIGHTS SHALL BE PUSH TO TEST. INPUTS SHALL BE PROVIDED TO PLC TO INDICATE PUMP RUNNING.
3. ELAPSED TIME: ELAPSE TIME METER SHALL BE MOUNTED ON THE DEAD FRONT DOOR.
4. CABINET TEMPERATURE CONTROL: THE CABINET SHALL BE EQUIPPED WITH A PANEL HEATER CONTROLLED BY A THERMOSTAT AND A VENT FAN CONTROLLED BY A THERMOSTAT.
5. RECEPTACLES: ONE DUPLEX RECEPTACLE LOCATED ON INNER DEAD FRONT DOOR FOR GENERAL PURPOSE USE. THIS RECEPTACLE SHALL BE OF THE GROUND FAULT TYPE, 120VOLT, AND PROTECTED BY A 20 AMP BREAKER. A SECOND SINGLE RECEPTACLE SHALL BE LOCATED ON THE BACK PANEL TO PROVIDE POWER FOR UPS BACK UP SYSTEM. THIS RECEPTACLE SHALL BE 120 VOLT AND PROTECTED BY A SEPARATE 20 AMP BREAKER.

- UPS BACK UP SYSTEM: WILL PROVIDED 120 VOLT POWER TO SCADA COMMUNICATION EQUIPMENT AND ALL LOW VOLTAGE POWER TRANSFORMERS. THIS MUST BE INSTALLED IN THE CONTROL PANEL. UPS SHALL BE APC 650VA 120 VOLT OR EQUIVALENT.
- THE SYSTEM MUST BE ABLE TO TRANSMIT ALL ALARMS AND WET WELL LEVELS WHEN ON BACKUP POWER.
- MOTOR PROTECTION: A CONTROL AND STATUS MODULE SHALL SENSE EITHER MOTOR OVER TEMPERATURE OR SEAL LEAKAGE, AND SHALL TURN OFF THE PUMP, LOCK OUT THE PUMP, AND SEND AN ALARM. INPUTS SHALL BE PROVIDED TO PLC TO INDICATE PUMP FAIL, SEAL FAIL AND TEMP FAIL INDIVIDUALLY FOR EACH PUMP.
MISCELLANEOUS:
1. PANEL RACKS: POSTS SUPPORTING RACKS SHALL BE 3" MINIMUM RIGID CONDUIT CAPPED AND BOLTED DIRECTLY TO CHANNEL FRAMEWORK SUPPORTING THE PANELS.
2. PANELS SHALL HAVE A "RAIN SHIELD" STRUCTURE USING 1/2" MINIMUM ALUMINUM PLATING PROVIDING A SOLID BACK PLATE BEHIND PANELS CONTINUOUS TO OVERHEAD PLATE TO PROTECT PANEL FROM RAIN. PROVIDE LED LIGHTING MOUNTED ON STRUCTURE WITH SWITCH MOUNTED ON EXTERIOR OF PANEL TO LIGHT UP PANEL AREA. CONTACT CITY OF ROCKWALL AT 972-771-7730 FOR LOCATION OF EXISTING TYPE STRUCTURE. EACH PUMP MUST HAVE ITS OWN CONDUIT FOR POWER CORD AND A SEPARATE CONDUIT FOR ALL FLOAT WIRES.
3. WET WELLS: WET WELL SHALL HAVE METAL SAFETY GRATES. ALL HATCHES SHALL HAVE ACCOMMODATIONS FOR LOCKING ABOVE GRADE WITH 3/8" SHAFT PADLOCKS PROVIDED BY THE CITY. CHECK VALVES SHALL BE OF THE SPRING TYPE. LEVEL CONTROL SYSTEM SHALL USE A PRESSURE TRANSDUCER WITH BUILT IN SURGE PROTECTION FOR PUMP OPERATION WITH OFF AND HIGH LEVEL FLOATS AS BACK-UP IN CASE TRANSDUCER FAILS.
4. DRAWINGS: CONTROL PANEL SCHEMATIC DRAWINGS SHALL BE SUBMITTED FOR APPROVAL WITH THE SUBMITTAL PLANS. FINAL CONTROL PANEL WIRE SCHEMATIC DRAWINGS INCLUDING A LIST OF ALL LEGENDS (2 SETS TOTAL) SHALL BE PROVIDED. ONE SET SHALL BE ENCAPSULATED IN MYLAR AND ATTACHED TO THE INSIDE OF THE FRONT DOOR OF THE CONTROL CABINET. A SECOND SET SHALL BE DELIVERED TO THE CITY OF ROCKWALL WASTEWATER DEPARTMENT.
5. PANEL MARKINGS: ALL COMPONENT PARTS IN THE CONTROL PANEL SHALL BE PERMANENTLY MARKED AND IDENTIFIED AS THEY ARE INDICATED ON THE DRAWING. MARKING SHALL BE ON THE BACK PLATE ADJACENT TO THE COMPONENT. ALL CONTROL CONDUCTORS SHALL BE IDENTIFIED WITH WIRE MARKERS AS CLOSE AS PRACTICAL TO EACH END OF CONDUCTORS.
6. PANEL WIRING: ALL WIRING IN PANEL SHALL MAINTAIN A MINIMUM OF 1/2" SPACING BETWEEN COMPONENTS AND WIRE WAYS.
7. TESTING: ALL PANELS SHALL BE TESTED TO THE POWER REQUIREMENTS AS SHOWN ON THE PLANS TO ASSURE PROPER OPERATION OF ALL THE COMPONENTS. EACH CONTROL FUNCTION SHALL BE ACTIVATED TO CHECK FOR PROPER OPERATION AND INDICATION.
8. GUARANTEE: ALL EQUIPMENT SHALL BE GUARANTEED FOR A PERIOD OF THREE (3) YEARS FROM DATE OF ACCEPTANCE. THE GUARANTEE IS EFFECTIVE AGAINST ALL DEFECTS IN WORKMANSHIP AND/OR DEFECTIVE COMPONENTS. THE WARRANTY IS LIMITED TO REPLACEMENT OR REPAIR OF THE DEFECTIVE EQUIPMENT.

RECORD DRAWING
TO THE BEST OF OUR KNOWLEDGE PERKINS ENGINEERING CONSULTANTS, INC., HEREBY STATES THAT THIS PLAN IS AS-BUILT. THIS INFORMATION PROVIDED IS BASED ON SURVEYING AT THE SITE AND INFORMATION PROVIDED BY THE CONTRACTOR.
Justin Angel 10/20/2022
JUSTIN A. ANGEL, P.E. DATE
TEXAS NO. 129386

RECORD DRAWING
THIS RECORD DRAWING IS A COMPILATION OF A COUP OF THE SEALED ENGINEERING DRAWINGS FOR THE PROJECT, MODIFIED BY ADDENDA, CHANGE ORDERS, AND INFORMATION FURNISHED BY THE CONTRACTOR AND OTHERS. THE INFORMATION SHOWN ON THE RECORD DRAWING THAT WAS PROVIDED BY THE CONTRACTOR OR OTHERS NOT ASSOCIATED WITH THE DESIGN ENGINEER CANNOT BE VERIFIED FOR ACCURACY OR COMPLETENESS. THE ORIGINALLY SEALED DOCUMENTS ARE ON FILE AT THE OFFICES OF:
LKC-ES ENGINEERING, INC.
13810 TBPE FIRM 13810
800 E. CAMPBELL RD, SUITE 270
RICHARDSON, TX 75081
972-677-7865

INPUT OUTPUT LIST	
POINT	DESCRIPTION
DI-01	LEVEL SWITCH LOW ALARM
DI-02	LOW LEVEL SWITCH LSL-01 ALL PUMPS OFF
DI-03	LEVEL SWITCH HIGH LSH-01 RUN 1 PUMP
DI-04	LEVEL SWITCH HIGH LSH-02 RUN 2 PUMPS
DI-05	LEVEL SWITCH HIGH LSH-03 HIGH LEVEL ALARM
DI-06	PUMP 1 FAIL
DI-07	PUMP 1 RUNNING
DI-08	REMOTE ENABLED
DI-09	PUMP 2 FAIL
DI-10	PUMP 2 RUNNING
DI-11	REMOTE-HAND
DI-12	GENERATOR FAIL
DI-13	GENERATOR LOW FUEL
DI-14	SOURCE UTILITY POWER
DI-15	SOURCE BACKUP POWER
DI-16	INTRUSION SWITCH
DI-17	UPS ON BACKUP POWER
DO-01	PUMP 1 RUN
DO-02	PUMP 2 RUN
AI-01	WET WELL LEVEL LIT-01

BAR IS ONE INCH IN LENGTH ON ORIGINAL DRAWING. CHECK SCALE AND ADJUST ACCORDINGLY.

ONE INCH



PERKINS ENGINEERING CONSULTANTS, INC.
TBPE REGISTRATION NO. F-8699



NO.	DATE	DESCRIPTION	BY	
			DATE	DESCRIPTION


ELECTRICAL
GENERAL NOTES

ENGINEERING CONCEPTS AND DESIGN
TIMBER CREEK LIFT STATION EXPANSION

Date:	NOVEMBER 2019	JAA	SRG	MAP	PEC Proj. No. ECD 18-004	of
Designed:						
Drawn:						
Reviewed:						
SEC.						

SHEET NO. E-2

PRINTED: 5/14/2021 2:50 PM \\LKC-ES\Projects\PEC1802_Rockwall Lift Station - Timber Creek Drawings\Electrical\E-3 SITE PLAN.dwg SANED: 5/14/2021 2:49 PM USER: LJC

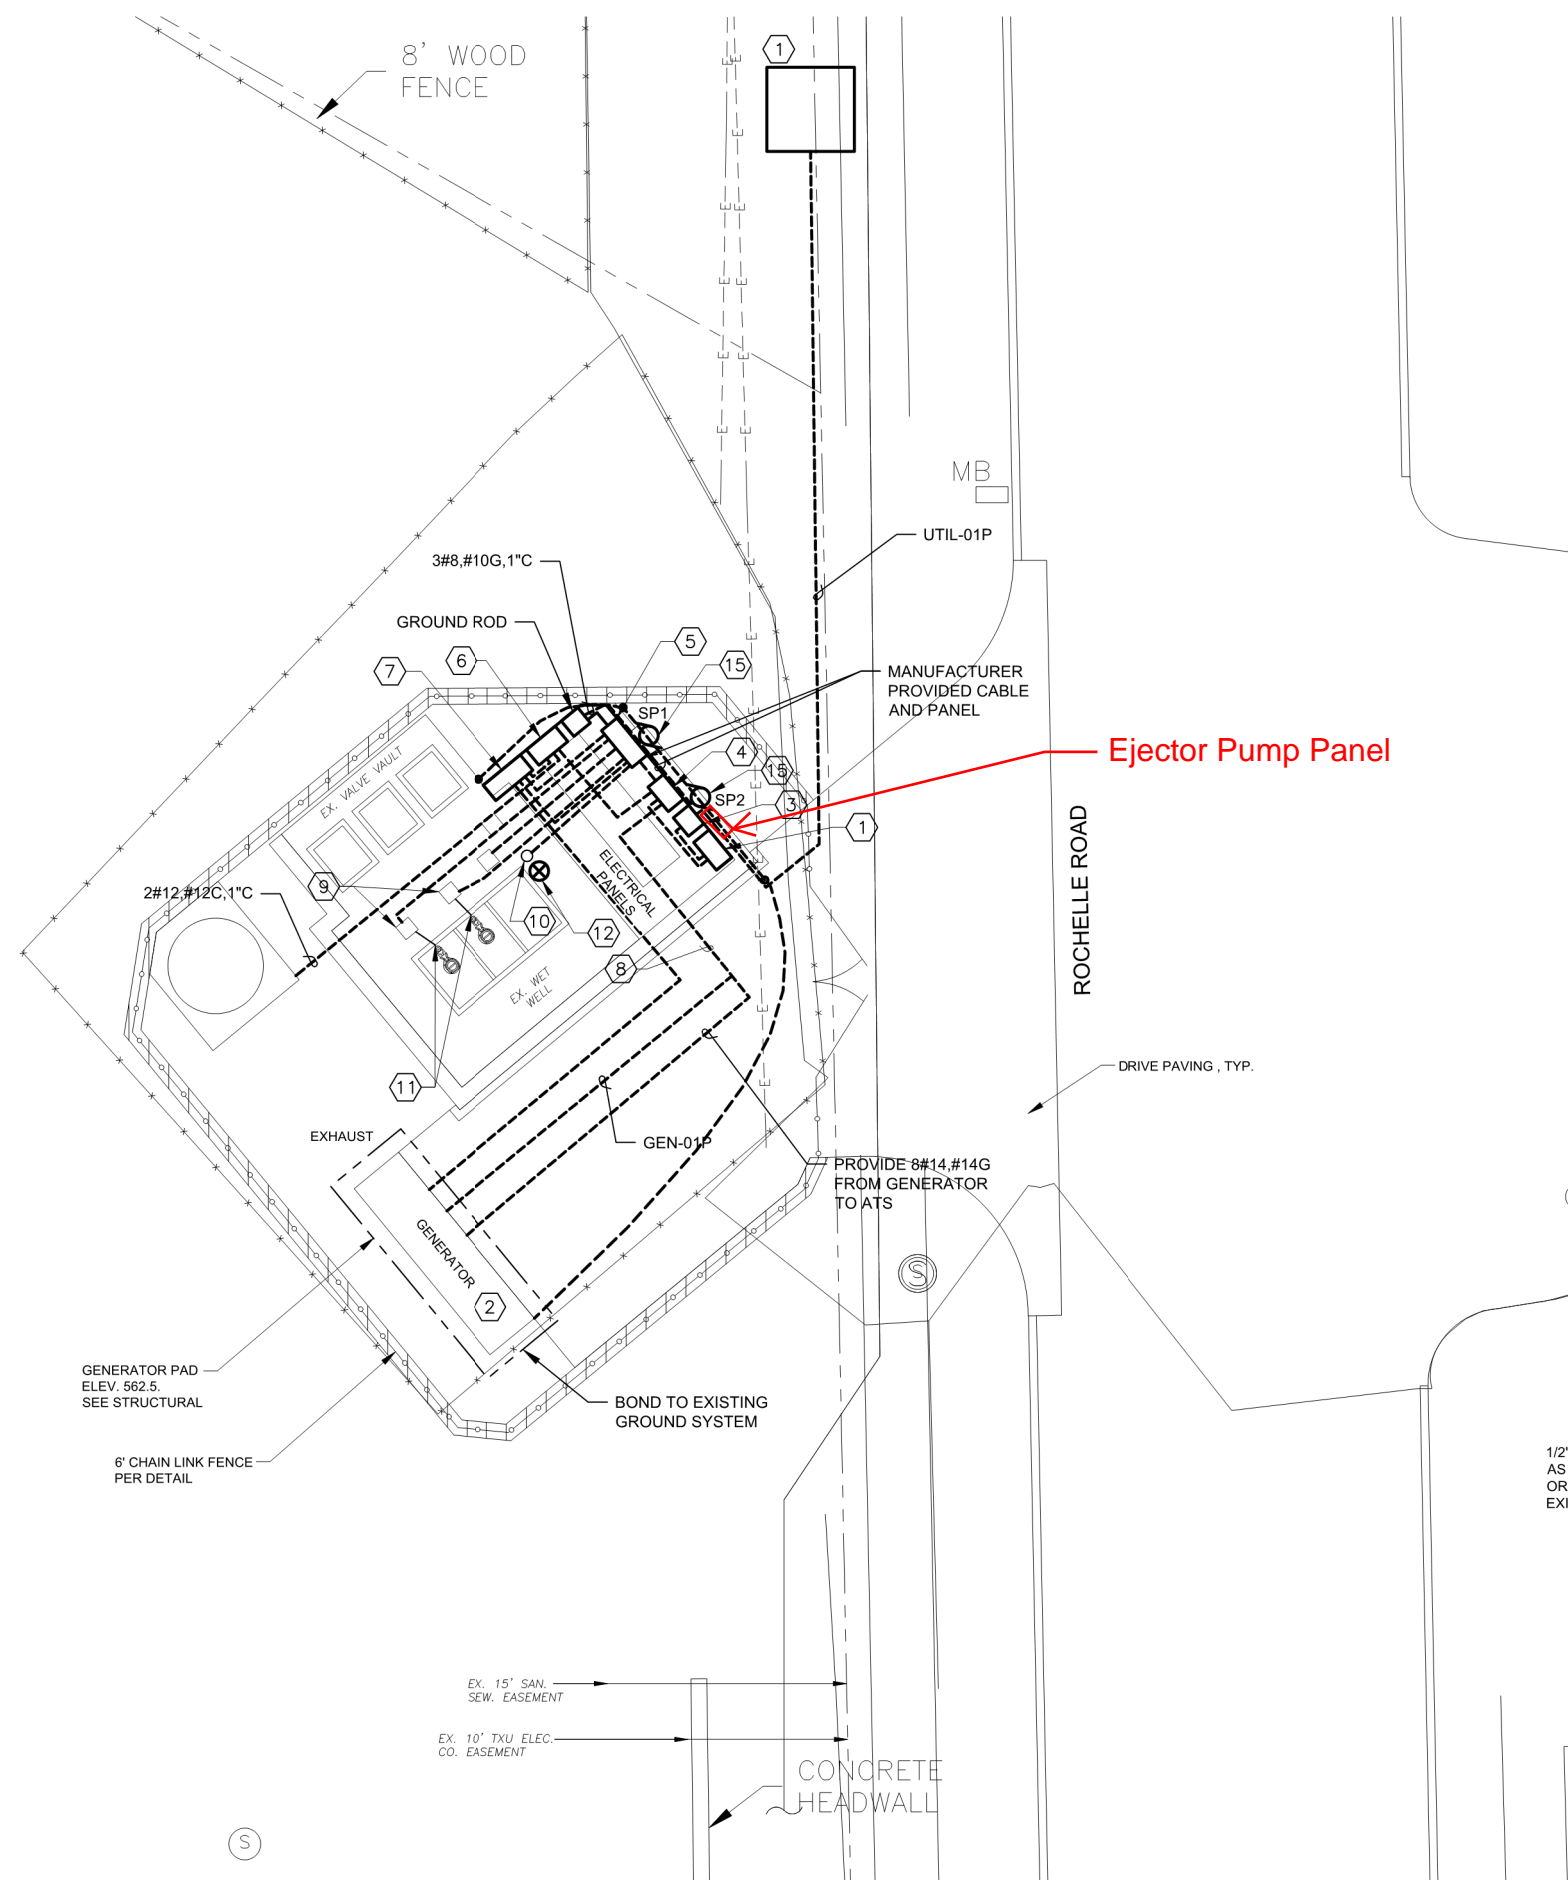


GENERAL NOTES:

1. PUMP STATION MUST MAINTAIN ONE PUMP IN SERVICE UNLESS CONTRACTOR IS BYPASS PUMPING THIS INCLUDES WHILE PUMP CONTROL PANEL IS BEING CHANGED.
2. FINAL CONSTRUCTION FOR LIFT STATION IS 2 PUMP. SLOT FOR 3RD PUMP TO BE ABANDONED.
3. EQUIPMENT THAT NEEDS TO REMAIN SHALL BE PROTECTED AND MAINTAINED BY THE CONTRACTOR DURING DEMOLITION & INSTALLATION.
4. COORDINATE WITH THE CITY TO DETERMINE WHAT TO DO WITH DEMO/REMOVED EQUIPMENT.
5. BOND GROUNDING EQUIPMENTS CABINETS TO GROUNDING SYSTEM.
6. COORDINATE WITH UTILITY COMPANY (FARMERS ELECTRIC COOPERATIVE, FRANK SPATARO 903-461-2452) FOR POWER DELIVERY TO THE SITE.

NOTES BY SYMBOL: "○"

1. 400A 3P DISCONNECT SWITCH.
2. 175KW GENERATOR 480/277 WITH 24HR FUEL IN DOUBLE WALLED BASE. PROVIDE SOUND ATTENUATION ENCLOSURE.
3. METER PER ONCOR REQUIREMENTS.
4. 200A, ATS.
5. PUMP CONTROLLER. TO BE PROVIDED IN LOCATION OF EXISTING PUMP CONTROLLER.
6. PROVIDE MINI POWER ZONE 30KVA 480V-208/120.
7. PROVIDE TELEMETRY PANEL WITH THE FOLLOWING POINTS:
NORMAL POWER
PUMP 1 RUN
GENERATOR POWER
PUMP 2 RUN
PUMP 1 FAIL
PUMP 2 FAIL
HIGH LEVEL ALARM
LOW GENERATOR FUEL ALARM
WET WELL LEVEL
8. PROVIDE 2#10,#10G,3/4"C TO GENERATOR FOR HEATER AND 2#12,#12G,3/4"C FOR BATTERY CHARGER.
9. USE EXISTING TERMINATION BOX FOR SUBMERSIBLE PUMP.
10. PROVIDE LEVEL SWITCH FOR:
LOW LEVEL ALARM
LEAD PUMP ON
LAG PUMP ON
PUMP OFF
HIGH LEVEL ALARM
PROVIDE 1"Ø#14,#14G,1"C TO PUMP CONTROL PANEL.
11. PROVIDE MANUFACTURER SUPPLIED SUBMERSIBLE CABLES.
12. PROVIDE LEVEL TRANSDUCER WITH LIGHTNING ARRESTER.
13. PROVIDE CONNECTION TO EXISTING ODOR CONTROL PANEL AND 2#12#12C TO MPZ-6.
14. PROVIDE PRESSURE TYPE LEVEL TRANSMITTER.
15. PROVIDE AND INSTALL 2 SEWAGE EJECTOR PUMP WITH ASSOCIATED APPURTENANCES AND SUPPORT. PROVIDE HIGH LEVEL ALARM CONNECTION TO SCADA.

RECORD DRAWING
TO THE BEST OF OUR KNOWLEDGE PERKINS ENGINEERING CONSULTANTS, INC., HEREBY STATES THAT THIS PLAN IS AS-BUILT. THIS INFORMATION PROVIDED IS BASED ON SURVEYING AT THE SITE AND INFORMATION PROVIDED BY THE CONTRACTOR.
Justin A. Angel
JUSTIN A. ANGEL, P.E.
TEXAS NO. 129386
10/20/2022
DATE

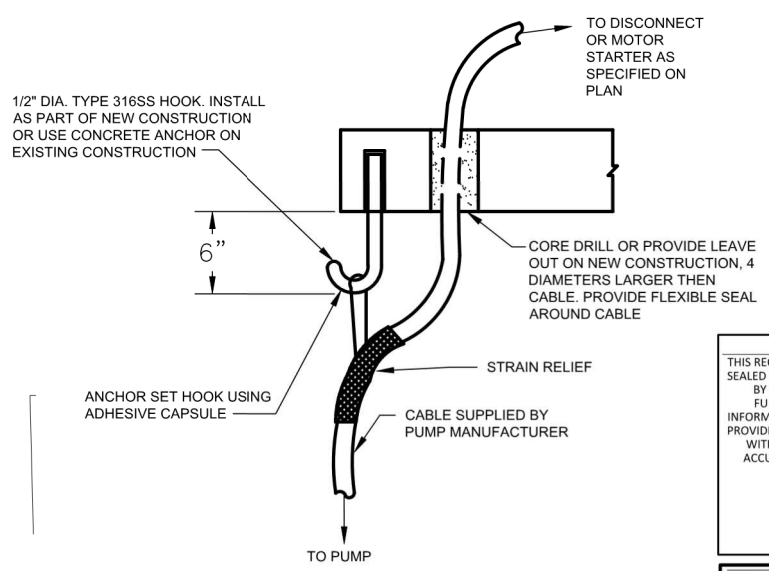

CABLE MOUNTING DETAIL
N.T.S.

RECORD DRAWING
THIS RECORD DRAWING IS A COMPILATION OF A COUP OF THE SEALED ENGINEERING DRAWING FOR THE PROJECT, MODIFIED BY ADDENDA, CHANGE ORDERS, AND INFORMATION FURNISHED BY THE CONTRACTOR AND OTHERS. THE INFORMATION SHOWN ON THE RECORD DRAWING THAT WAS PROVIDED BY THE CONTRACTOR OR OTHERS NOT ASSOCIATED WITH THE DESIGN ENGINEER CANNOT BE VERIFIED FOR ACCURACY OR COMPLETENESS. THE ORIGINALLY SEALED DOCUMENTS ARE ON FILE AT THE OFFICES OF:
LKC-ES ENGINEERING, INC.
TBPE FIRM 13810
800 E. CAMPBELL RD, SUITE 270
RICHARDSON, TX 75081
972-677-7865



BAR IS ONE INCH IN LENGTH ON ORIGINAL DRAWING. CHECK SCALE AND ADJUST ACCORDINGLY.
ONE INCH

SITE PLAN
SCALE: 1" = 6'-0"

PERKINS ENGINEERING CONSULTANTS, INC.
TBPE REGISTRATION NO. F-8699

NO.	DATE	DESCRIPTION

SITE PLAN


ENGINEERING CONCEPTS AND DESIGN

TIMBER CREEK LIFT STATION EXPANSION

Date:	NOVEMBER 2019
Designed:	JAA
Drawn:	SRG
Reviewed:	MAP
PEC Proj. No.:	ECO 18-004
of	
SEC.	

SHEET NO. E-3

PRINTED: 5/14/2021 2:50 PM \\LKC-ES\Projects\PEC1802_Rockwall Lift Station - Timber Creek Drawings\Electrical\E-4 ONE-LINE DIA.dwg - USER: LJC

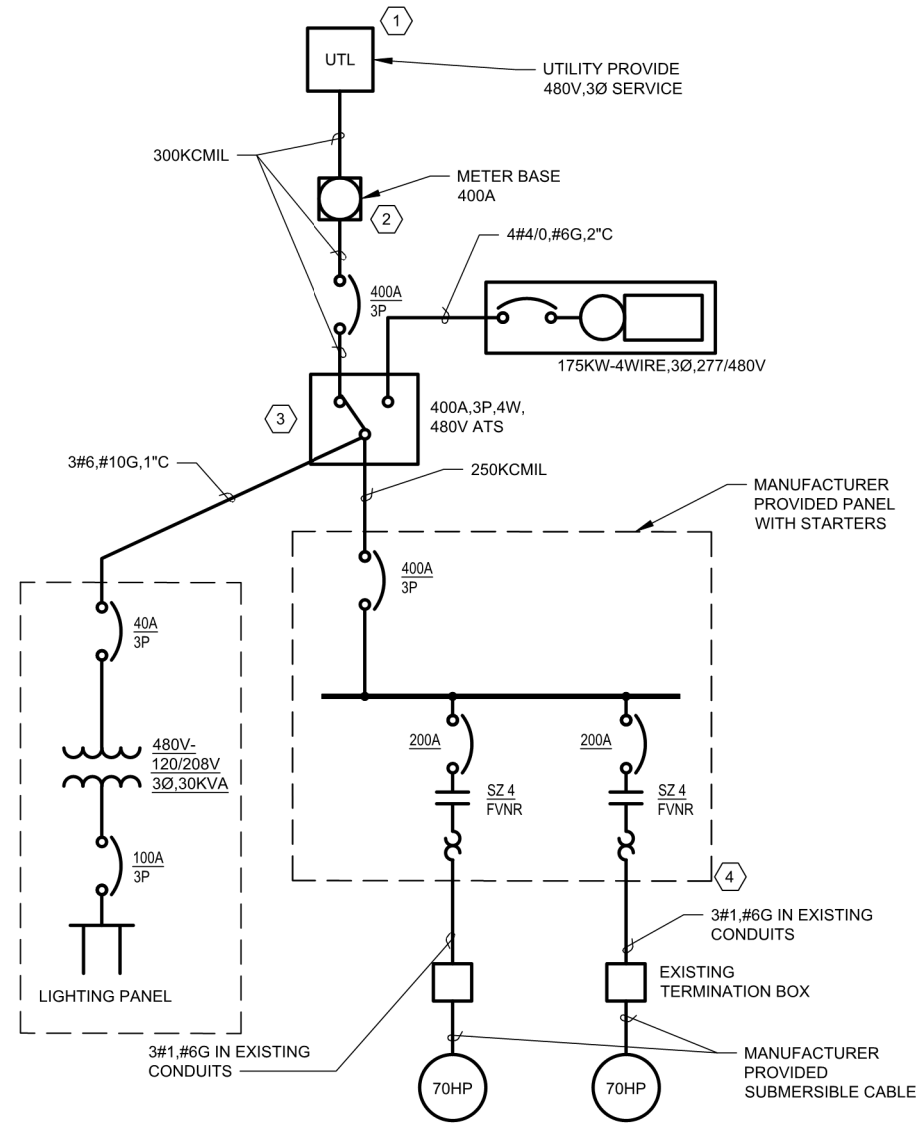

TIMBER CREEK LIFT STATION
ONE-LINE DIAGRAM

LIFT STATION NOTES:

- 1. PUMP CONTROL PANEL TO PROVIDE THE POINTS TO TELEMETRY PANEL.
- COMPLETE LIST OF I/O POINTS SHOULD BE OBTAINED FROM THE SCADA SYSTEM INTEGRATOR.

NOTES BY SYMBOL "⬡":

- COORDINATE WITH UTILITY COMPANY (FARMERS ELECTRIC COOPERATIVE, FRANK SPATARO 903-461-2452) FOR POWER DELIVERY TO THE SITE
- COORDINATE METER SOCKET WITH ELECTRIC UTILITY.
- 400A, 3P AUTOMATIC TRANSFER SWITCH.
- MANUFACTURER PROVIDED CABLES TO INCLUDE OVER TEMPERATURE AND LEAK DETECTION.

NO.	DATE	DESCRIPTION

ELECTRICAL
ONE-LINE DIAGRAM

ENGINEERING CONCEPTS AND DESIGN
TIMBER CREEK LIFT STATION
EXPANSION

Date:	NOVEMBER 2019
Designed:	JJA
Drawn:	SRG
Reviewed:	MAP
PEC Proj. No.:	ECD 18-004
of	
SEC.	

SHEET NO.
E-4

CKT	DESCRIPTION	POLES	LOAD			VOLT AMPS			BRKR	LOAD SERVED	CKT
			A	B	C	A	B	C			
1	RECEPTACLES	20/1	360			500			20/1	RTU TELEMETRY	2
3	LIGHTING	20/1		150			500		20/1	LEVEL TRANSMITTER	4
5	GENERATOR HEATER	20			500				20/1	ODOR CONTROL	6
7	GENERATOR HEATER	2	500						20	SURGE PROTECTION DEVICE	8
9	GENERATOR BATTERY CHARGER	20/1		500					1		10
11	STORM WATER SUMP PUMP	30/1			700						12
13	GENERATOR BATTERY CHARGER	20/1									14
15	SPARE	20/1									16
17	SPARE	20/1									18

BAR IS ONE INCH IN LENGTH ON ORIGINAL DRAWING. CHECK SCALE AND ADJUST ACCORDINGLY.
ONE INCH


RECORD DRAWING
TO THE BEST OF OUR KNOWLEDGE PERKINS ENGINEERING CONSULTANTS, INC., HEREBY STATES THAT THIS PLAN IS AS-BUILT. THIS INFORMATION PROVIDED IS BASED ON SURVEYING AT THE SITE AND INFORMATION PROVIDED BY THE CONTRACTOR.
Justin A. Angel
JUSTIN A. ANGEL, P.E.
TEXAS NO. 129386
DATE: 10/20/2022

RECORD DRAWING
THIS RECORD DRAWING IS A COMPILATION OF A COUP OF THE SEALED ENGINEERING DRAWING FOR THE PROJECT; MODIFIED BY ADDENDA, CHANGE ORDERS, AND INFORMATION FURNISHED BY THE CONTRACTOR AND OTHERS. THE INFORMATION SHOWN ON THE RECORD DRAWING THAT WAS PROVIDED BY THE CONTRACTOR OR OTHERS NOT ASSOCIATED WITH THE DESIGN ENGINEER CANNOT BE VERIFIED FOR ACCURACY OR COMPLETENESS. THE ORIGINALLY SEALED DOCUMENTS ARE ON FILE AT THE OFFICES OF:
LKC-ES ENGINEERING, INC.
TBE FIRM 13810
800 E. CAMPBELL RD, SUITE 270
RICHARDSON, TX 75081
972-677-7865

LKC-ES
ENGINEERING SERVICE




PRINTED: 5/14/2021 2:50 PM \\LKC-ES\Projects\PEC1802 Rockwall Lift Station - Timber Creek Drawings\Electrical\E-5 CONTROL LOGIC.dwg SAVE: 4/16/2020 4:41 PM USER: LJC

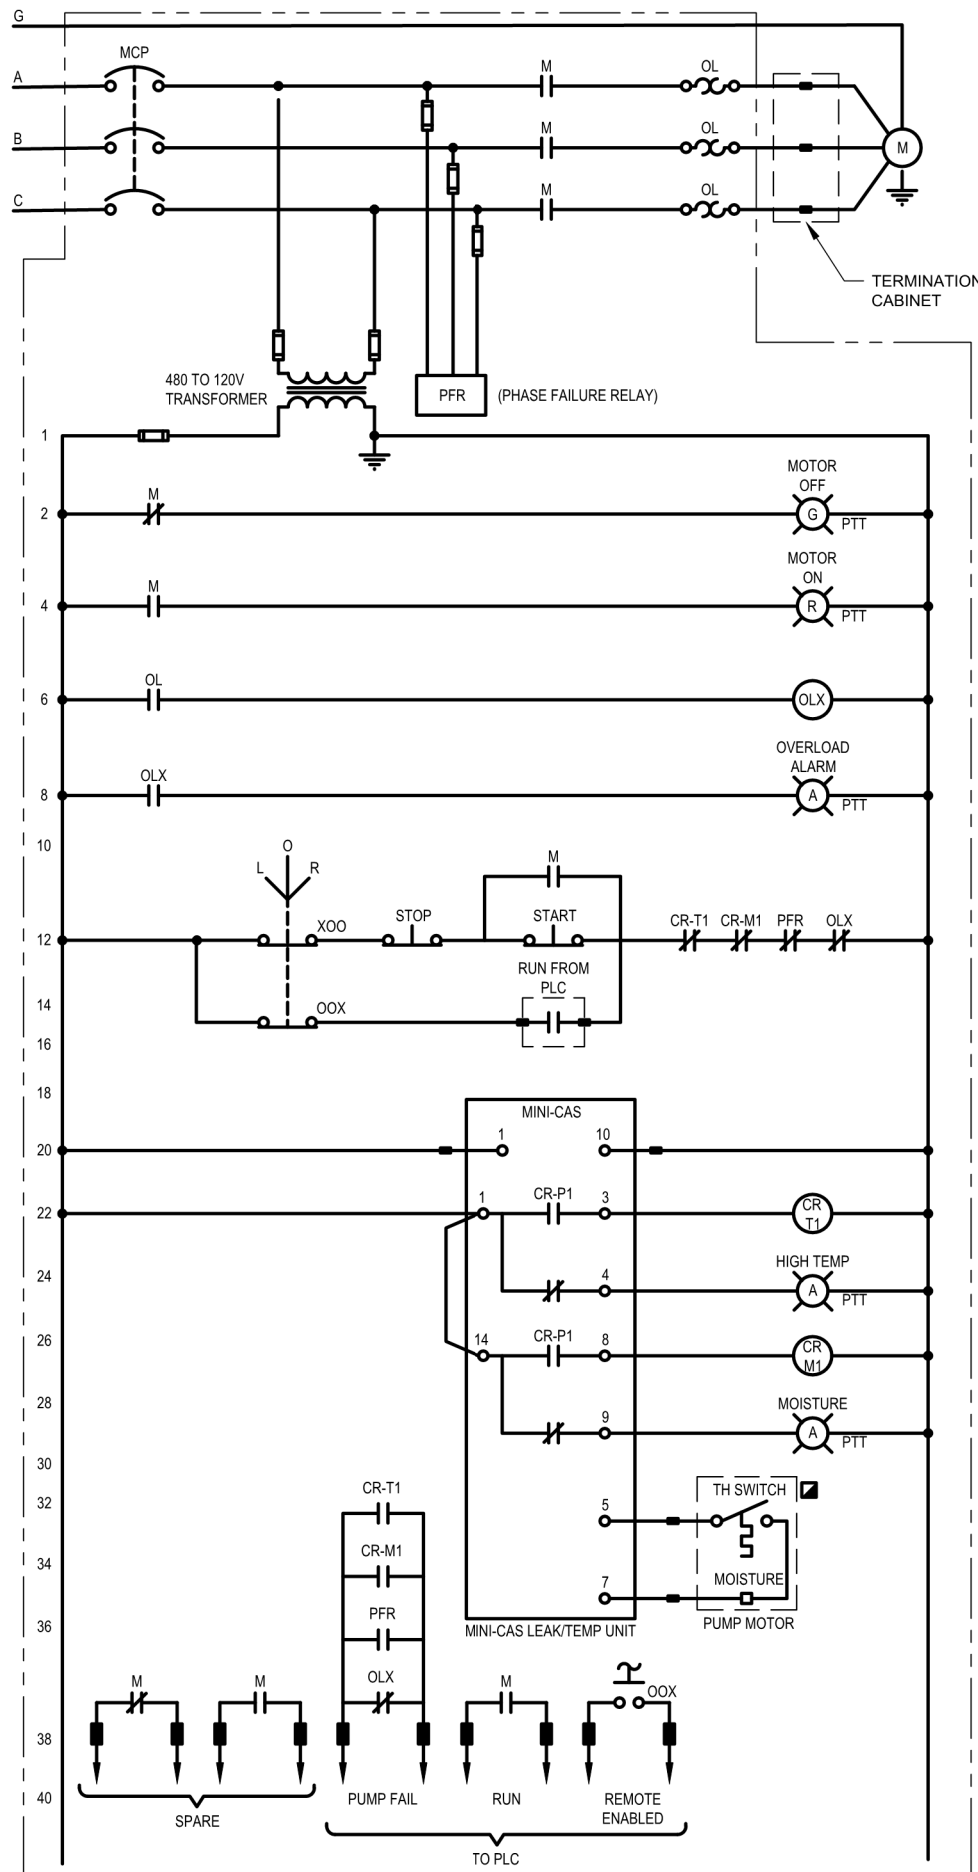

SCHEMATIC 1

BAR IS ONE INCH IN LENGTH ON ORIGINAL DRAWING. CHECK SCALE AND ADJUST ACCORDINGLY.
ONE INCH

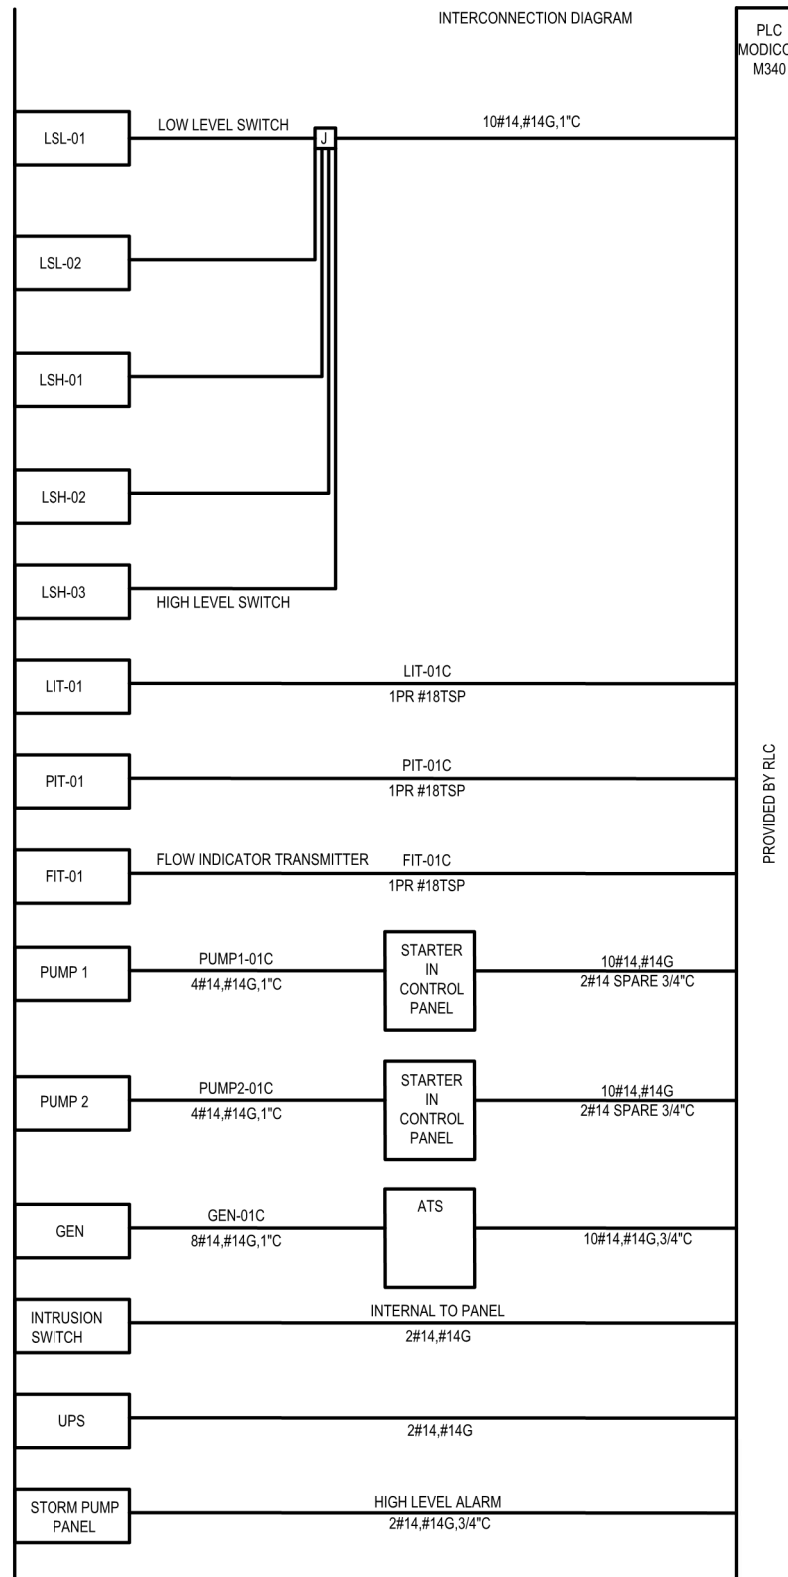

INTERCONNECTION DIAGRAM
NTS

RECORD DRAWING
TO THE BEST OF OUR KNOWLEDGE PERKINS ENGINEERING CONSULTANTS, INC., HEREBY STATES THAT THIS PLAN IS AS-BUILT. THIS INFORMATION PROVIDED IS BASED ON SURVEYING AT THE SITE AND INFORMATION PROVIDED BY THE CONTRACTOR.
Justin Angel
JUSTIN A. ANGEL, P.E. 10/20/2022
TEXAS NO. 129386 DATE

RECORD DRAWING
THIS RECORD DRAWING IS A COMPILATION OF A COUP OF THE SEALED ENGINEERING DRAWING FOR THE PROJECT, MODIFIED BY ADDENDA, CHANGE ORDERS, AND INFORMATION FURNISHED BY THE CONTRACTOR AND OTHERS. THE INFORMATION SHOWN ON THE RECORD DRAWING THAT WAS PROVIDED BY THE CONTRACTOR OR OTHERS NOT ASSOCIATED WITH THE DESIGN ENGINEER CANNOT BE VERIFIED FOR ACCURACY OR COMPLETENESS. THE ORIGINALLY SEALED DOCUMENTS ARE ON FILE AT THE OFFICES OF:
LKC-ES ENGINEERING, INC.
TBE FIRM 13810
800 E. CAMPBELL RD, SUITE 270
RICHARDSON, TX 75081
972-677-7865



03/16/2020



PERKINS ENGINEERING CONSULTANTS, INC.
TBE REGISTRATION NO. F-8699

CONTROL LOGIC

ENGINEERING CONCEPTS AND DESIGN


TIMBER CREEK LIFT STATION EXPANSION

NOVEMBER 2019

Date: JJA
Designed: SRG
Drawn: MAP
Reviewed: MFP
PEC Proj. No.: ECD 18-004
of
SEQ.

SHEET NO. E-5

PRINTED: 5/14/2021 2:50 PM \\LKC-ES\Projects\PEC1802_Rockwall Lift Station - Timber Creek Drawings\Electrical\6-DETAILS.dwg SANED: 5/14/2021 2:43 PM USER: LJC

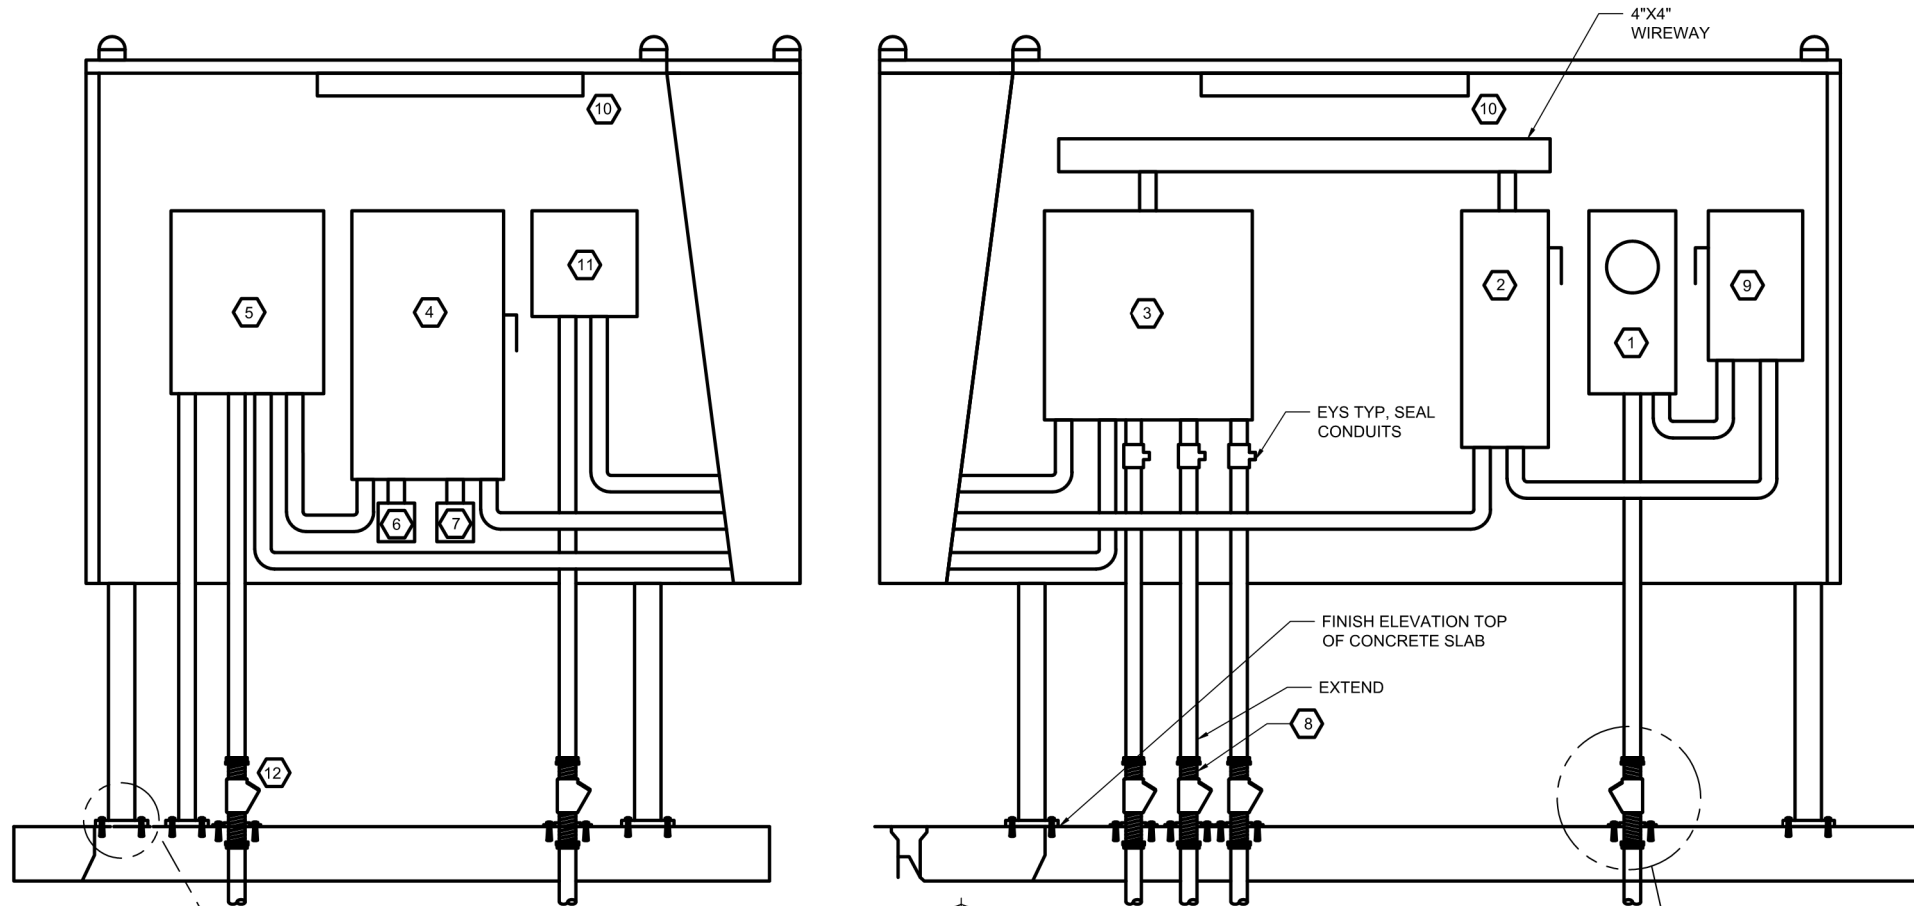

GENERAL NOTES:





1. MANUFACTURER SUPPLIED PUMP CONTROL PANEL SHALL BE DESIGNED TO OPERATE THE REQUIRED NUMBER OF PUMPS SPECIFIED ON THE DRAWINGS. THE CONTROL FUNCTION SHALL PROVIDE FOR THE OPERATION OF THE PUMPS IN HAND (MANUAL) AND AUTO (CONTROL PLC).
2. ALL EXPOSED CONDUITS AND FITTINGS TO BE TAPED RIGID ALUMINUM. ALL UNDERGROUND CONDUITS AND FITTINGS SHALL BE SCHEDULE 40 PVC WITH 4" CONCRETE CAP, DYED RED THROUGHOUT.
3. ALL POWER AND/OR CONTROL CONDUCTORS SHALL BE THWN STRANDED.
4. ENCLOSURES FOR ALL INSTRUMENTATION EQUIPMENT AND ELECTRICAL LIGHTING (LED) PANEL SHALL BE NEMA-4X 316 SS W/STAINLESS FITTINGS WITH SINGLE ACTION HANDLE THAT ACCEPTS A 3/8" SHAFT PADLOCK.
5. CALIBRATION OF INSTRUMENTS FURNISHED SHALL BE ACCOMPLISHED BY A QUALIFIED REPRESENTATIVE OF THE MANUFACTURER OF THE INSTRUMENTS WITH CITY OF ROCKWALL REPRESENTATIVES PRESENT.
6. ALL CONDUITS SHALL BE SEALED AT PANEL BOARDS, JUNCTION BOXES, CONDUITS AND TERMINATION POINTS.
7. ALL CONDUIT TERMINATIONS SHALL BE MADE WITH A MEYERS HUB. FOR CONDUITS ENTERING SIDE OR TOP OF ENCLOSURE AND SEALABLE LOCK RINGS FOR CONDUITS ENTERING BOTTOM OF ENCLOSURE.
8. WET WELL LEVEL SHALL BE SENSED BY A TRANSDUCER. FLOAT REGULATORS SHALL BE INSTALLED AS BACK-UP FOR HIGH AND LOW LEVEL ONLY. THE TRANSDUCER SHALL SENSE THE OFF, LEAD, LAG, AND HIGH LEVELS.

NOTES BY SYMBOL ◻:

1. METER SOCKET, COORDINATE WITH ELECTRIC UTILITY.
2. 400A 3PH, 4 WIRE AUTOMATIC TRANSFER SWITCH.
3. MANUFACTURER PROVIDED PUMP CONTROL PANEL.
4. 30 KVA MINI POWER ZONE. 3 ϕ , 120/208V SECONDARY.
5. SCADA PANEL WITH UPS.
6. WP, GFCI RECEPTACLE.
7. WP LIGHT SWITCH.
8. EXTEND EXISTING CONDUITS TO NEW CONTROL PANEL.
9. 400A, 3P DISCONNECT SWITCH.
10. VAPOR-TIGHT LIGHT FIXTURE W/15W L.E.D. LAMP.
11. SUMP PUMP PANEL.
12. CONDUIT TO RTU FROM WETWELL REQUIRE CONDUIT SEAL.

RECORD DRAWING
 TO THE BEST OF OUR KNOWLEDGE PERKINS ENGINEERING CONSULTANTS, INC. HEREBY STATES THAT THIS PLAN IS AS-BUILT. THIS INFORMATION PROVIDED IS BASED ON SURVEYING AT THE SITE AND INFORMATION PROVIDED BY THE CONTRACTOR.
 JUSTIN A. ANGEL, P.E. DATE 10/20/2022
 TEXAS NO. 129386

RECORD DRAWING
 THIS RECORD DRAWING IS A COMPILATION OF A COUP OF THE SEALED ENGINEERING DRAWING FOR THE PROJECT; MODIFIED BY ADDENDA, CHANGE ORDERS, AND INFORMATION FURNISHED BY THE CONTRACTOR AND OTHERS. THE INFORMATION SHOWN ON THE RECORD DRAWING THAT WAS PROVIDED BY THE CONTRACTOR OR OTHERS NOT ASSOCIATED WITH THE DESIGN ENGINEER CANNOT BE VERIFIED FOR ACCURACY OR COMPLETENESS. THE ORIGINALLY SEALED DOCUMENTS ARE ON FILE AT THE OFFICES OF:
 LKC-ES ENGINEERING, INC.
 TBPE FIRM 13810
 800 E. CAMPBELL RD, SUITE 270
 RICHARDSON, TX 75081
 972-677-7865

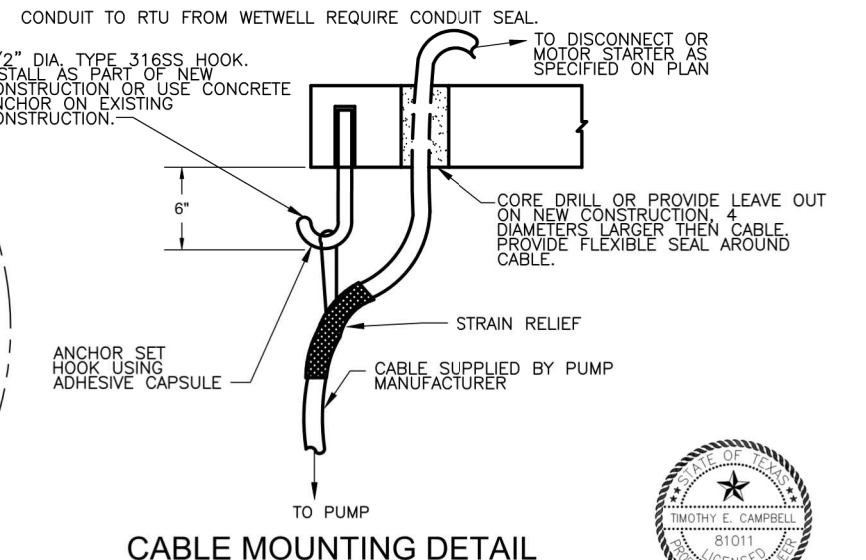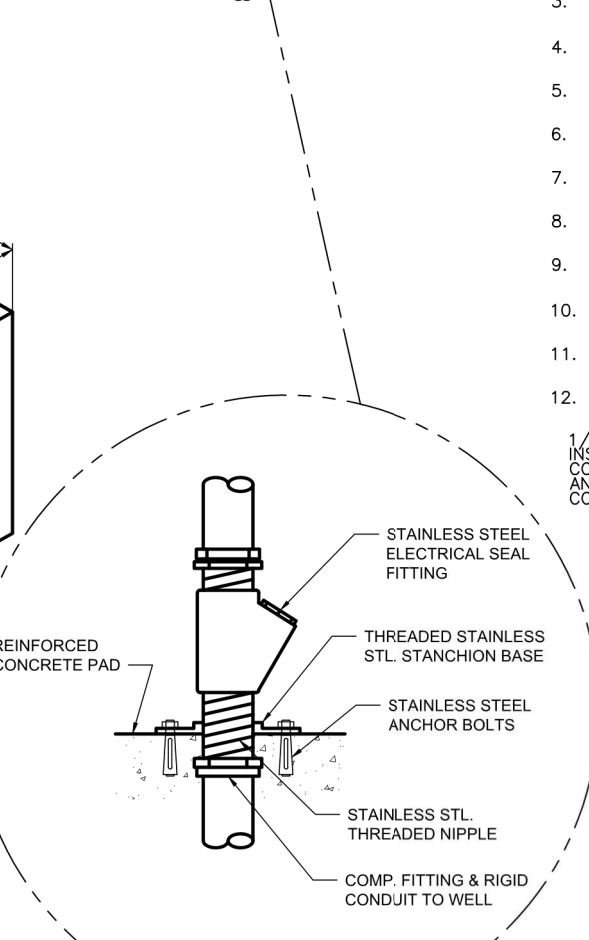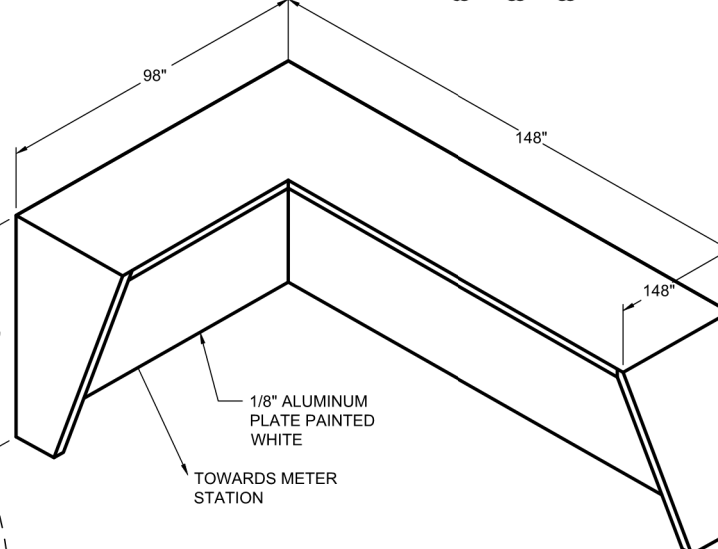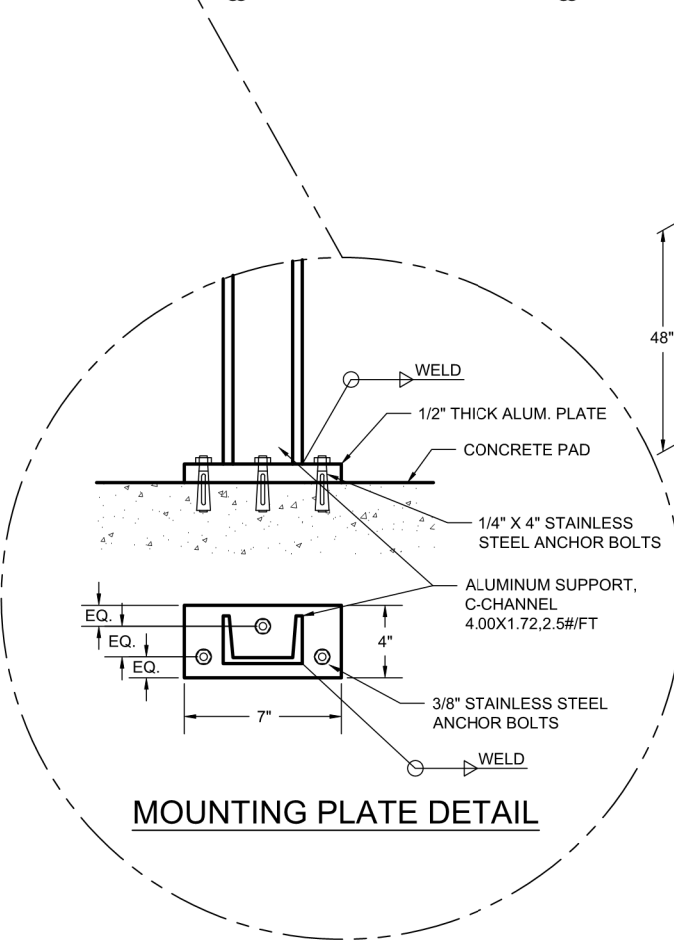

BAR IS ONE INCH IN LENGTH ON ORIGINAL DRAWING. CHECK SCALE AND ADJUST ACCORDINGLY.
 ONE INCH

WEATHER SHIELD (TYP)

CABLE MOUNTING DETAIL
 N.T.S.
LKC-ES
 ENGINEERING SERVICE
 TBPE FIRM-#13810



PERKINS ENGINEERING CONSULTANTS, INC.
 TBPE REGISTRATION NO. F-8699

NO.	DATE	DESCRIPTION

By: _____
 Description: _____
 Date: _____

ELECTRICAL DETAILS

ENGINEERING CONCEPTS AND DESIGN

TIMBER CREEK LIFT STATION EXPANSION

Date: NOVEMBER 2019
 Designed: JAA
 Drawn: SRG
 Reviewed: MAP
 PEC Proj. No. ECD 18-004
 of _____
 SEC.

SHEET NO. E-6

