

6' MASONRY SCREENING WALL

LOT 1
BLOCK A

PROP. ONE STORY BLDG.
FF 475.75

6' MASONRY SCREENING WALL

135 L.F. CROSS TIE WALL

SECTION A-A

150 L.F. SAW-CUT
REMOVE 24 S.Y. CONC.
CONN. TO EXPOSED REINFORCING
REPLACE 24 S.Y. CONC.

406 L.F. SAW-CUT
REMOVE 193 S.Y. CONC.
CONN. TO EXPOSED REINFORCING
REPLACE 254.6 S.Y. CONC. W/O CURB & GUTTER
SEE DETAIL FOR STRIPING


B.M.
TOP OF EXIST. SAN. SEW. M.H.
81' +/- EAST & 20' +/- NORTH OF PROP.
M.H. AT STA. 1+69.81 LN. A
ELEVATION = 471.11

B.M.
CITY OF ROCKWALL MON. NO. 11 LOCATED
ON APPROX. C.L. NORTH LAKESHORE DR., 2.8' +/-
NORTH OF SOUTH END MEDIAN BTWN. AMESBURY
& STONEYBROOK.
ELEVATION = 518.88

'As Built'

NORTH LAKESHORE DRIVE

DETAIL FOR STRIPING

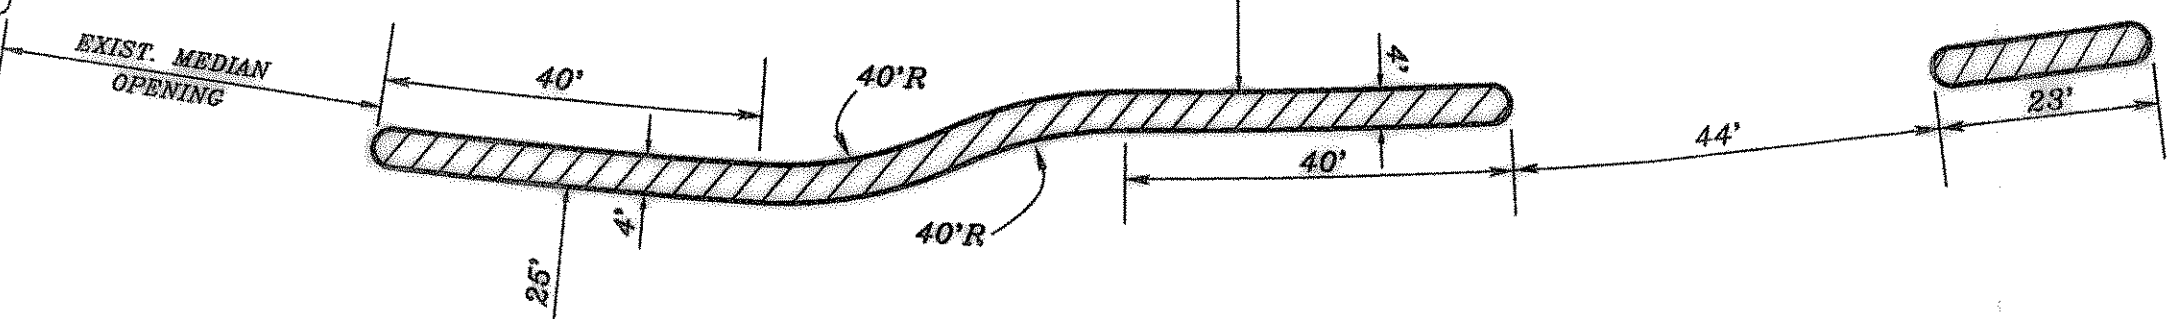

06128CRD HAROLD L. EVANS CONSULTING ENGINEER P.O. BOX 28955 2391 CUS THOMASSON ROAD, SUITE 102 DALLAS, TEXAS 75228, (214) 328-8133		GRADING PLAN THE LIGHTHOUSE CITY OF ROCKWALL		SHEET NO. 1 / 2
REV. PER CITY REVIEW REV.	2/22/96 2/13/96	DATE 2/5/96	SCALE 1" = 20' H.L.E.	JOB NO. 95128