


As Built

B.M.
TOP OF EXIST. SAN. SEW. M.H.
81' +/- EAST & 20' +/- NORTH OF PROP.
M.H. AT STA. 1+69.31 LN. A
ELEVATION = 471.11

B.M.
CITY OF ROCKWALL MON. NO. 11 LOCATED
ON APPROX. C.L. NORTH LAKESHORE DR., 2.3' +/-
NORTH OF SOUTH END MEDIAN BTWN. AMESBURY
& STONEYBROOK
ELEVATION = 518.88

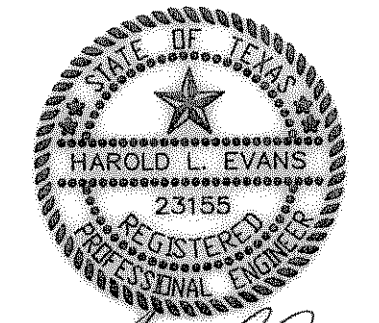

2-96

REV. PER CITY REVIEW		DATE		SCALE		DESIGN		DRAWN		SHEET NO.	
2/19/96		1/20/96		1" = 40' 1" = 6"		H.L.E.				2	
HAROLD L. EVANS CONSULTING ENGINEER P.O. BOX 28855 2331 CUS THOMASSON ROAD, SUITE 102 DALLAS, TEXAS 75228, (214) 328-8133										PROPOSED UTILITIES THE LIGHTHOUSE	
CITY OF ROCKWALL										JOB NO. 95128	