



MULTI-HOLE  
SEE SHEET C  
FOR DETAIL

**SITE IMPROVEMENT PLAN**  
SCALE - 1" = 30'

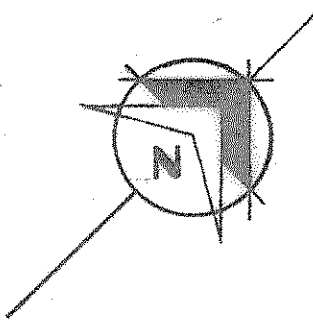

NUMBER OF UNITS IN BUILDING	21	BUILDING NUMBER	21
	14	NUMBER OF BEDROOMS	14


JOB NO	888
DATE	6/2/74

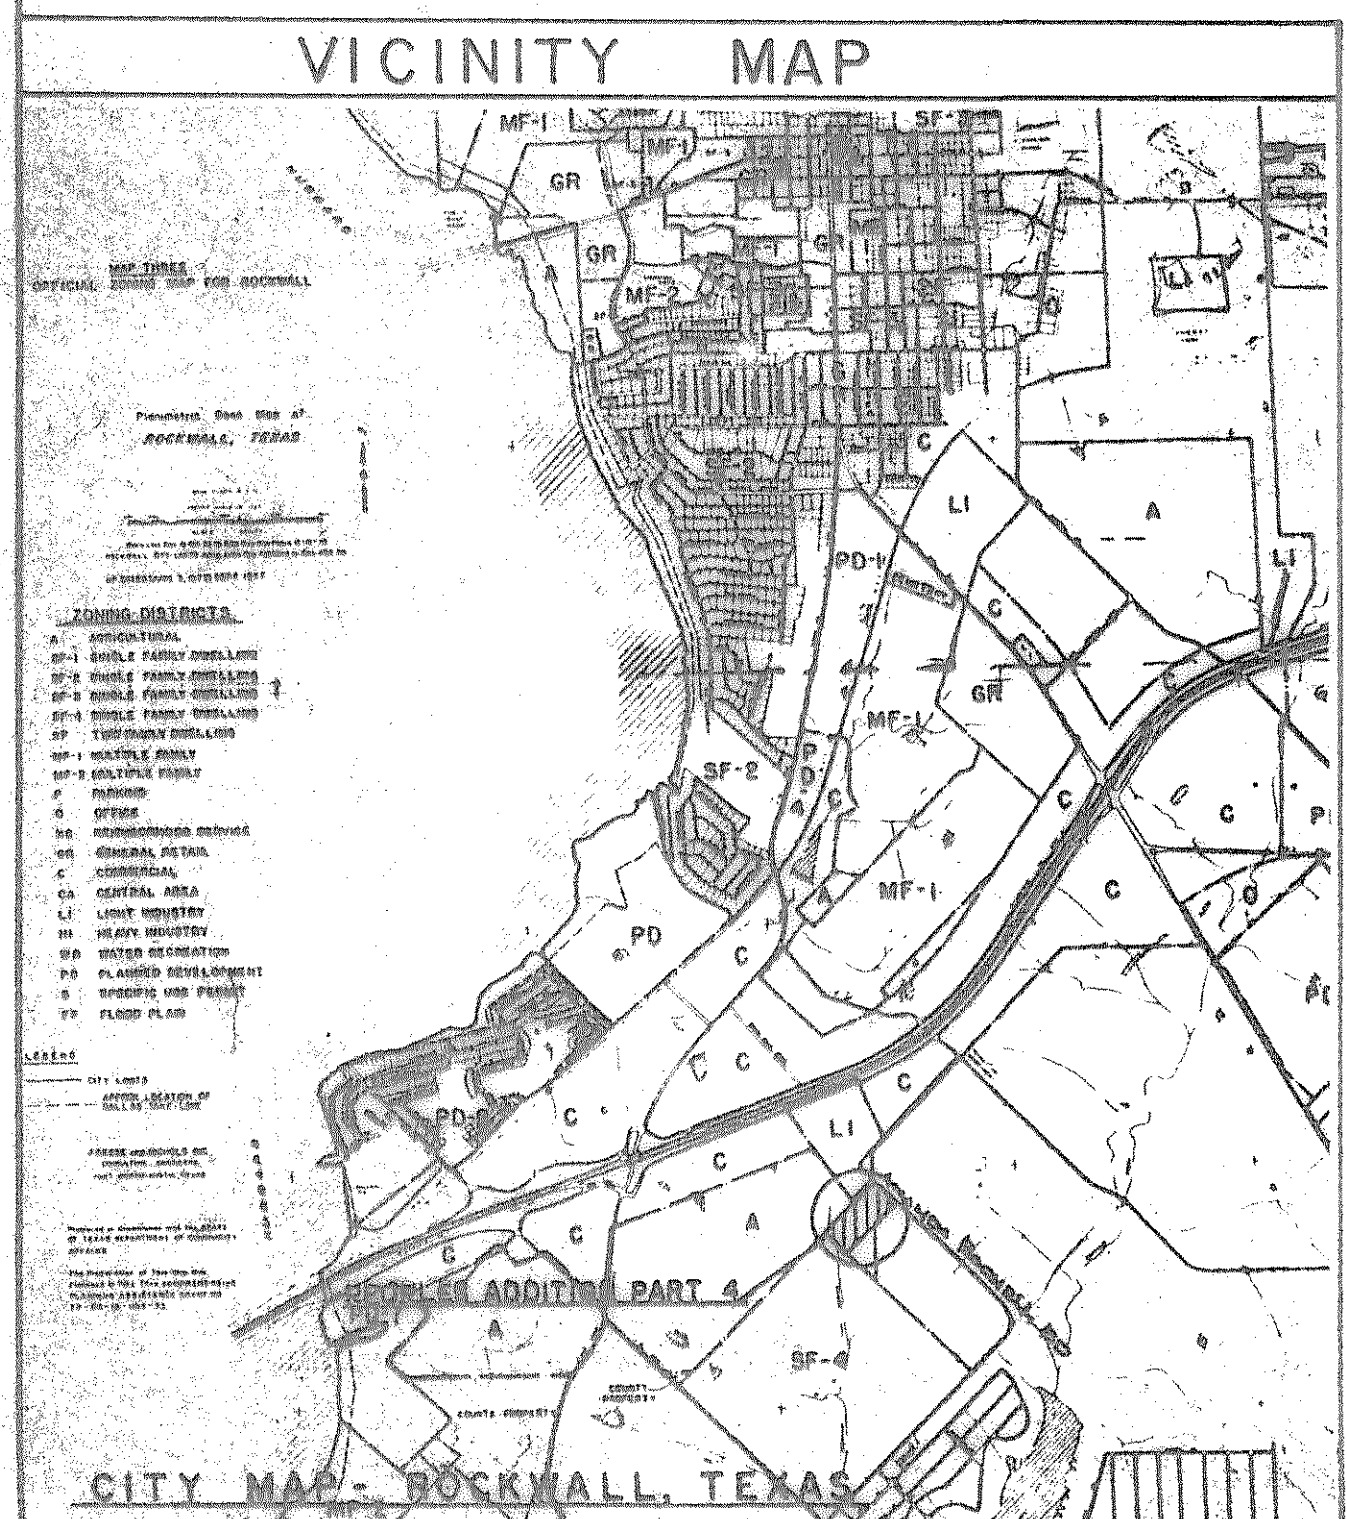

**M O**  
**M A L**  
**M A L**  
**M A L**

**MICHAEL O. MALONEY ARCHITECT**  
1803 MIDWESTERN PKWY  
WICHITA FALLS, TEXAS 76302  
817 767 0003

**DAMBOLD & ASSOCIATES**  
ARCHITECTS - ENGINEERS  
1609 West Gore Blvd. P.O. Box 248  
Lawton, Oklahoma

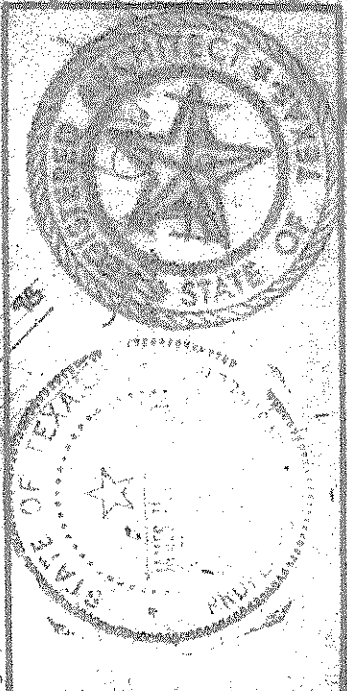

**HOUSING AUTHORITY OF ROCKWALL, TEXAS**  
UNITS TO BE CONSTRUCTED FOR THE HOUSING PROJECT TO BE BUILT BY THE HOUSING AUTHORITY OF ROCKWALL, TEXAS