


SITE GRADING PLAN
SCALE - 1" = 30'


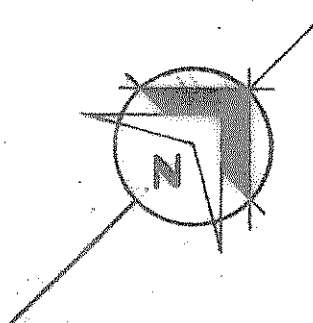


NUMBER OF UNITS IN BUILDING	21	BUILDING NUMBER
	14	NUMBER OF BEDROOMS

JOB NO.	DATE
	MAR 9 1983

MICHAEL O. MALONEY ARCHITECT
1803 MIDWESTERN PKWY
WICHITA FALLS, TEXAS 76302 817 767 0003

DAMBOLD & ASSOCIATES
ARCHITECTS - ENGINEERS
1608 West Cow Blvd. P.O. Box 248
Lantieri, Oklahoma

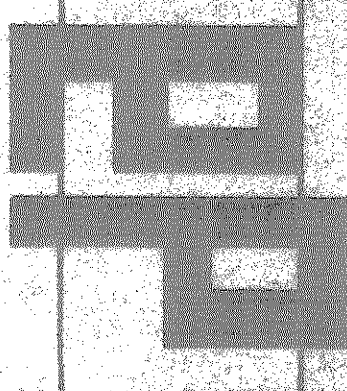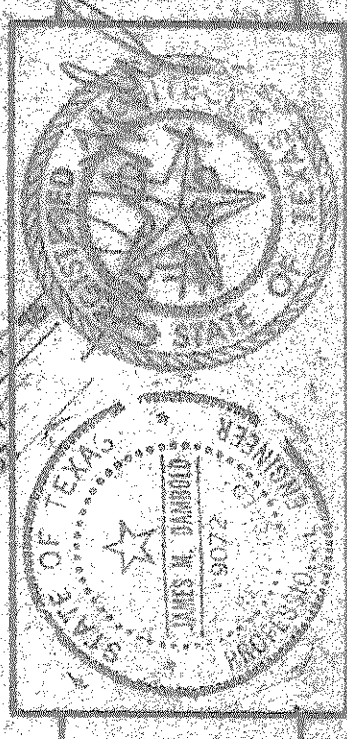

PROPERTY AUTHORITY OF ROCKWALL TEXAS