


AT STA. 13+29 IS A DITCH. UNLESS PROTECTED FOR CONC. EASEMENT.

NOTE: ON-SITE UTILITIES SHOWN ON SHEET C-4

OFFSITE UTILITY LAYOUT  
SCALE 1" = 200'

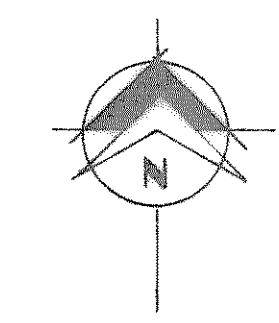

**M O**  
**M A R C H**

MICHAEL O. MALONEY ARCHITECT  
1803 MIDWESTERN PKWY  
WICHITA FALLS, TEXAS 76302  
817 767 0003

**DAMBOLD & ASSOCIATES**  
ARCHITECTS - ENGINEERS  
1609 West Gore Blvd. P.O. Box 248  
Lawton, Oklahoma

JOB NO. DATE  
2-17-83 REVISION

38 UNIT TURKEY LOW RENT HOUSING PROJECT TX-95-004  
HOUSING AUTHORITY OF ROCKWALL, TEX.  
DEVELOPER: development consultants, inc. oklahoma city, okla.