


REVISED TO CONFORM TO CONSTRUCTION RECORDS.
W. D. [Signature] DATE: 8-10-20

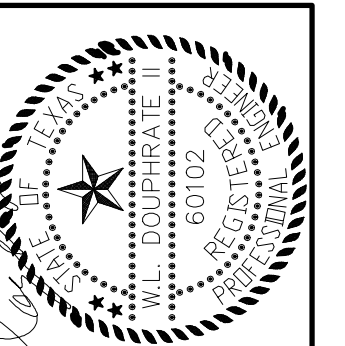

THE SEAL APPEARING ON THIS DOCUMENT WAS AUTHORIZED BY THE BOARD OF PROFESSIONAL ENGINEERS, STATE OF TEXAS, NO. 60102, F-886, ON DATE: APRIL 18, 2018.

DOUPHRATE & ASSOCIATES, INC.
 ENGINEERING • PROJECT MANAGEMENT • SURVEYING
 2235 RIDGE RD., # 200 ROCKWALL, TEXAS 75087
 PHONE: (972)771-9004 FAX: (972)771-9005

**PROPOSED GRADING
 KEY MAP
 THE STANDARD ROCKWALL
 CITY OF ROCKWALL
 ROCKWALL COUNTY, TEXAS**

3-6-18 REV. ENTRANCE REVISION

W.L.D.
 CHECKED

D.A.C.
 DRAWN

SCALE
 1" = 50' H
 1" = 5' V

MARCH, 2018
 DATE

17013
 PROJECT

40