


THE SEAL APPEARING ON THIS DOCUMENT IS VALID ONLY IF THE SEALING ENGINEER'S LICENSE IS IN FULL FORCE AND EFFECT. DATE: APRIL 18, 2018.

DOUPHRADE & ASSOCIATES, INC.  
22235 RIDGE RD., # 200 ROCKWALL, TEXAS 75087  
PHONE: (972)771-9004 FAX: (972)771-9005

PROPOSED GRADING  
SHT. 4.1  
THE STANDARD ROCKWALL

3-6-18 REV. ENTRANCE REVISION
W.L.D.
CHECKED
D.A.C.
DRAWN
SCALE 1"=50' H 1"=V
APRIL 2018 DATE
17013 PROJECT
41

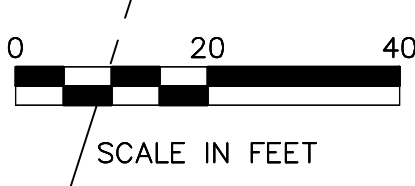

**SOUTH COLLIAD STREET**  
(CRUISE HIGHWAY NO. 580)  
(165'-WIDE WITH PUBLIC RIGHT-OF-WAY)

EXISTING SIDEWALK TO BE REMOVED AND REPLACED 2' OFFSET FROM PROPERTY LINE WHERE PROPOSED WATER LINE IS TO BE INSTALLED. SEE SHEET 6.0

- NOTE:
1. NO SMOOTH CONCRETE WALLS ALLOWED.
  2. NO PART OF THE WALL (FOOTINGS, TIE-BACKS, ETC) MAY BE OFF-SITE OR ON LOT LINE, IN EASEMENTS OR R.O.W.
  3. WALL MUST BE COMPLETELY ON ONE LOT.
  3. NO SIDEWALKS AT BACK OF CURB

REVISED TO CONFORM TO CONSTRUCTION RECORDS.  
*W.L. Douphrate*  
DATE: 8-10-20