



REVISED TO CONFORM TO CONSTRUCTION RECORDS.
 DATE: 8-10-20

NOTE:
 1. NO SMOOTH CONCRETE WALLS ALLOWED.
 2. NO PART OF THE WALL (FOOTINGS, TIE-BACKS, ETC) MAY BE OFF-SITE OR ON LOT LINE, IN EASEMENTS OR R.O.W..
 WALL MUST BE COMPLETELY ON ONE LOT.
 3. NO SIDEWALKS AT BACK OF CURB

LEGEND
 BFR BARRIER FREE RAMP
 PAD PROP. PAD ELEVATION
 XX.XXTC PROP. TOP OF CURB ELEVATION
 XX.XX PROP. SPOT GRADES
 XX.XXNG NATURAL GROUND ELEVATION
 XX.XXNG-TW TOP OF WALL @ NATURAL GROUND ELEVATION
 XX.XX-TW PROP. TOP OF WALL ELEVATION
 XX.XXBW PROP. BOTTOM OF WALL ELEVATION
 XX.XXFG PROP. FINISHED GRADE ELEVATION
 XX.XXFP PROP. FINISHED PAVEMENT ELEVATION

NOTE:
 NO PART OF THE WALL (FOOTING, TIE BACKS, ETC) MAY BE OFFSITE, ON LOT LINE, IN EASEMENT OR RIGHT-OF-WAY. WALL MUST BE COMPLETELY ON ONE LOT.

ALL LOTS NOT TO EXCEED 4:1 MAX SLOPE

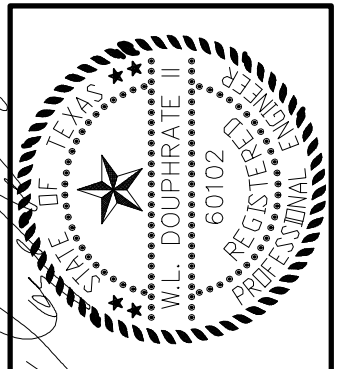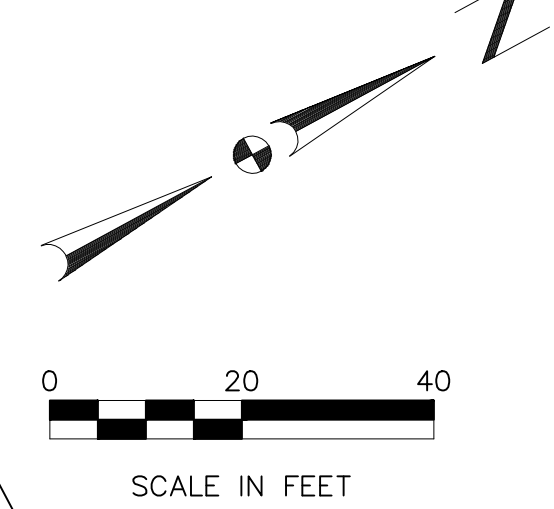

THE SEAL APPEARING ON THIS DOCUMENT WAS AUTHORIZED BY W.L. DOUPHRATE II, LICENSE NO. 60102, EXPIRES APRIL 16, 2016.

DOUPHRATE & ASSOCIATES, INC.
 ENGINEERING - PROJECT MANAGEMENT - SURVEYING
 2235 RIDGE RD., # 200 ROCKWALL, TEXAS 75087
 PHONE: (972)771-9004 FAX: (972)771-9005

PROPOSED GRADING
 SHT. 4.2
 THE STANDARD ROCKWALL
 CITY OF ROCKWALL
 ROCKWALL COUNTY, TEXAS

REVISION	WLD.
CHECKED	D.A.C.
DRAWN	
SCALE	1" = 20' H 1" = 5' V
APRIL, 2018	
DATE	
PROJECT	17013
	42