


NOTE:
 1. NO SMOOTH CONCRETE WALLS ALLOWED.
 2. NO PART OF THE WALL (FOOTINGS, TIE-BACKS, ETC) MAY BE OFF-SITE OR ON LOT LINE, IN EASEMENTS OR R.O.W.
 WALL MUST BE COMPLETELY ON ONE LOT.
 3. NO SIDEWALKS AT BACK OF CURB

REVISED TO CONFORM TO CONSTRUCTION RECORDS.
[Signature] DATE: 8-10-20

LEGEND
 BFR BARRIER FREE RAMP
 PAD PROP. PAD ELEVATION
 XX.XXTC PROP. TOP OF CURB ELEVATION
 XX.XX PROP. SPOT GRADES
 XX.XXNG NATURAL GROUND ELEVATION
 XX.XXNG-TW TOP OF WALL @ NATURAL GROUND ELEVATION
 XX.XX-TW PROP. TOP OF WALL ELEVATION
 XX.XXBW PROP. BOTTOM OF WALL ELEVATION
 XX.XXFC PROP. FINISHED GRADE ELEVATION
 XX.XXPF PROP. FINISHED PAVEMENT ELEVATION

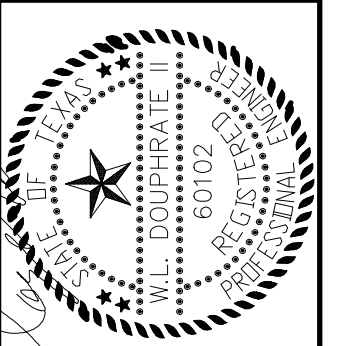

THE SEAL APPEARING ON THIS DOCUMENT WAS AUTHORIZED BY THE STATE OF TEXAS PROFESSIONAL ENGINEERING BOARD. DATE: APRIL 18, 2018.

DOUGLASS TATE & ASSOCIATES, INC.
 ENGINEERING • PROJECT MANAGEMENT • SURVEYING
 2235 RIDGE RD., # 200 ROCKWALL, TEXAS 75087
 PHONE: (972)771-9004 FAX: (972)771-9005

**PROPOSED GRADING
 SHT. 4.4
 THE STANDARD ROCKWALL
 CITY OF ROCKWALL
 ROCKWALL COUNTY, TEXAS**

REVISION	WLD.
CHECKED	DAC.
DRAWN	
SCALE	1"=20' H 1"= V
DATE	APRIL 2018
PROJECT	17013
	44