


REVISED TO CONFORM TO CONSTRUCTION RECORDS.  
 \_\_\_\_\_ DATE: 8-10-20

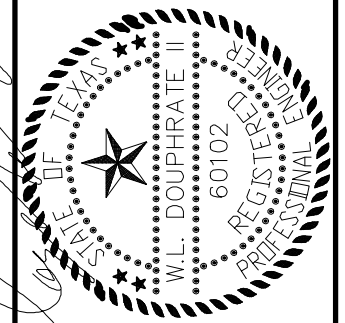

THE SEAL APPEARING ON THIS DOCUMENT WAS AUTHORIZED BY W.L. DOUPHRAE II, TEXAS P.E. NO. 60102, F-886, ON DATE: APRIL 12, 2018.

DOUPHRAE & ASSOCIATES, INC.  
 ENGINEERING • PROJECT MANAGEMENT • SURVEYING  
 2235 RIDGE RD., # 200 ROCKWALL, TEXAS 75087  
 PHONE: (972)771-9004 FAX: (972)771-9005

SANITARY SEWER PROFILES  
 THE STANDARD  
 ROCKWALL  
 CITY OF ROCKWALL  
 ROCKWALL COUNTY, TEXAS

REVISION	W.L.D.
CHECKED	D.A.C.
DRAWN	
SCALE	1"=60' H
DATE	APRIL 2018
PROJECT	17013
	62