
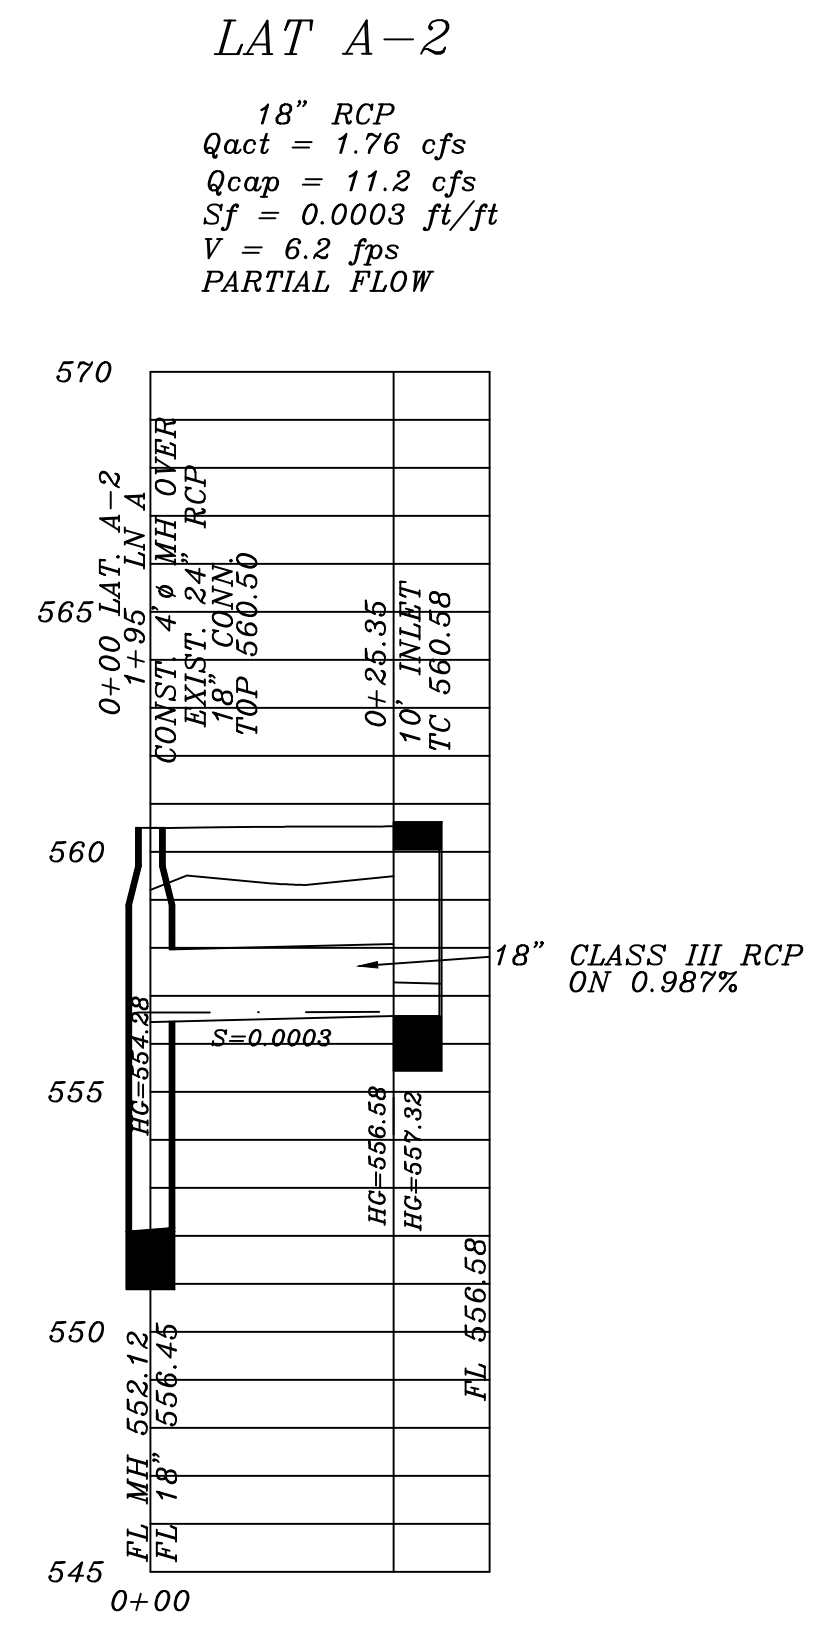
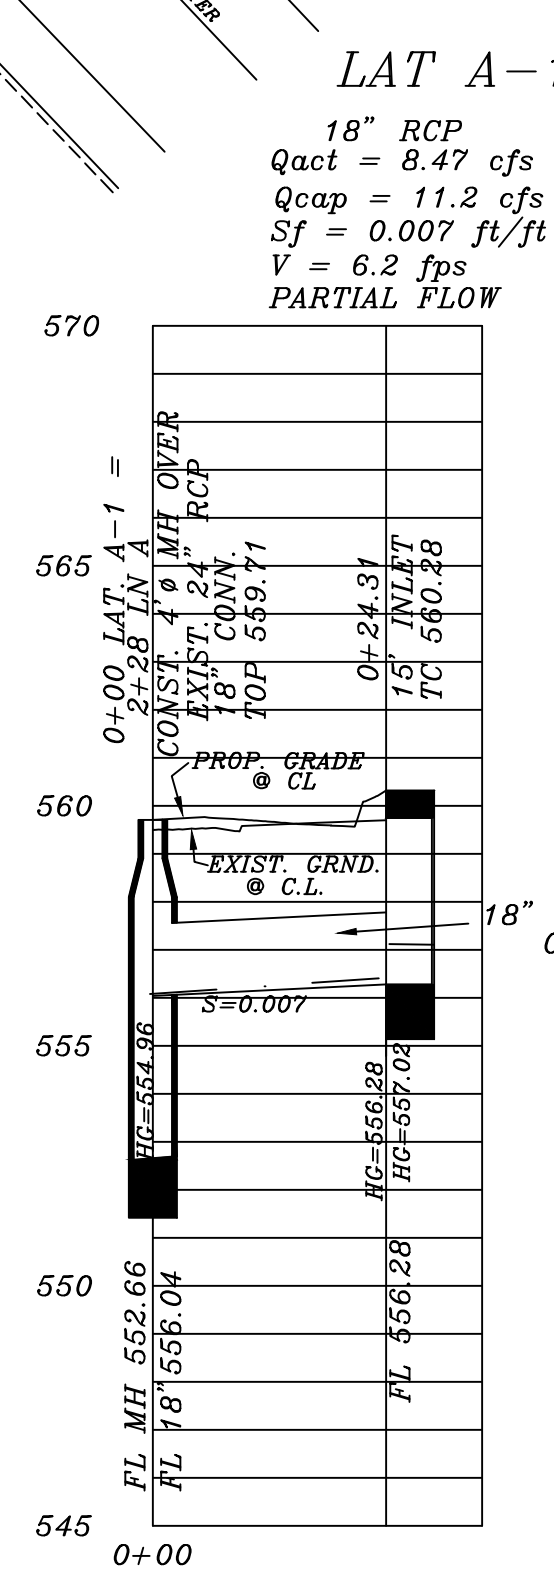
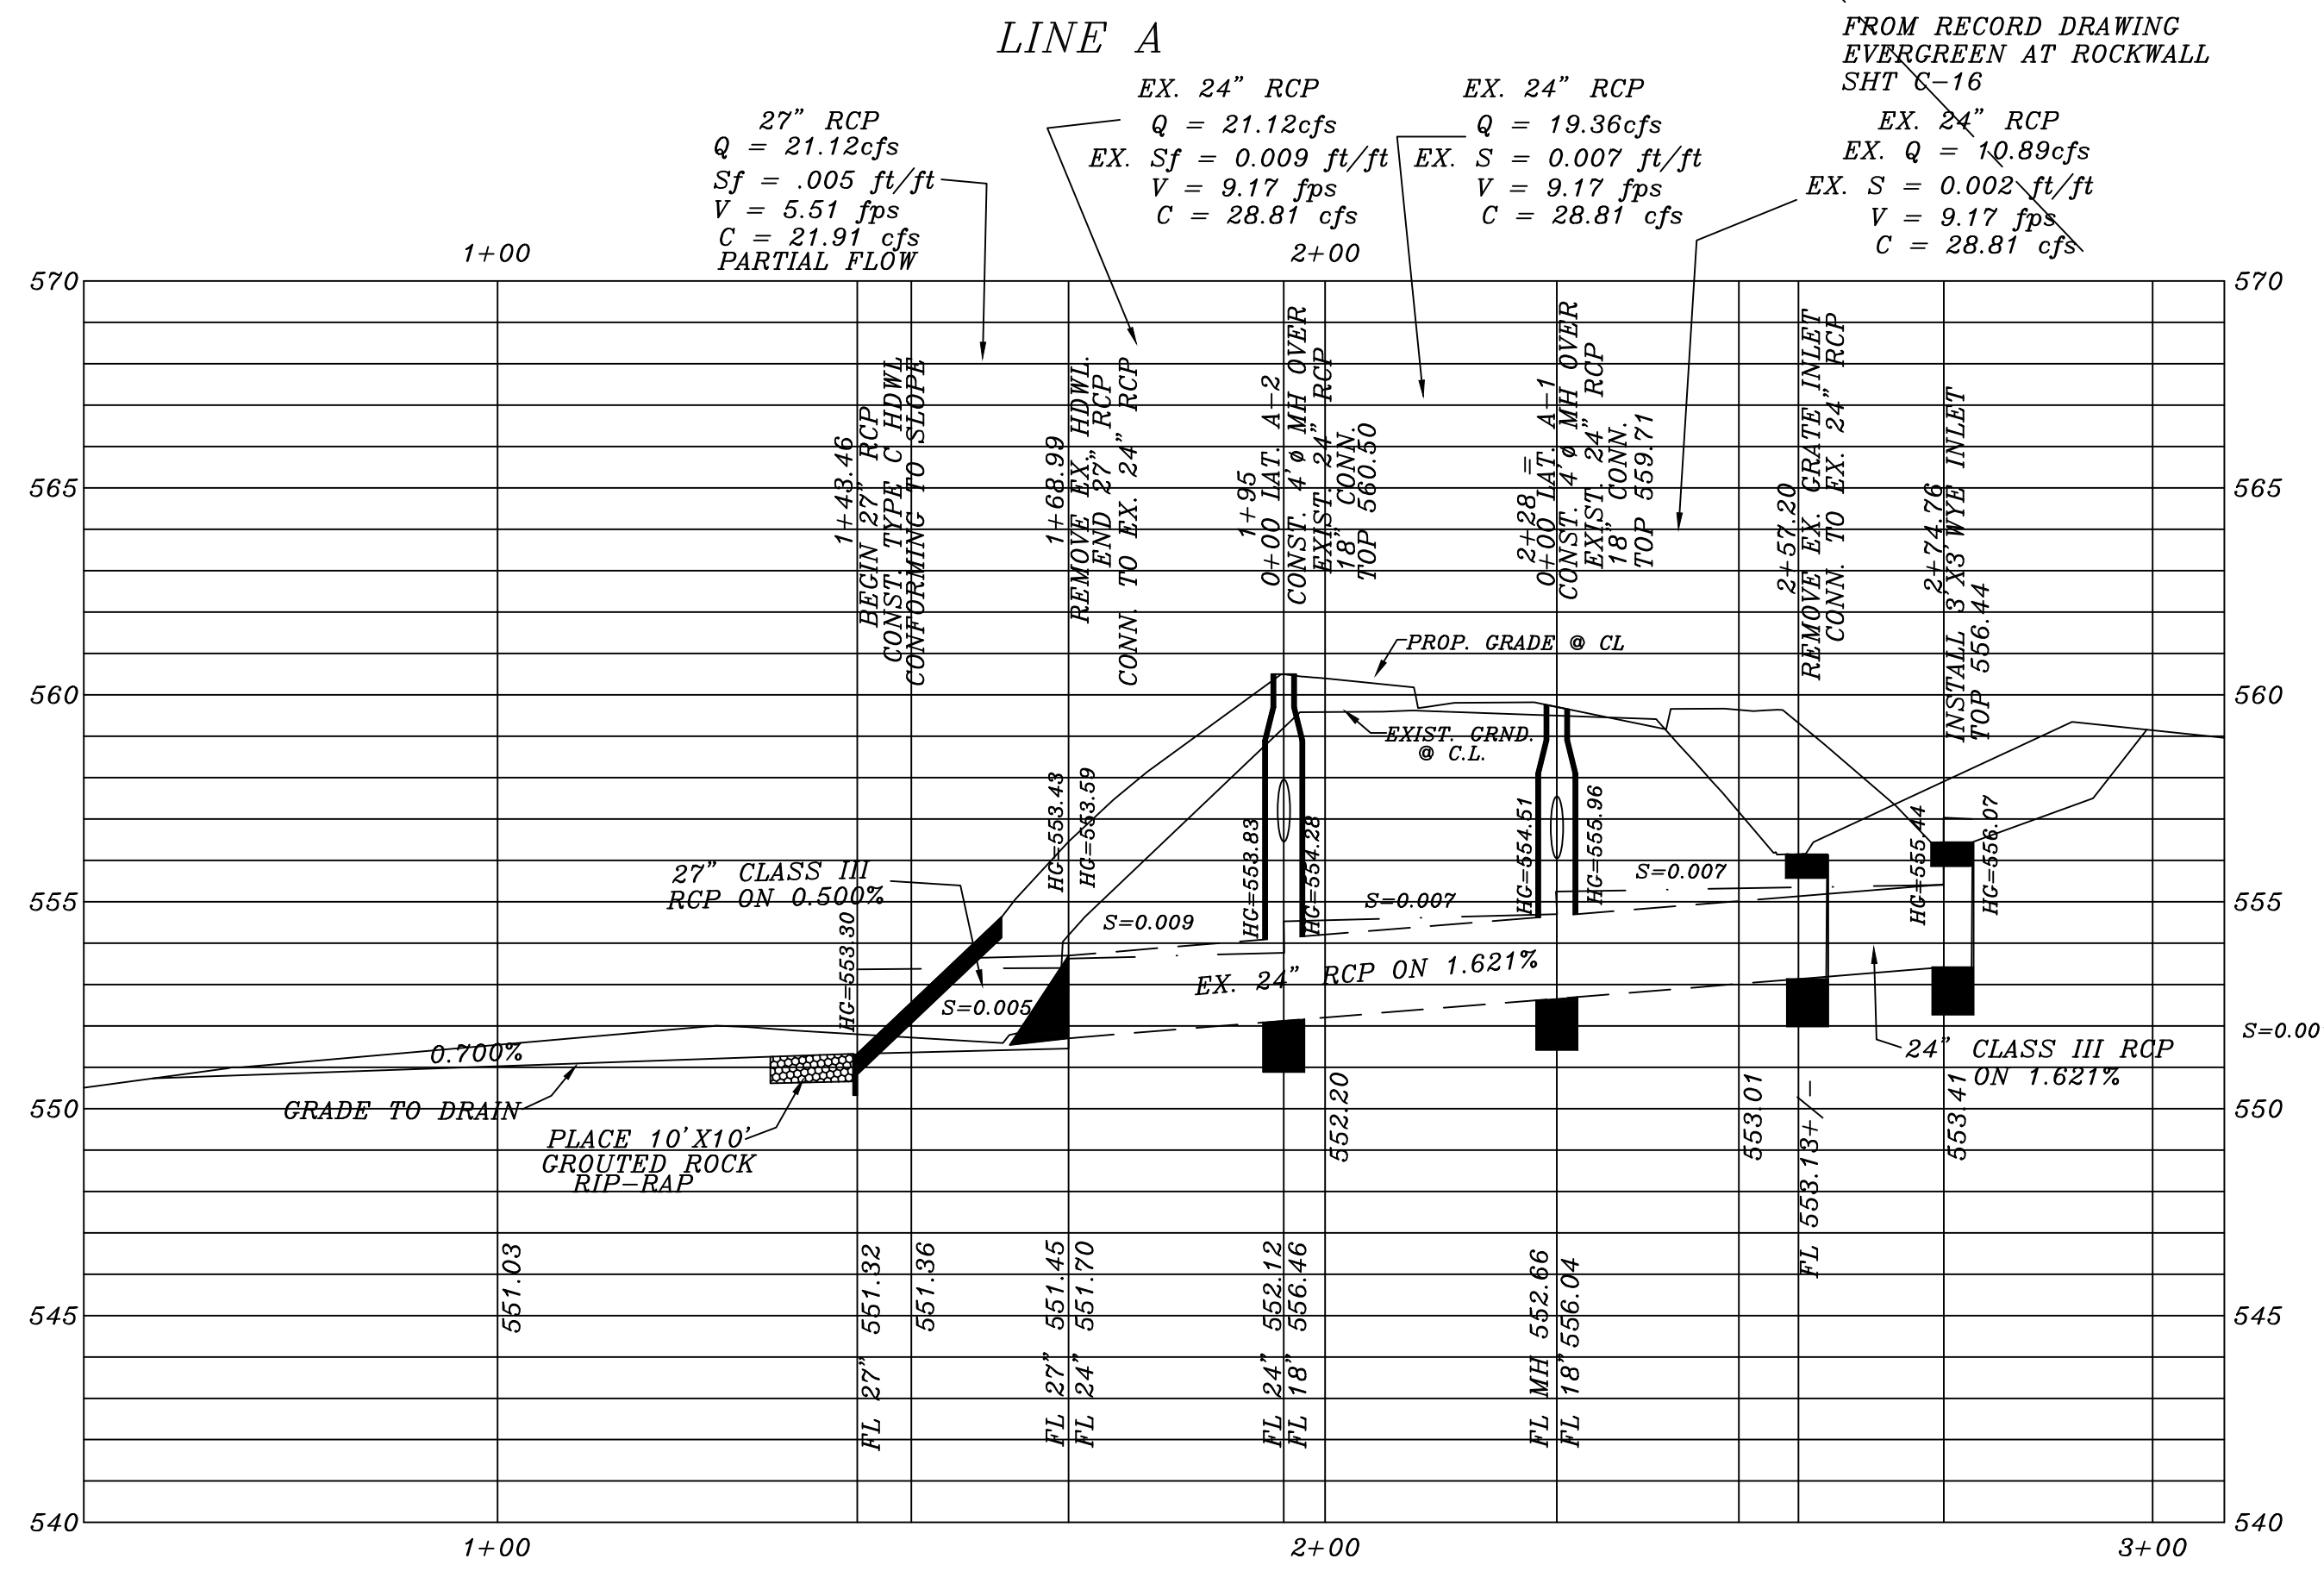


REVISED TO CONFORM TO CONSTRUCTION RECORDS.
W. Douphrate DATE: 8-10-20

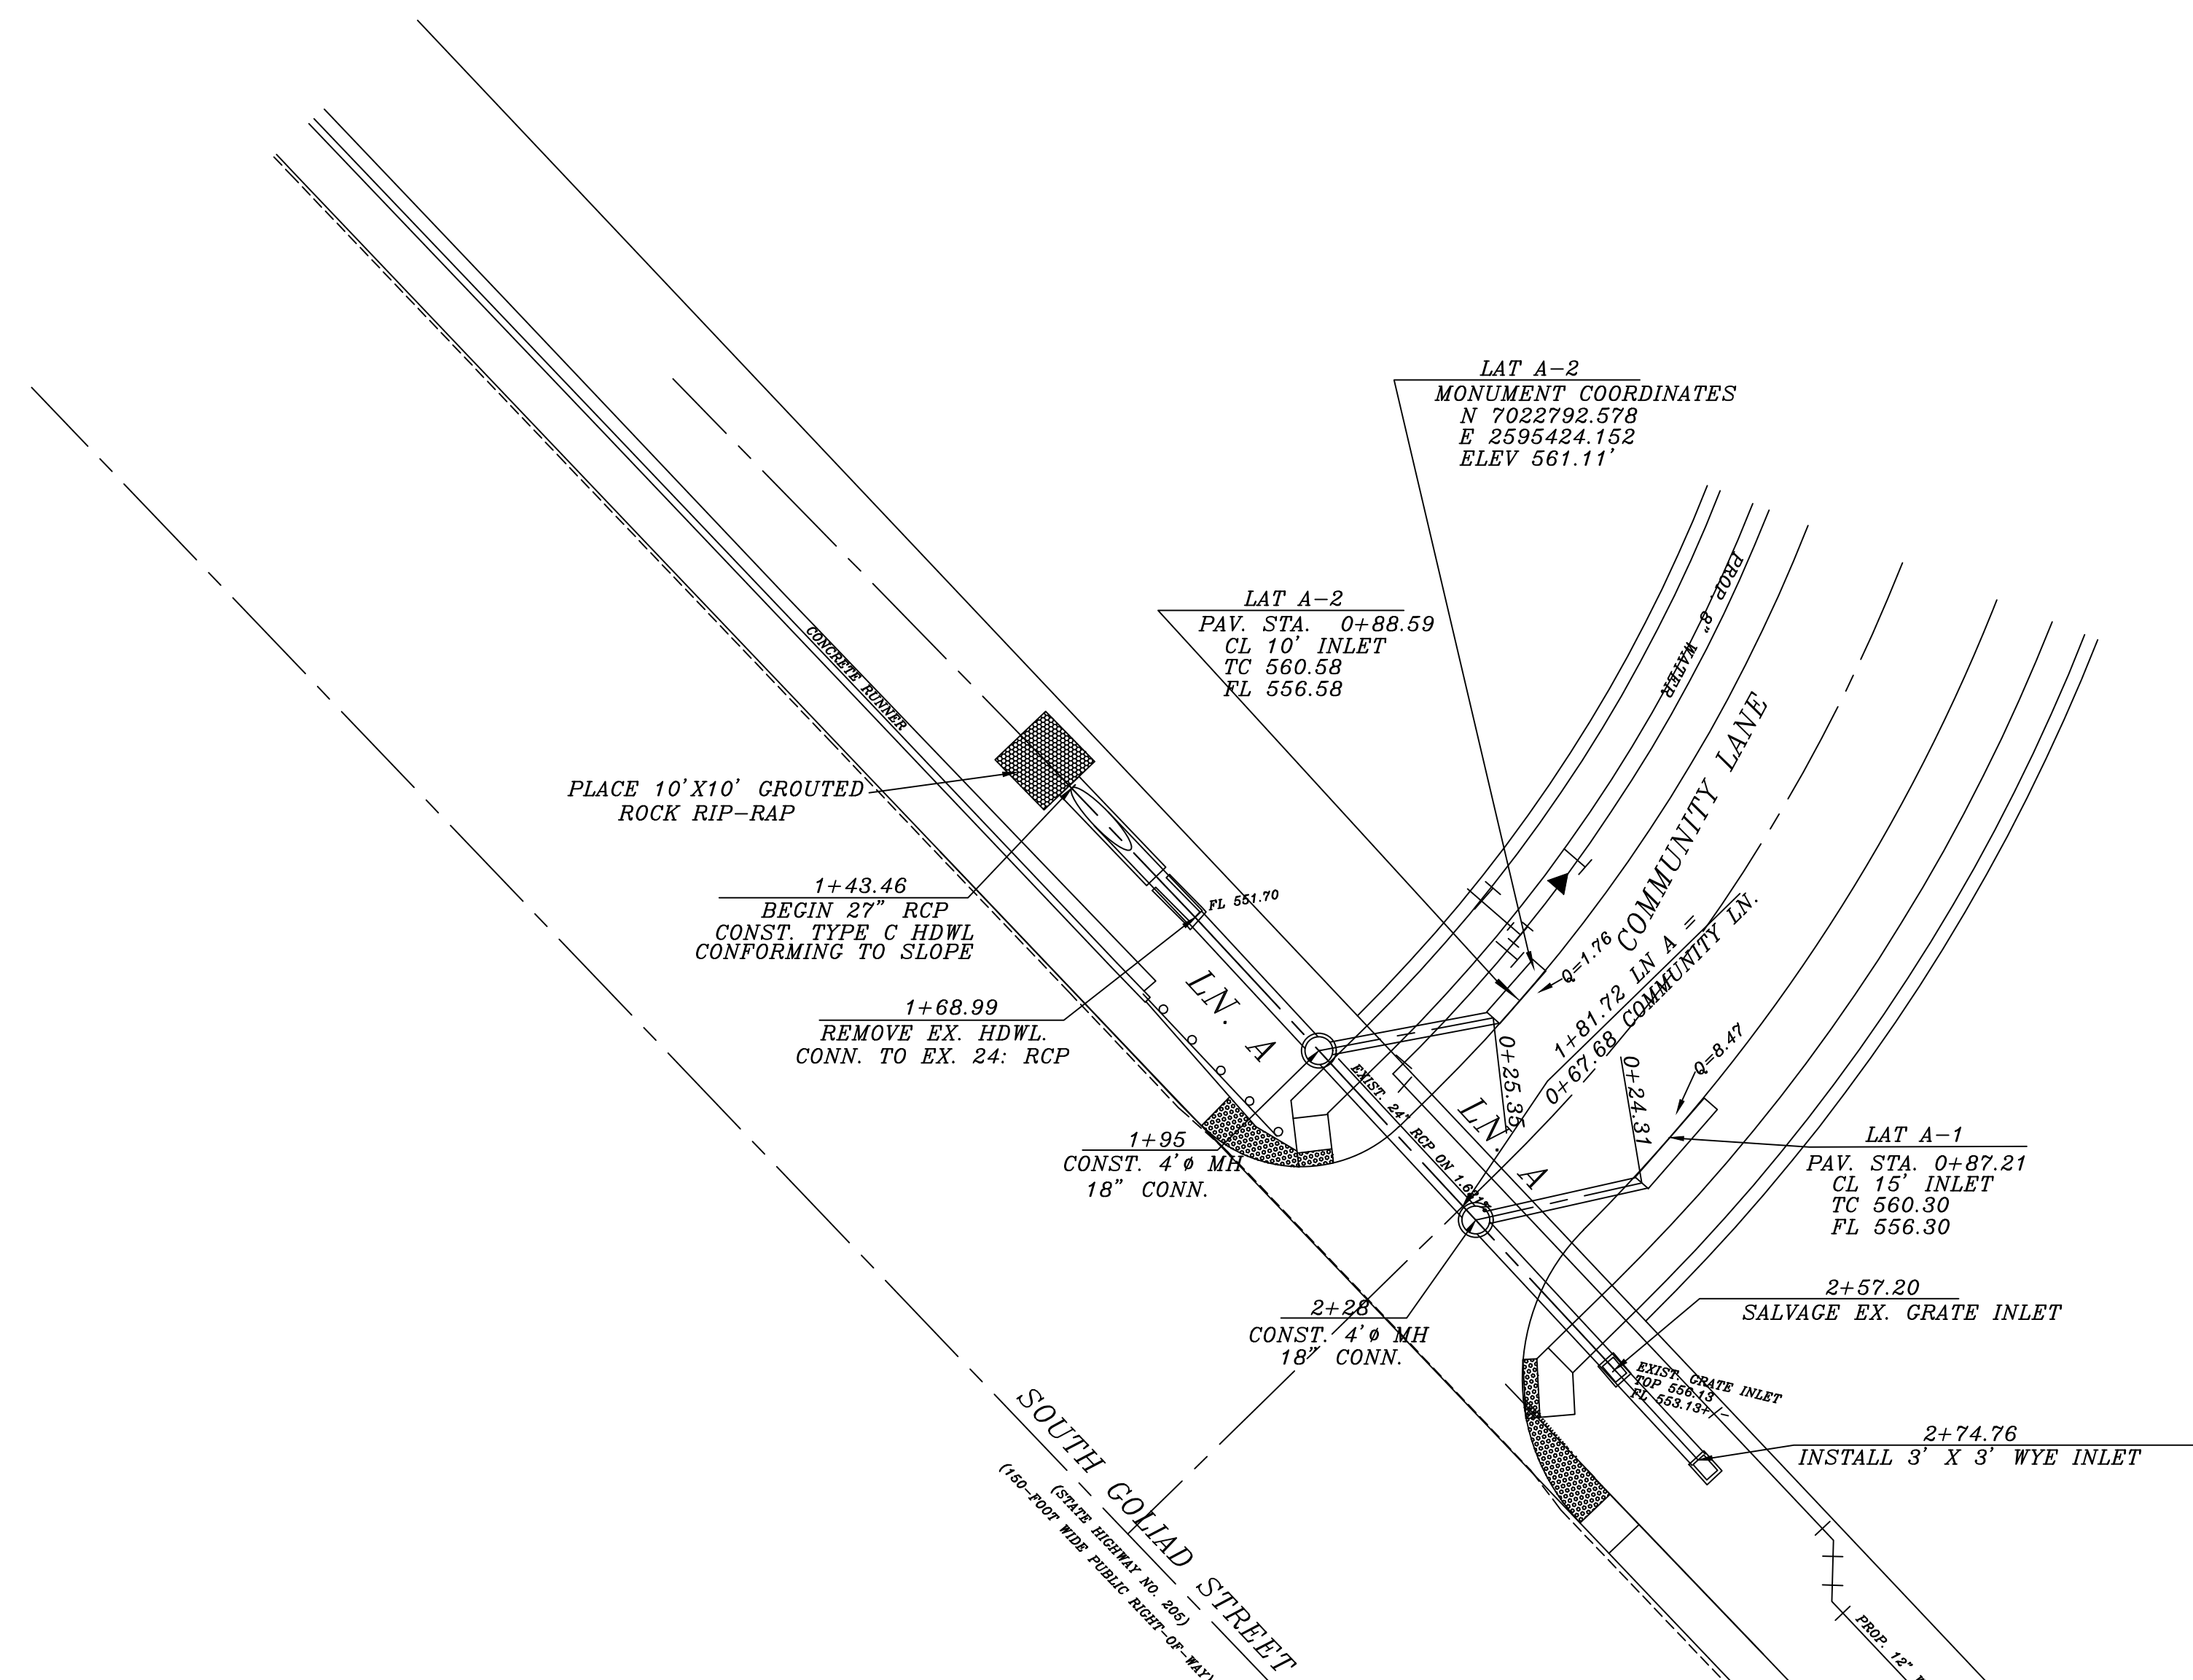

THE SEAL APPEARING ON THIS DOCUMENT WAS AUTHORIZED BY W.L. DOUPHRATE II TEXAS P.E. NO. 60102, F-866, ON DATE: APRIL 16, 2018.

DOUPHRATE & ASSOCIATES, INC.
 ENGINEERING - PROJECT MANAGEMENT - SURVEYING
 2235 RIDGE RD., # 200 ROCKWALL, TEXAS 75087
 PHONE: (972)771-9004 FAX: (972)771-9005

PROPOSED DRAINAGE
 THE STANDARD ROCKWALL
 LINE B 5+50 TO END, LATS B-2, 3 & 4
 CITY OF ROCKWALL,
 ROCKWALL COUNTY, TEXAS

REVISION	W.L.D.
CHECKED	
DRAWN	D.A.C.
SCALE	1"=20'H 1"=4'V
DATE	APRIL 2018
PROJECT	17013
	71