




65.5 AC @ 0.80 TC = 20 MIN.

434.92 C.F.S.

NOTE:


ALL FLUMES AND LOW WATER
SIDEWALK CROSSINGS TO BE
GRADED DURING PHASE ONE.

GRAPHIC SCALE

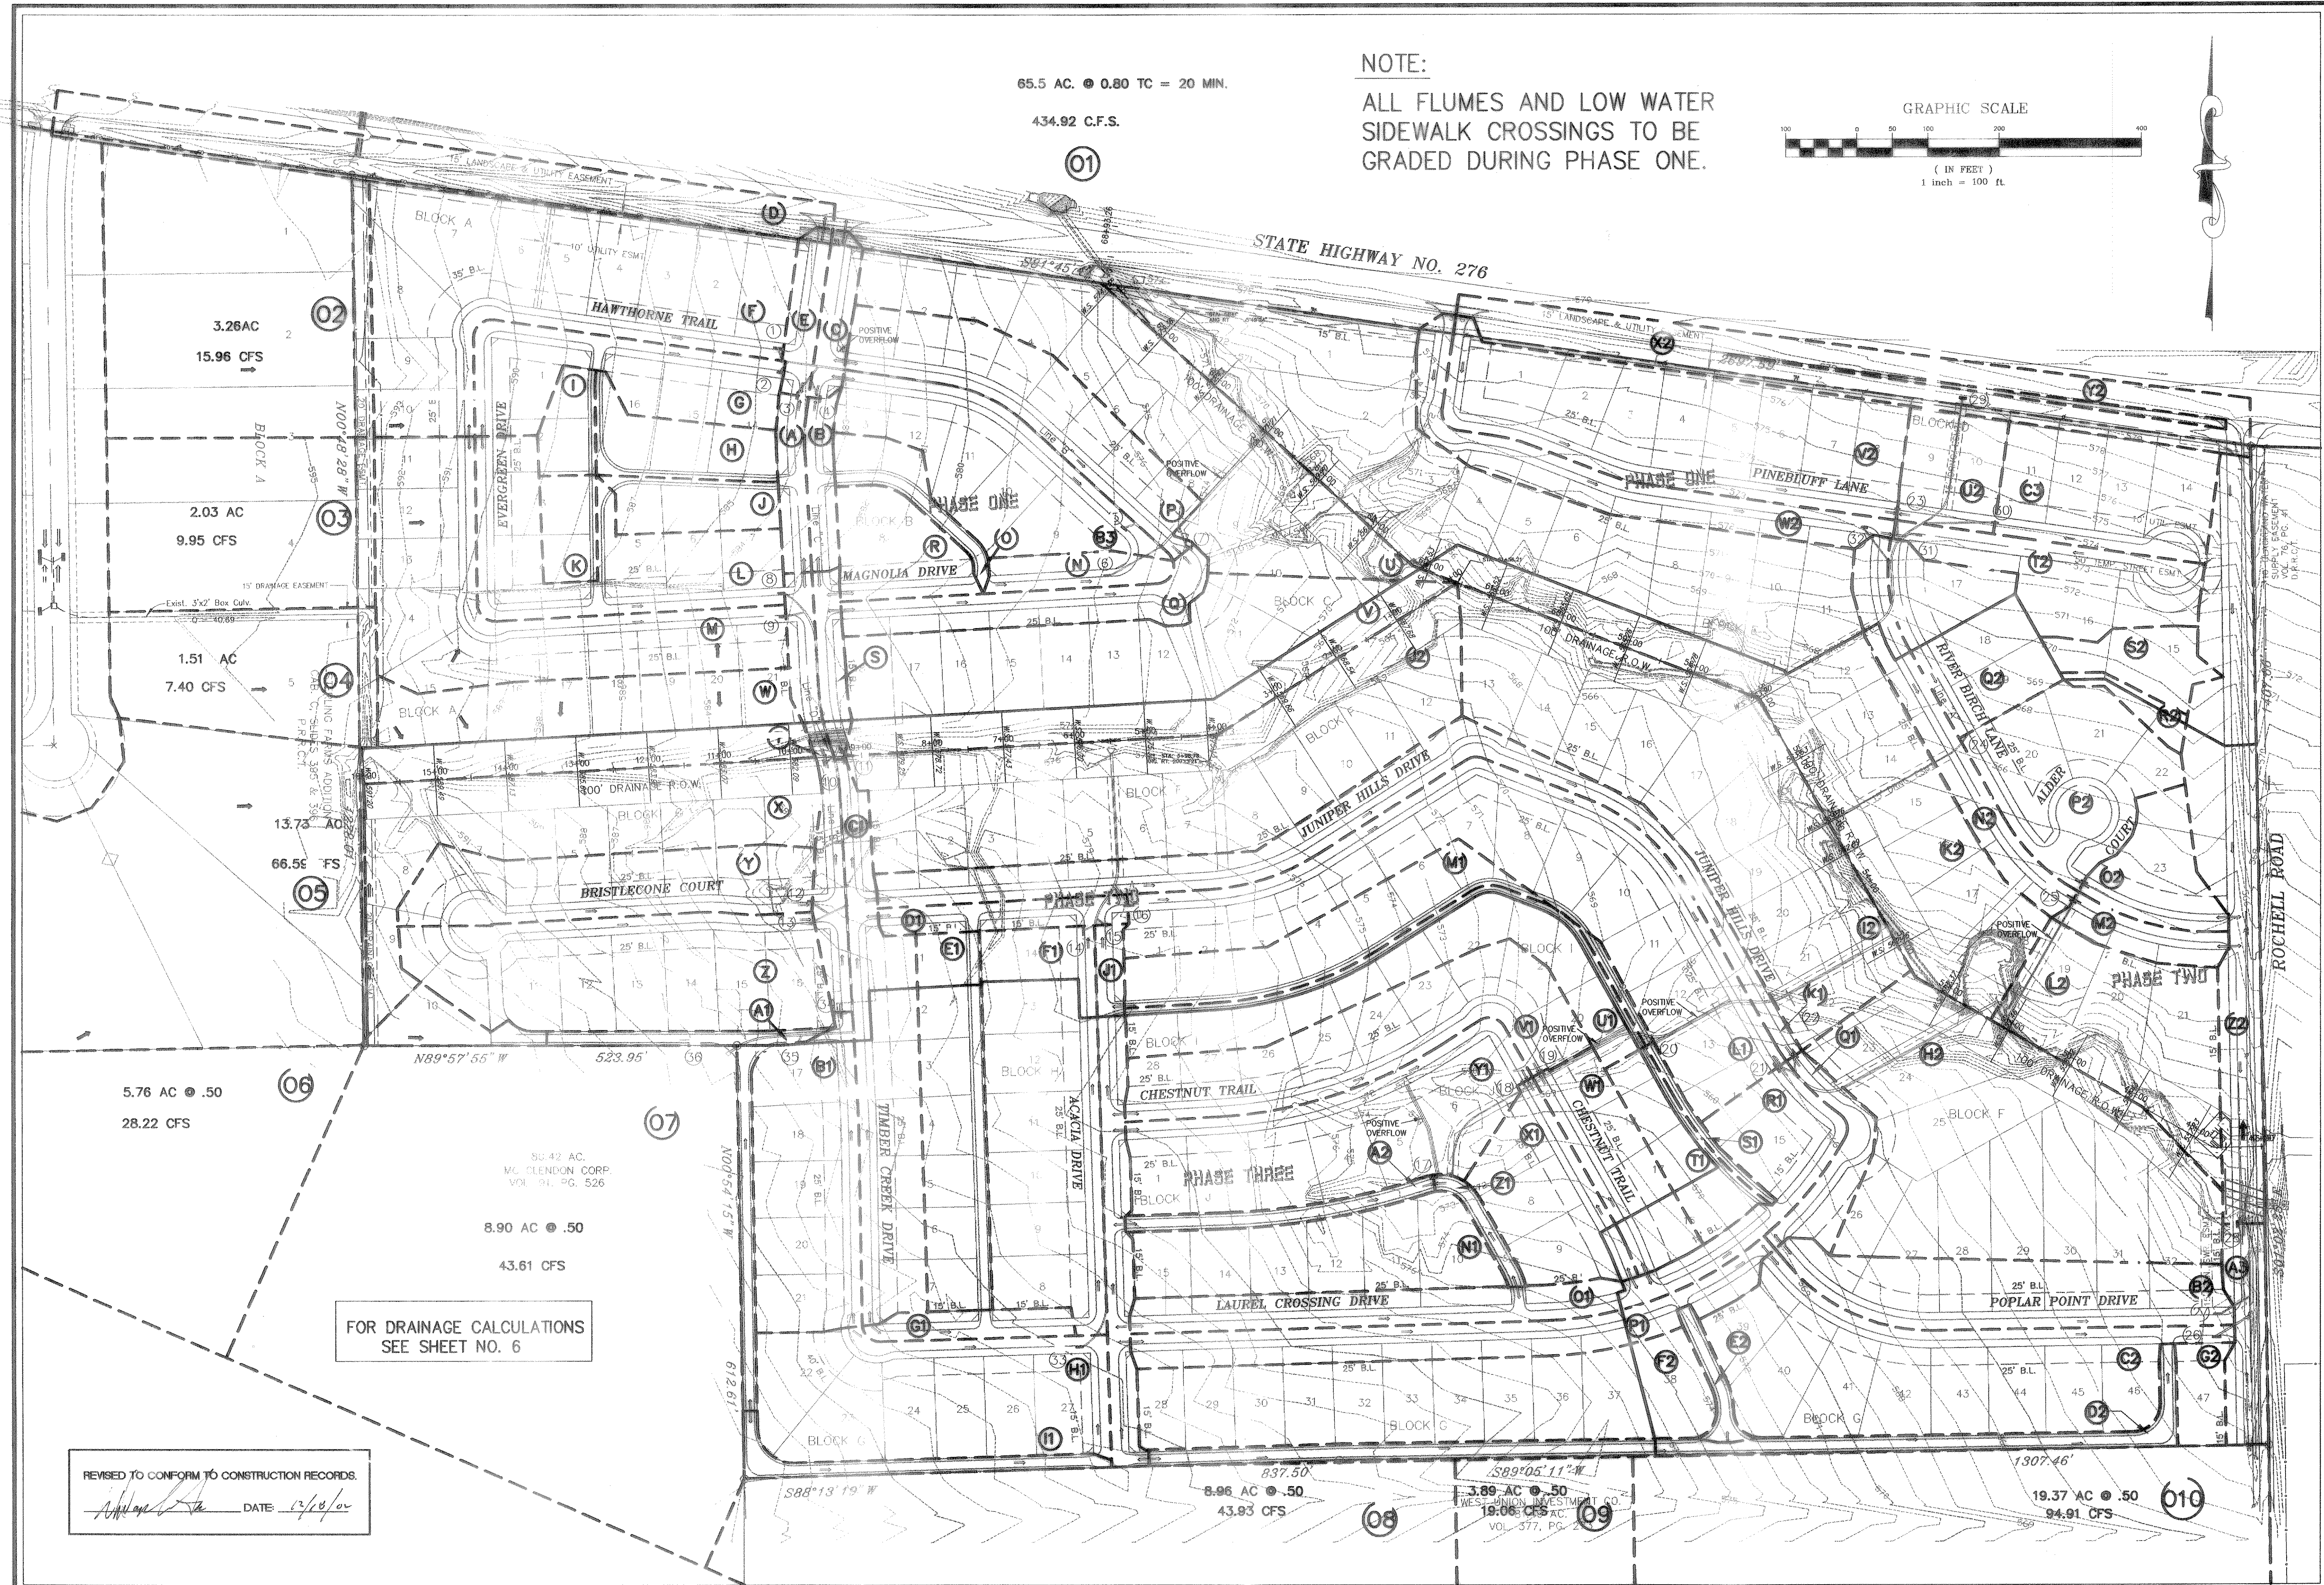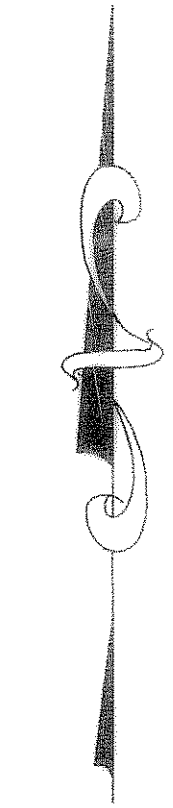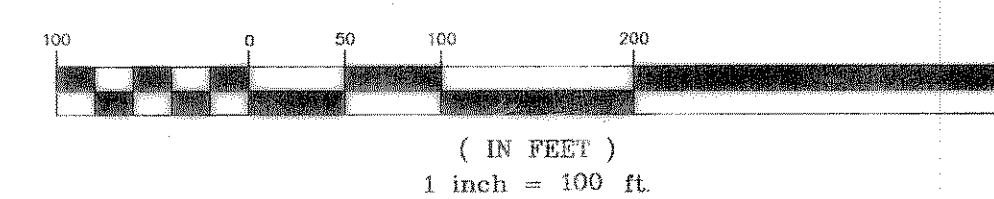

FOR DRAINAGE CALCULATIONS
SEE SHEET NO. 6

REVISED TO CONFORM TO CONSTRUCTION RECORDS.
DATE 12/10/00

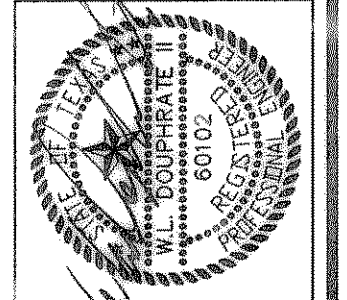

THE SEAL APPEARING ON THIS
DOCUMENT WAS AUTHORIZED BY
W.L. DOUDRATE II TEXAS P.E.
NO. 60102 ON 12/12/82

DOUPRATE
& ASSOCIATES, INC.
ENGINEERING PROJECT MANAGEMENT - SURVEYING
2236 RIDGE RD., # 200 ROCKWALL, TEXAS 75087
PHONE: (972)771-9004 FAX: (972)771-9005

DRAINAGE AREA MAP
TIMBERCREEK ADDITION
CITY OF ROCKWALL
ROCKWALL, ROCKWALL COUNTY, TEXAS

REVISION
W.L.D. CHECKED
B.W.H. DRAWN
8/4/00 DATE
9913DAM PROJECT
5 OF