


THE SEAL APPEARING ON THIS DOCUMENT WAS AUTHORIZED BY W.L. DOUPHRATE, TEXAS P.E. NO. 60102 ON 12/2/94

**DOUPHRATE & ASSOCIATES, INC.**  
 ENGINEERING • PROJECT MANAGEMENT • SURVEYING  
 2235 RIDGE RD., # 200 ROCKWALL, TEXAS 75087  
 PHONE: (972)771-9004 FAX: (972)771-9005

**LOT GRADING PLAN**  
**TIMBER CREEK ESTATES**  
 CITY OF ROCKWALL  
 ROCKWALL COUNTY, TEXAS

6/24/02	REVISION
REVISED NOTE	
W.L.D.	CHECKED
K.E.B.	DRAWN
7/25/00	DATE
9913GRD1	PROJECT
8	OF

**BENCHMARK:**  
 T.C. CENTERLINE OF INLET ON WEST SIDE OF SILVER VIEW LANE BETWEEN LOTS 4 & 5, BLOCK B, OF STERLING FARMS ADDITION  
 ELEV: 599.65

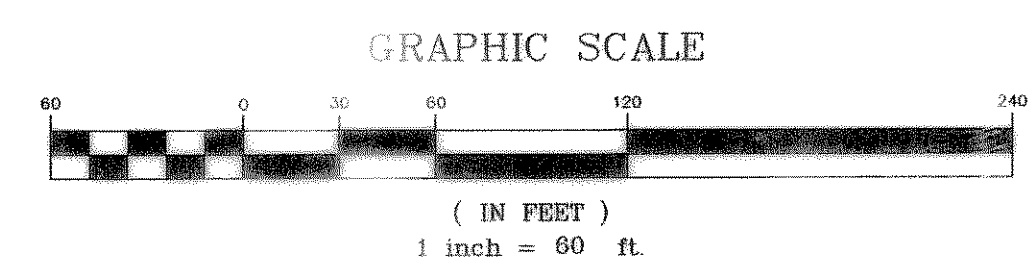

REVISED TO CONFORM TO CONSTRUCTION RECORDS.  
*[Signature]* DATE: 12/2/02



SEE SHEET 8B

SEE SHEET 8A

POSITIVE OVERFLOW

POSITIVE OVERFLOW